



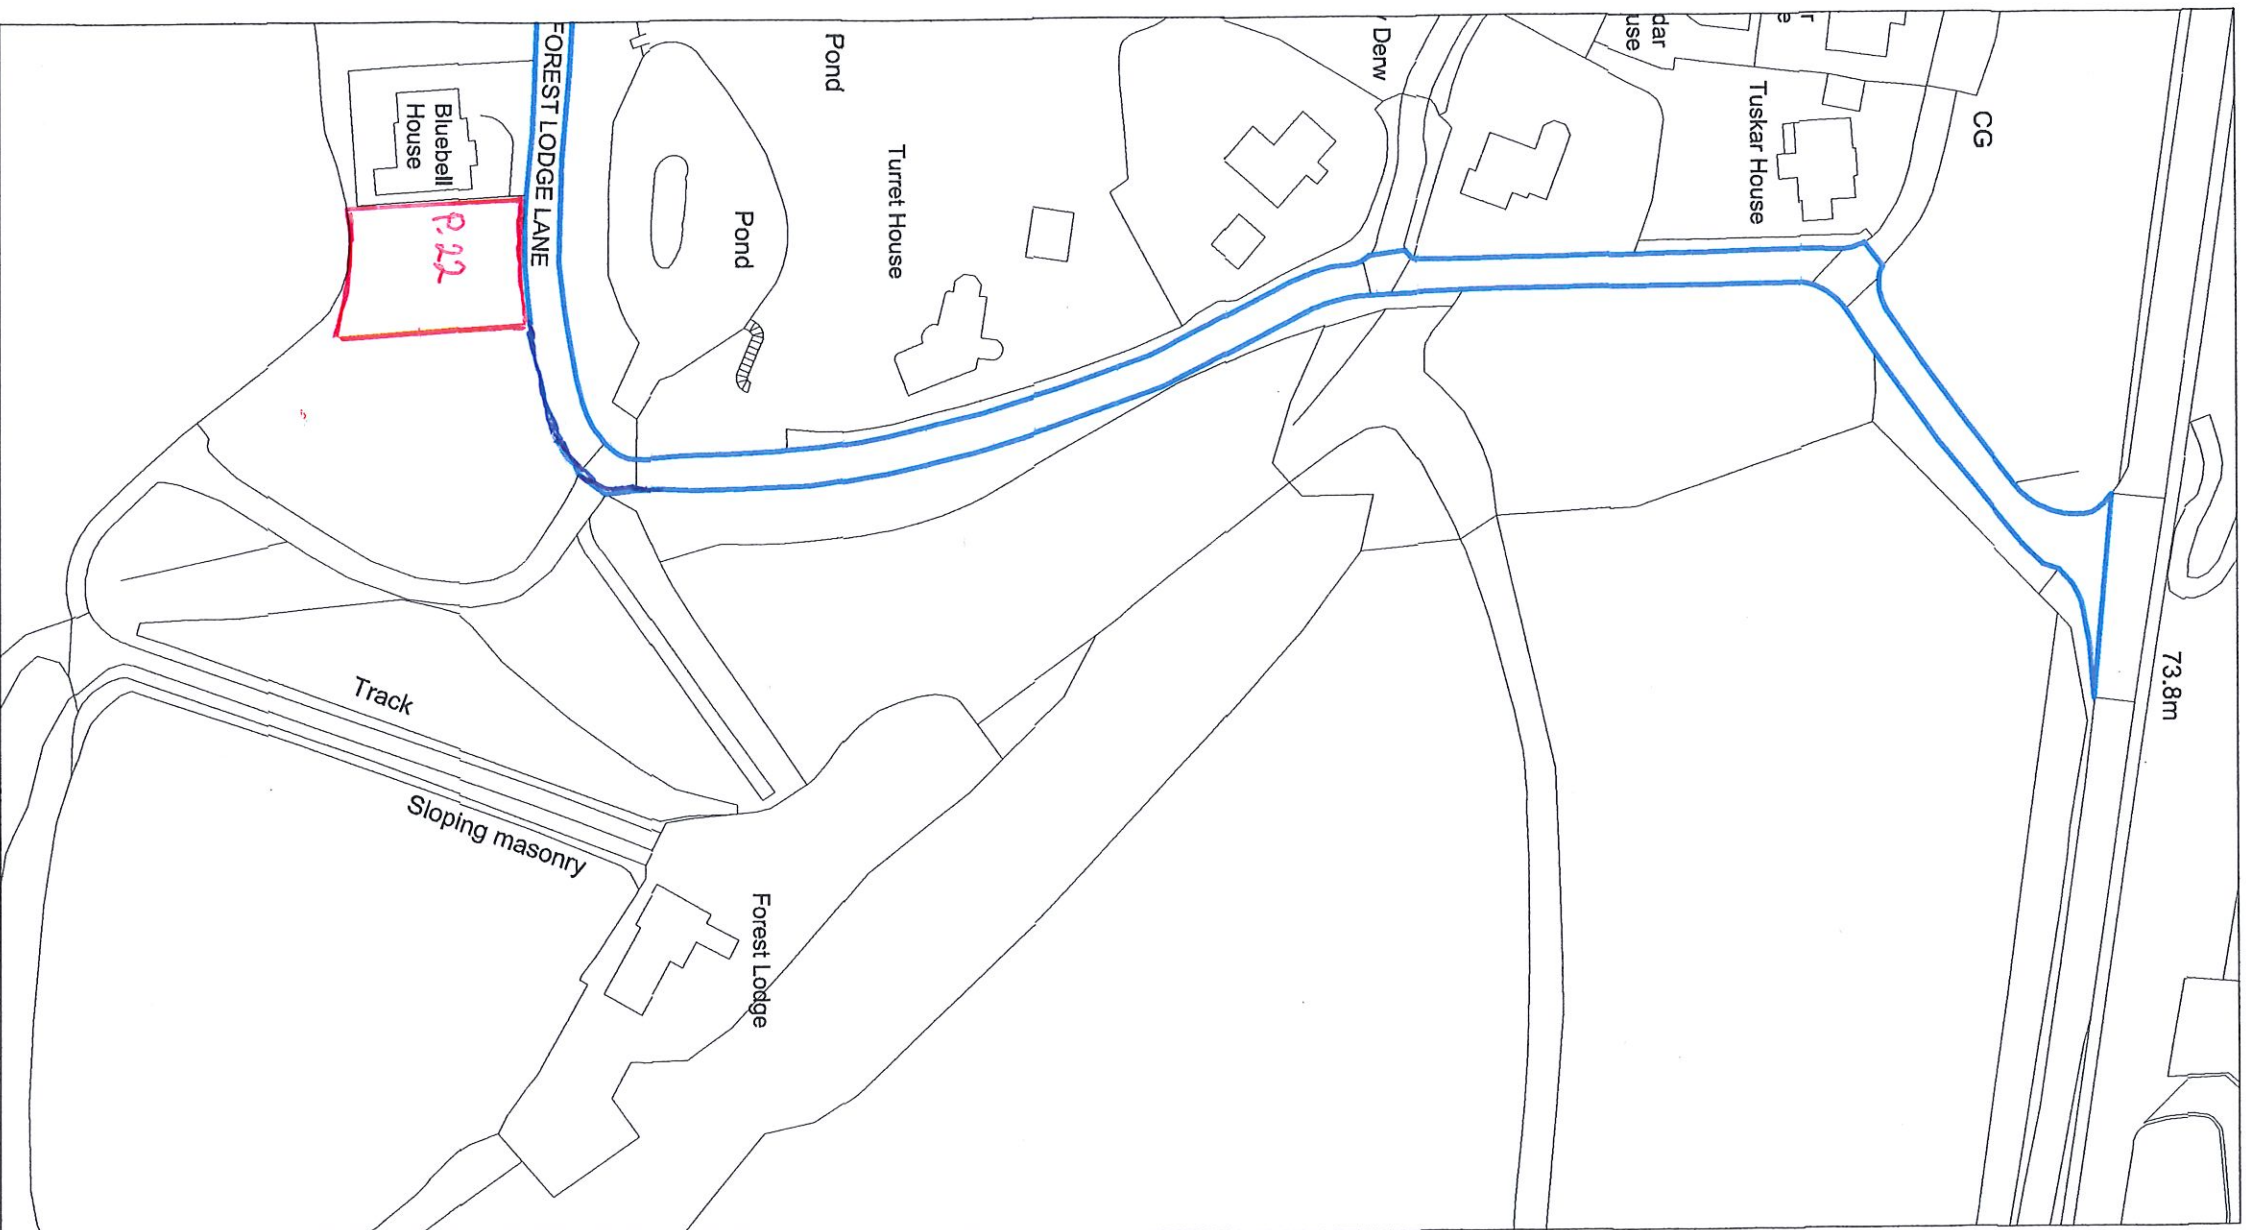


SITE LOCATION PLAN

Scale 1:1250@A2

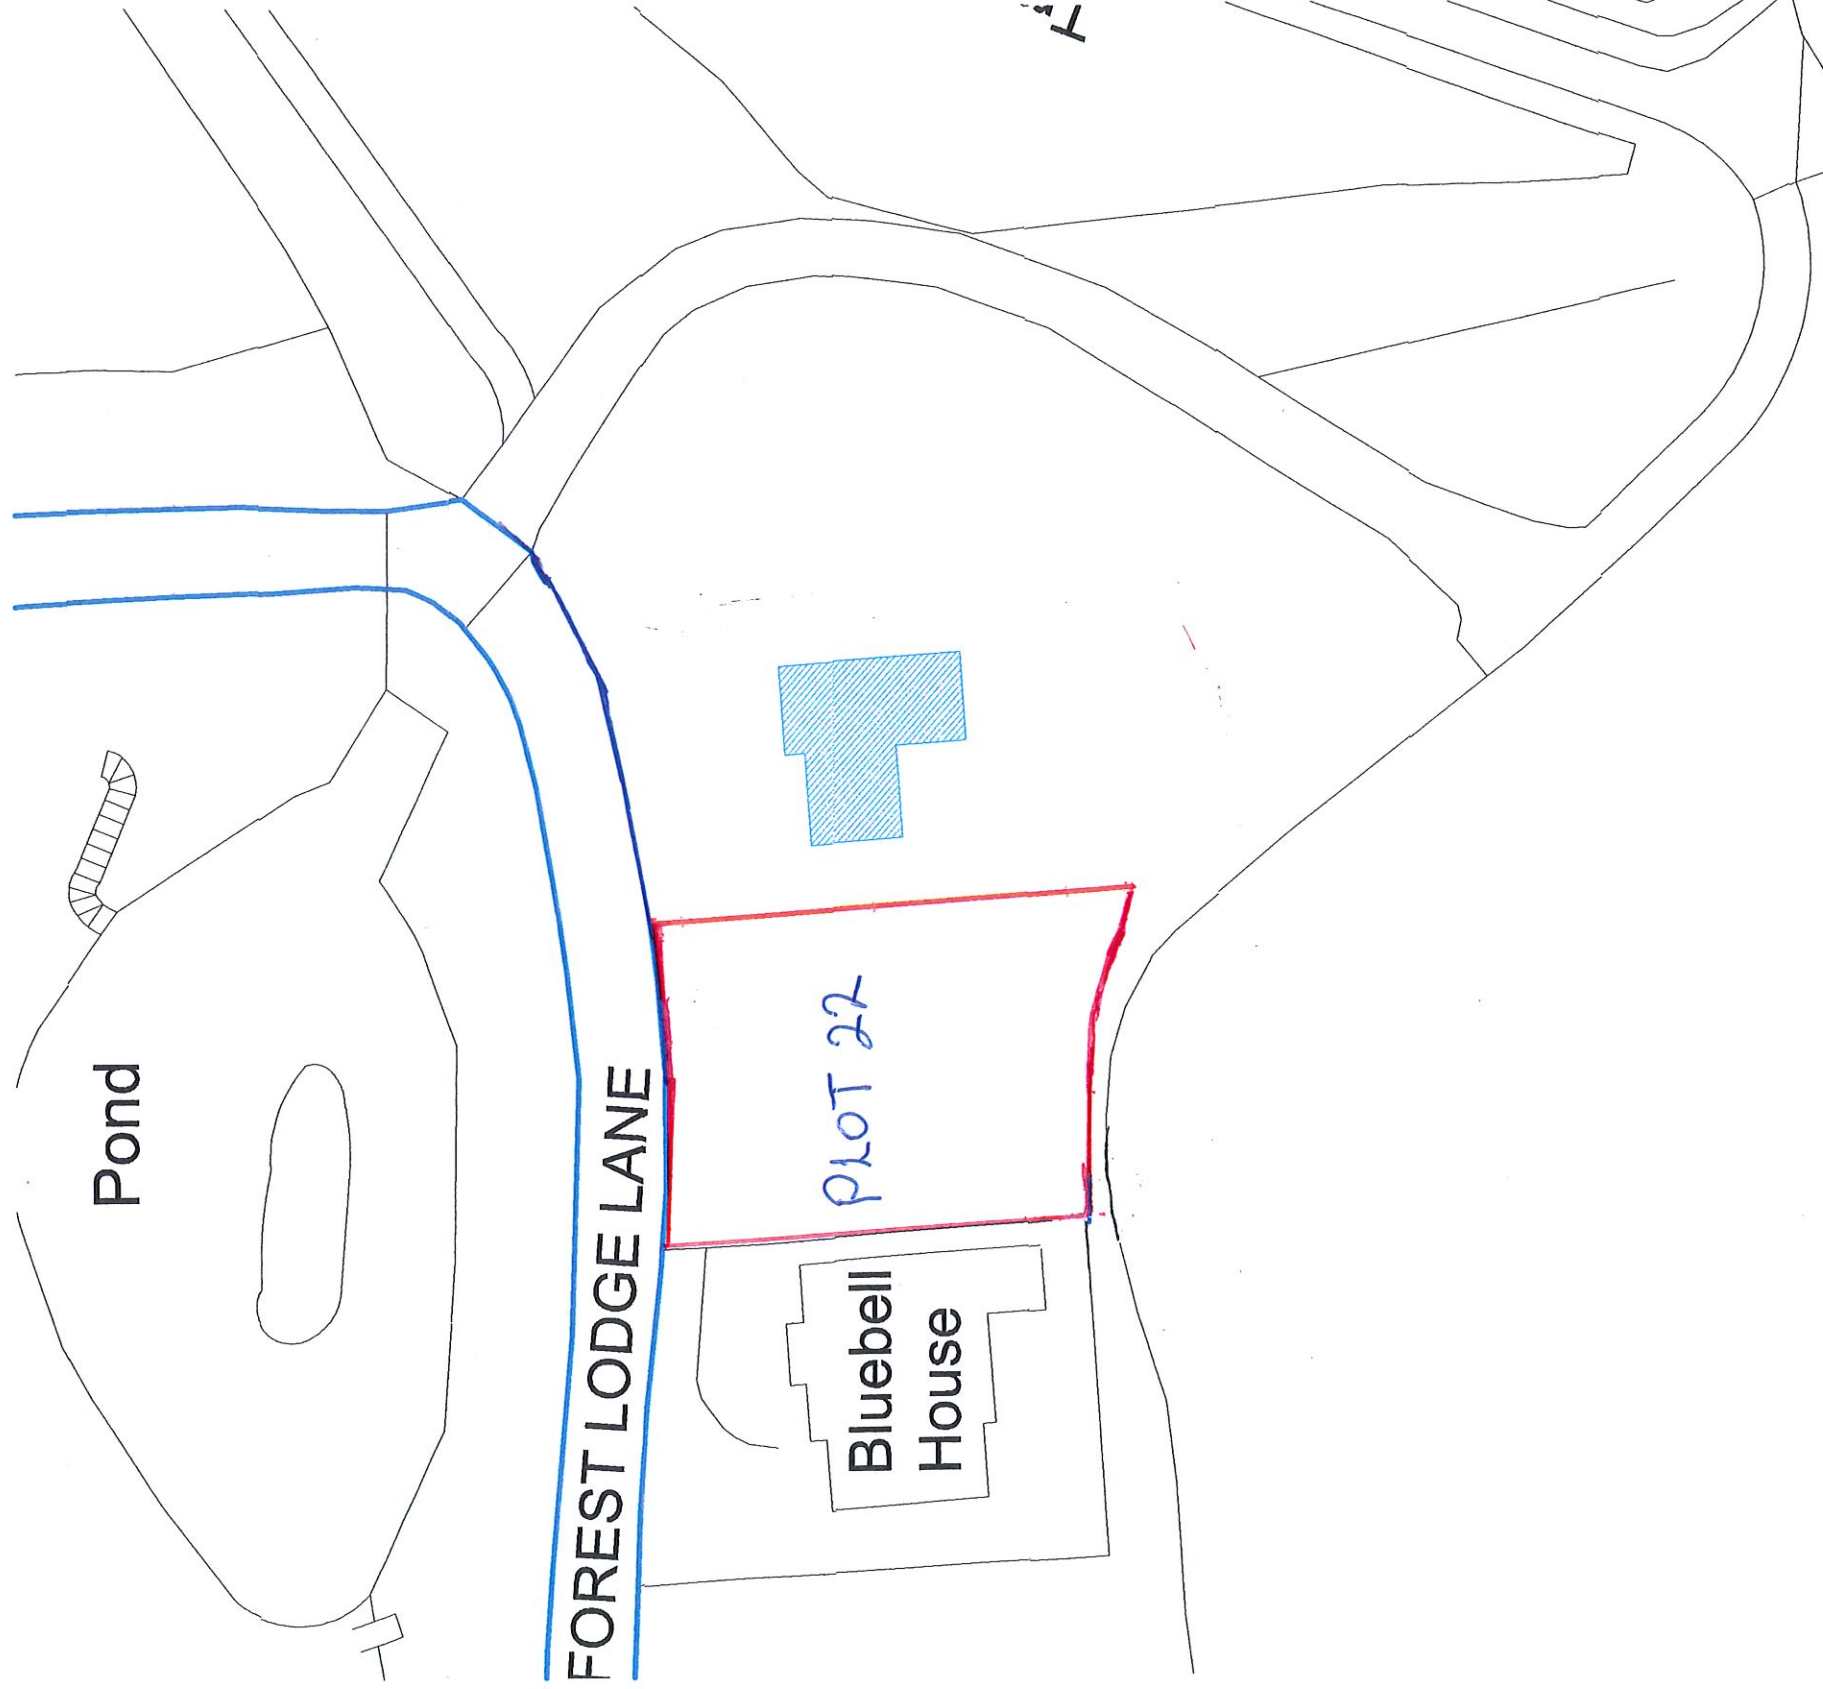

PROPOSED BLOCK PLAN
Scale 1:500@A2

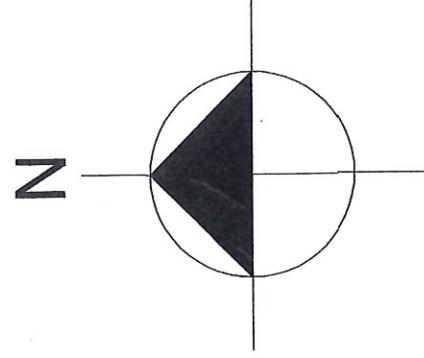

JOB: Plot 22	CLIENT: K.O. MAHONY		Rev	
ADDRESS: Forest Lodge Lane, Cwmavon Port Talbot			DRW-No.	
TITLE: EXISTING SITE PLAN		DATE: 13/08/2019	P01	
SYSTEM No:		Checked by: Kem		
JOB No:		DRAWN BY:		
SCALES: Varies				
REVISIONS DESCRIPTION: A - Red line amended and blue line added showing access over lane.				