


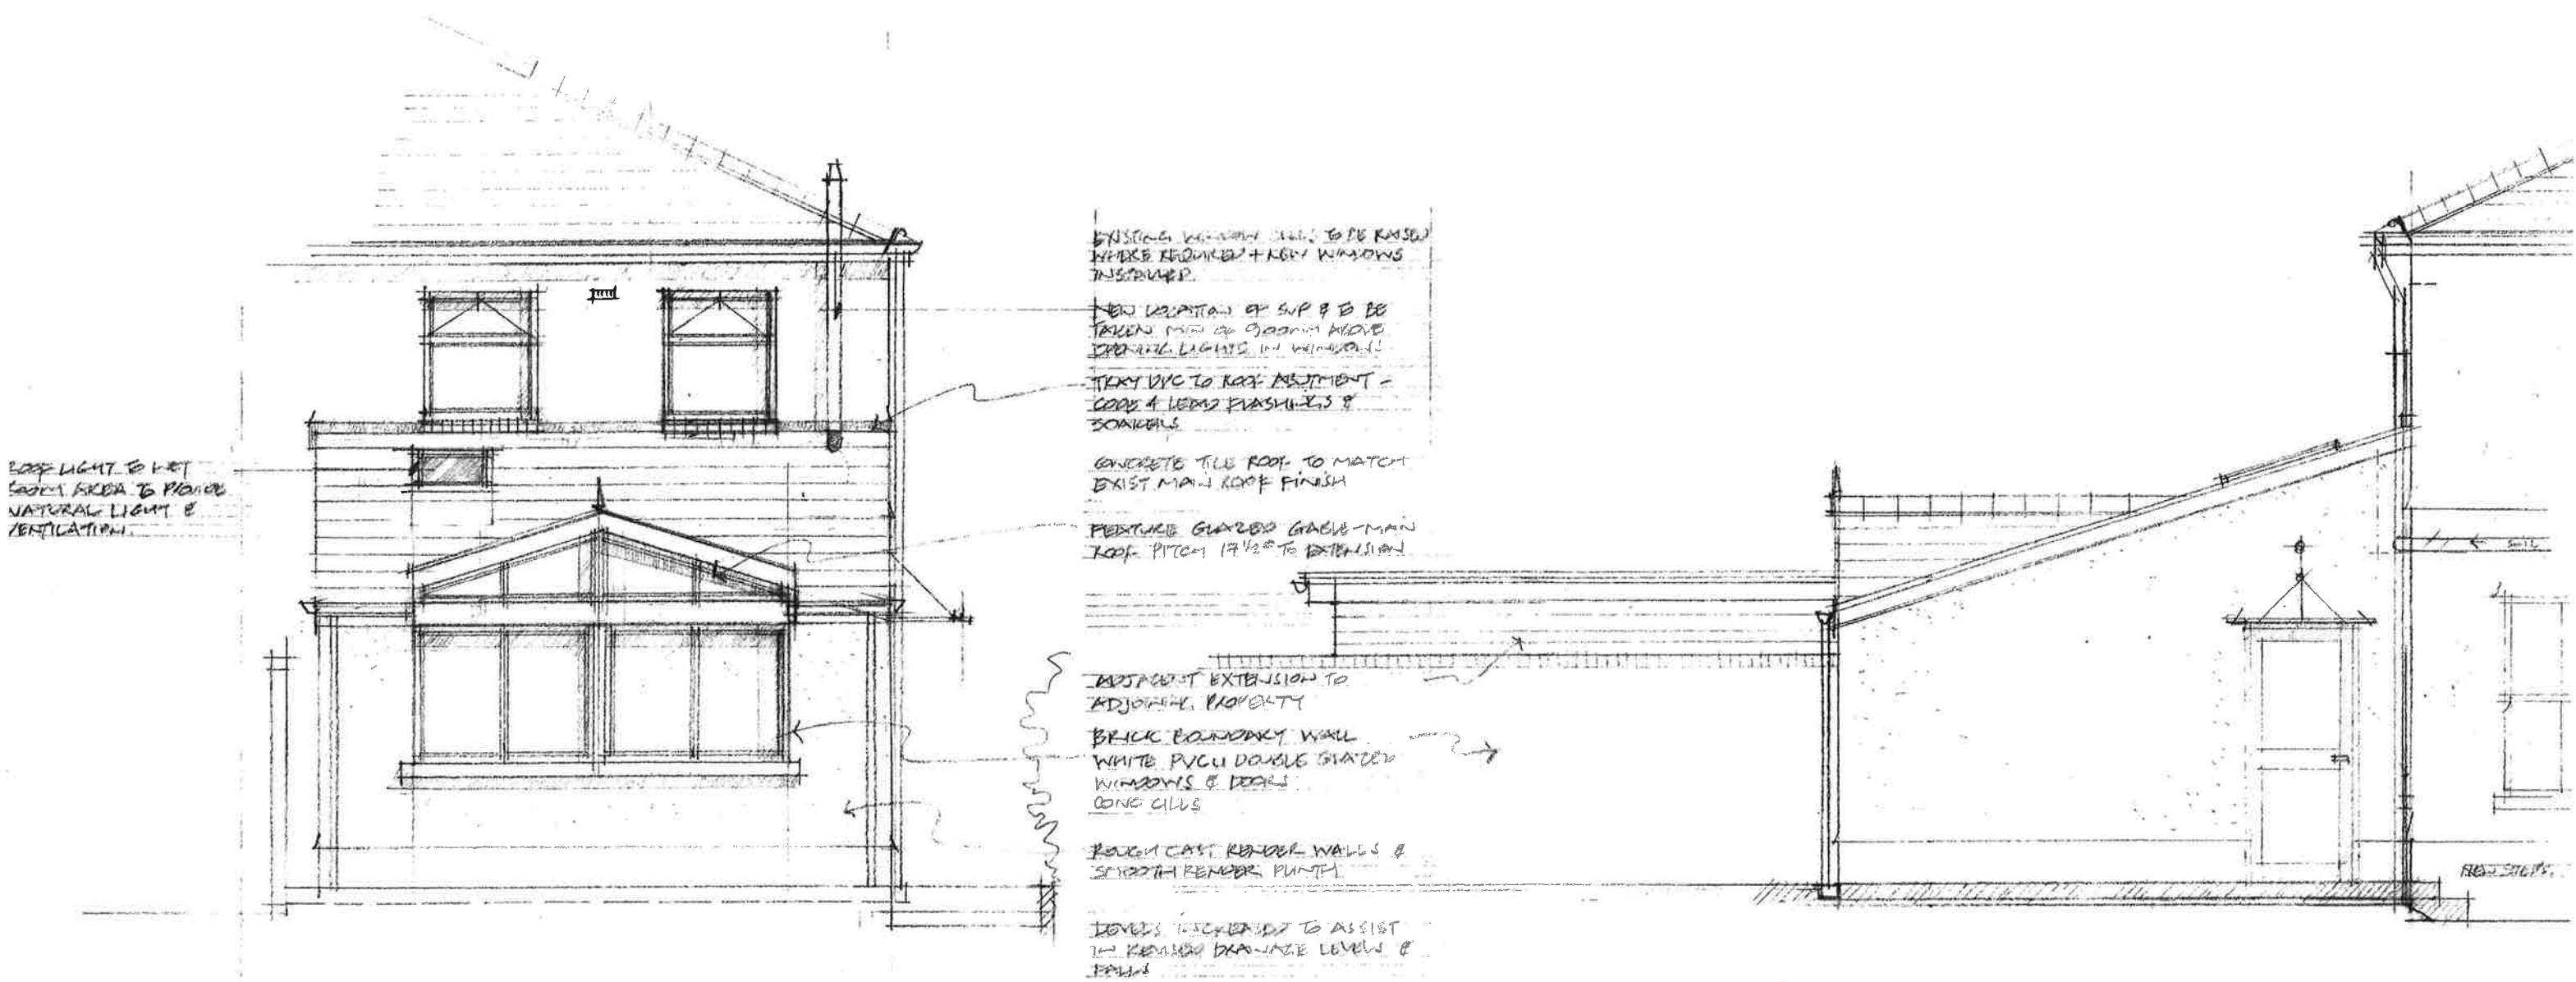

PROPOSED REAR ELEVATION 'AS BUILT' ~ SCALE 1:50 @ A3.

STUART BENTLEY BA(HONS), ARCHT., BARCH (WALES) ARCHITECTURAL & DESIGN CONSULTANT.

PROPOSED SIDE ELEVATION ~ SCALE 1:50 @ A3

DRG / PRP / ELEVS / DL.