


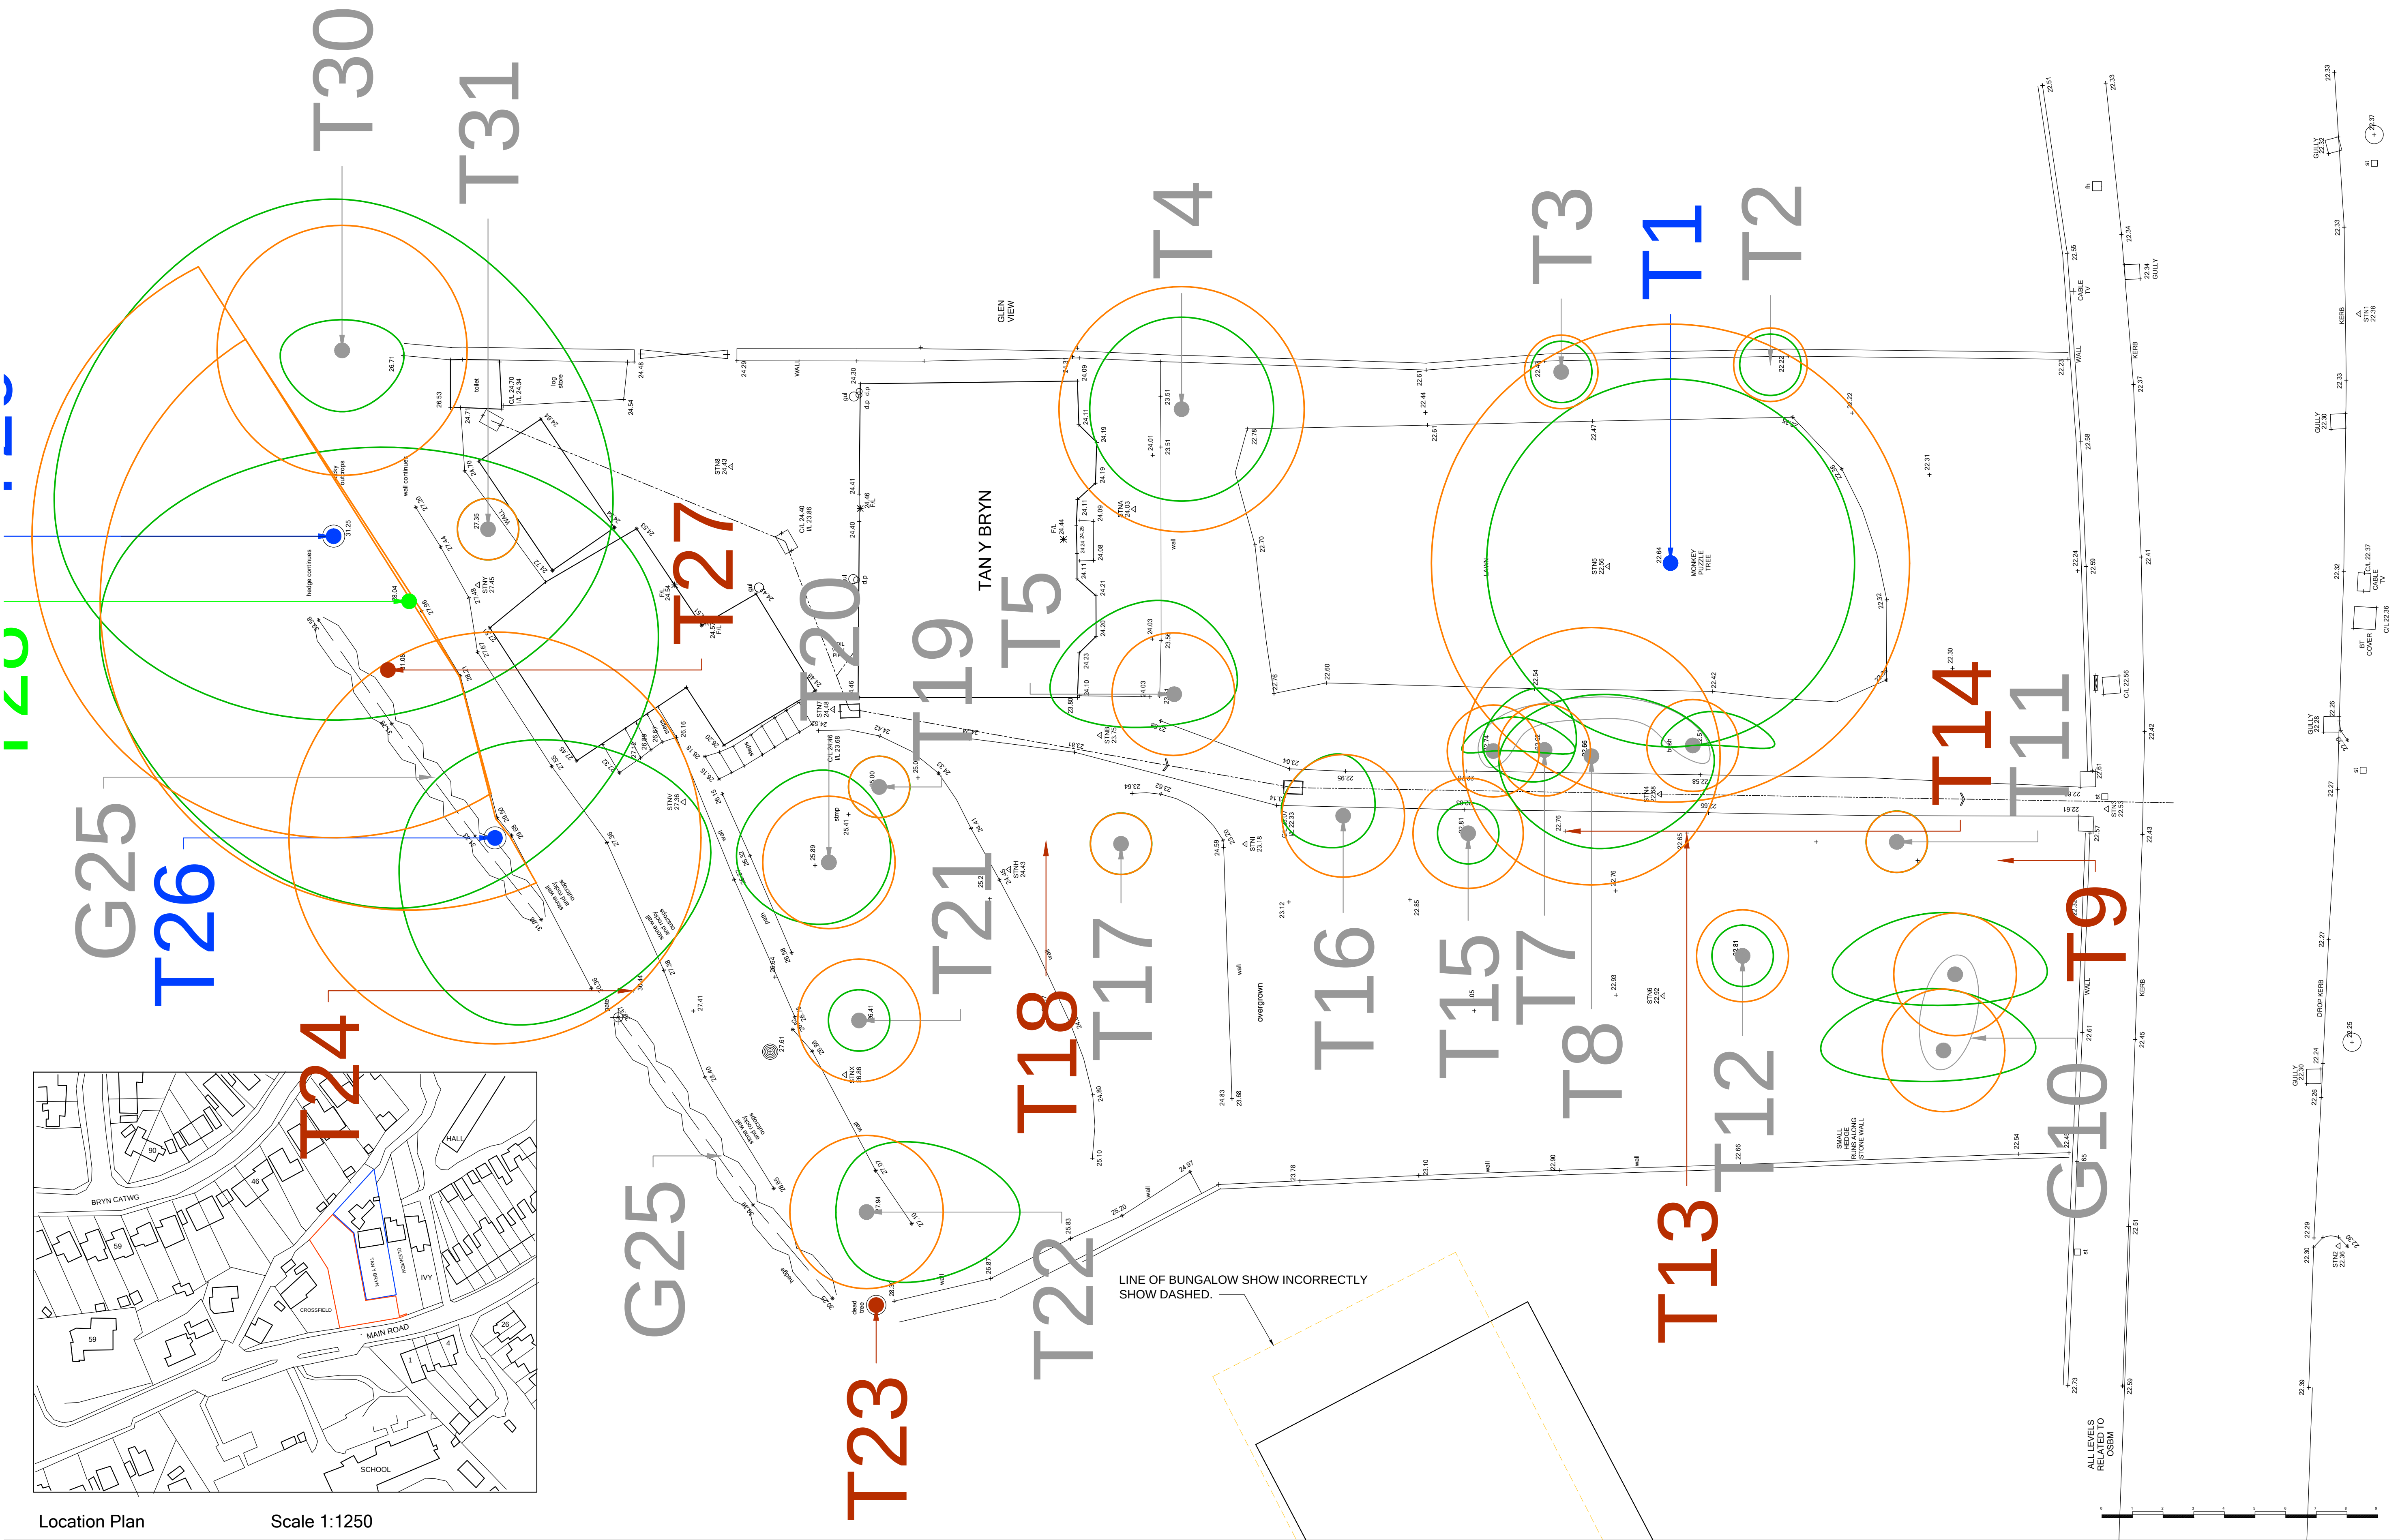

Location Plan Scale 1:1250

Do not scale this drawing. Report discrepancies in figured dimensions to the author. The drawing is copyright.	Revisions:		CHK: RWJ RWJ
	Rev No.	Date:	
	A	041119	
	B	060520	
	Revision:		
ADJOINING BUNGALOW POSITION MOVED			
LOCATION RED LINE ALTERED			
Title: Survey and Location Plan			
Scale: 1:100 Date: 05/2020			Drawn: RWJ Checked: RWJ
Project No. 4389			Drawing No. (P)01
			Rev. B

Project:
PROPOSED DETACHED HOUSE
TAN Y BRYN, MAIN ROAD.
CADOXTON.
NEATH. SA10 8BL.

BEACON ARCHITECTURAL SERVICES

Chartered Institute of
Architectural Technologists
Registered Practice

BEACON ARCHITECTURAL SERVICES - TY MONDAS TRECANGLE BRECON LD3 8UH - TEL: 01874 638082 - MOB: 07792695996