



Existing Front Elevation




Proposed Front Elevation (As-built)

Note:-

- All dimensions are approximate and should be checked on site, with discrepancies reported.

Planning Finishes

- New external walls to be constructed using facing brickwork to match existing.
- New window to be wood grain upvc to match existing.

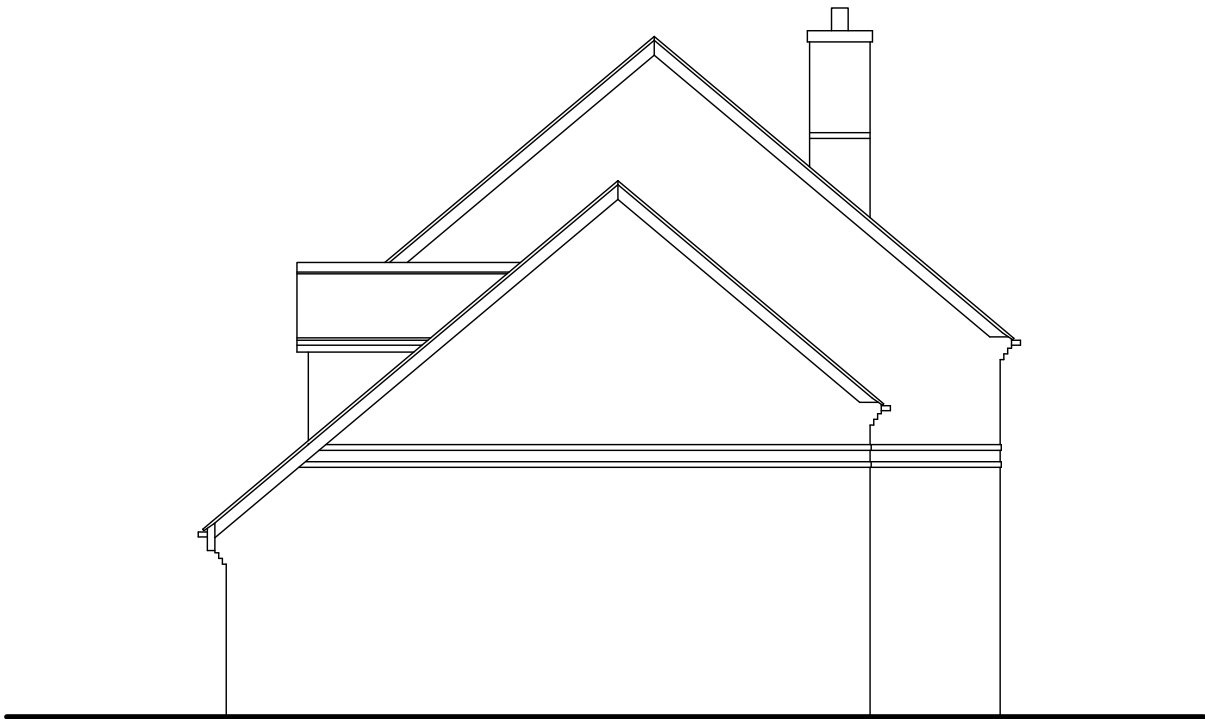

Existing End Elevation (no change)



Existing Side Elevation (no change)

Client:- Mr & Mrs Redwood 1, The Avenue, Neath. SA11 2FD		Job Title :- Proposed conversion garage at 1, The Avenue, Neath. SA11 2FD		Dwg Title:- Elevations as Existing & Proposed	
Scale:- 1:100	Date :- February 2021	Stage :- Planning	Dwg No.:- P03	Rev.:- -	A3