
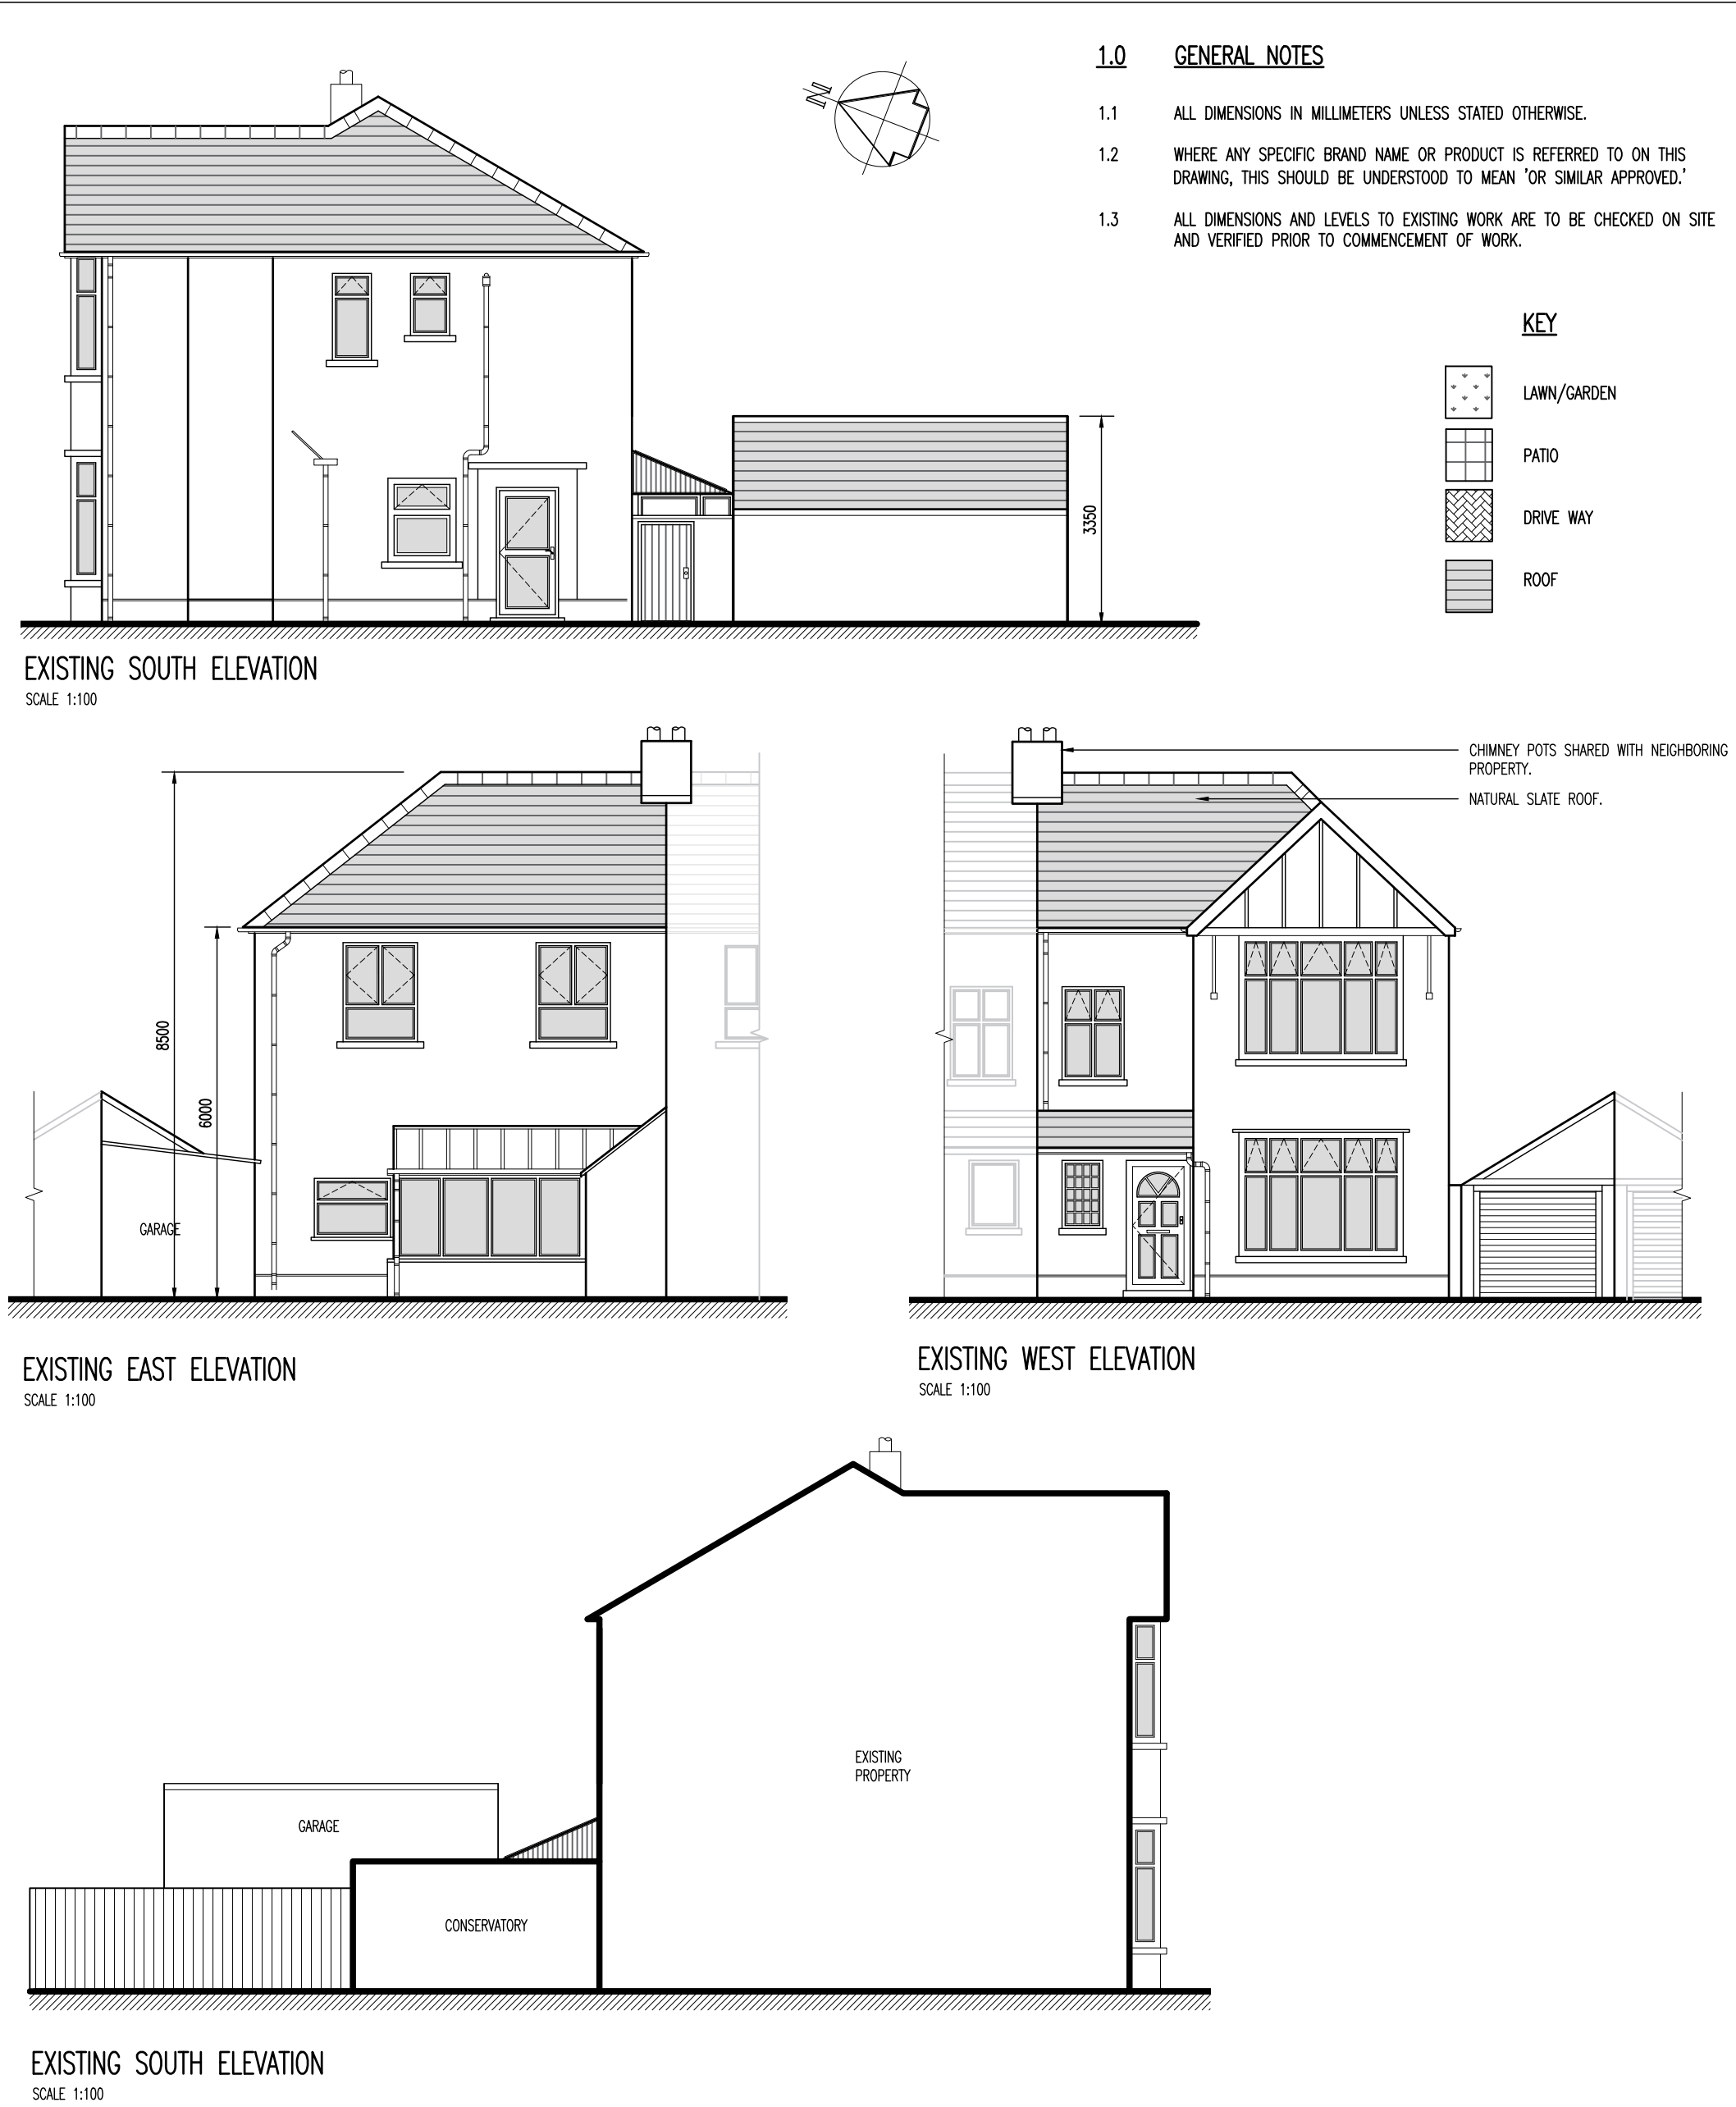


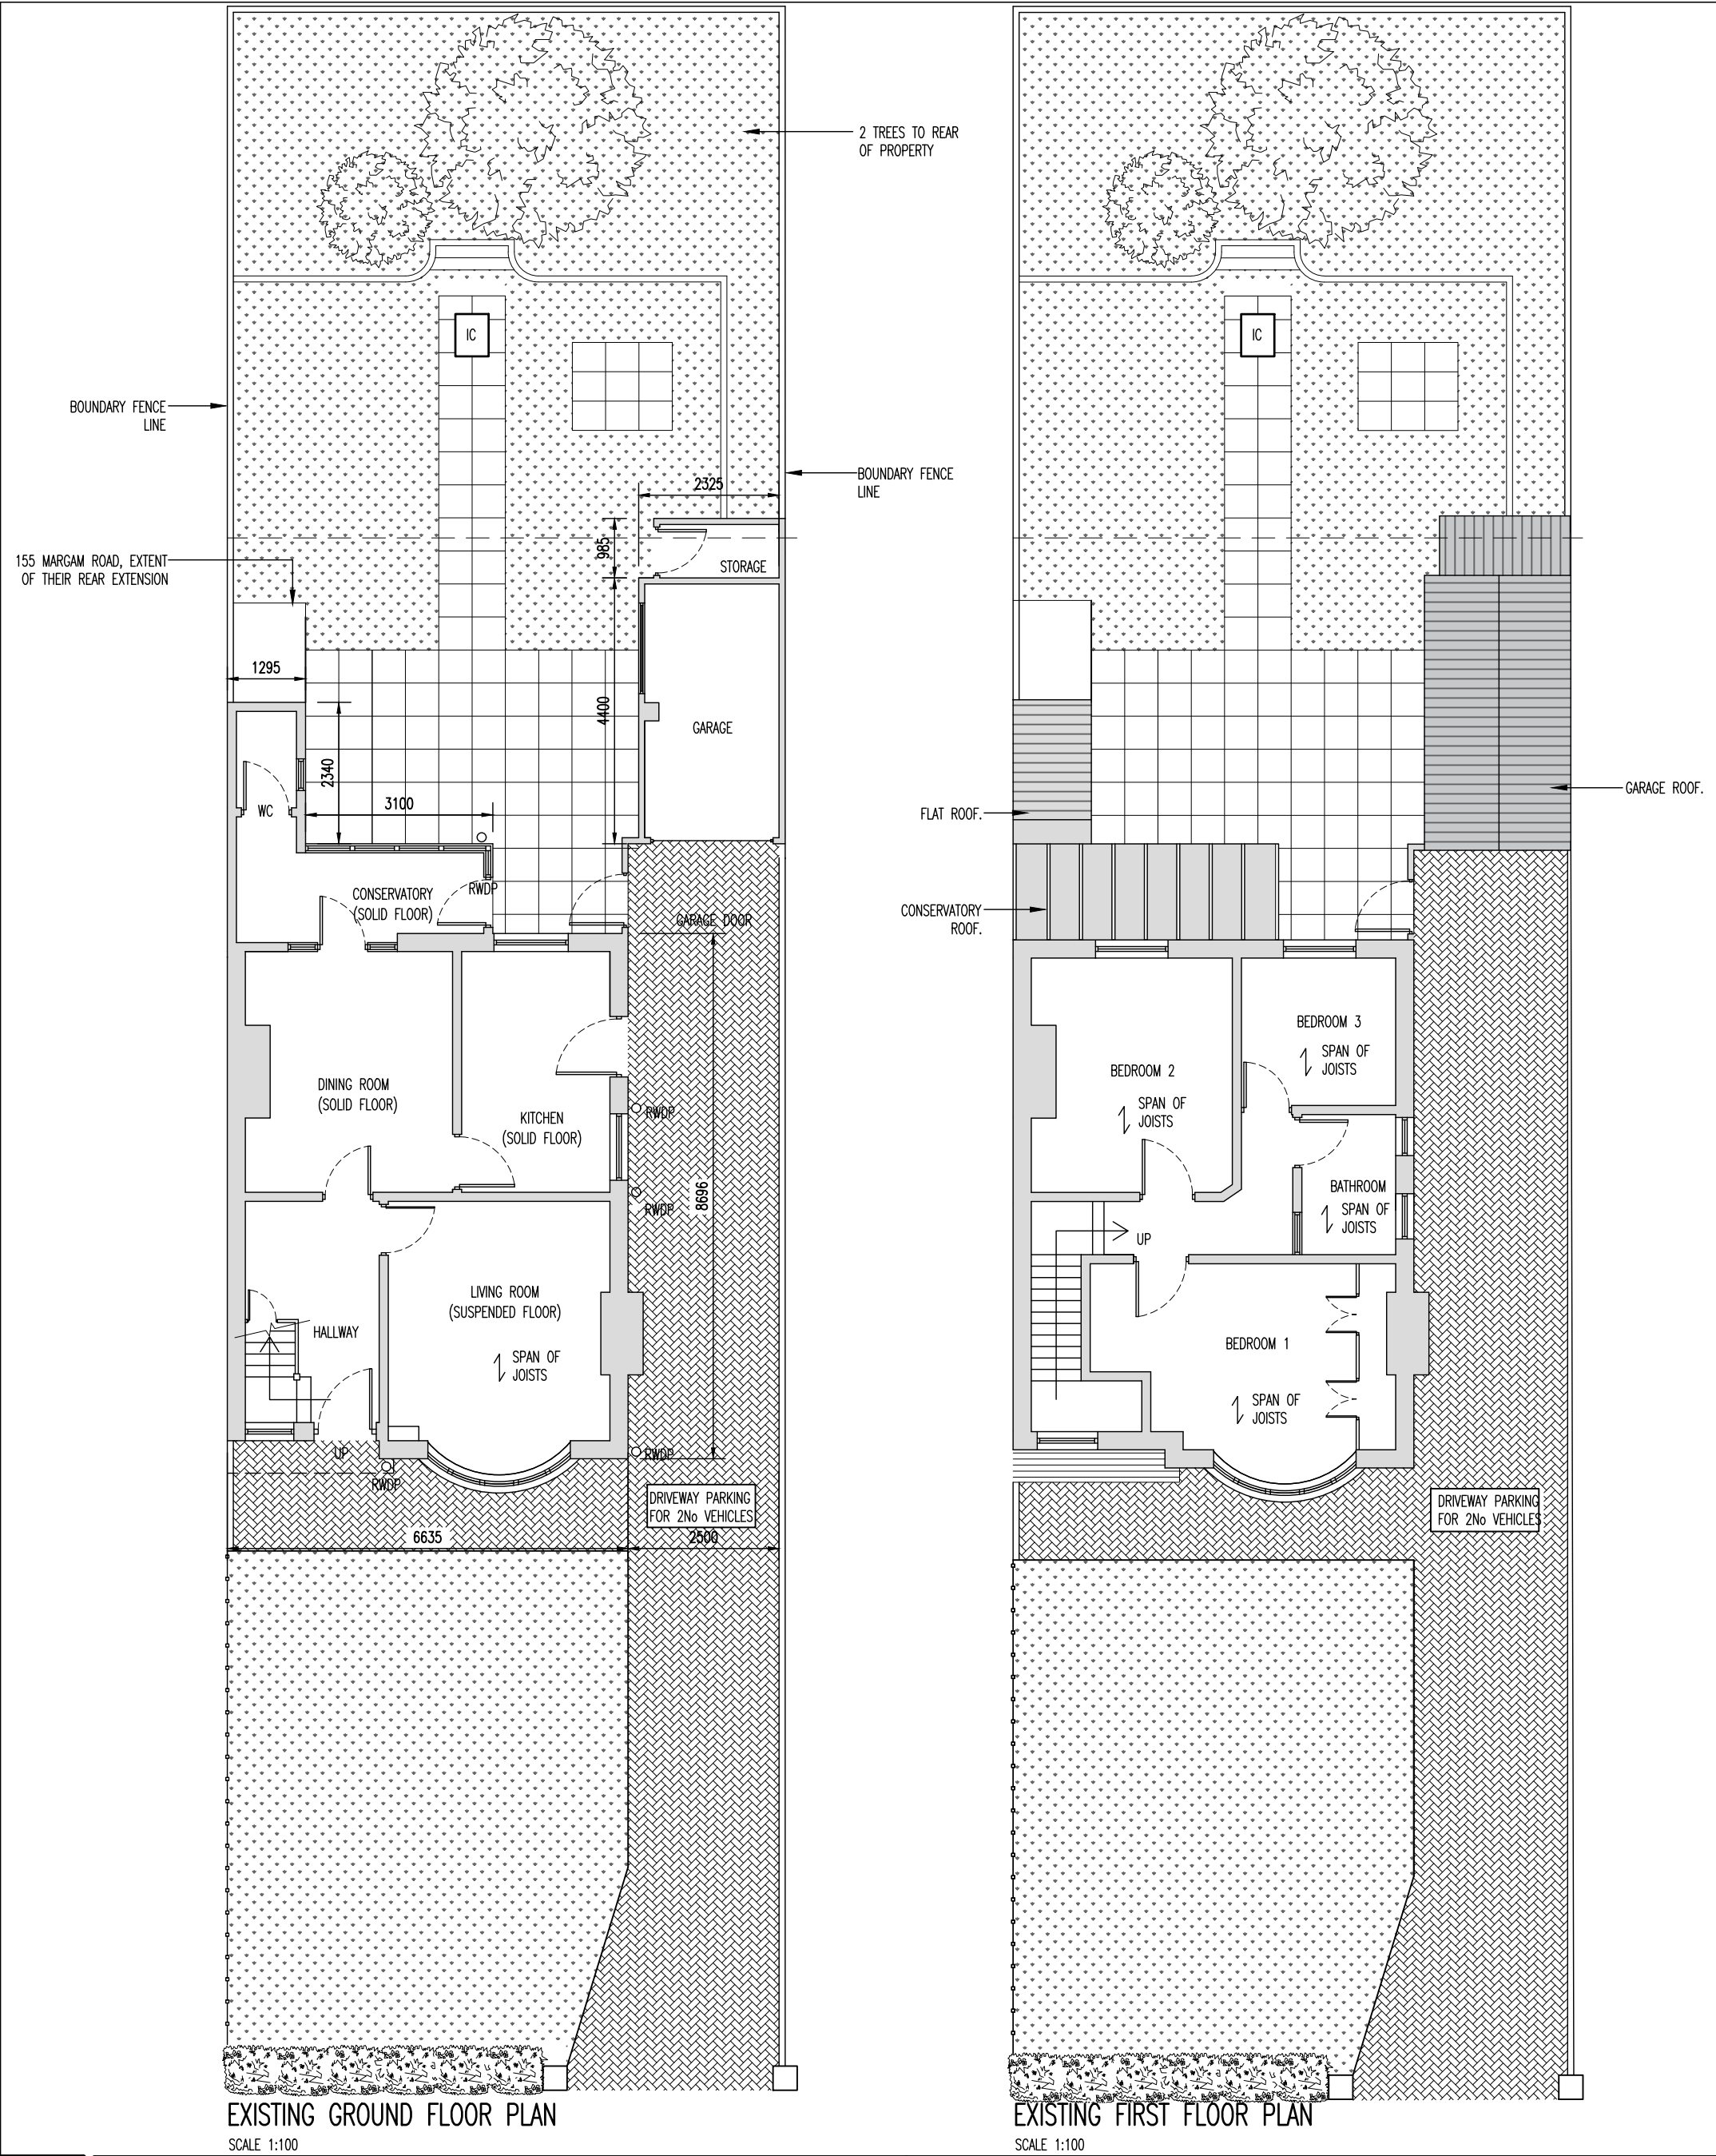

Rev.	No.	REVISION	by	date	No.	REVISION	by	date
C	A	FRONT GARDEN ADDED, PROPERTY LINE TO REAR OF PROPERTY AMENDED	JOH	30.03.21				
	B	DRAWING UPDATED TO REFLECT CLIENT COMMENTS	JOH	21.04.21				
	C	DRAWING UPDATED TO REFLECT CLIENT COMMENTS	LT	05.05.21				

NOTES
1 Do not scale from this drawing
2 All dimensions to be checked on site
3 'As built' drawings are prepared, in part, based upon information furnished by others. While this information is believed to be reliable, James & Nicholas LLP assume no responsibility for the accuracy of 'As built' drawings or for any errors or omissions that may have been incorporated into them as a result of incorrect information provided to us by others. Those relying on an 'As built' drawing are advised to obtain independent verification of its accuracy.
STAGE
PRELIMINARY

CLIENT
MS. KATIE JOHN

james&nicholas

Grove House, Grove Place, Port Talbot SA13 1XA • Tel 01639 885431 • Fax 01639 891687
admin@jamesandnicholas.com • www.jamesandnicholas.com
James & Nicholas Limited Liability Partnership. Registered in the UK No. OC303071

Job title

EXTENSION AND REFURBISHMENT WORKS, AT 157
MARGAM ROAD, PORT TALBOT.

Drawing title

EXISTING FLOOR PLANS AND ELEVATIONS

by

checked

approved

J.M.

J.E.H.

J.E.H.

date

15.02.21

15.02.21

15.02.21

Job No:

21.17

Drawing No:

A01

Rev:

C

scales: 1:100, 1:1250 @ A2

COPYRIGHT

