


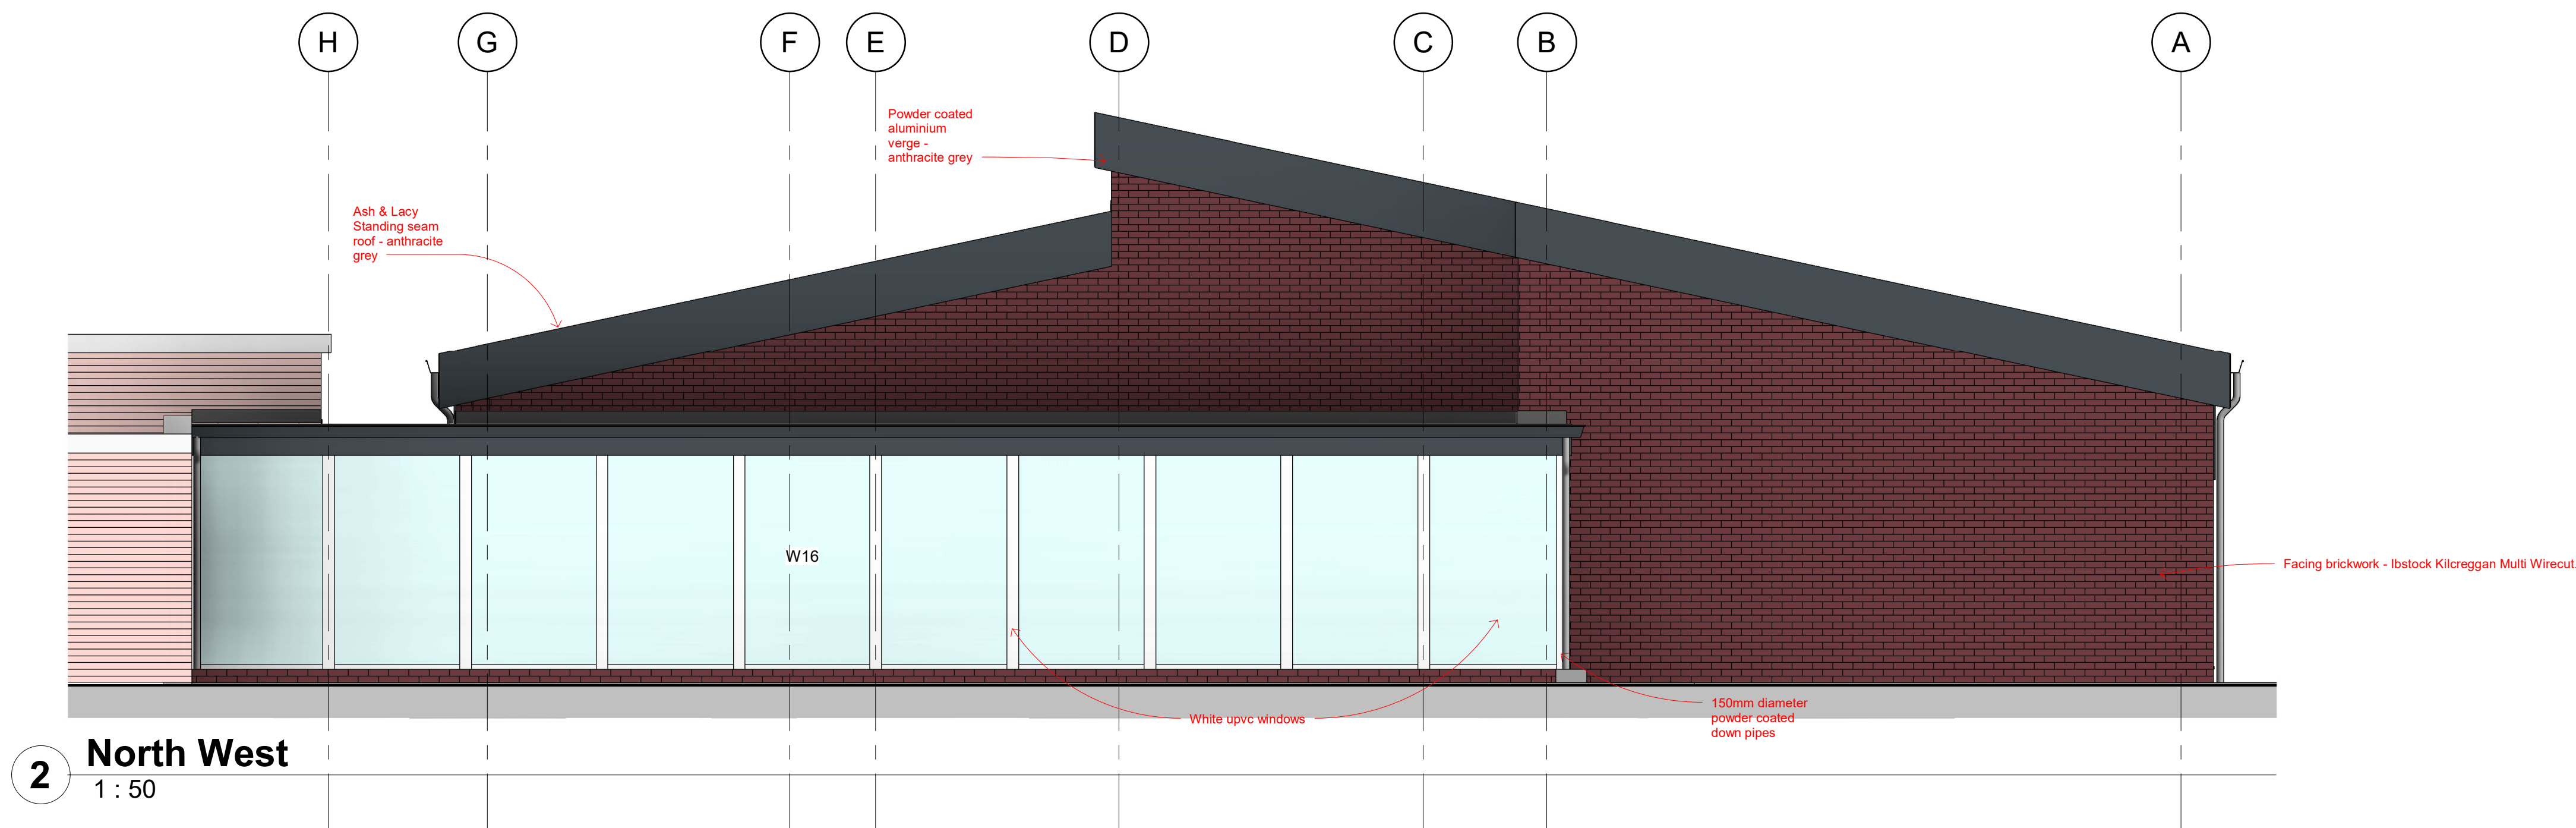

N.B. See drawing 06b for glazing manifestation zones

B.I.M. Drawing Reference	
-03	

Only use figured dimensions. Any discrepancies must be reported to Lewis Partnership Limited. The copyright of this drawing remains the property of Lewis Partnership Limited. Lewis Partnership Limited, registered in Wales, reg no. 3913005

59443/A/0001/UK/EN

13 Park Crescent LLANELLI Carmarthenshire SA15 3AE
01554 777998
enquiries@lewispartnership.co.uk
WWW.lewispartnership.co.uk

RIBA

Chartered Practice

RIBA no. 279554

Rev

Amendments

Date

Ckd By

A

High level window positions altered

01/10/20

pl

B

Update re latest Structural Model

16/10/20

pl

C

Cladding changed to RAL 7016

29/07/21

pl

LEWIS PARTNERSHIP

architects - penseiri

Rev

Amendments

Date

Ckd By

D

Fascias, soffits, verge boards, rups changed to anthracite grey

03/08/21

pl

E

As Built

05/08/21

pl

Project

Proposed Alterations & Extension

Location : Ysgol Gynradd Gymraeg Rhosafan

Client : TAD Builders Ltd.

Project Number

1996

Drawing Number

03

Rev.

E

Scale

1 : 50

Status

AS BUILT

A1

Date Drawn

07/20

By

pjl

Date Checked

18/09/20

By

cdo