



Proposed new sprinkler tank location

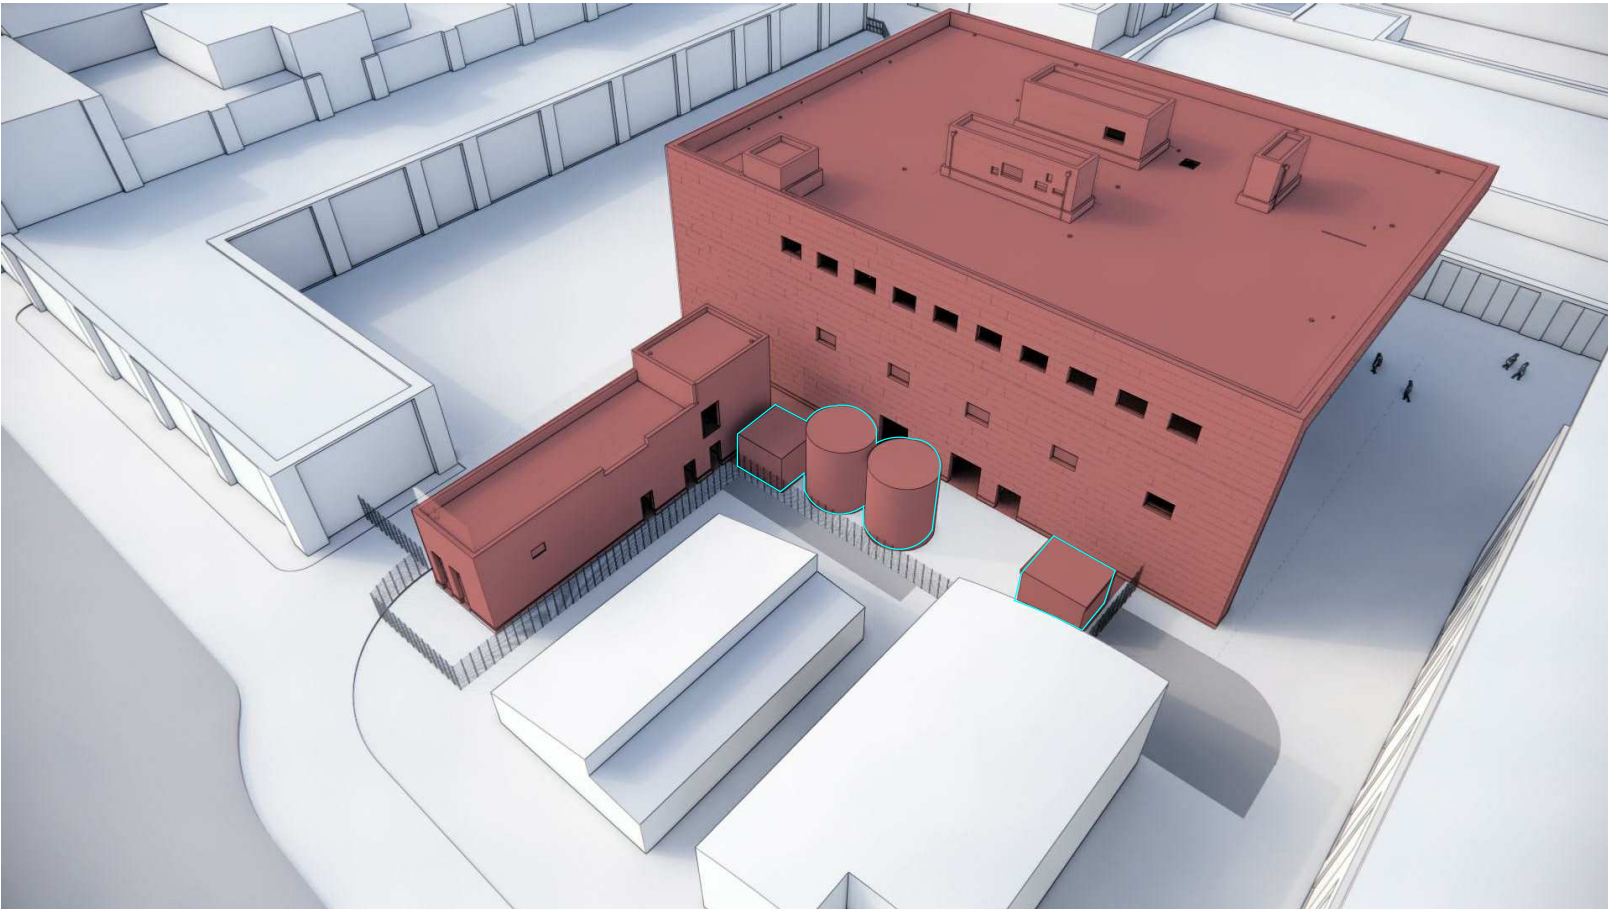

Updated view North East

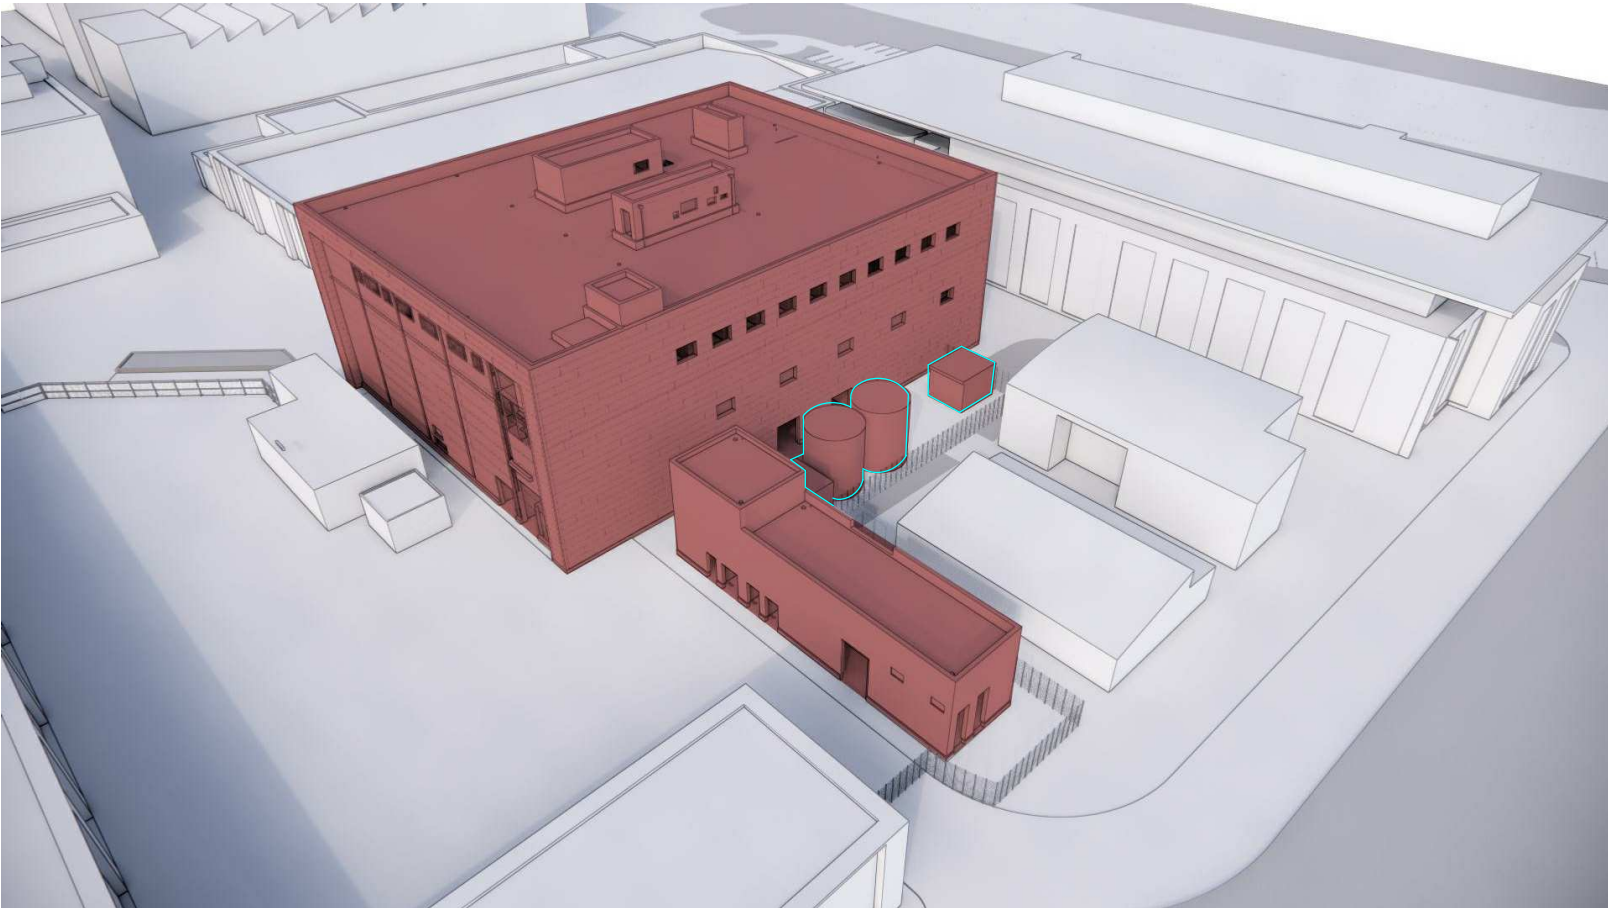

Updated view South East

A	PB1	07.07.21	Red line location updated to reflect new sprinkler pump building location.
STATUS	REV	DATE	DESCRIPTION
CLIENT			REVISD BY
Swansea University			RC
			CHECKED BY
			DS
			ORIGINATOR NO
			152296

CONSULTANT

STRIDE TREGLOWN

www.stridetreglown.com

PROJECT

CISM

SU Bay Campus

© Stride Treglown Limited 2017

DRAWING TITLE

Updated Sprinkler Tank Visual Impact

SUITABILITY STATUS	SCALE
S1 : SUITABLE FOR CO-ORDINATION	@ A3
PROJECT ORIGINATOR ZONE LEVEL TYPE ROLE CLASS. NUMBER	REVISION
CISM-STL-XX-XX-DR-A-ZZZZ-0624	PB1