
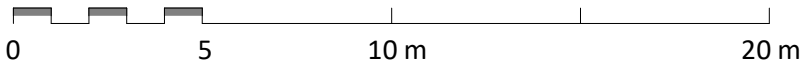
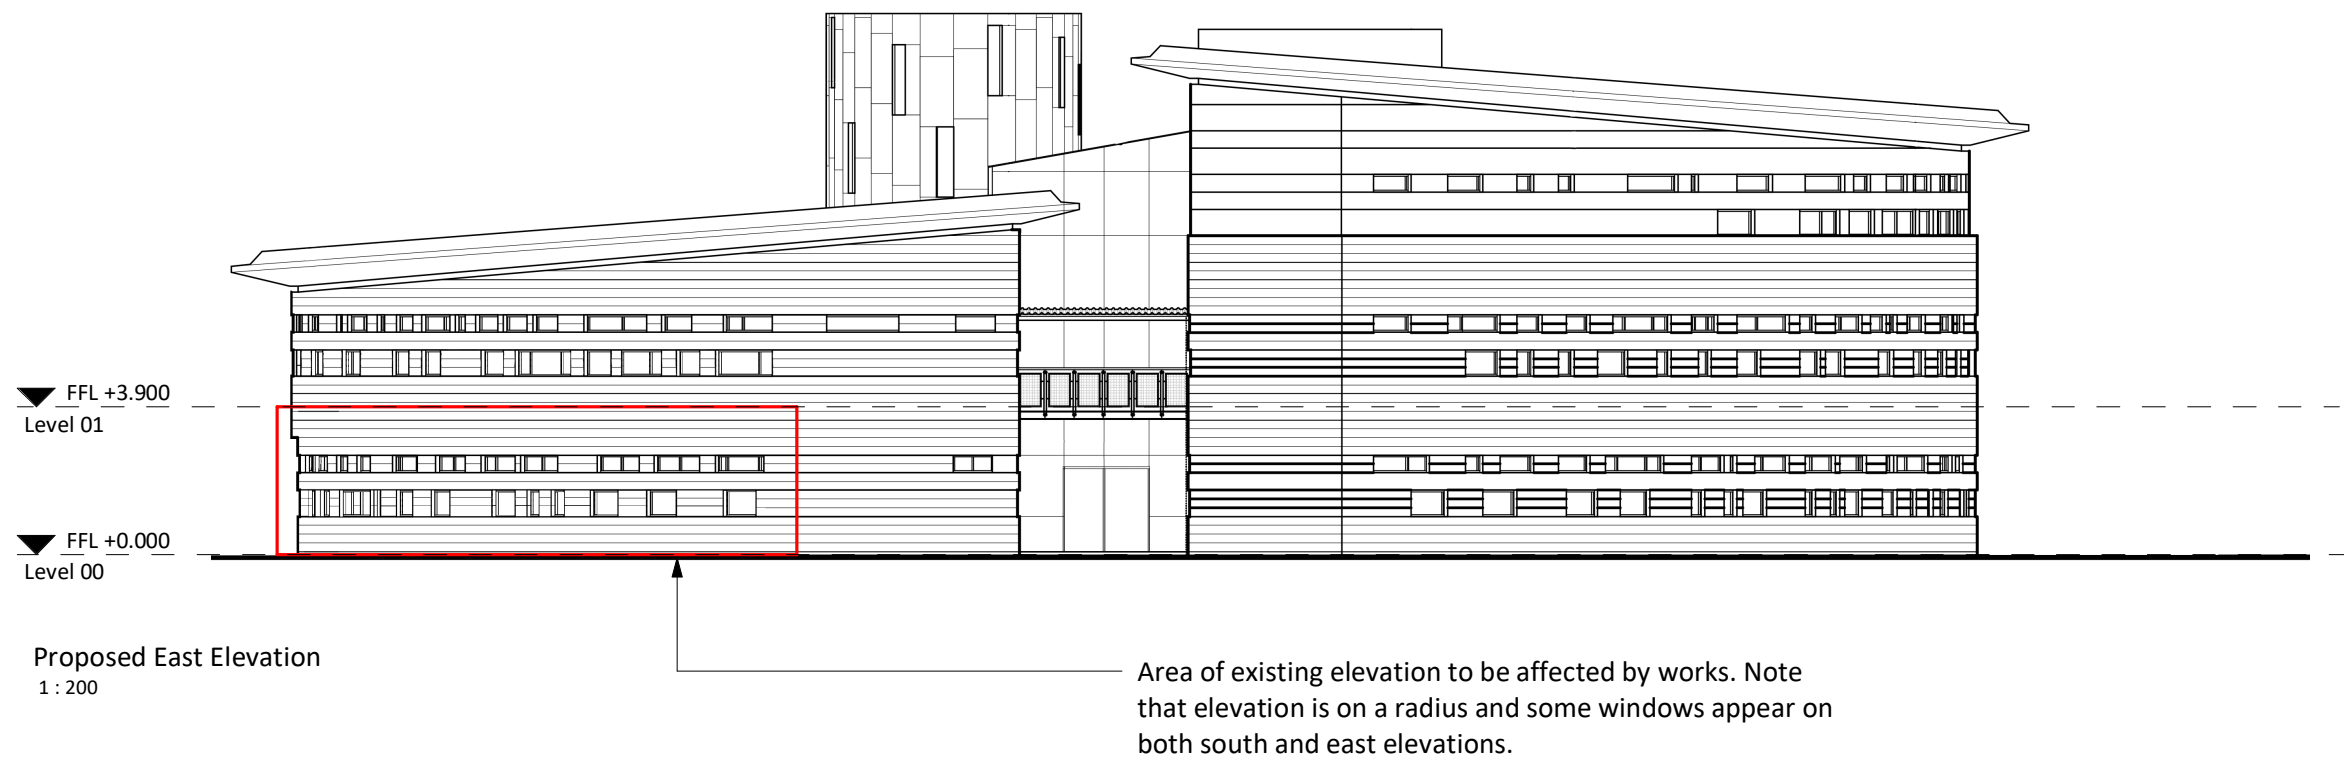


GENERAL DRAWING NOTE:

- This is not a Stride Treglown drawing, but a record drawing supplied by Swansea Bay University Health Board, for information only.
- Stride Treglown accept no responsibility for discrepancies made in the production this baseline information.
- This information is provided to indicate design intent only, with regards to obtaining planning permission. Building Control/Fire Officer approval will still be required for these works.
- No responsibility will be taken by Stride Treglown for any information which is scaled from this drawing, particularly with regards to construction information.

STATUS	REV	DATE	DESCRIPTION
PL	P03	211117	Package to Client for Reference
PL	P04	211117	PLANNING APPLICATION DRAWINGS

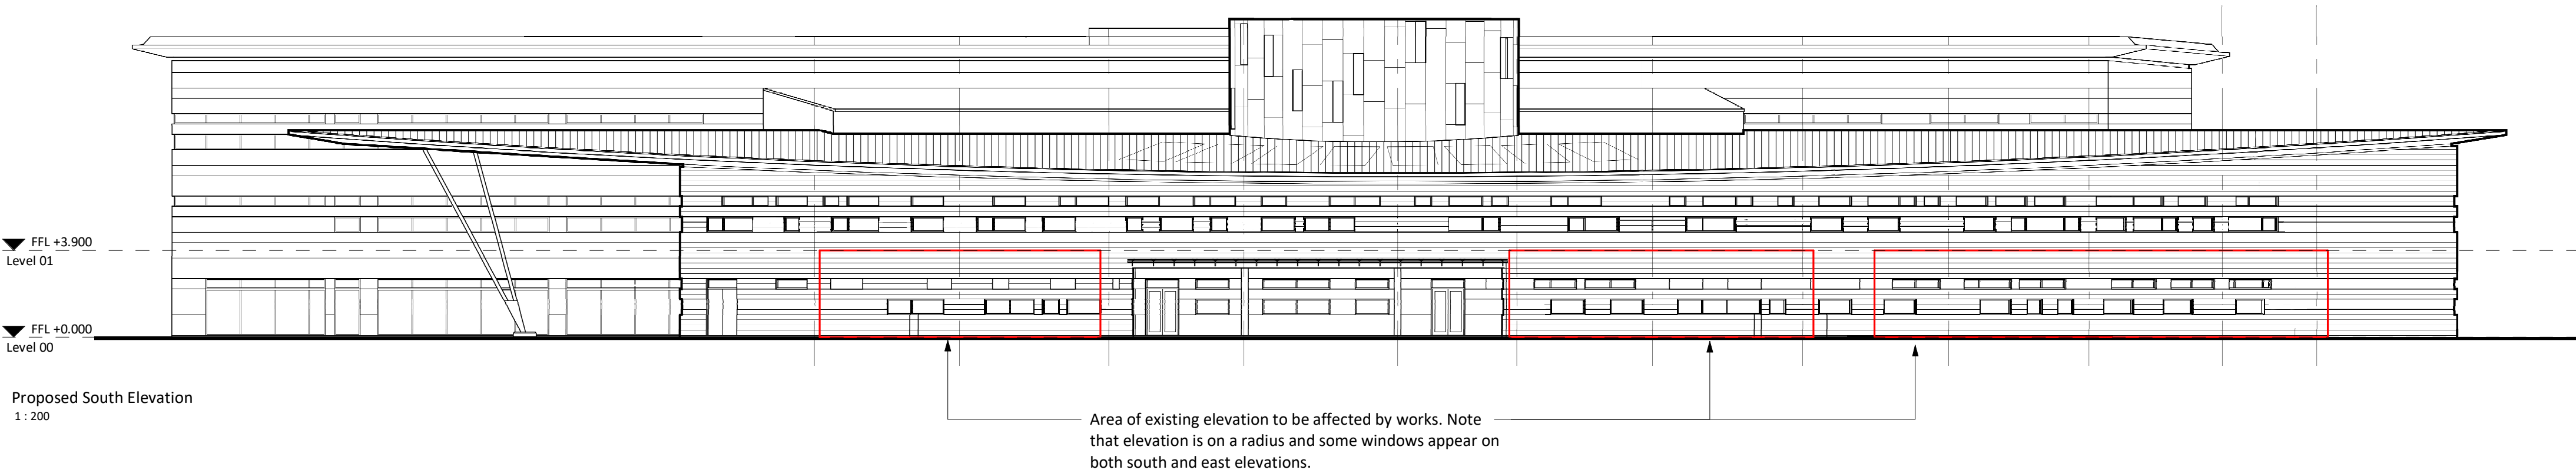

TITLE: Existing Affected Elevations
PROJECT: Neath Port Talbot Resource Centre - Primary Care Centre
CLIENT: Swansea Bay University Health Board

REVISED BY: Chloe Madge
CHECKED BY: Lea Watkins
ORIGINATOR NO: 155109

SUITABILITY STATUS: PL : Authorized and accepted
DRAWING USAGE: Planning
SCALE: 1 : 200@A2

PROJECT - ORIGINATOR - VOLUME - LEVEL - TYPE - ROLE - CLASS. - NUMBER
155109-STL-XX-00-DR-A-XXXX-PL003
STATUS_REVISION: PL_P04