
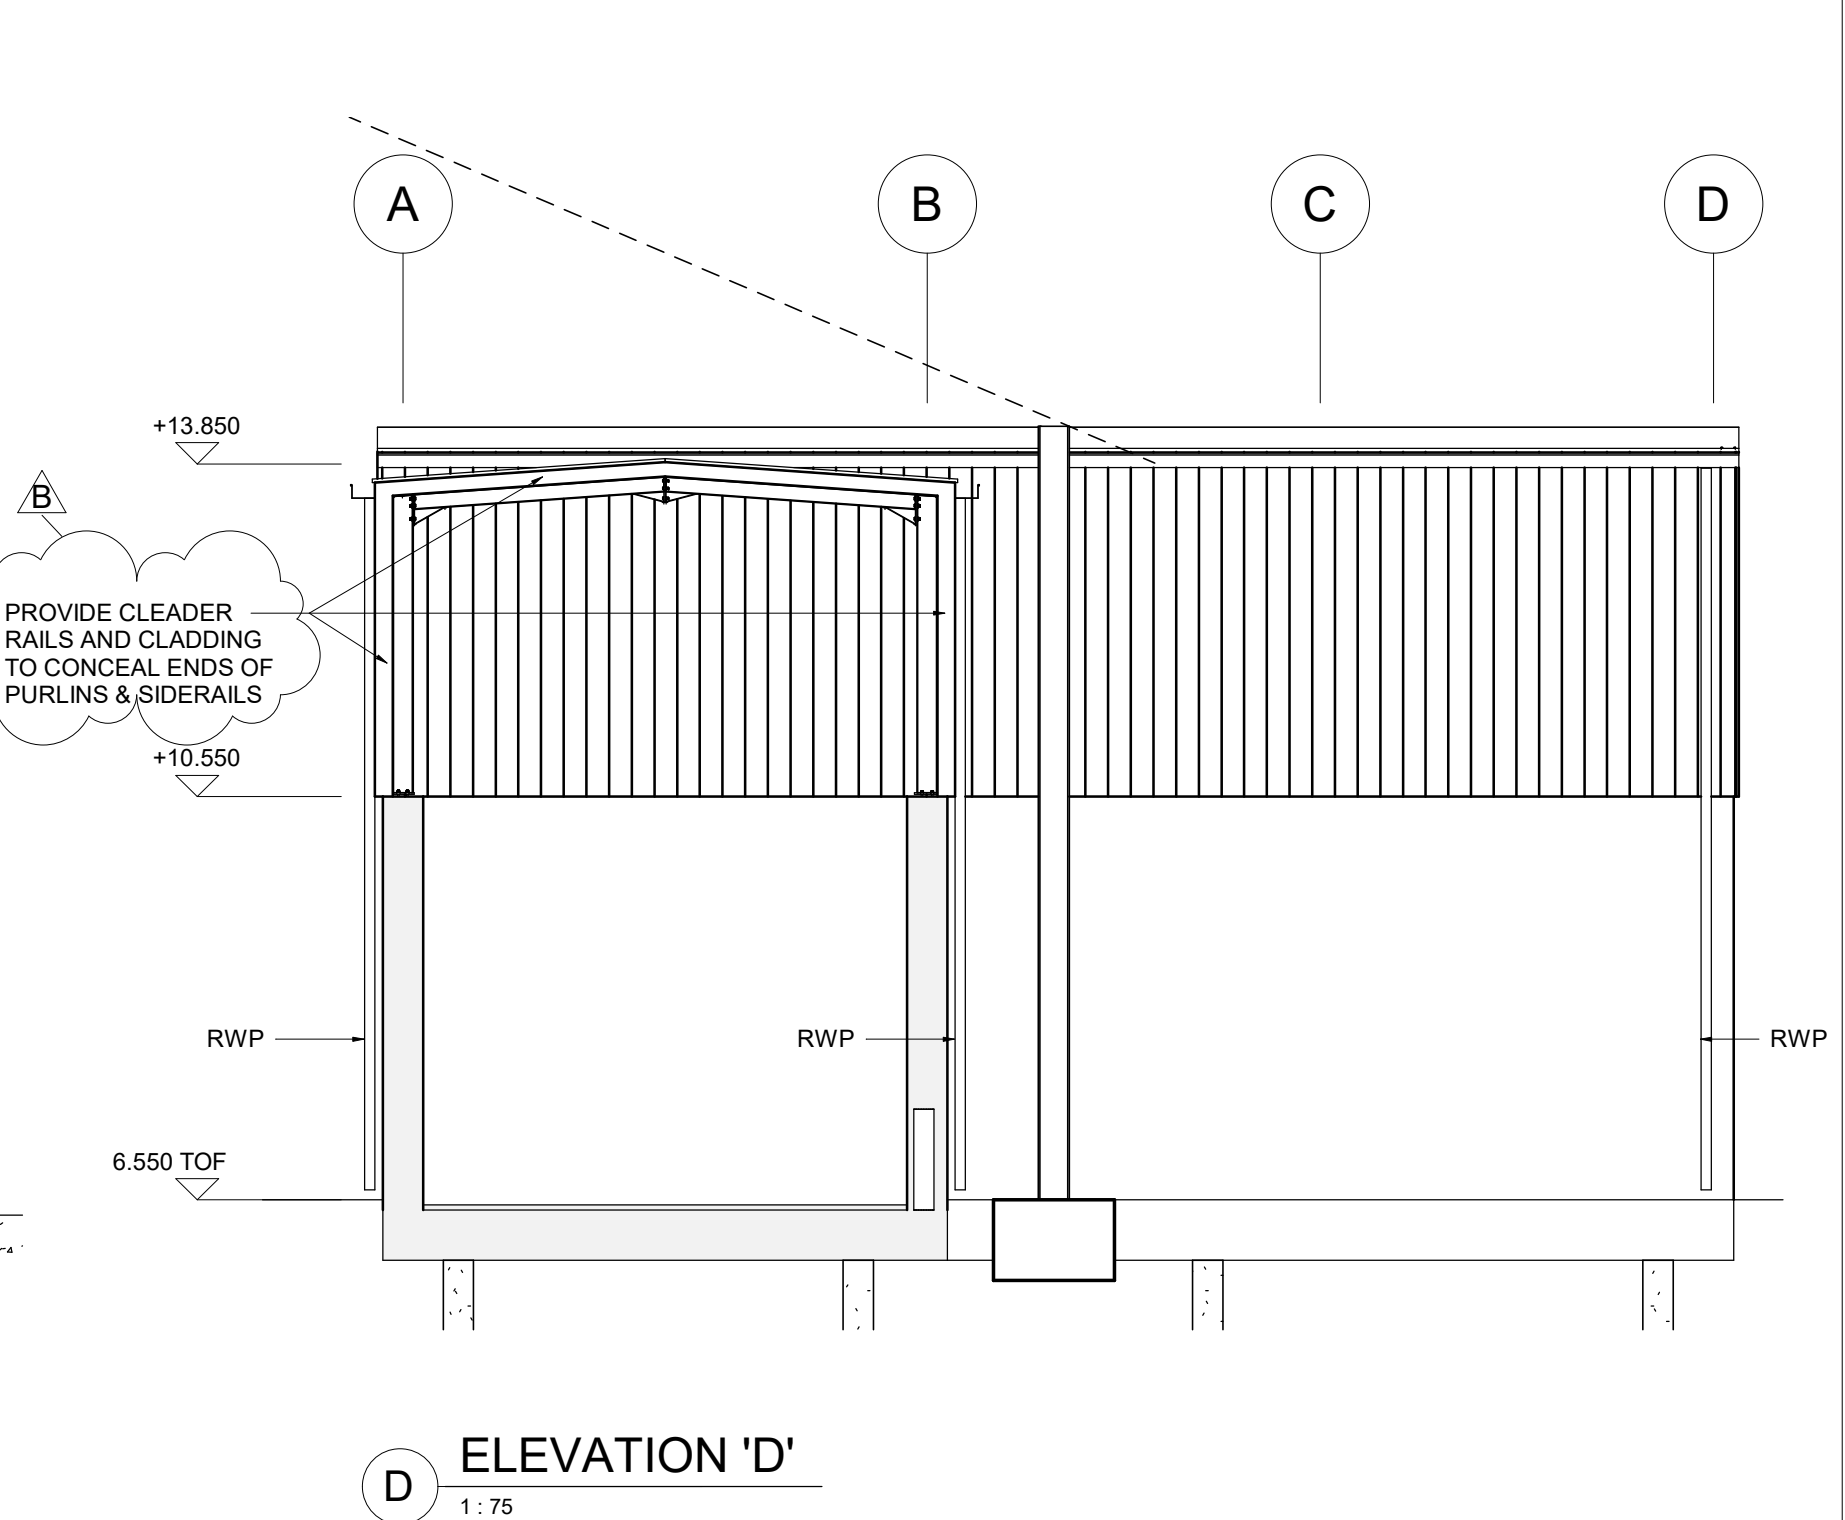
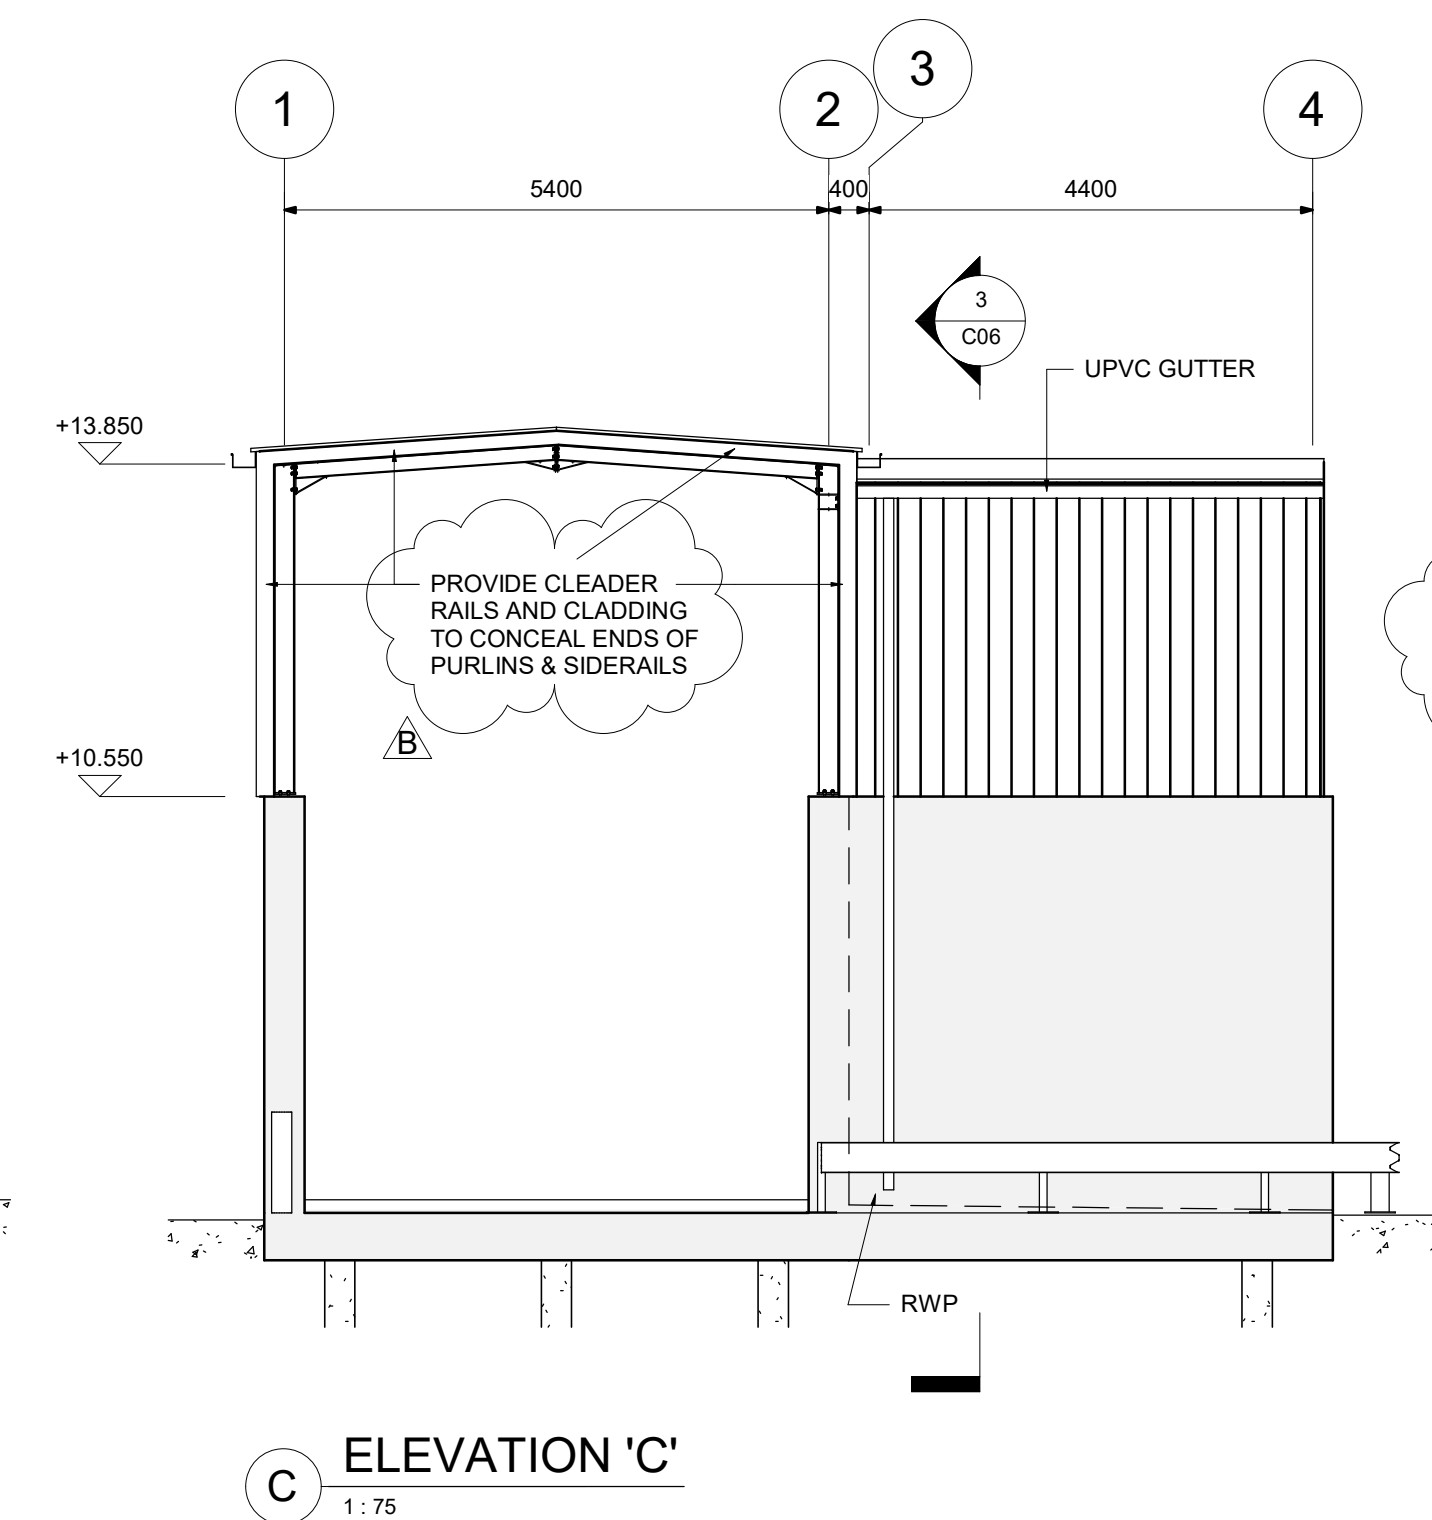
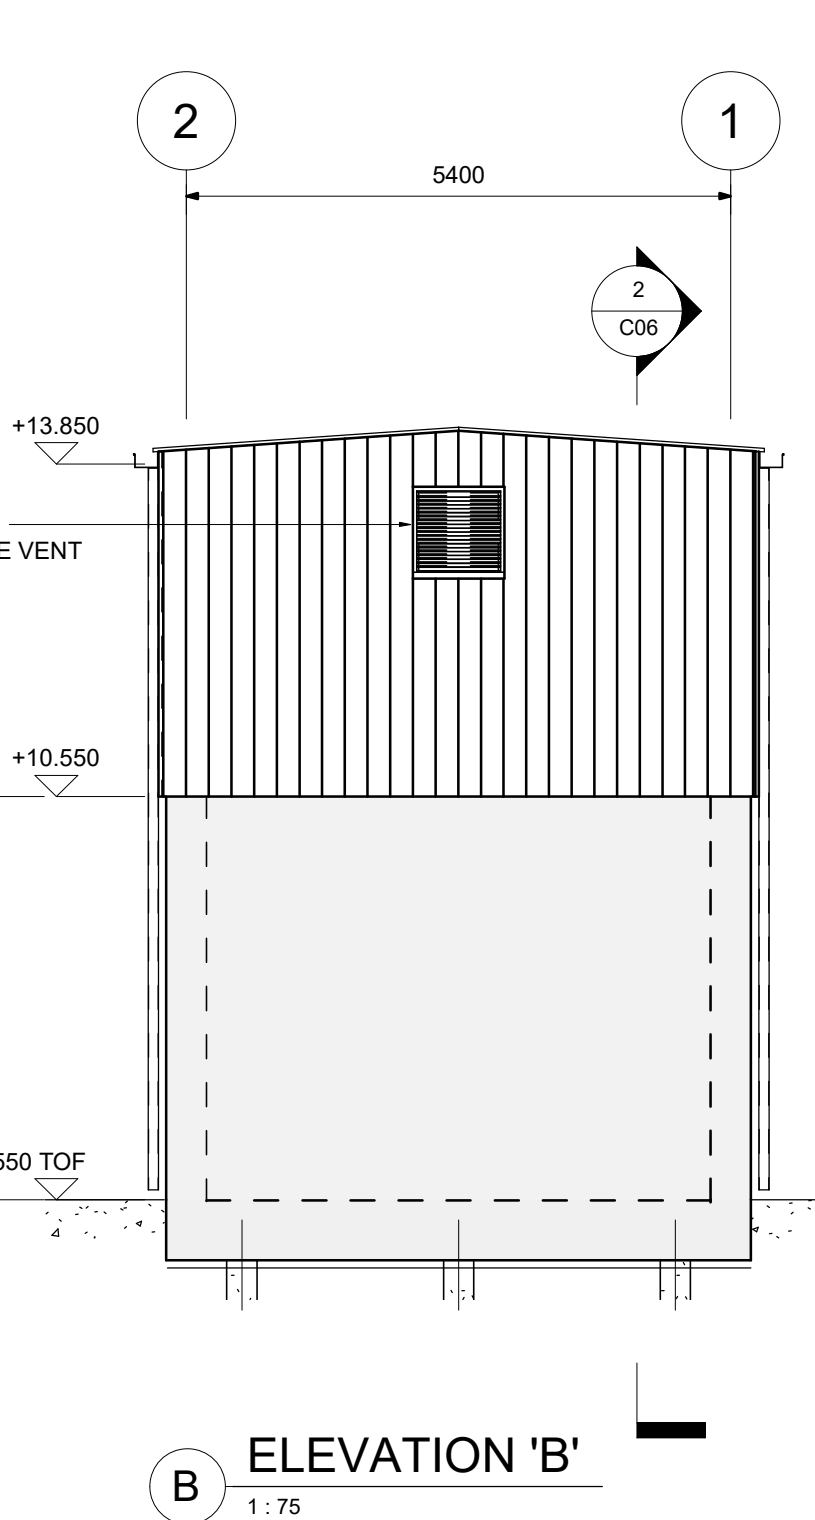
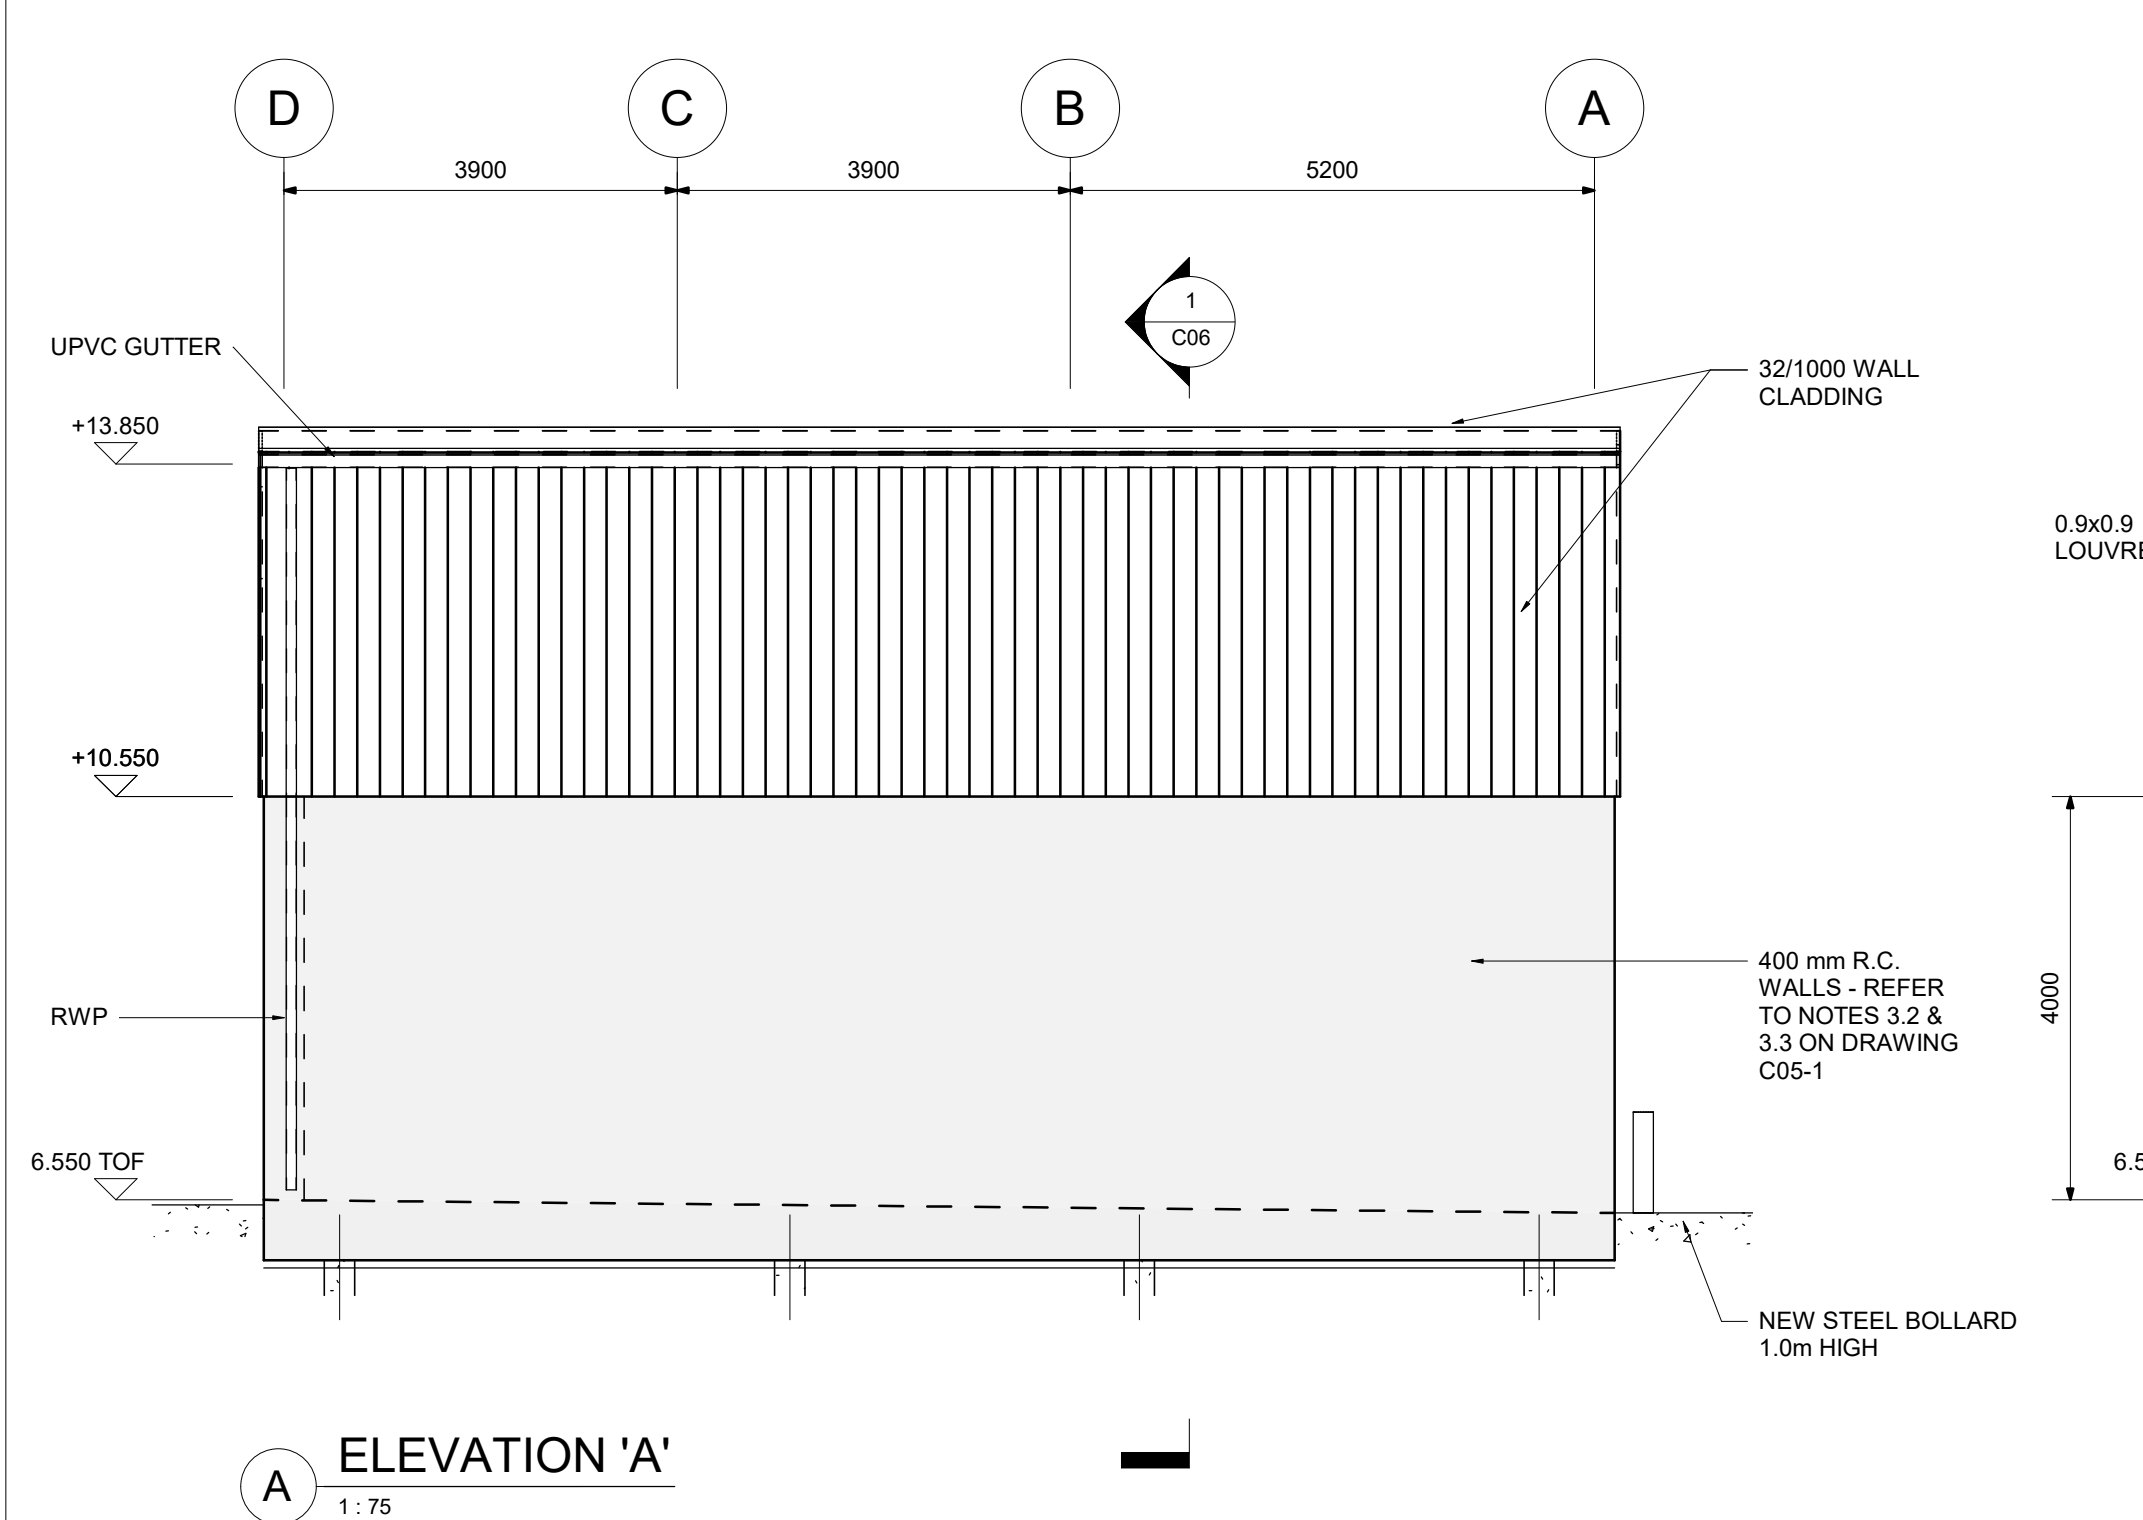


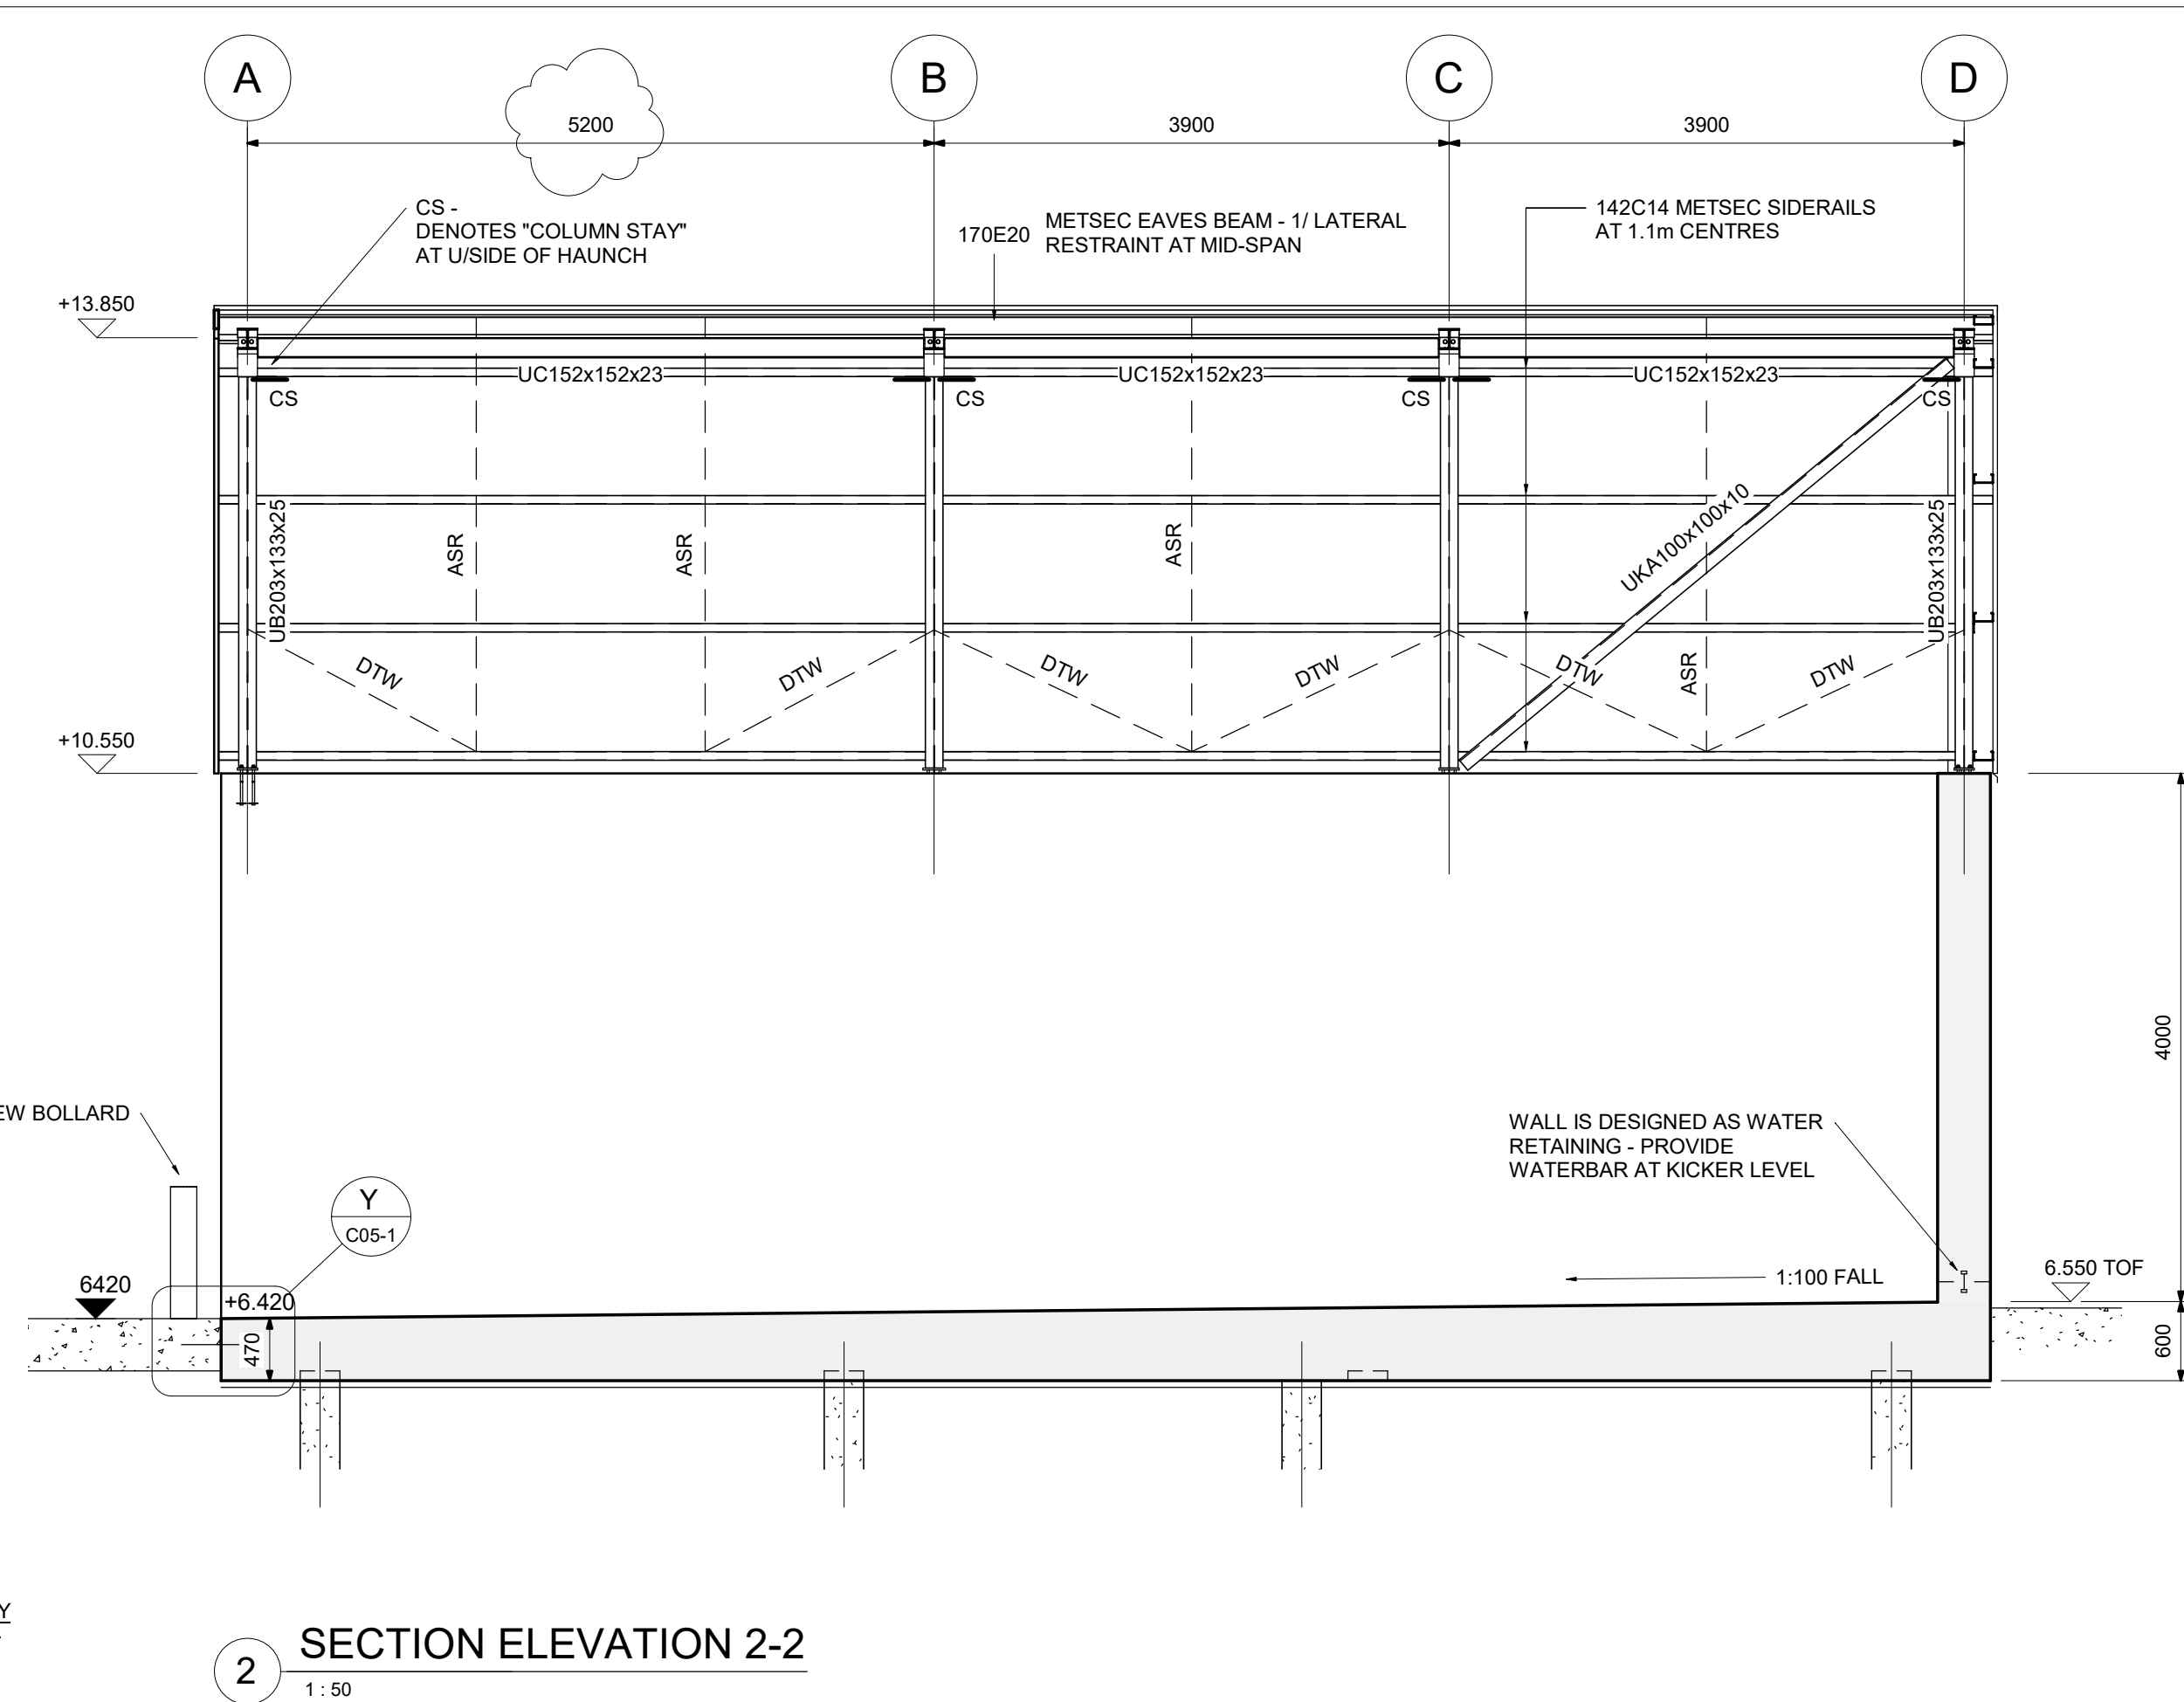

Job No. 21.38	Drawing No. C06	Rev. B	No. REVISION			No. REVISION		
			by	date		by	date	
scales: As indicated			A	COLUMNS CHANGED FROM 152x152x23UC TO 203x133x25UB, 2.0m HIGH STEEL PLATE ADDED TO WALLS OF ASH STORE, STEEL PLATE ADDED TO BASE OF SAMPLING POINT, LOUVER ADDED, DETAILS ADDED, DRAWING ISSUED FOR TENDER.	MW	04.11.21		
			B	PROPOSED SLAB LEVEL NOW SHOWN FLUSH WITH EXISTING CONCRETE SLAB, UPVC GUTTERS AND DOWNPIPES ADDED.	MW	12.11.21		

NOTES

- 1 Do not scale from this drawing
- 2 All dimensions to be checked on site
- 3 All built drawings are prepared, in part, based upon information furnished by others. While this information is believed to be reliable, James & Nicholas LLP assume no responsibility for the accuracy of As built drawings or for any errors or omissions that may have been incorporated into them as a result of incorrect information provided to us by others. Those relying on an As Built drawing are advised to obtain independent verification of its accuracy.

STAGE

TENDER

REFER ALSO TO THE FOLLOWING:
Drawings:
C05-1 FOUNDATION PLAN
C07 STEELWORK PLANS

Bending Schedules:

CLIENT

MANNING
Construction
A Division of Bridgeland Plans Ltd.

james&nicholas

Grove House, Grove Place, Port Talbot SA13 1XA • Telephone 01639 885431 • Fax 01639 891687
Email admin@jamesandnicholas.com • www.jamesandnicholas.com

COPYRIGHT



Job title

New Ash Storage Buildings, Margam Green Energy Park, Mannings

Drawing title

SECONDARY ASH STORE - SECTIONS AND ELEVATIONS

by	date
drawn	1/10
checked	11/11
approved	11/11

Job No:	Drawing No:	Rev:
21.38	C06	B
scales: As indicated		