



~~EXISTING~~ EAST ELEVATION

Scale 1:200

previous



~~PROPOSED~~ EAST ELEVATION

Scale 1:100

Existing

No change needed; only change of use to first floor.



~~EXISTING~~ WEST ELEVATION

Scale 1:200


previous



~~PROPOSED~~ WEST ELEVATION

Scale 1:100


Existing

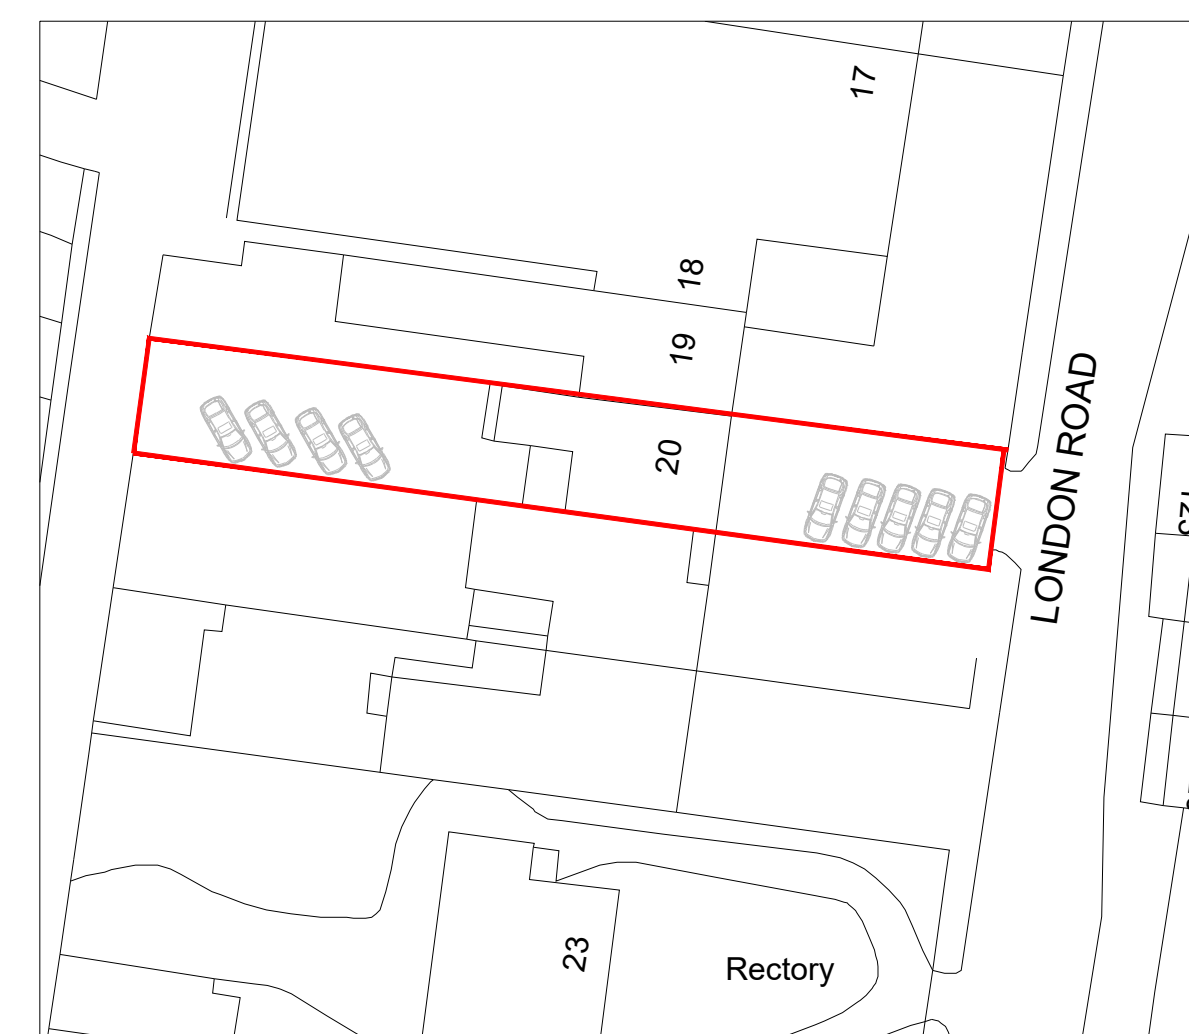

BLOCK PLAN Scale 1:500




LOCATION PLAN Scale 1:2500

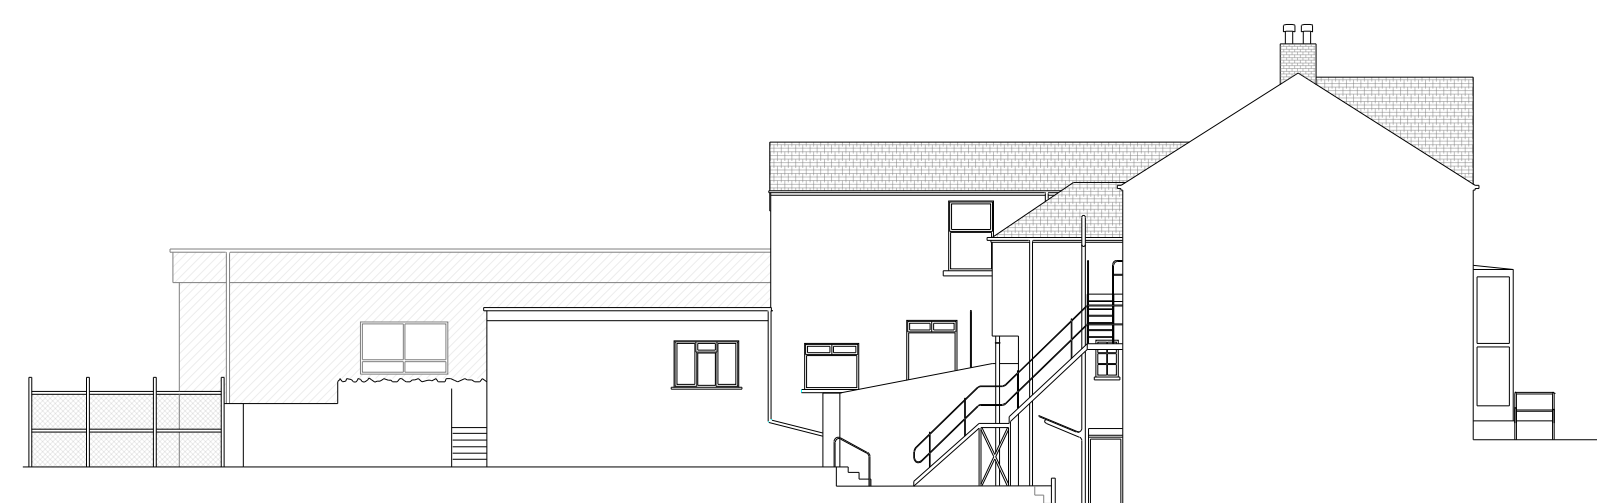

~~EXISTING~~ SOUTH ELEVATION

Scale 1:100

previous

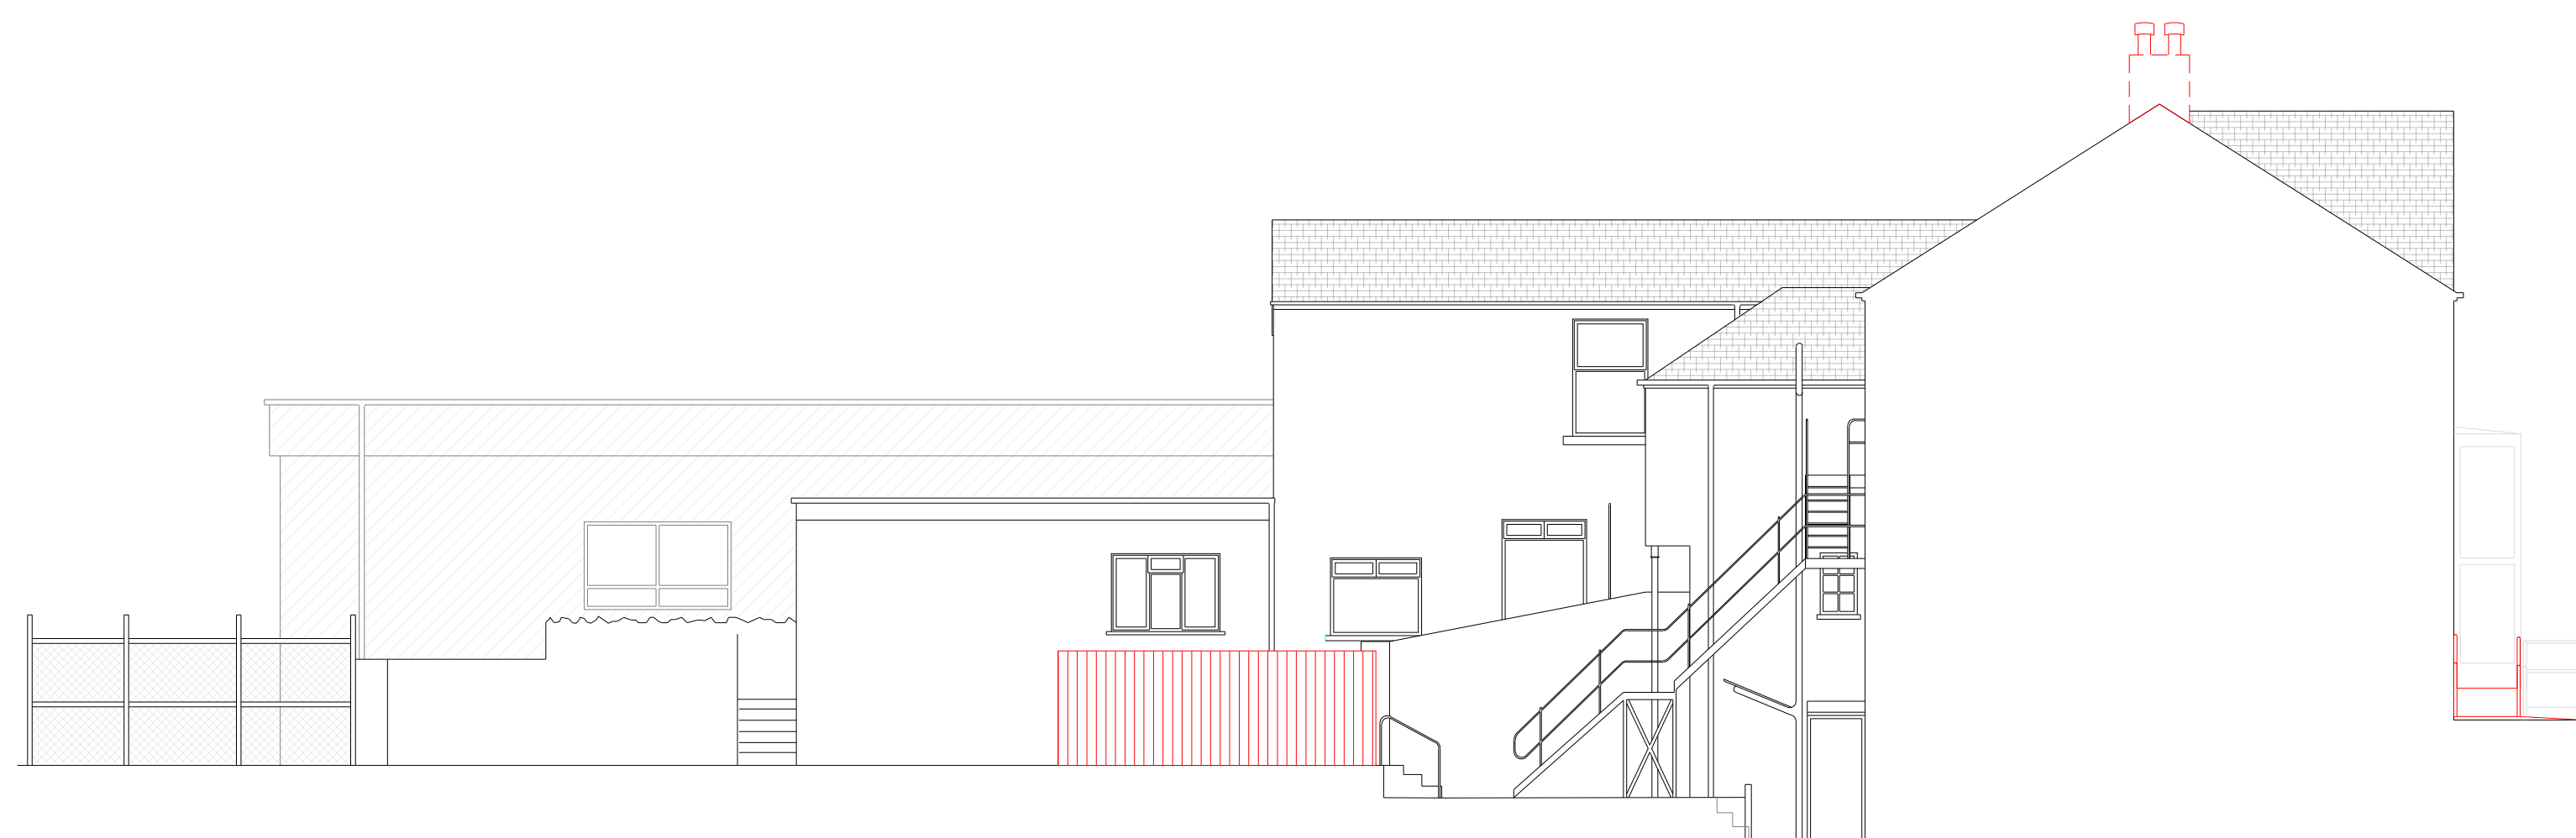

~~PROPOSED~~ SOUTH ELEVATION

Scale 1:100

Existing

SCALED DIMENSIONS MUST NOT BE TAKEN FROM THIS DRAWING	
Client:	Mr T.Pedrick
Project:	Change of Use to 20 London Rd., Neath SA11 1LE
Surveyed:	Drawn:
JTR	JTR
Approved:	Date:
TJF	January, 2021
Amendment Date/No.:	Scales:
	1:100 1:500 1:2500
Drawing No.: JTR/TP/01/21/03	
PLANNING	
TREVOR J. FRANCIS MSc. MRICS, MCIOB M.B.Eng., Dip. Arch. Cons. (Bristol) Chartered Building Surveyor/Chartered Builder 12 Dulais Fach Rd Tonina Neath SA11 3JW Tel./Fax 01639 638820 Mob. 07974114702	