



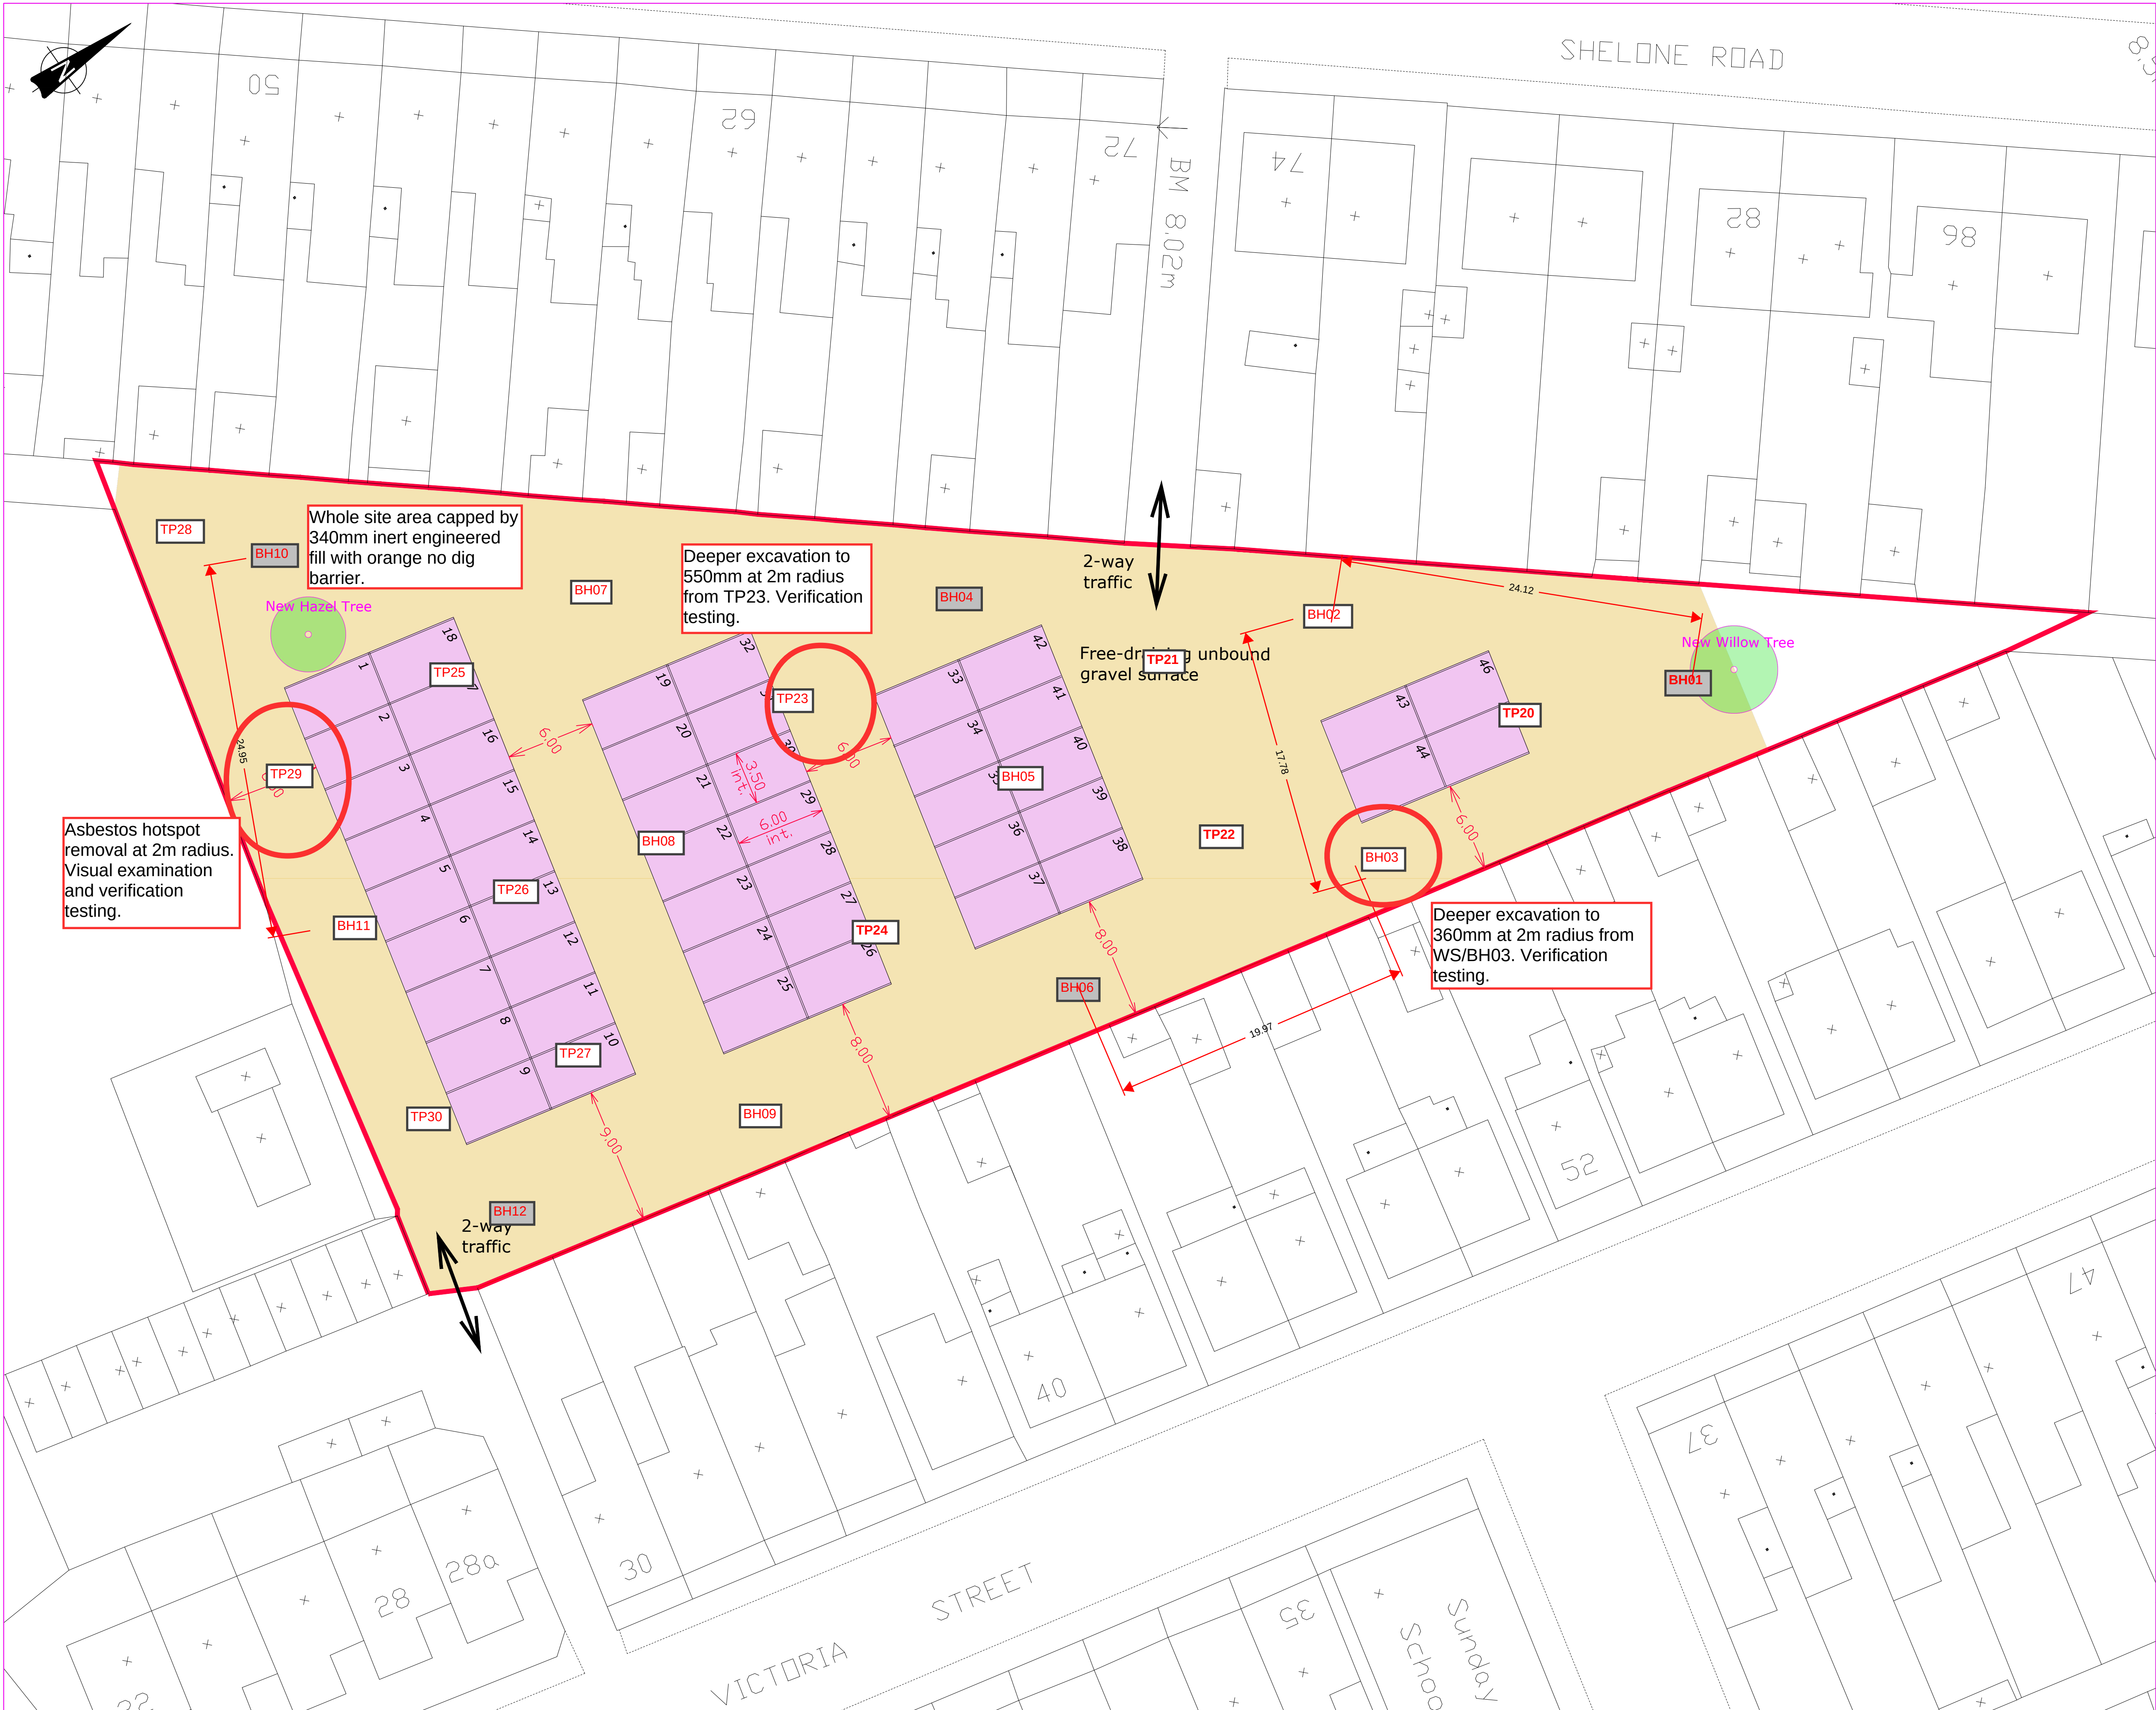

Total garage floorspace:
393+302+217+87 = 999 sqm

Drawing SGS/21012/02

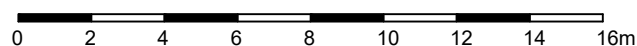

Rev	Date	Client
B	21.10.19	15.09.19
A	15.09.19	15.09.19

15.09.19 No-Entry signs omitted. 2-way traffic note added. Red line updated.

Client

Mrs P Rolt

Project

New Garages

Location

Land between Victoria St & Shelone Road, Briton Ferry

Drg Title

Site Layout

Drawing Status

PLANNING

Drawn by

GT

Scale

1:200 @ A1

Date

08.07.16

Drg No:

100

Rev

B