



NOTES
DO NOT SCALE THIS DRAWING
CONTRACTOR TO CHECK ALL DIMENSIONS AND REPORT
ALL ERRORS AND OMISSIONS TO THE ENGINEER

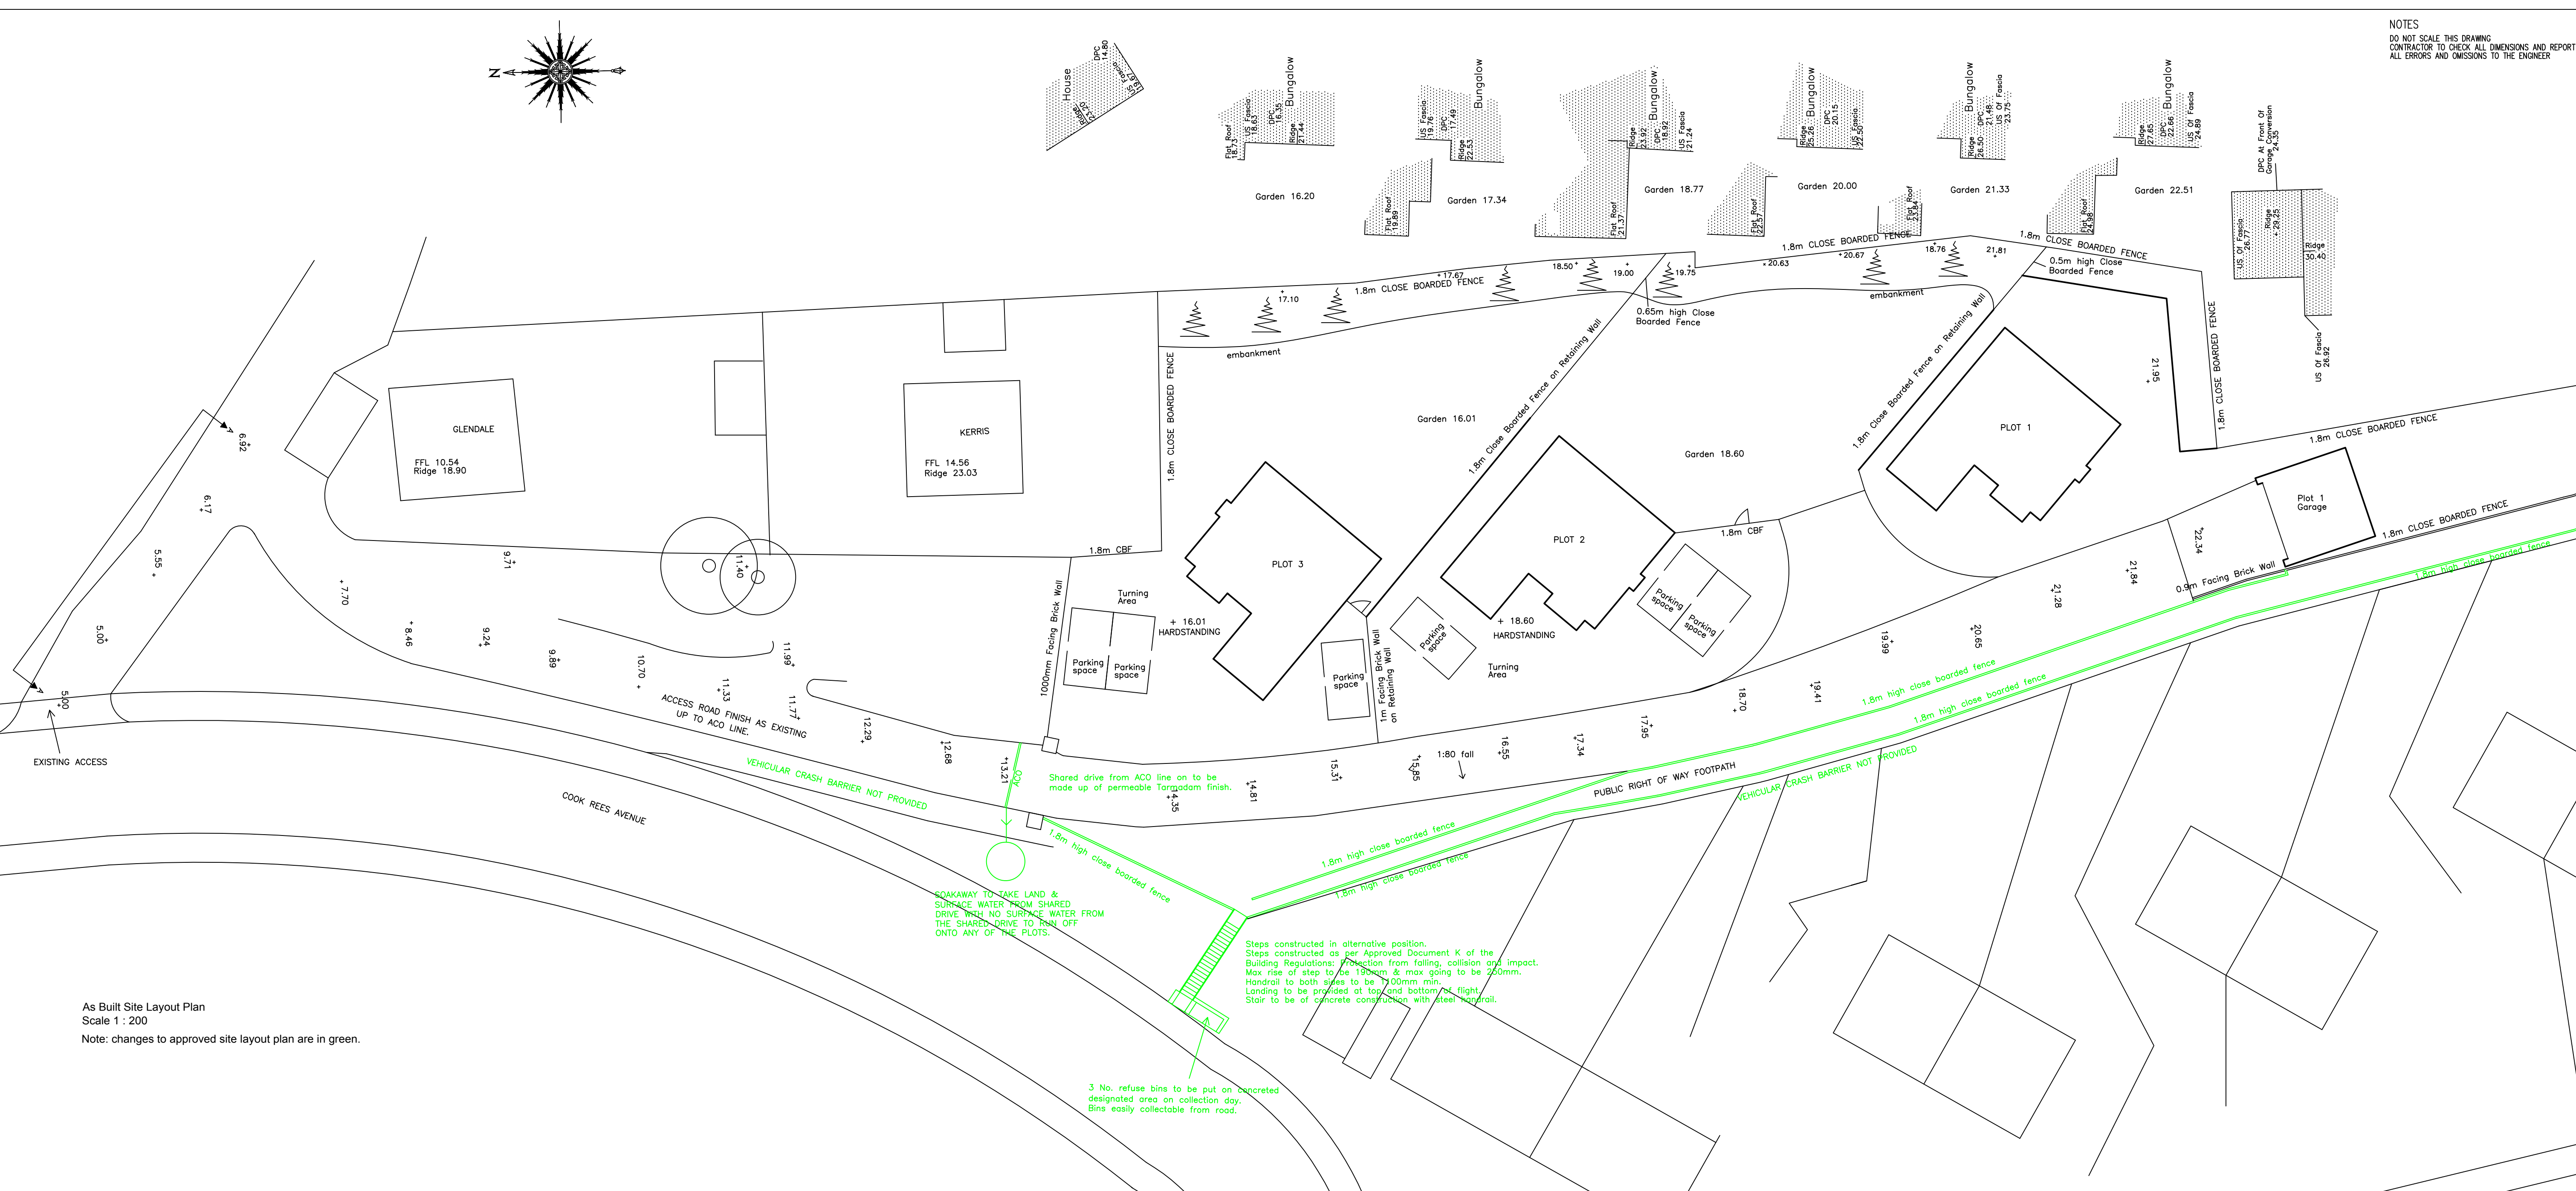

As Built Site Layout Plan
Scale 1 : 200
Note: changes to approved site layout plan are in green.

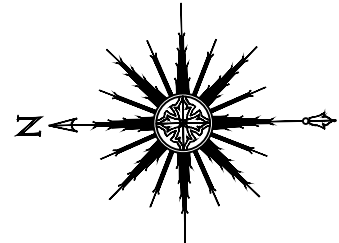

JA REWBRIDGE
DEVELOPMENT SERVICES
Architectural Design +
Quantity Surveying

5 Chapel Street, Mumbles, Swansea SA3 4NH

web: www.jarewbridge.com
email: info@jarewbridge.com
tel: 01792 360606
Adam: 07790 762443 John: 07775 595410

Client
Mr. D. Pickering

Project
Land Adjacent to
Cook Rees Avenue
Neath

Drawing Title
As Built Site Layout Plan.

Issue
PLANNING

Project No.
07.22.CRA

Drawing No.
07.22.CRA.D2

Scales
1:200

Date
28.07.22

Revision
A

Drawn
APR

Checked
JAR

Sheet Size
A1

© This drawing may not be copied without prior written permission