


Proposed South Elevation (as constructed to date) 1:100

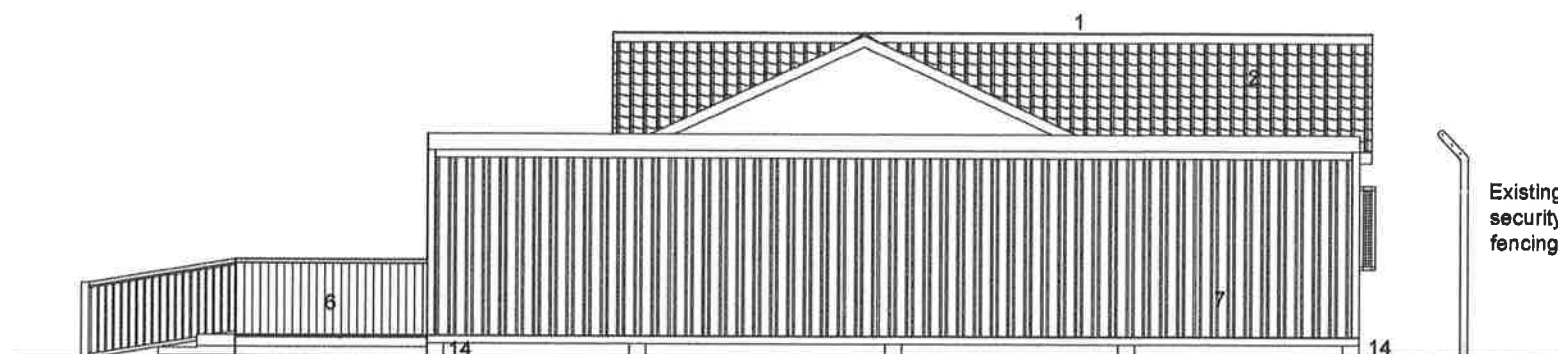

Proposed West Elevation (as constructed to date) 1:100

FINISHES.

1. Terracotta ridge tiles.
2. Profiled tiled roof.
3. Black Upvc rainwater goods.
4. White Upvc fascias / soffits / barge boards.
5. Horizontal timber cladding, painted.
6. Vertical timber balustrade.
7. Painted steel shipping containers.
8. White Upvc windows / doors.
9. Painted steel windows.
10. Painted steel security door.
11. Painted steel security mesh to rear windows.
12. Painted steel security shutters.
13. Timber decking.
14. Brick / block supports to containers.
15. Stainless steel mechanical ventilation ducts.

SCALE IN METRES



0 1 2 3 4 5

**FOR PLANNING
PURPOSES ONLY**

Revision	Description	Date
Drawing Title Proposed Elevations (as constructed to date)		
Client Mr & Mrs Hughes		
Project Name Proposed Breakfast Bar and Grill, Old TRW Works Neath Vale Supplier Park, Resolven, Neath Port Talbot, SA11 4SR		
Job No. 102	Drawing No. 05	Revision: -
Size: A3	Scale: 1:100	Date: Sep '22