




Existing security fencing.

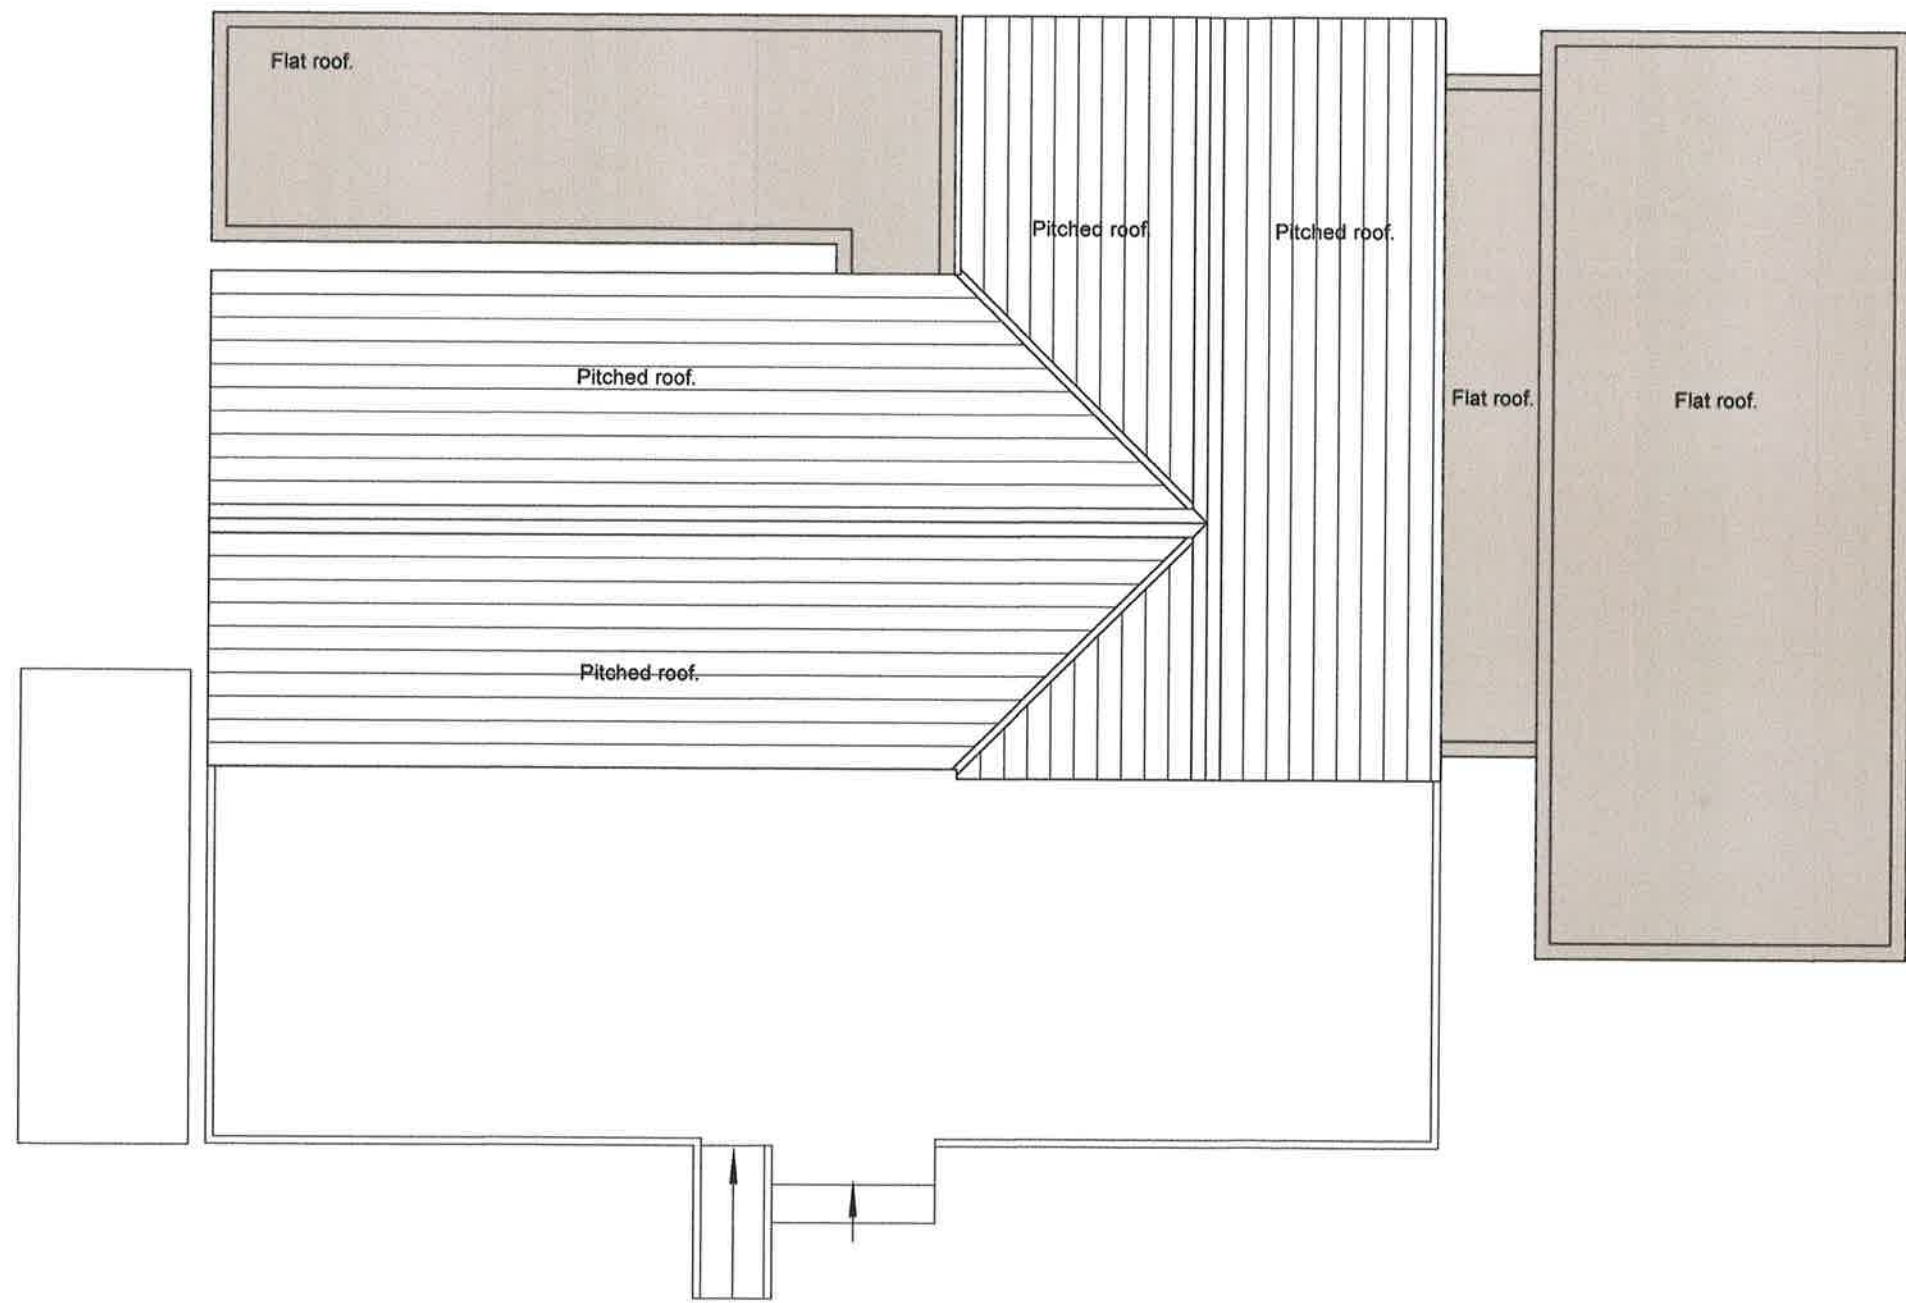

Proposed Roof Plan (as constructed to date) 1:100

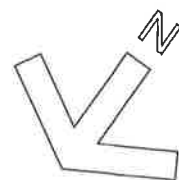

SCALE IN METRES

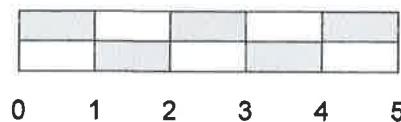

FOR PLANNING PURPOSES ONLY

Revision	Description	Date
Drawing Title Proposed Roof Plan (as constructed to date)		
Client Mr & Mrs Hughes		
Project Name Proposed Breakfast Bar and Grill, Old TRW Works Neath Vale Supplier Park, Resolven, Neath Port Talbot, SA11 4SR		
Job No: 102	Drawing No: 03	Revision: -
Size: A3	Scale: 1:100	Date: Sep '22