



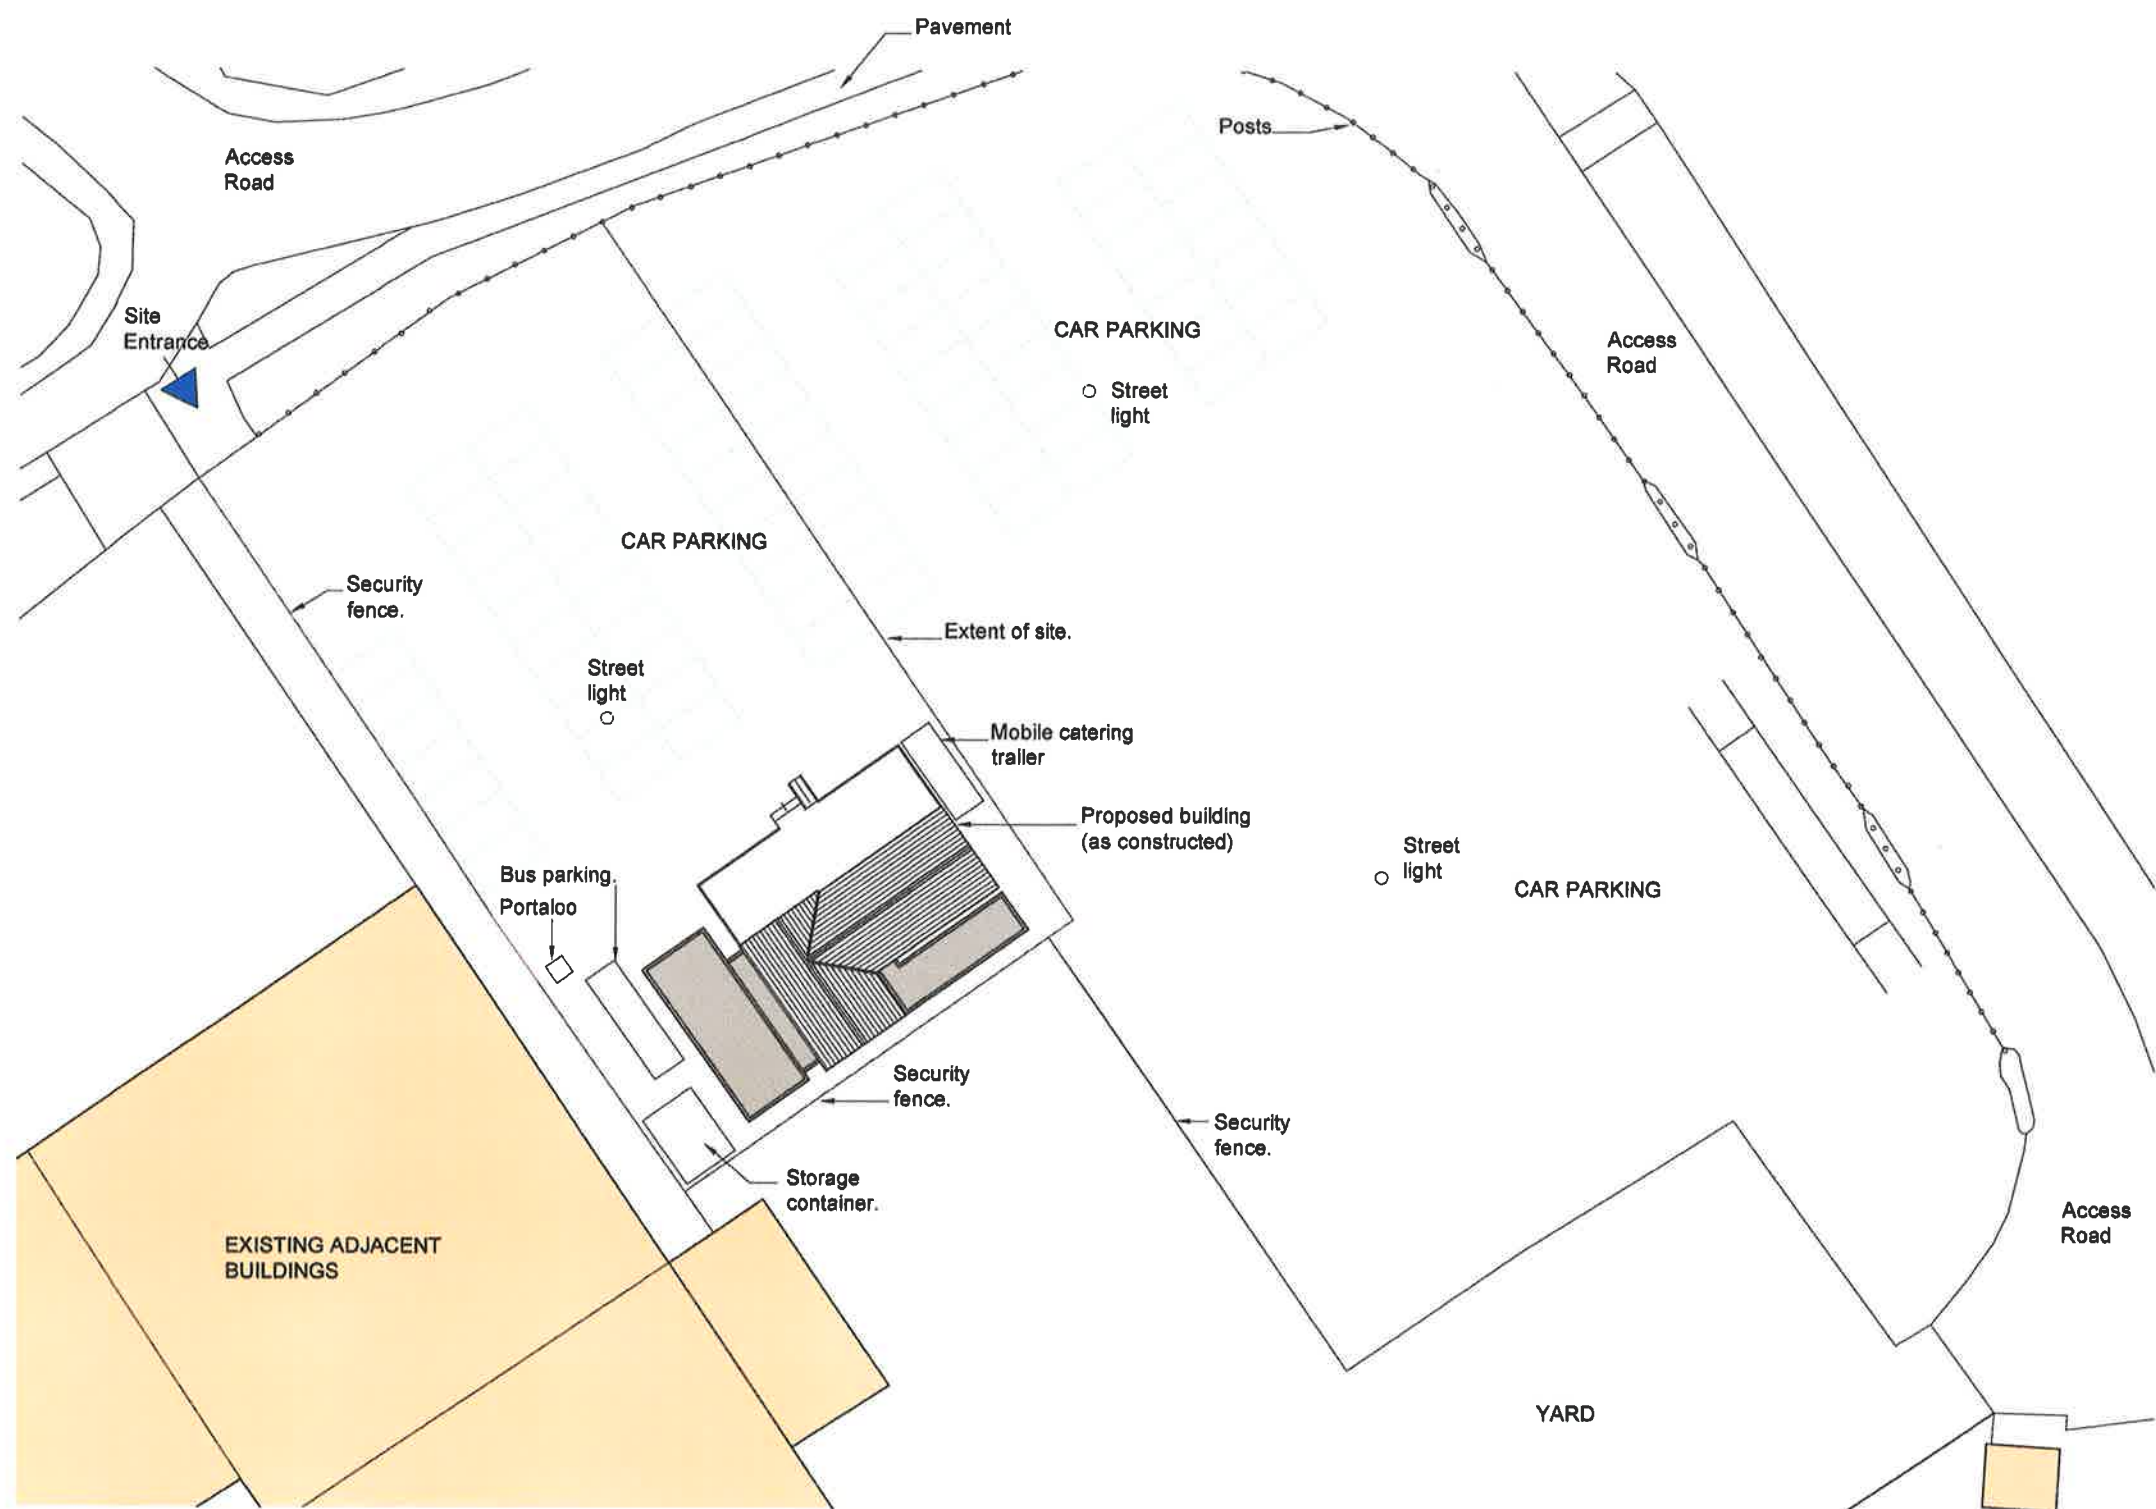

Site Plan (as constructed to date) 1:500

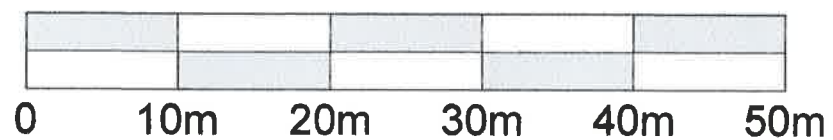

**FOR PLANNING
PURPOSES ONLY**

Revision	Description	Date
Drawing Title Proposed Site Plan (as constructed to date)		
Client Mr & Mrs Hughes		
Project Name Proposed Breakfast Bar and Grill, Old TRW Works Neath Vale Supplier Park, Resolven, Neath Port Talbot, SA11 4SR		
Job No. 102	Drawing No. 01	Revision: .
Size: A3	Scale: 1:500	Date: Sep '22