

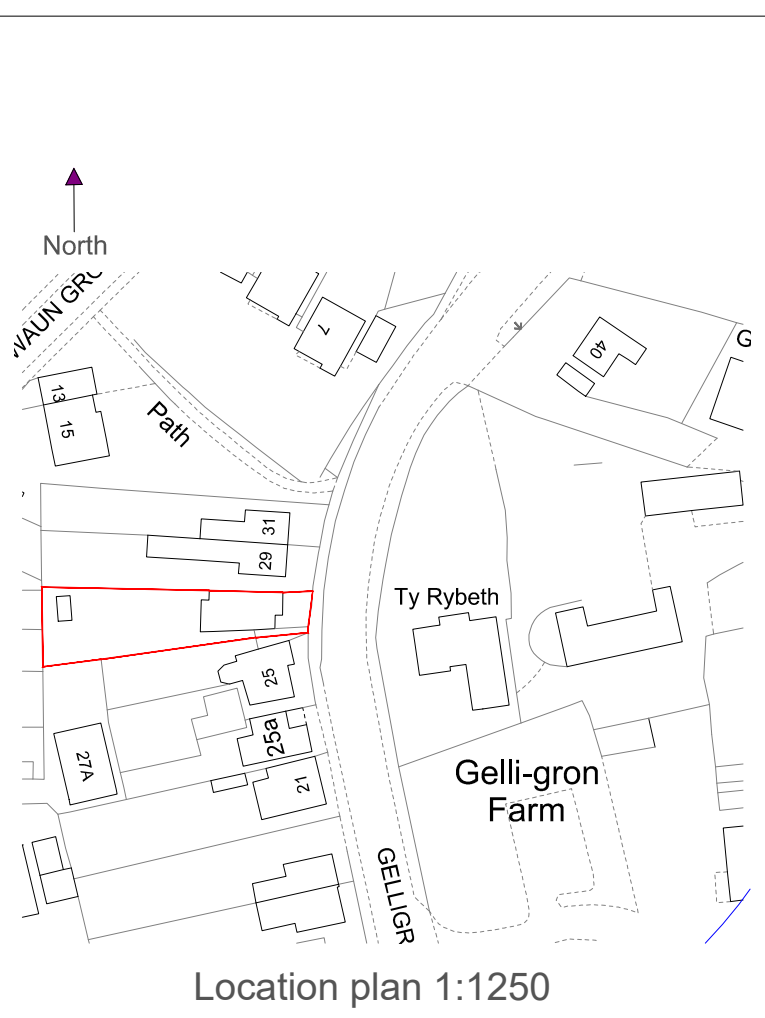
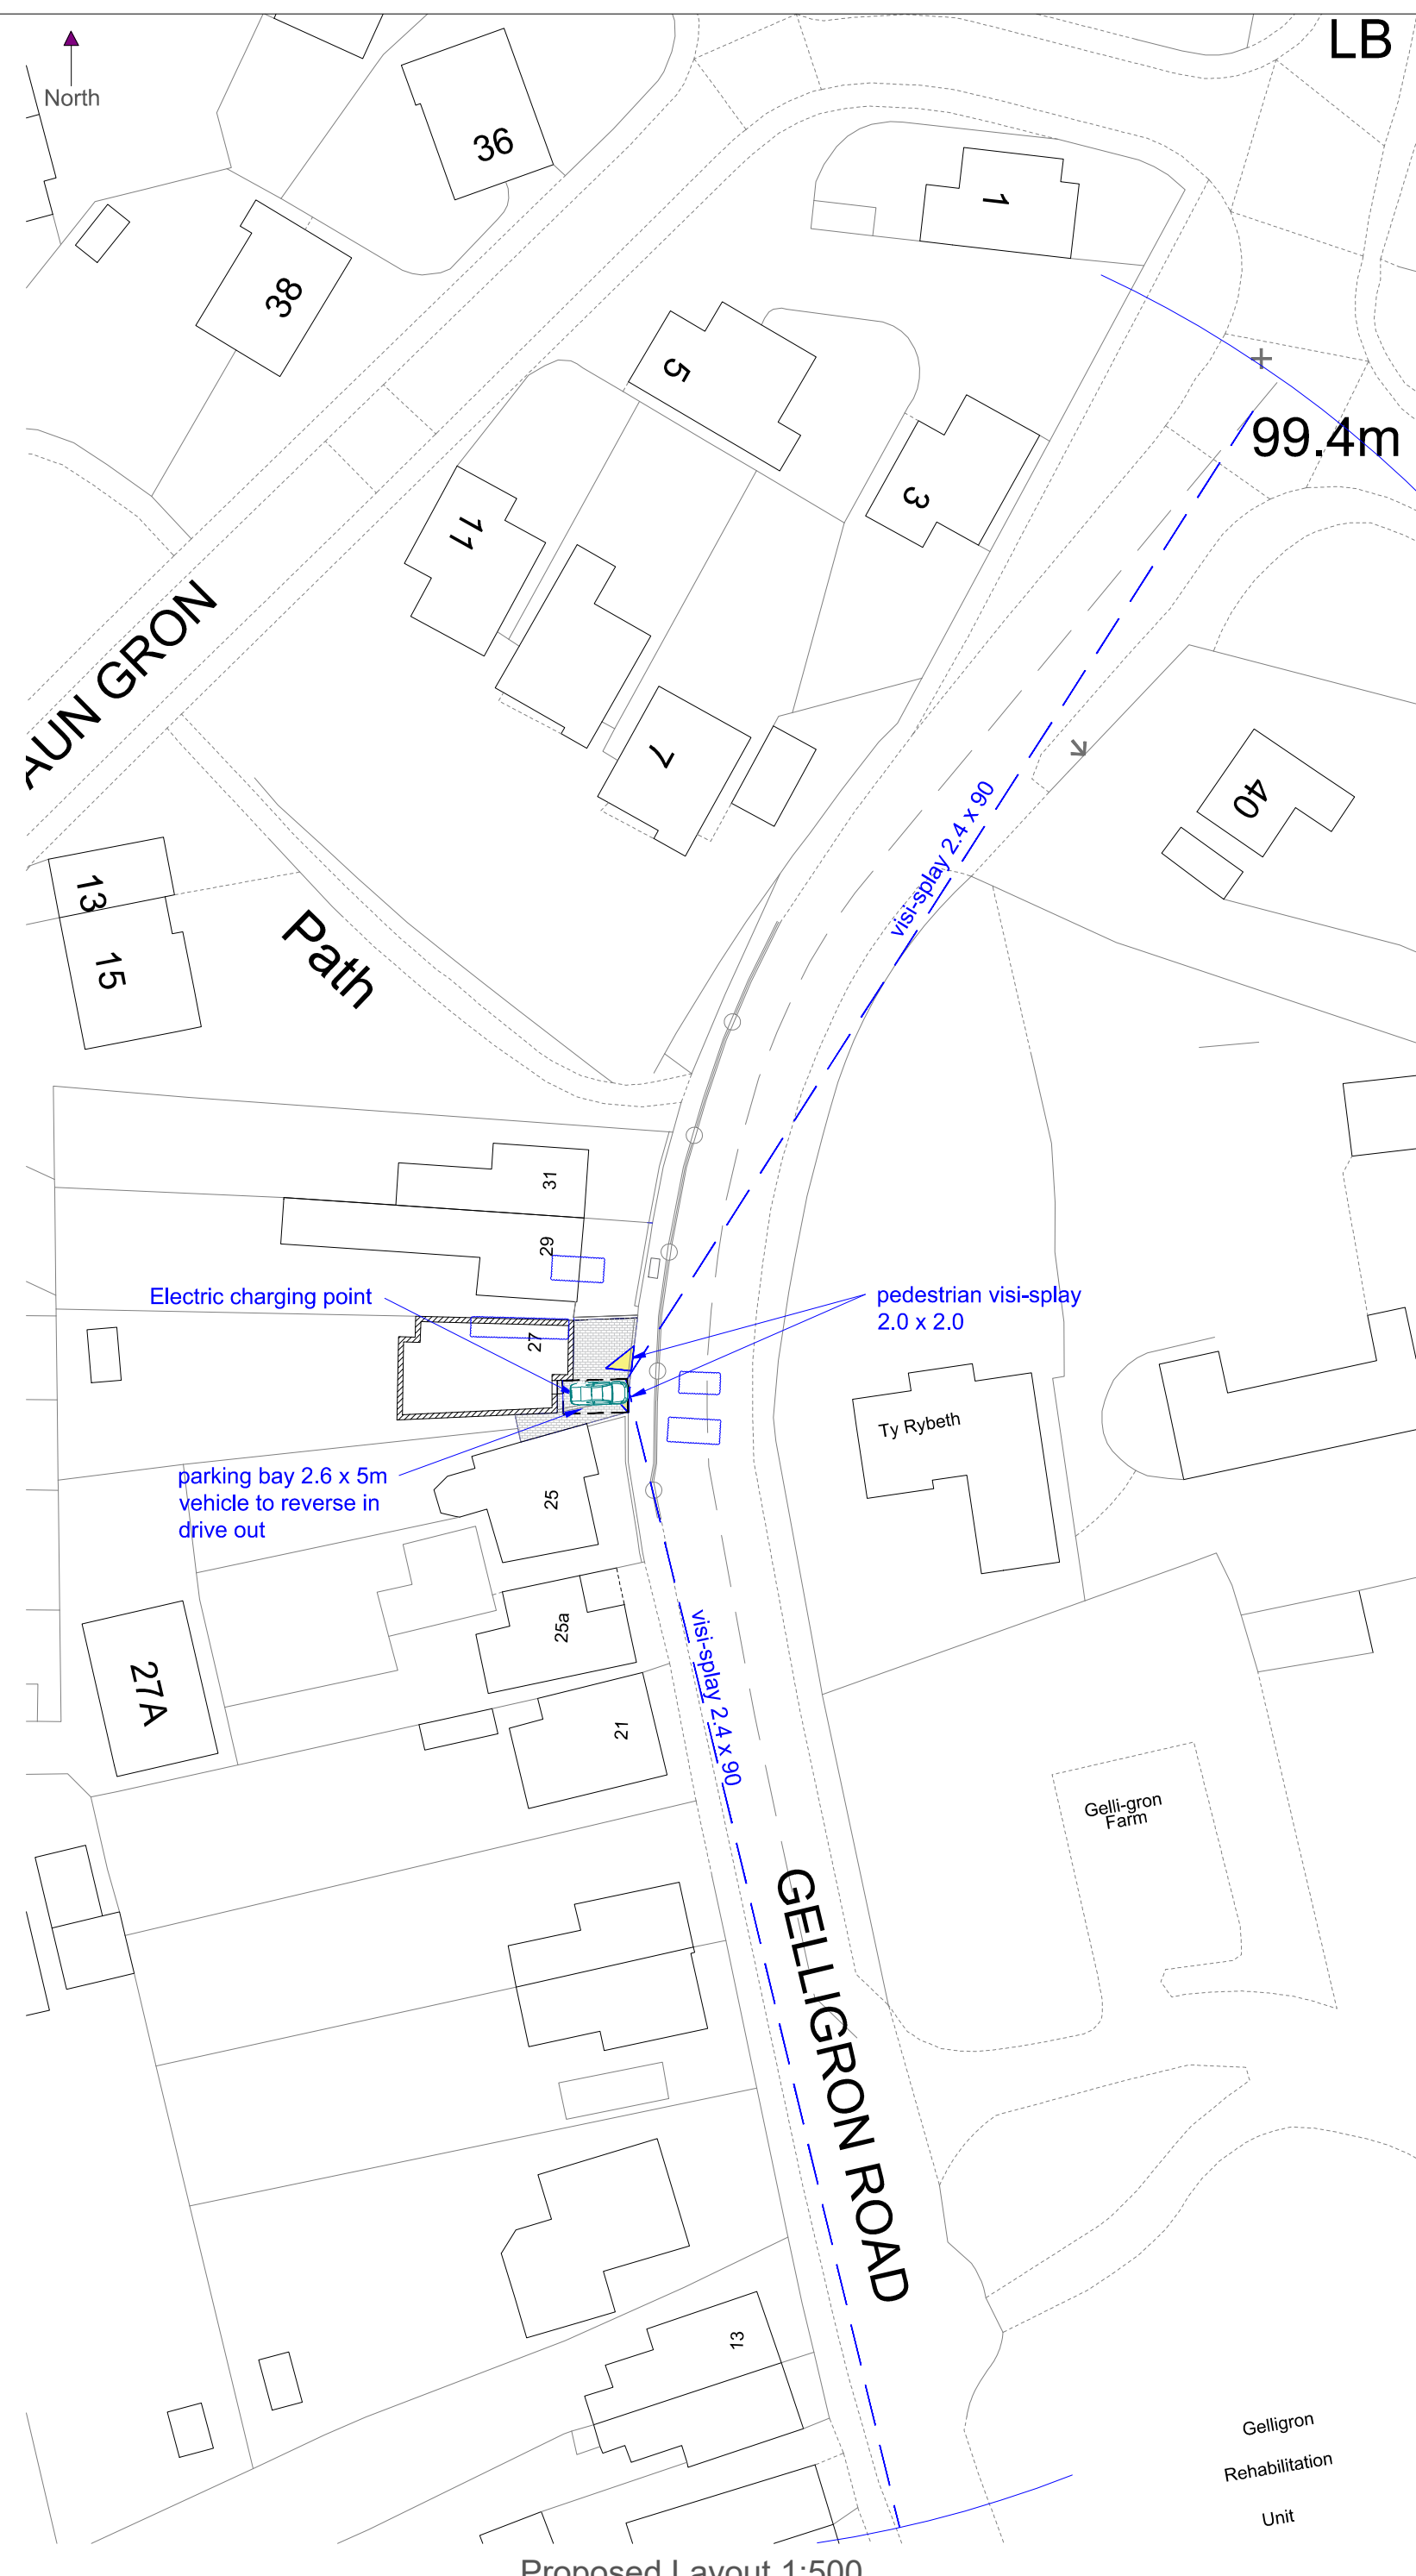


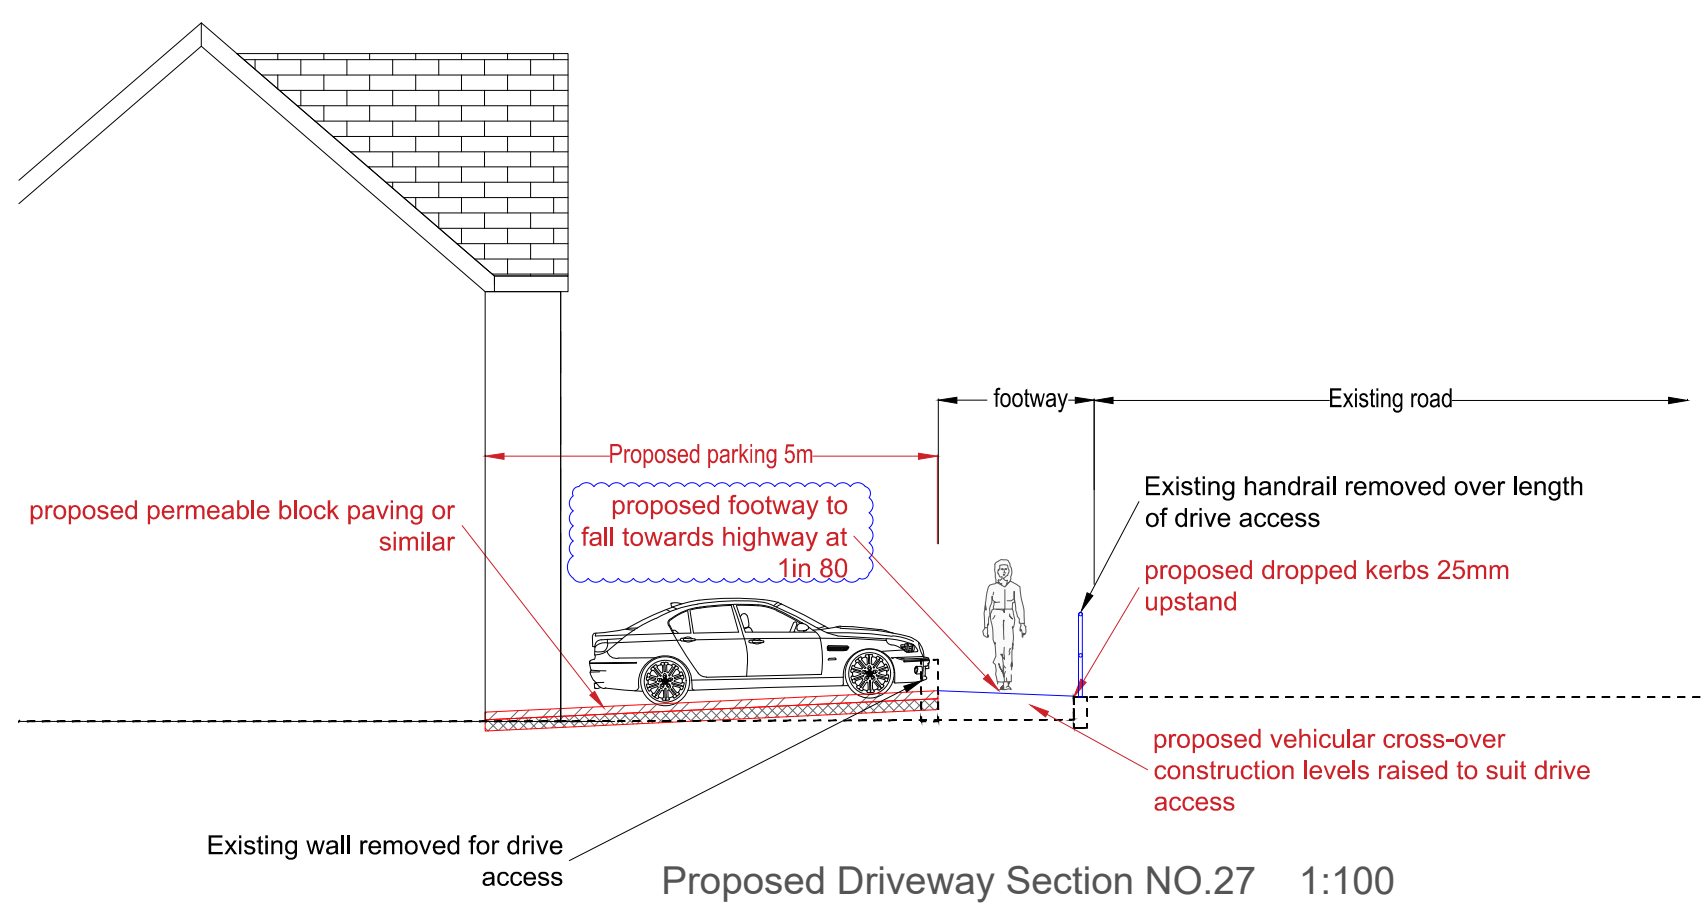

- Key:
- Proposed Vehicular crossover construction
 - Proposed Permeable Concrete Block paving
 - Red line Boundary
 - Proposed Dropped kerb upstand 25mm
 - Proposed transition kerb

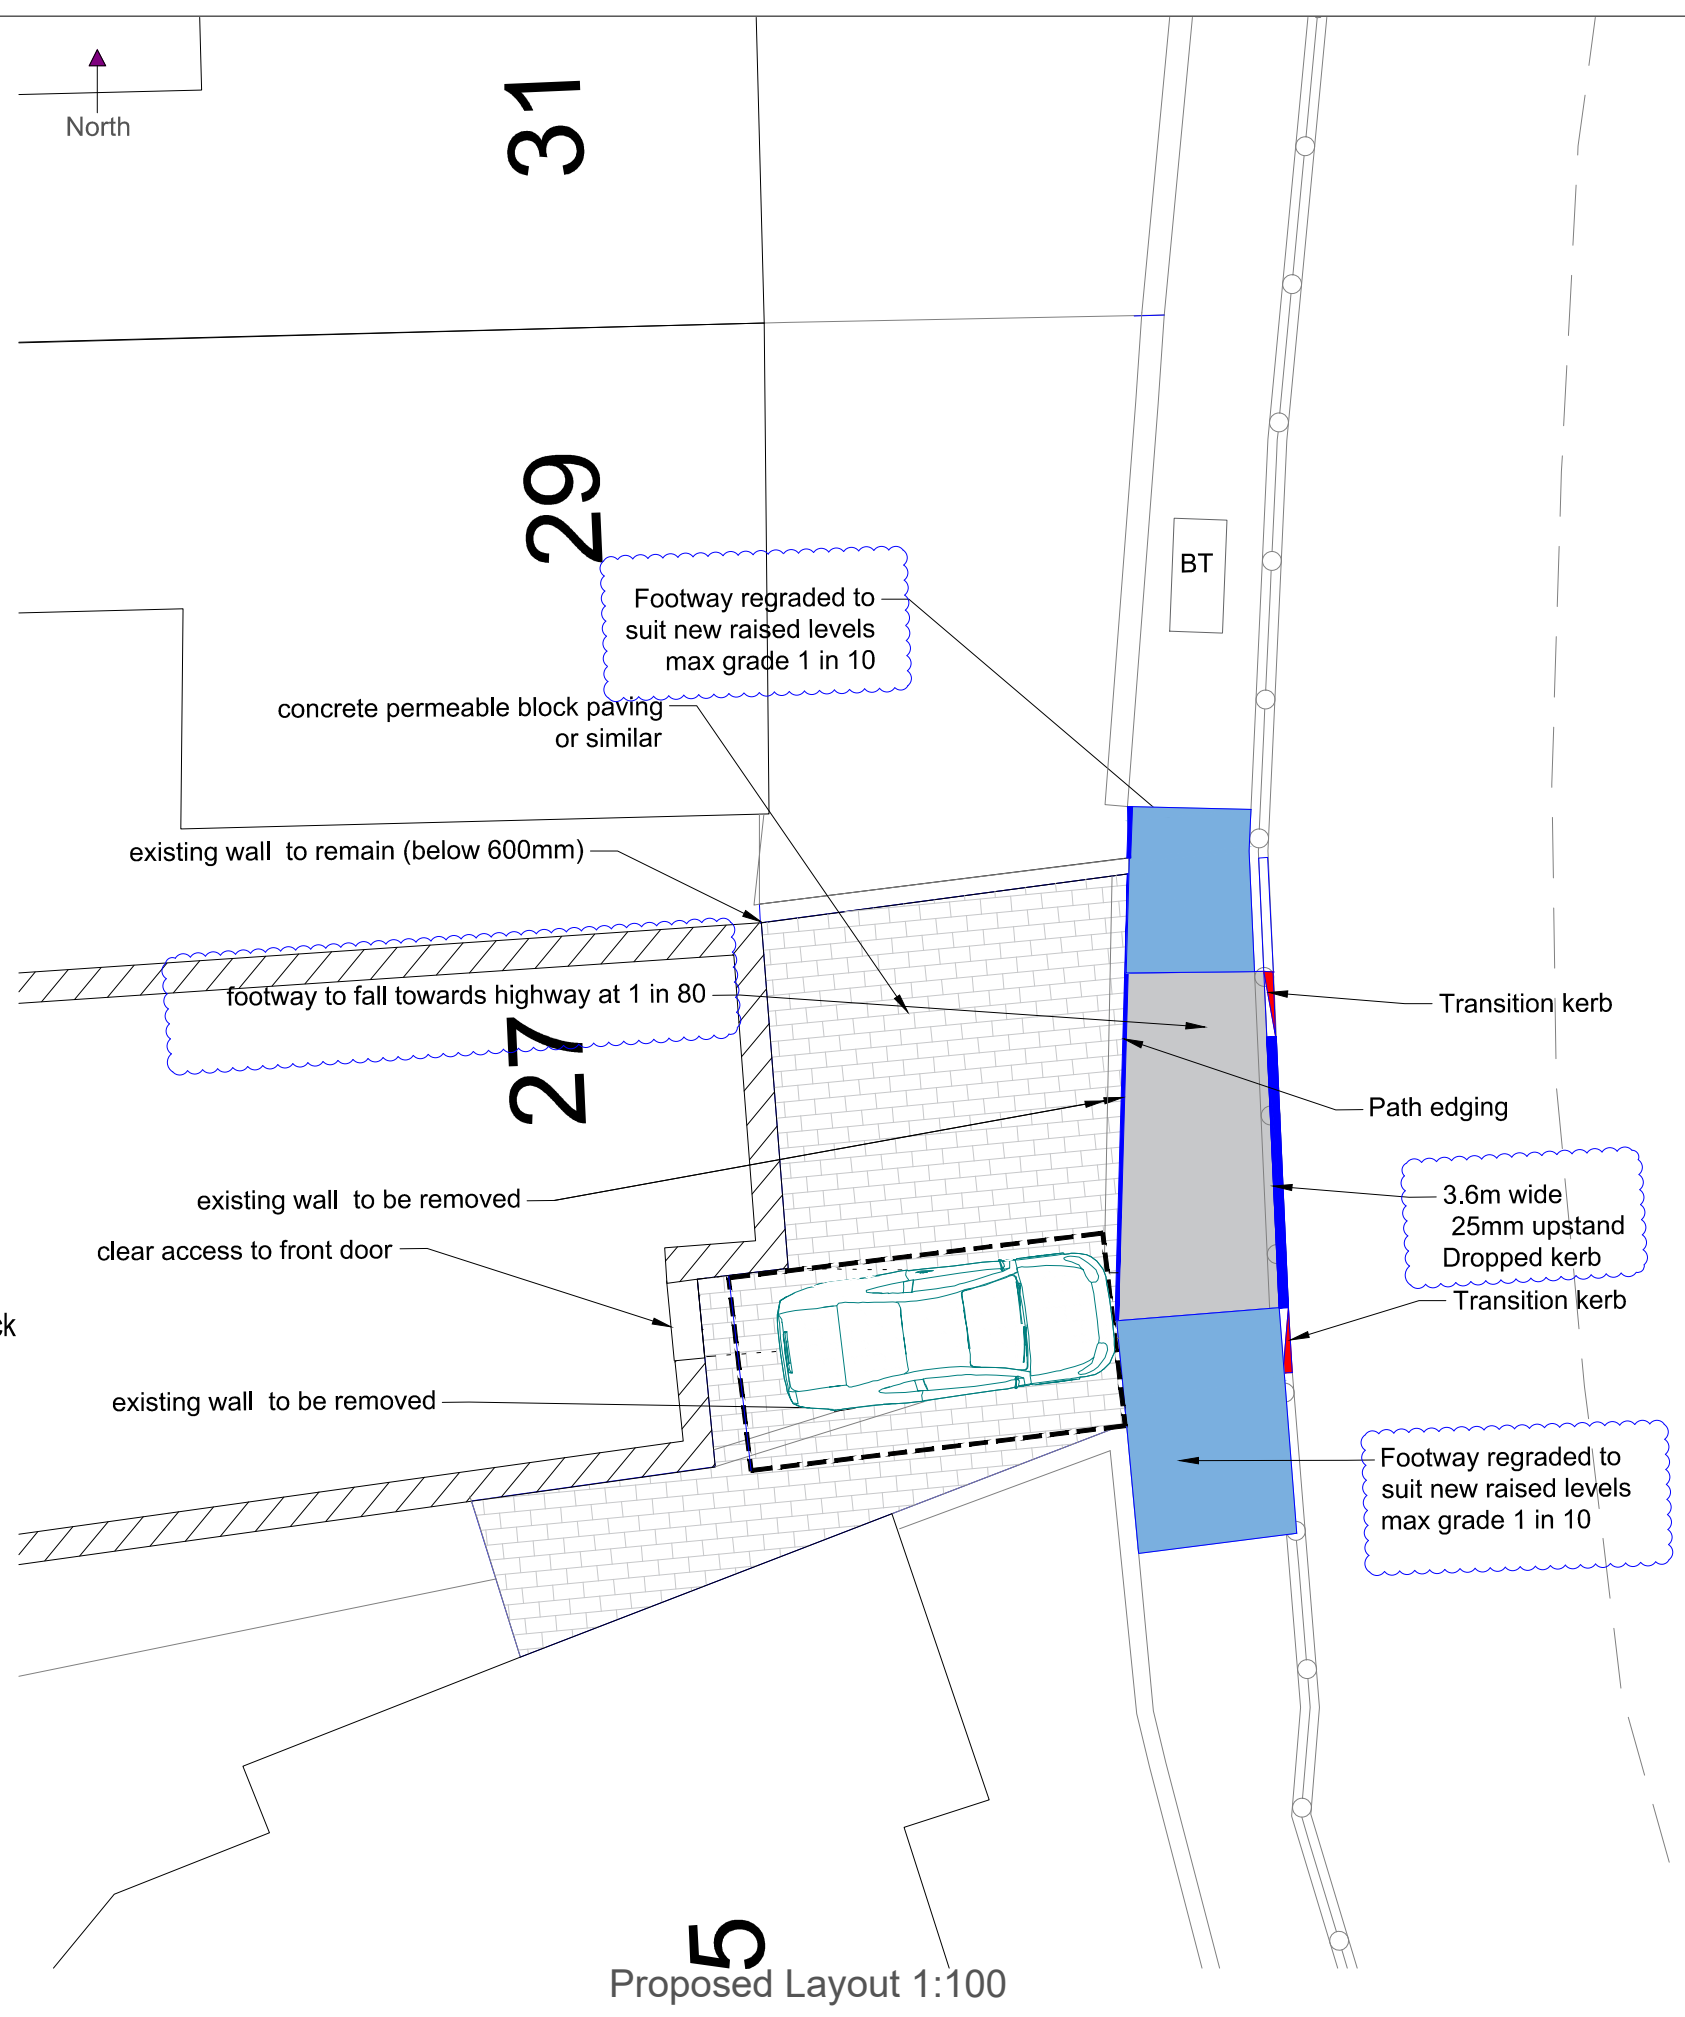

PROJECT DESCRIPTION:

27 Gelligron Road, Pontardawe

DATE:

Oct 2022

SCALE:

as shown

SHEET:

A-2

SHEET TITLE:

Driveway Proposal Plans P02

NO.

NOTES

BY

DATE

1

All dimensions in millimetres unless otherwise stated.

2

Drawings to be used for safety purposes of Planning Application only.

3

These are not Construction Drawings.

4

The contractor is to seek out, check and clear the site of any obstructions or hazards prior to the start of works.

5

RTPI

Accredited Engineer