


Rev.	Description	Date
C	As built changes for NMA application	31.10.22
B.	Prow corrected to reflect Modification Order to bridleway dated 30th April 1991.	09.03.18
A.	Prow & key added	13.02.18

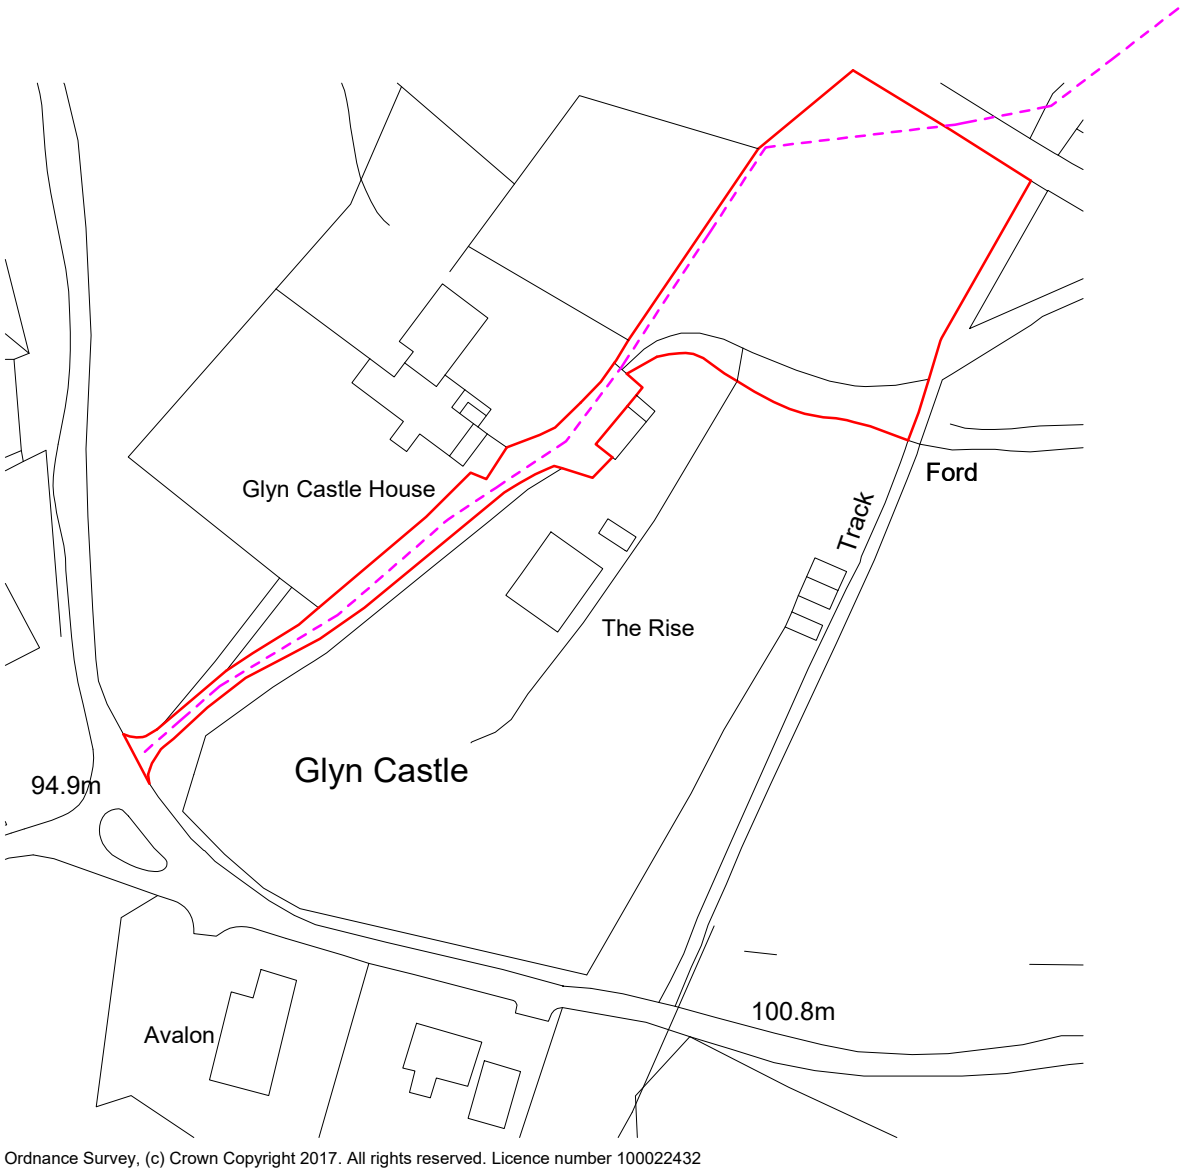

KEY	
	SITE BOUNDARY
	EXISTING PUBLIC RIGHT OF WAY (PROW)

Client
Mr & Mrs A Pearce

Scale (@ A3)
1 : 1250

Drawing Number
01

Project
The Rise, GlynCastle, Resolven

Project number
17-030

Purpose of Issue
Planning

Date
15.12.17

Suitability Description
-

Drawing Title
Location Plan

Drawn by
PNW

Sheet

Checked by
-

Status
-

Rev
C

Code
-