


Rev.	Description	Date
D	As built changes for NMA application	31.10.22
C.	Dwelling re-positioned due to location of PROW.	01.04.18
B.	Prow corrected to reflect Modification Order to bridleway dated 30th April 1991.	09.03.18
A.	Existing / Proposed Prow & key added	13.02.18

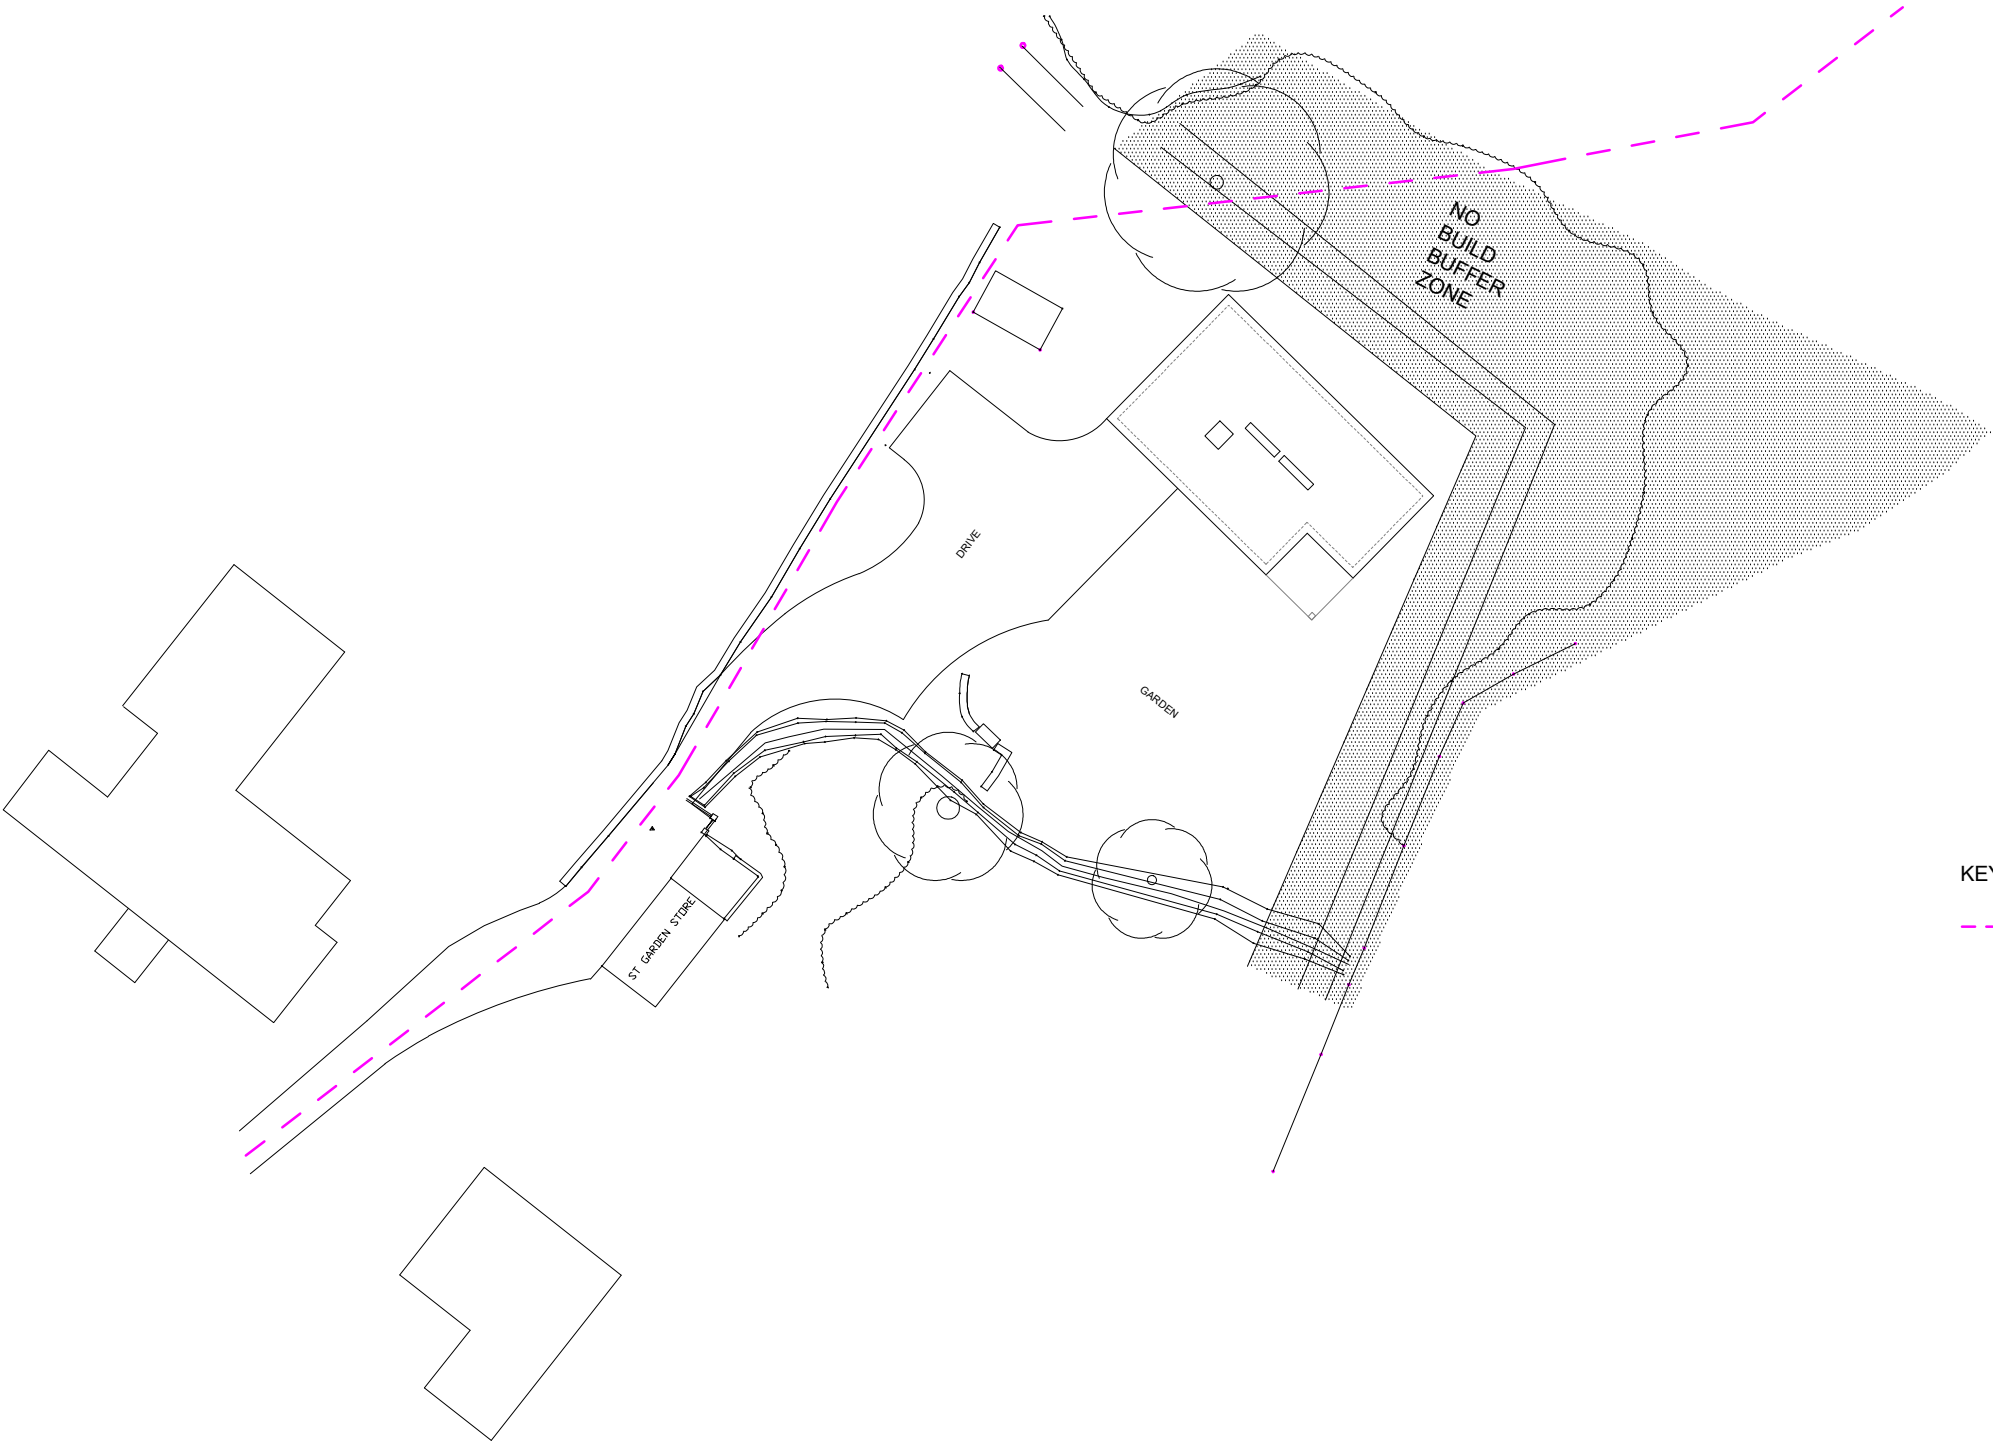

KEY

----- EXISTING PUBLIC RIGHT OF WAY (PROW)

Client

Mr & Mrs A Pearce

Project

The Rise, GlynCastle, Resolven

Scale (@ A3)

1 : 500

Drawing Number

02

Project number

17-030

Date

15.12.17

Purpose of Issue

Planning

Suitability Description

-

Drawing Title

Site layout Plan Proposed

Drawn by

PNW

Checked by

-

Rev

D

Sheet

-

Status

-

Code

-