


Rev.	Description	Date
A	As built changes for NMA application	31.10.22

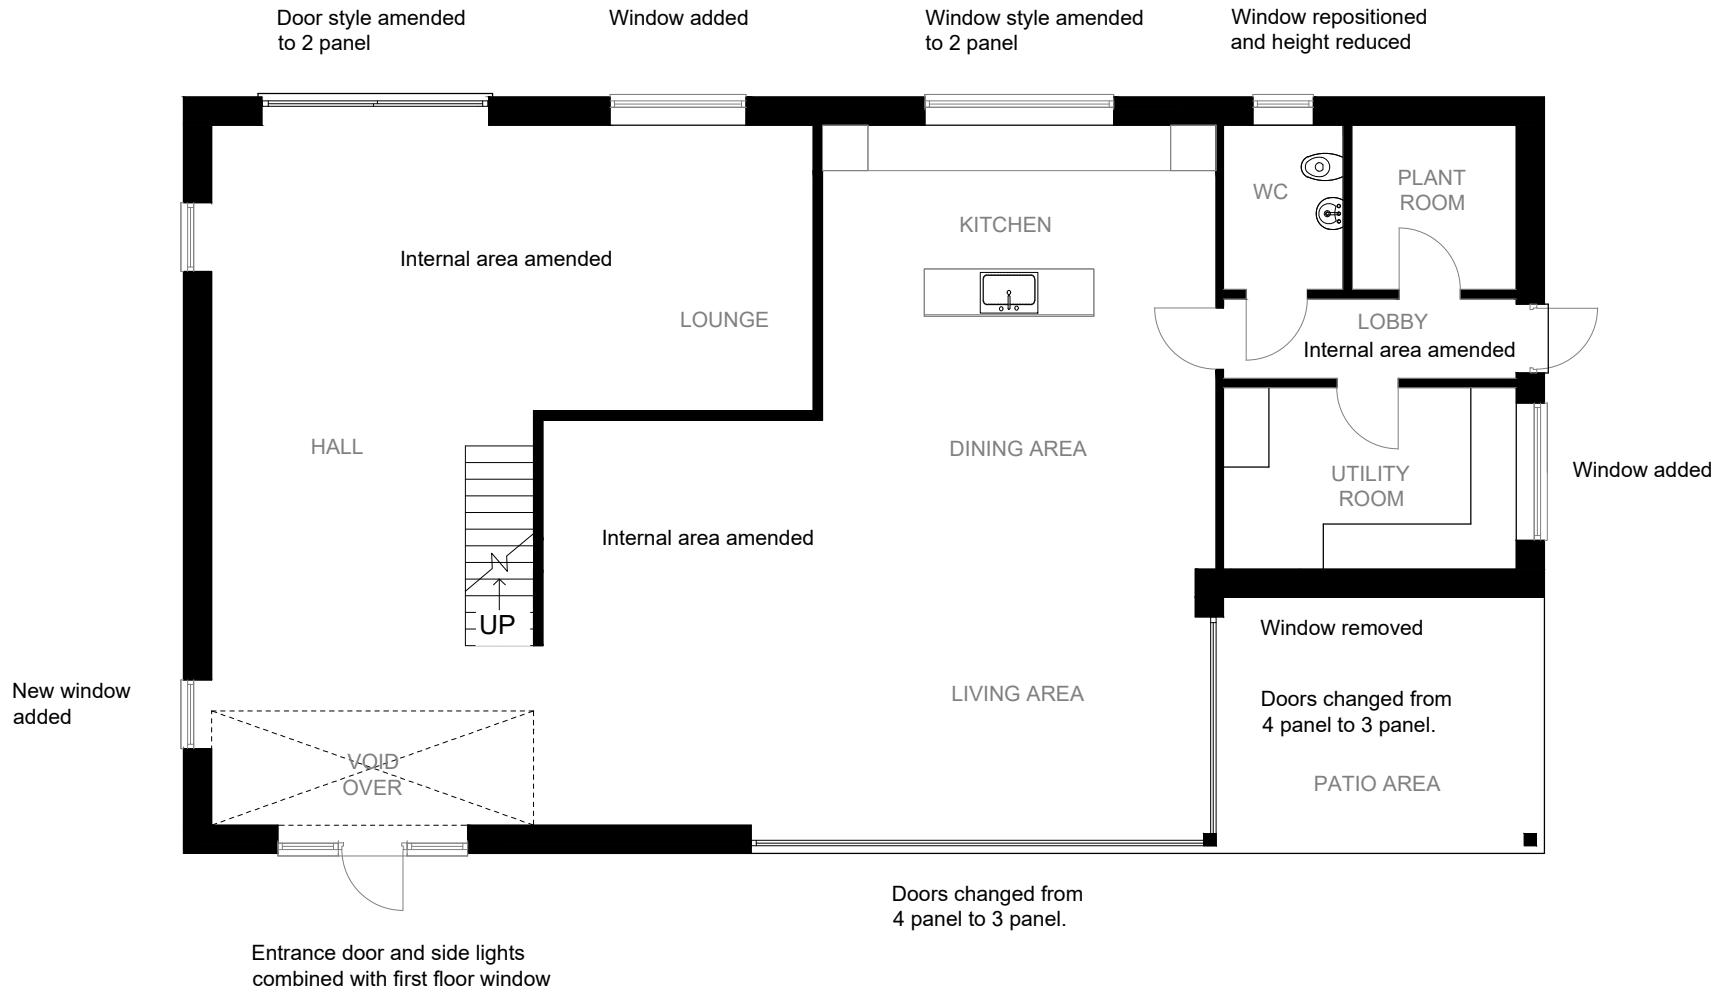

Client
Mr & Mrs A Pearce

Scale (@ A3)
1 : 100
Drawing Number
03

Project
The Rise, GlynCastle, Resolven

Project number
17-030
Date
15.12.17
Purpose of Issue
Planning
Suitability Description
-

Drawing Title
Proposed Ground Floor Plan

Drawn by
PNW
Checked by
-
Rev
A
Sheet
Status
-
Code
-

