


Rev.	Description	Date
A	As built changes for NMA application	31.10.22

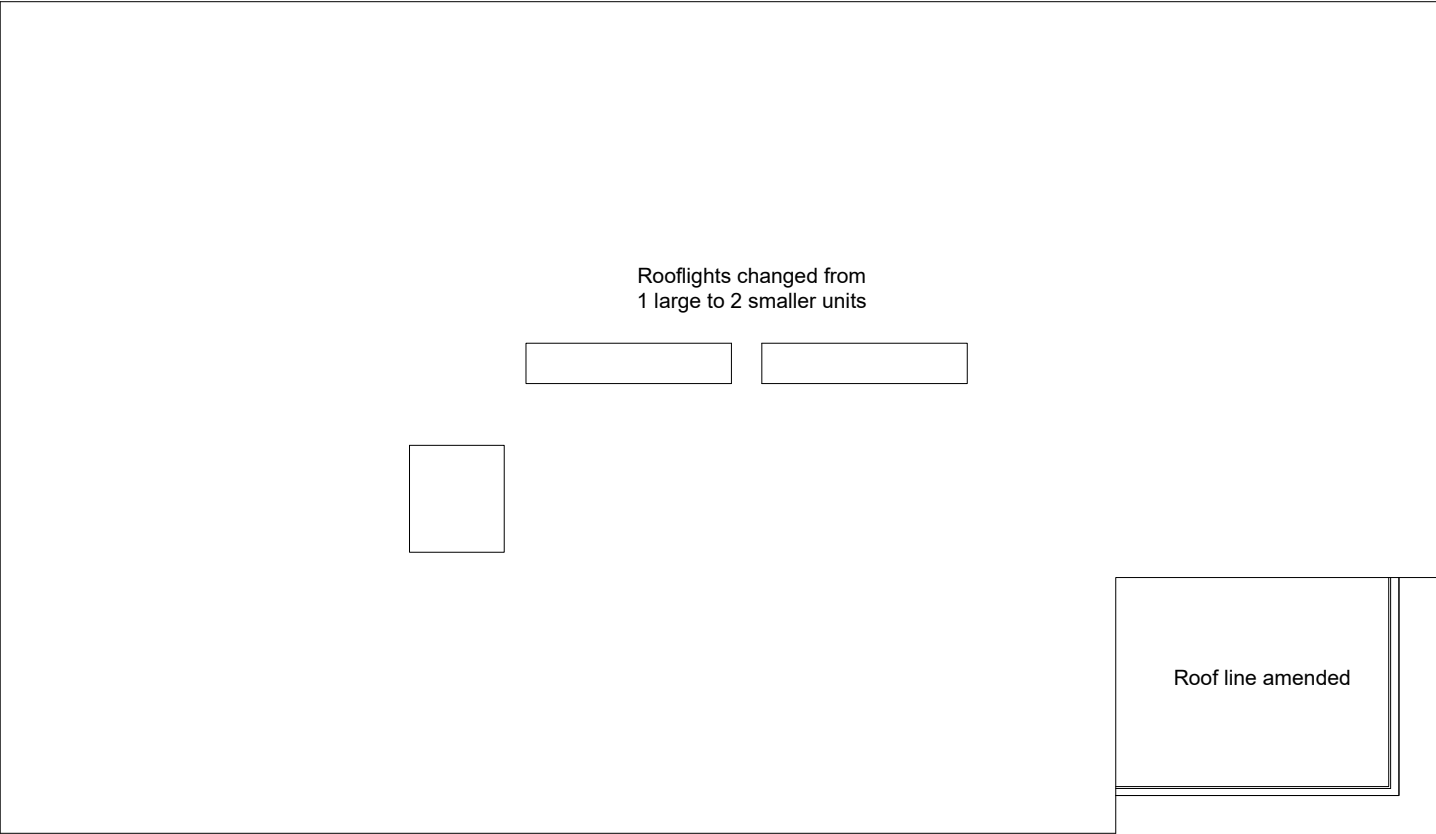

Client
Mr & Mrs A Pearce

Scale (@ A3)
1 : 100

Drawing Number
05

Project
The Rise, GlynCastle, Resolven

Project number
17-030

Date
15.12.17

Purpose of Issue
Planning

Suitability Description
-

Drawing Title
Proposed Roof Plan

Drawn by
PNW

Checked by
-

Rev
A

Sheet

Status
-

Code
-

