


Rev.	Description	Date
B	As built changes for NMA application	31.10.22
A	Proposed sections amended to allow usable front garden as amenity space. Key added.	24.08.18

Section A-A : Existing

Section B-B : Existing



Section A-A : Proposed

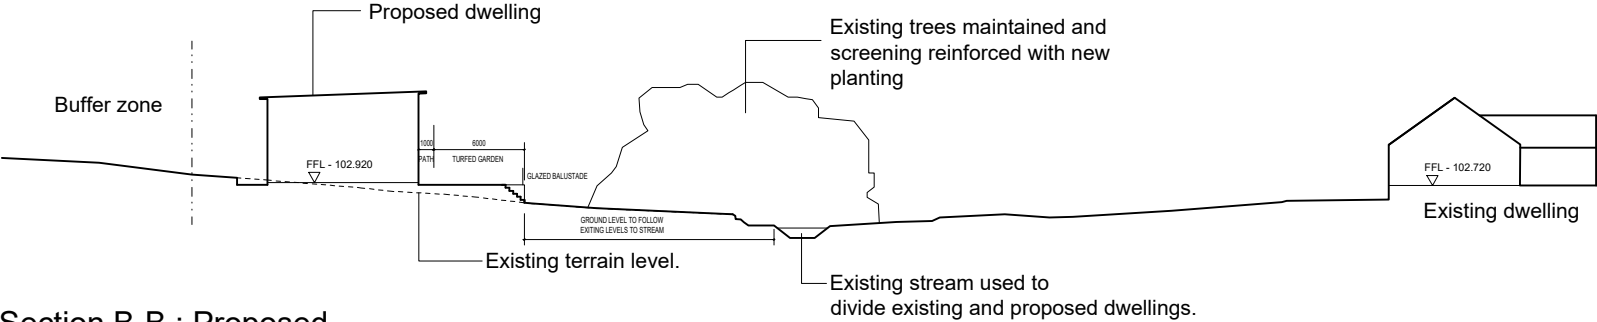

Section Locations : NTS

Client
Mr & Mrs A Pearce

Scale (@ A3)
1 : 500

Drawing Number
07

Project
The Rise, GlynCastle, Resolven

Project number
17-030

Purpose of Issue
Planning

Date
15.12.17

Suitability Description
-

Drawing Title
Existing & Proposed Site Sections

Drawn by
PNW

Sheet

Checked by
-

Status
-

Rev
B

Code
-