
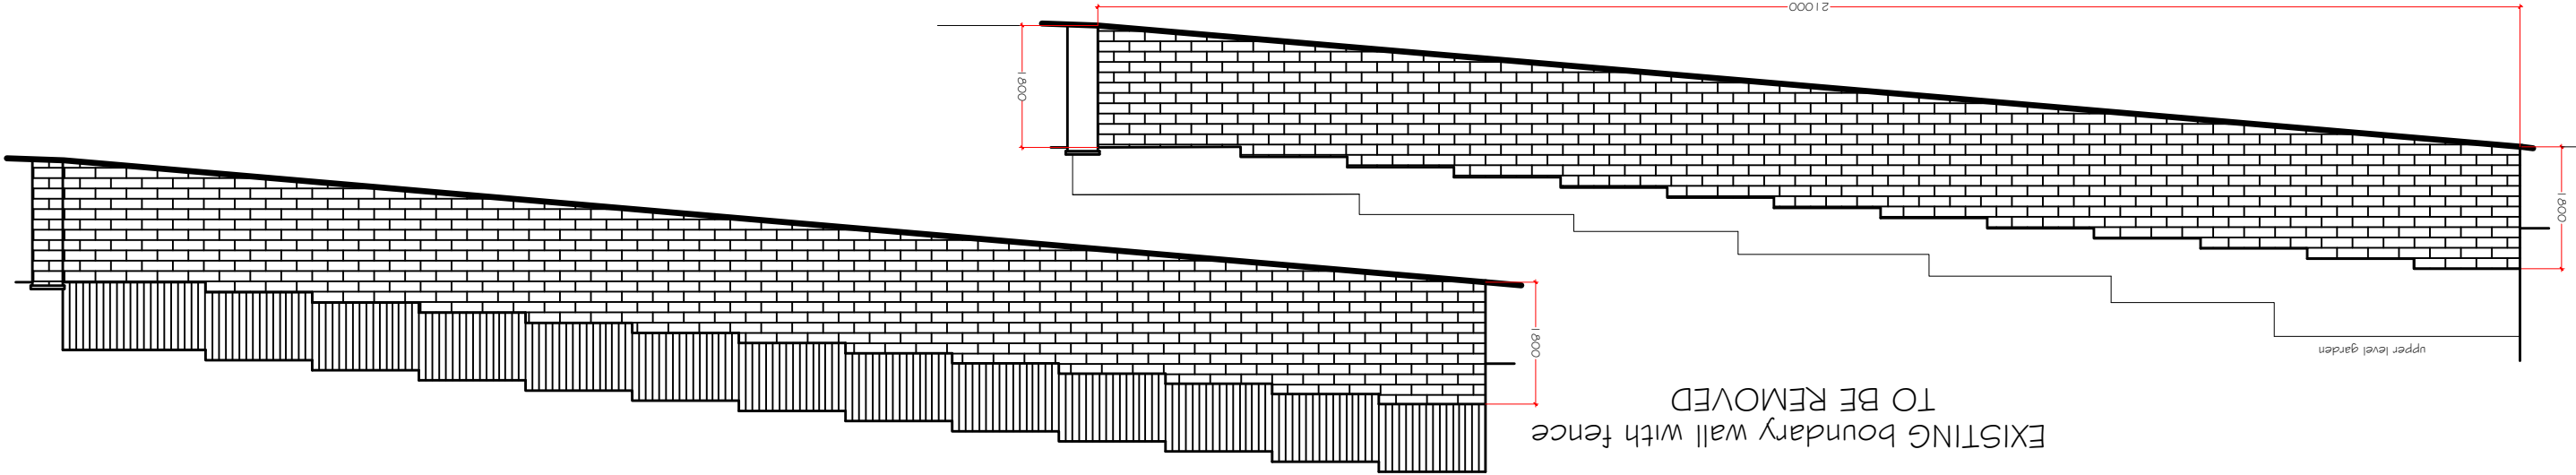


Superseded

New Boundary Wall 1 St llltyds Close Baglan, Port Talbot	AS CONSTRUCTED New boundary wall	drawing No 1 SIC - 02 rev A	scale noted	date Jan 2023
---	--	---	---------------------------	-----------------------------

Revision A 29.01.23
DESIGN CHANGE
NEW BOUNDARY WALL ONLY

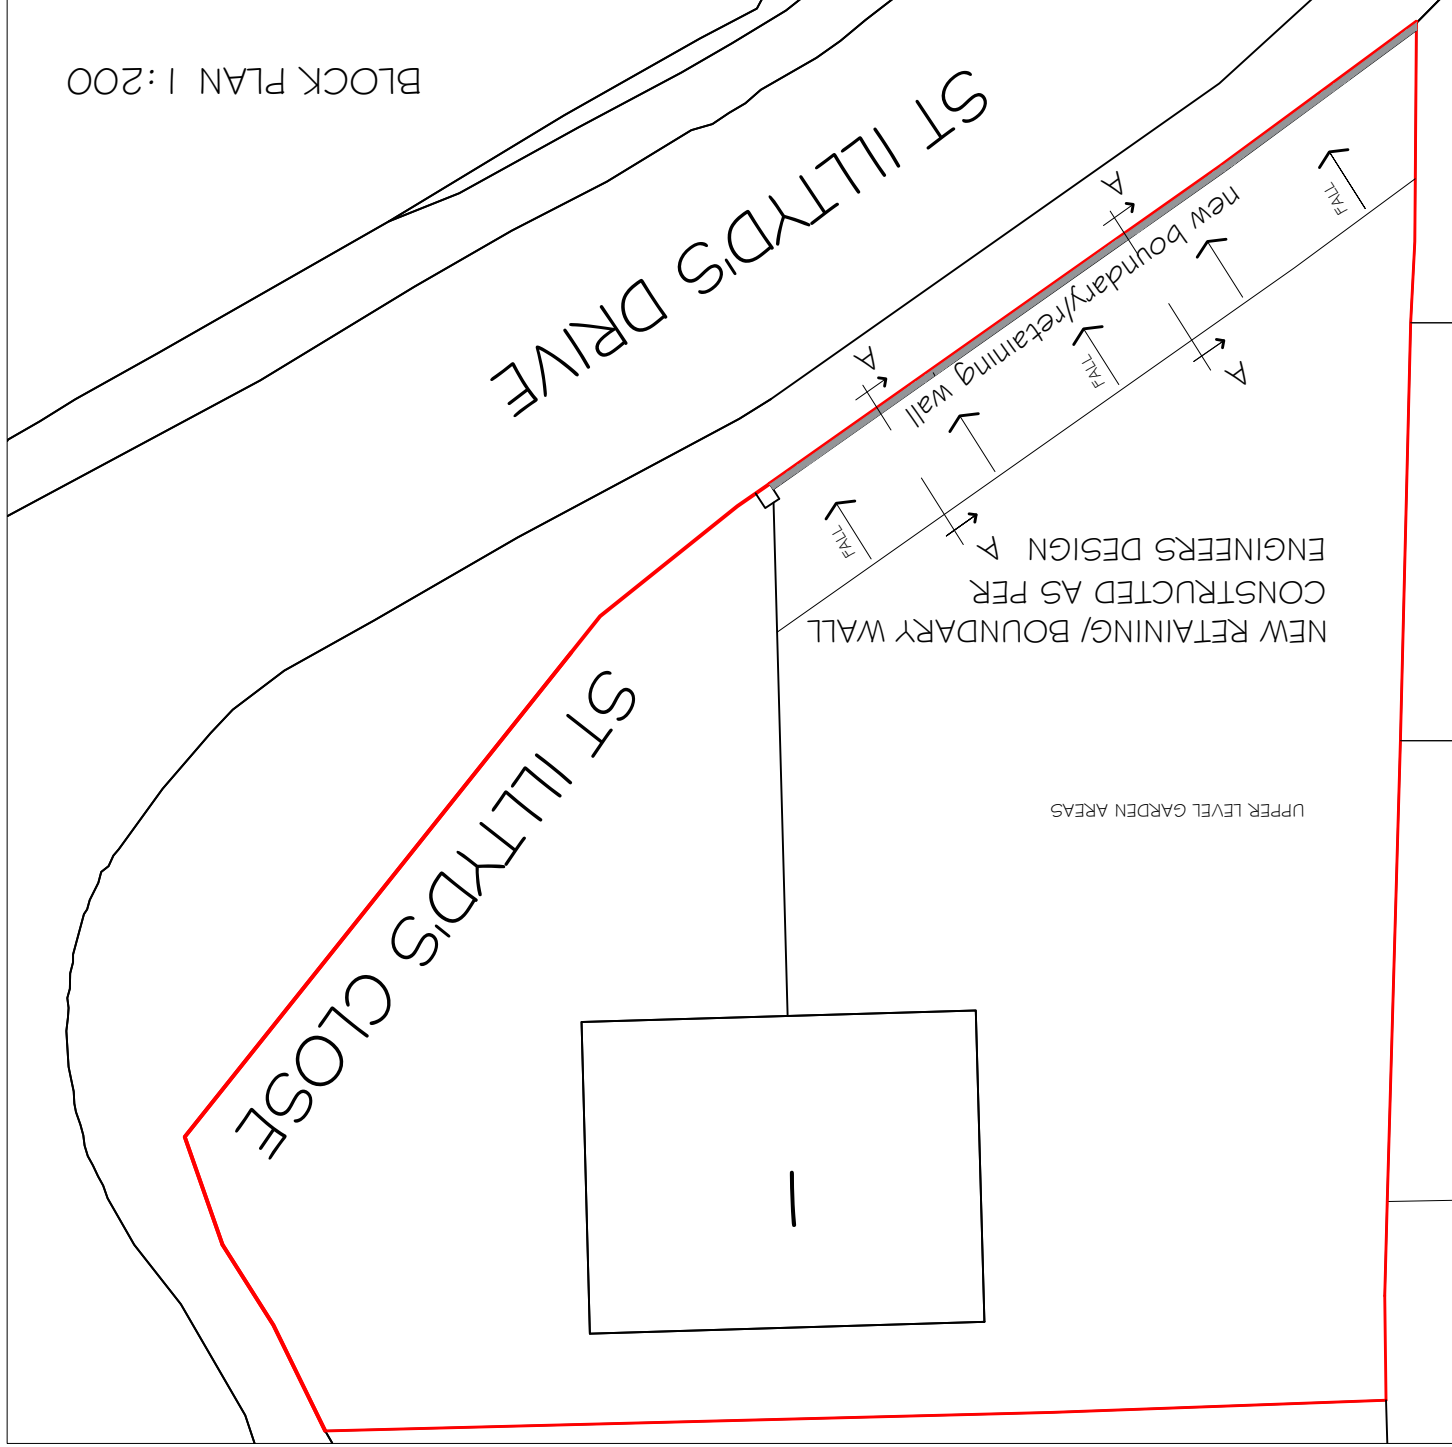

CROSS SECTION A-A 1:50
SEE DESIGN DETAIL

