



EXISTING boundary wall with fence
TO BE REMOVED


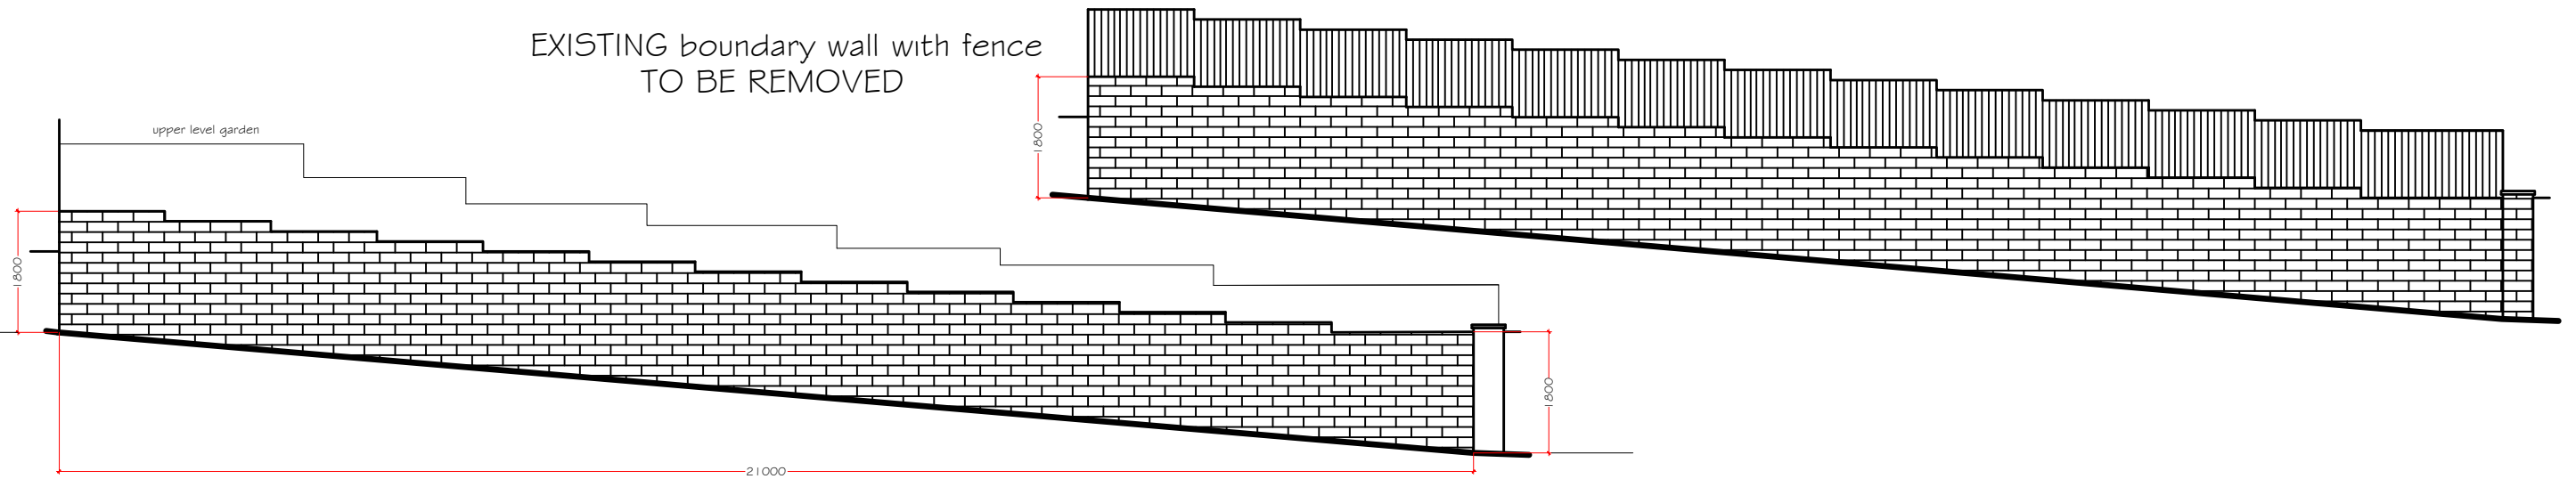


PROPOSED NEW BOUNDARY WALL
AND NEW RETAINING WALL 1:100

CROSS SECTION A-A 1:50

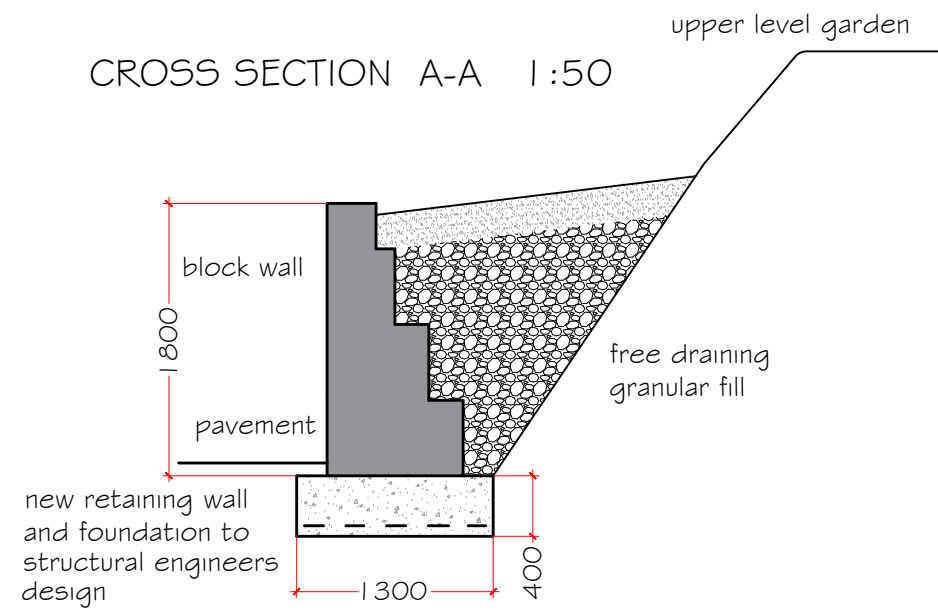

CROSS SECTION B-B 1:50

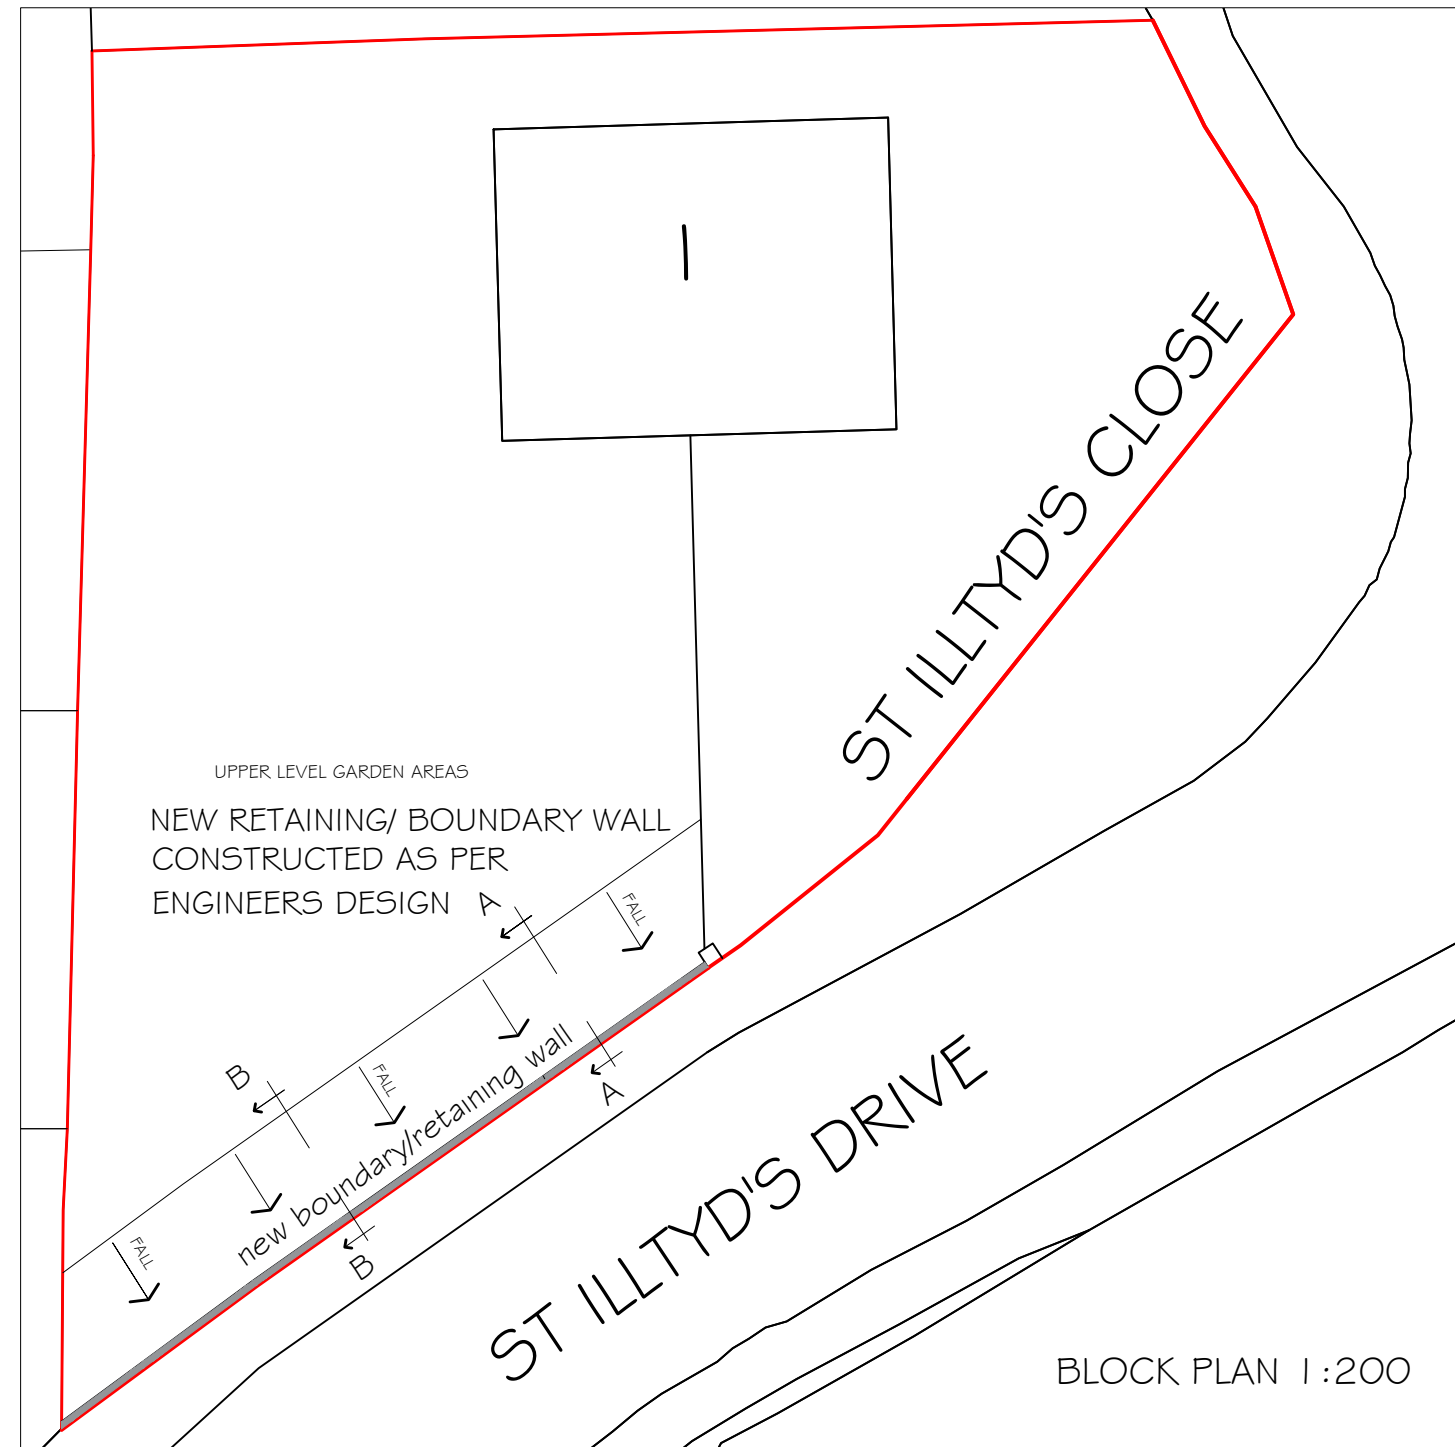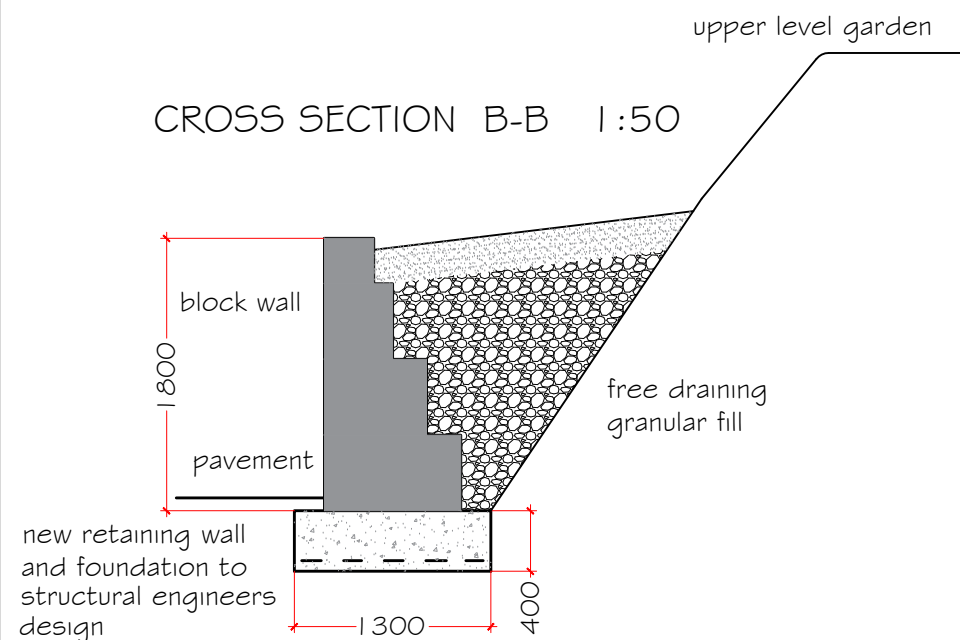

Revision B 20.02.23

X-Section B-B added

Revision A 29.01.23

DESIGN CHANGE
NEW BOUNDARY WALL ONLY

New Boundary Wall
1 St Illtyds Close
Baglan, Port Talbot

New boundary wall
AS CONSTRUCTED

drawing No 1 SIC - 02 rev B

scale noted date Jan 2023