




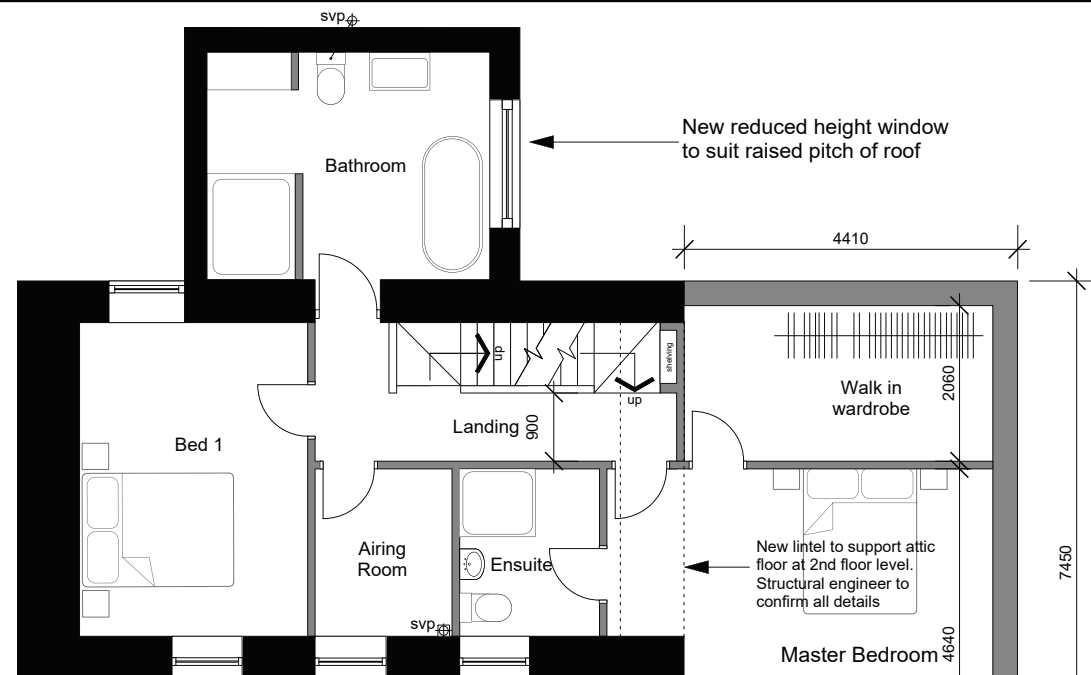

First Floor Plan

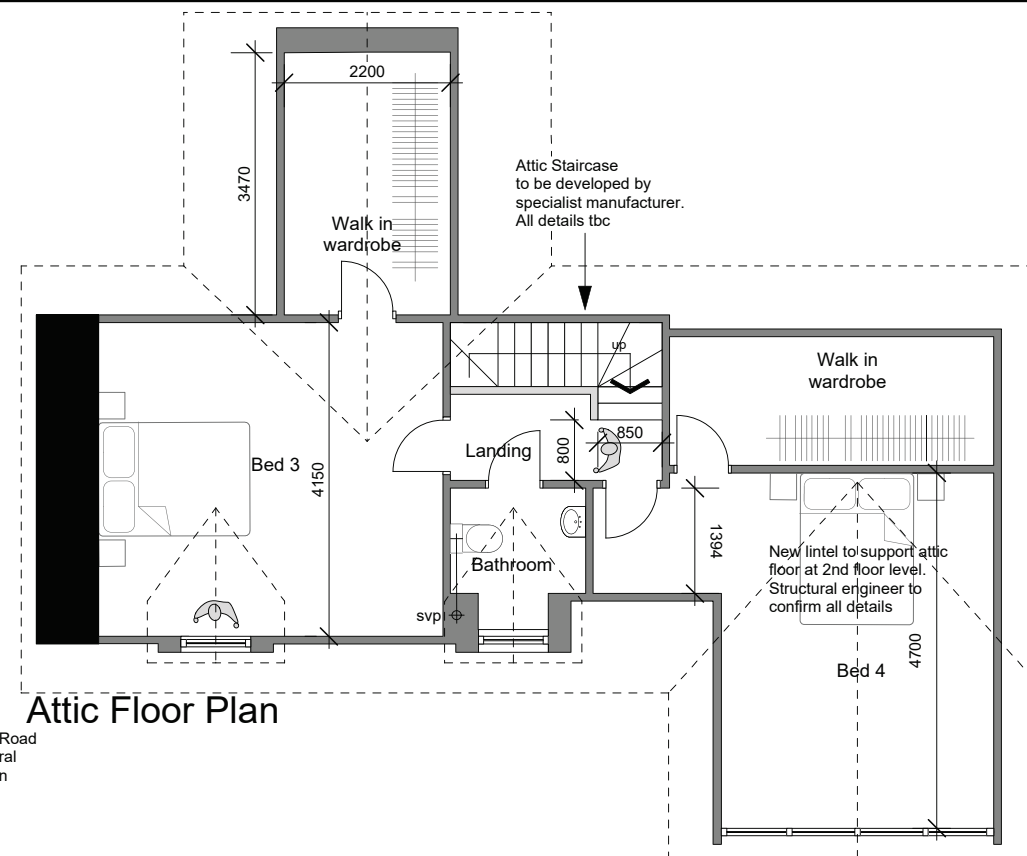

Attic Floor Plan

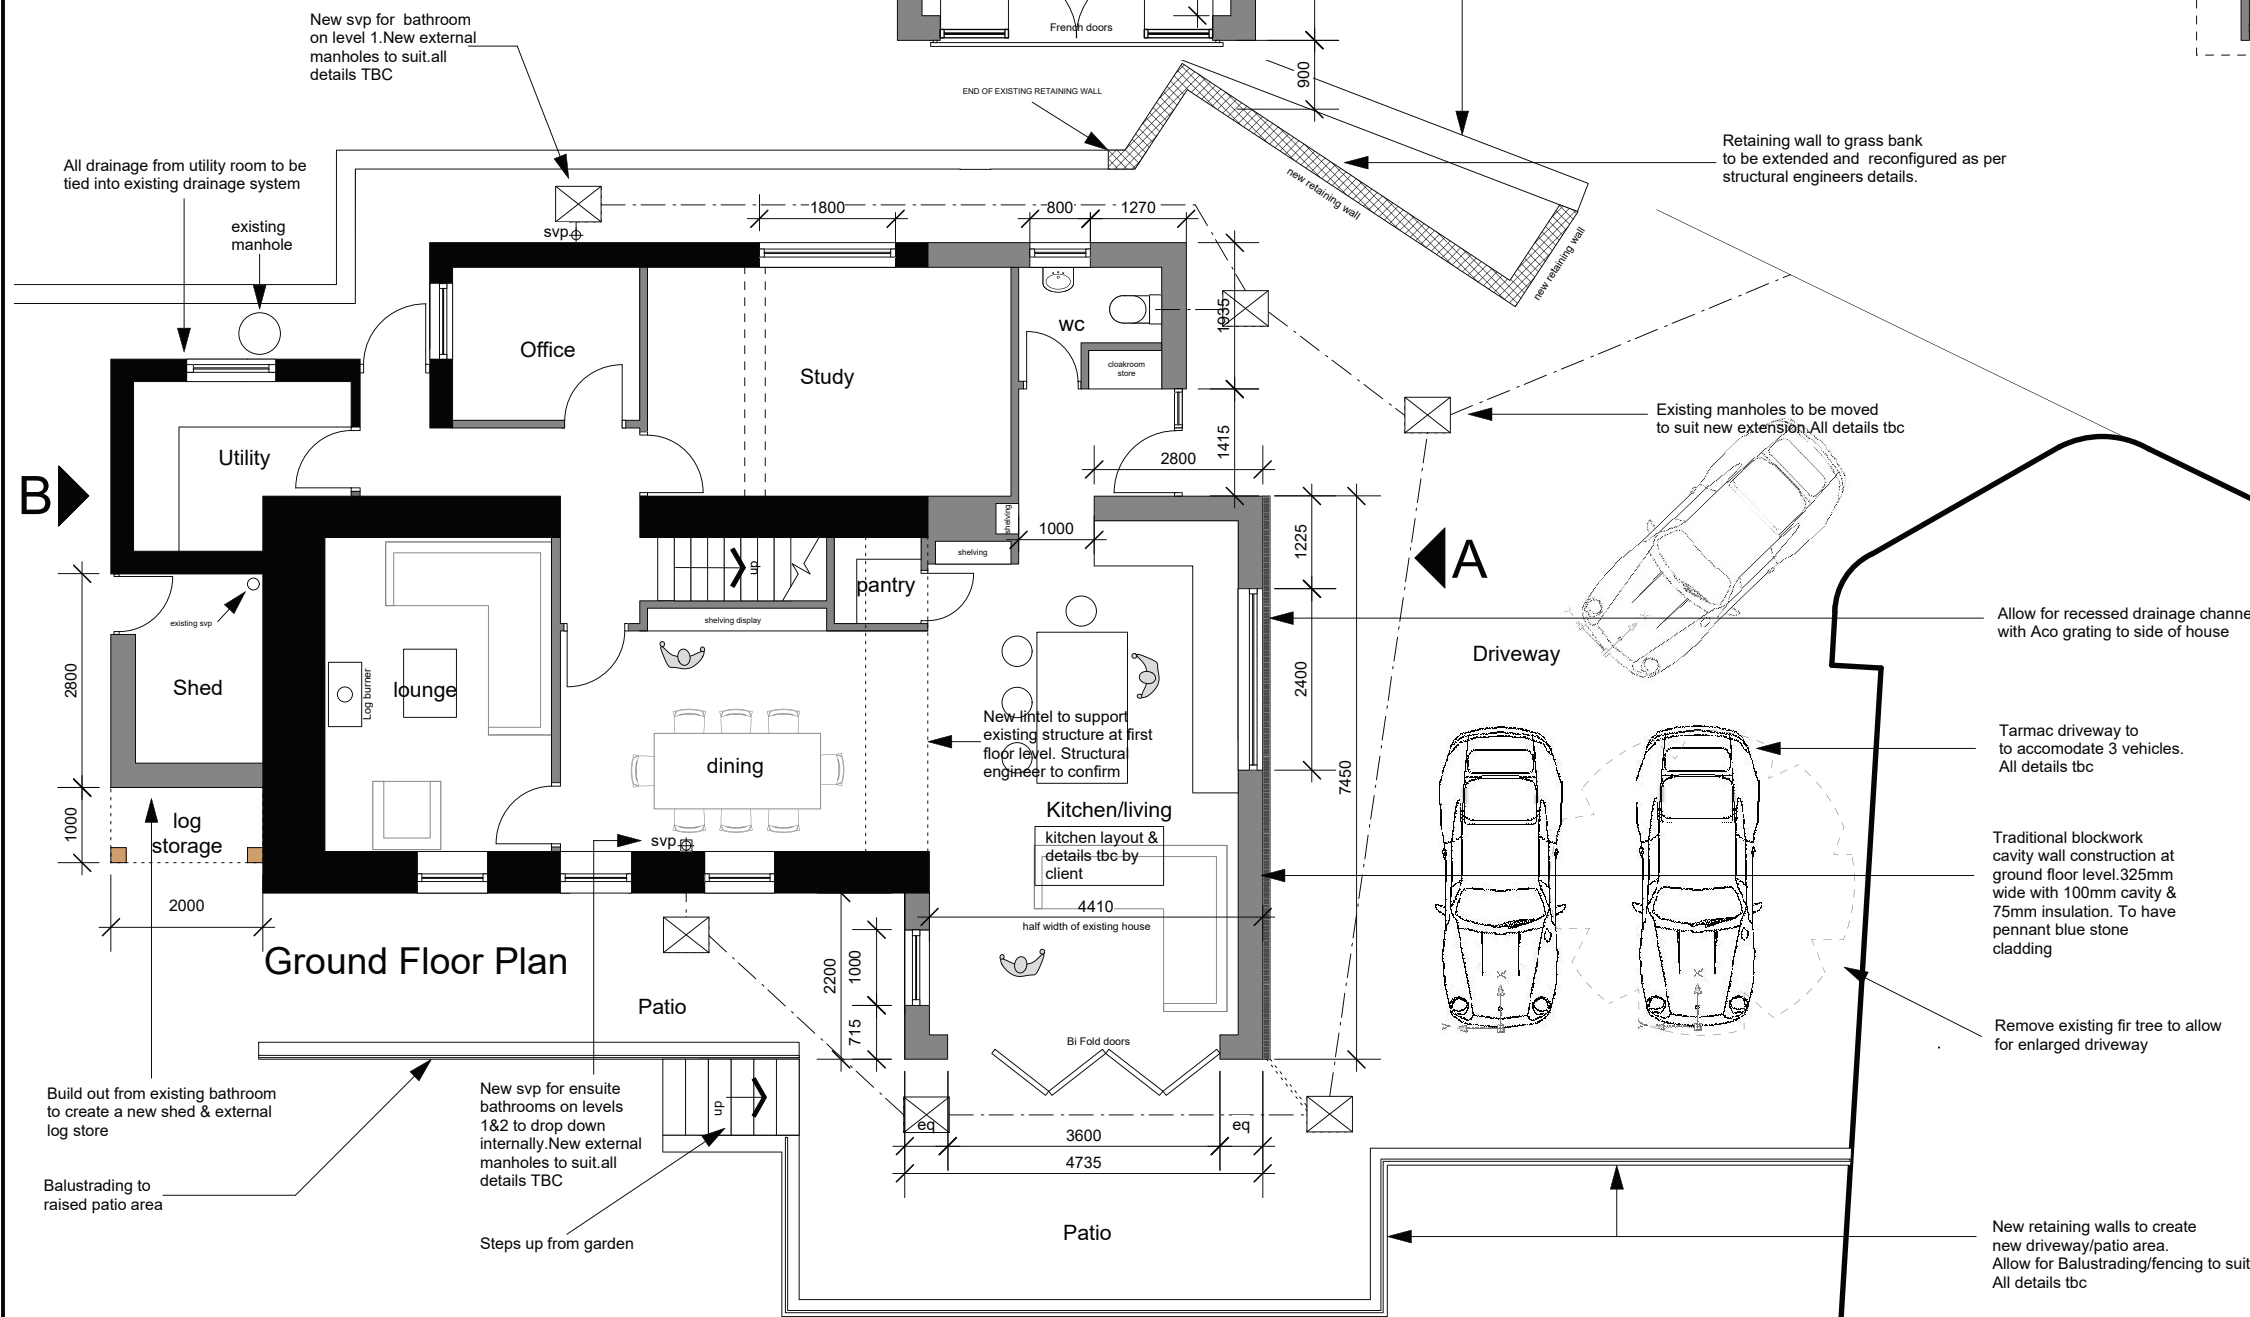

Ground Floor Plan

1. Do not scale off this drawing- Use Figured dimensions only
2. All dimensions are in mm unless otherwise stated
3. This drawing is to be read in conjunction with any other relevant drawings and subsequent engineers drawings & associated information.
4. All details & dimensions are to be confirmed on site prior to any works commencing or ordering materials. Contractor to liaise with Client when setting out extension on site.
5. Please note these are not working drawings and are for planning purposes only
6. This drawing has not been approved by building control. The contractor/Client will need to submit a building notice prior to the start of works or submit a full building regs submission. The final specification of all finishes & construction details to be advised by the contractor and should comply with building control. All details and finishes to be approved by Client.
7. Contractors final quotation to include itemised breakdown of all items and clear specification and proposal of all finishes etc
8. All construction details proposed by Contractor to be included as part of the quotation.
9. All works carried out to comply with current building regulations

amendments As built 27.3.23

BANKHEADDESIGN

client Mr & Mrs Jones

project 10 Graig road
Trebanos
SA8 4BA

title Proposed Plans

scale 1:100 @A3

dwg by

date March 2021

dwg no TJ-03 _rev

Dimensions to be verified on site. Figured dimensions to be taken in preference to those scaled.

This drawing is the property of Bankhead Design, copyright is reserved by them and the drawing is issued on the condition that it is not copied, reproduced, retained or disclosed to any unauthorised person, either wholly or in part without the consent in writing from Bankhead Design

Bankhead Design Ltd
20 Beechwood Avenue, Neath
SA11 3TE
Tel: 0781 8086740
email: info@bankheaddesign.co.uk