
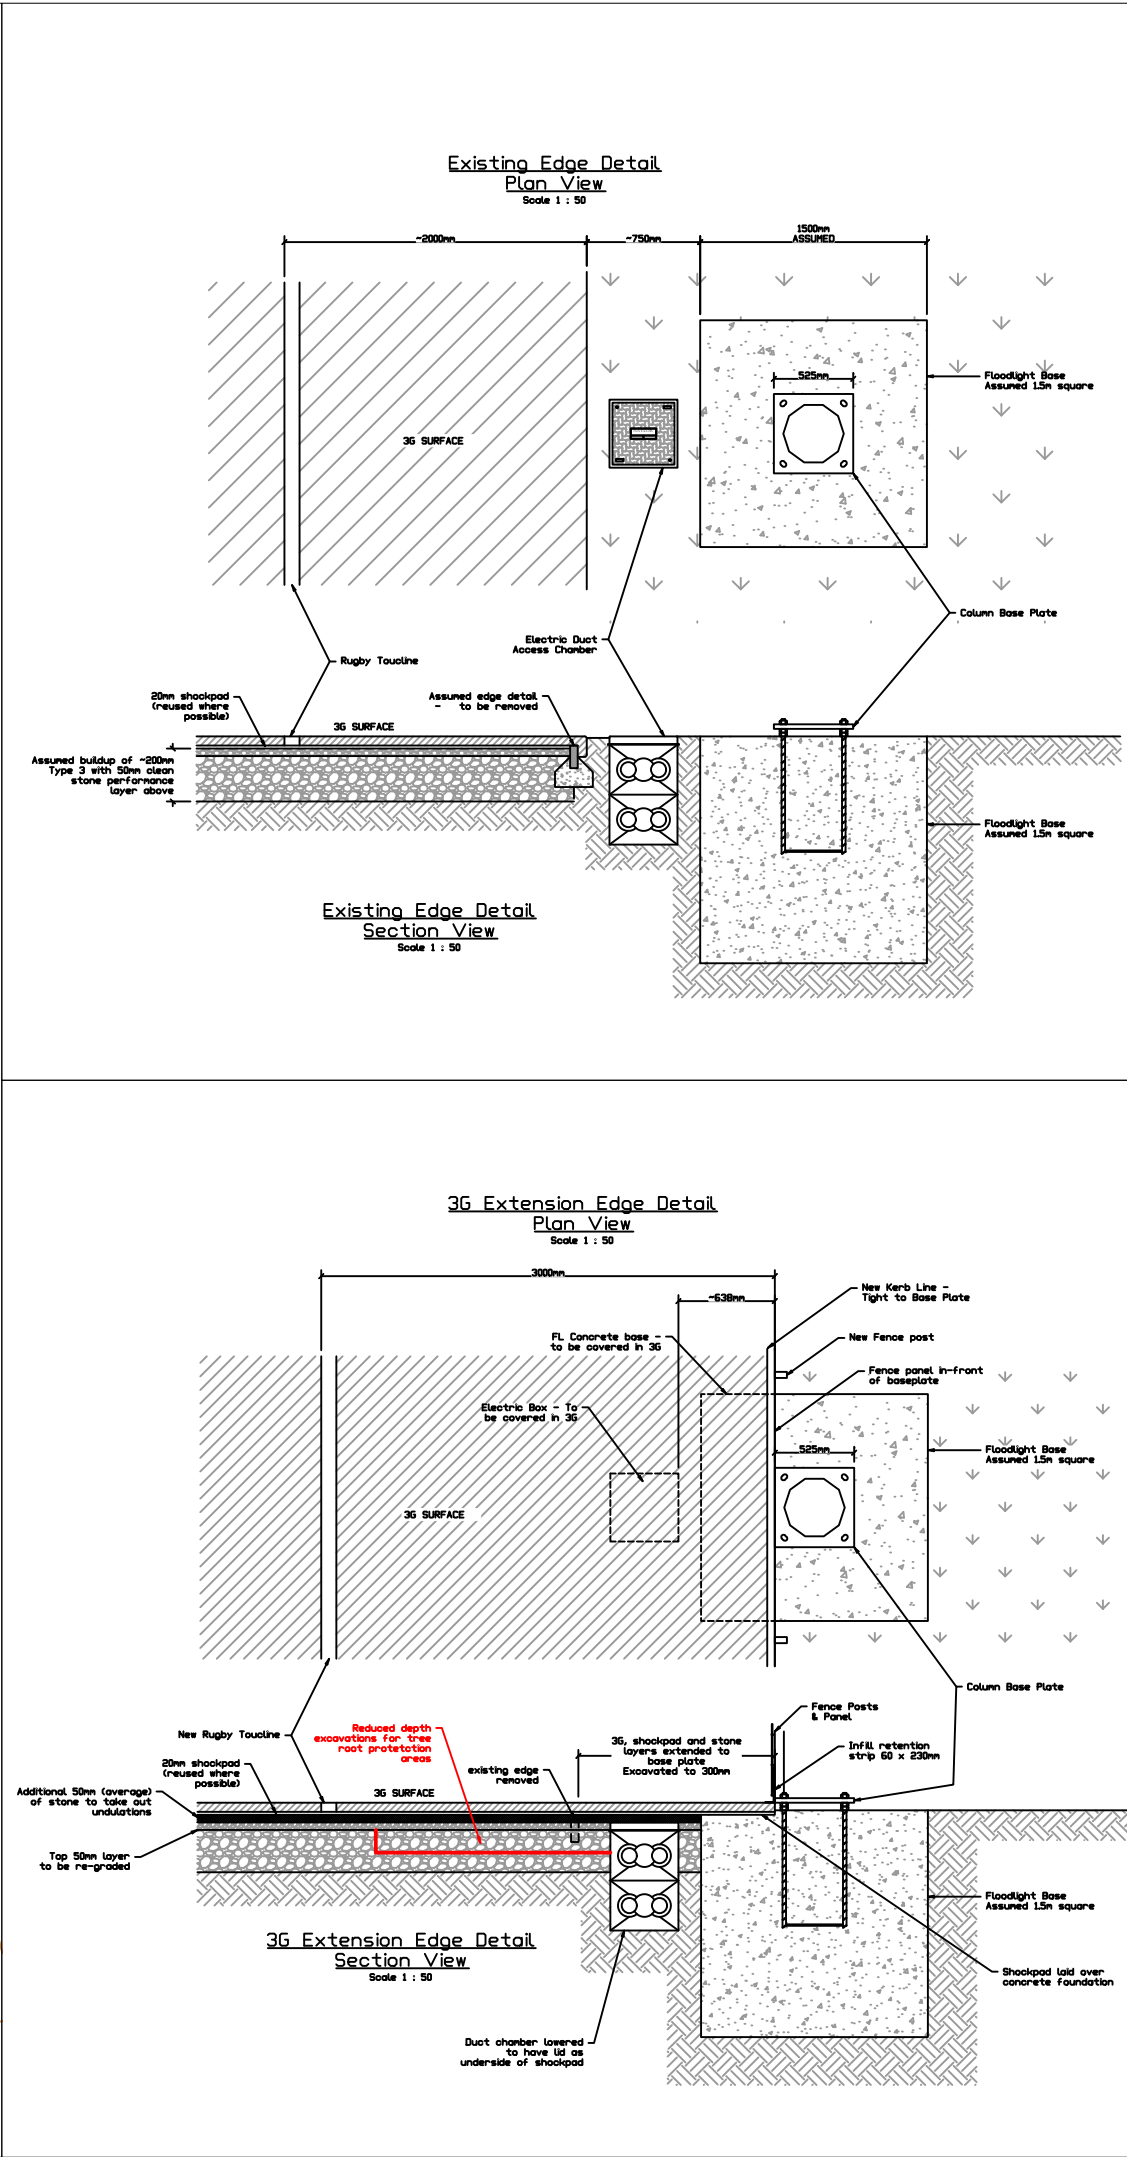


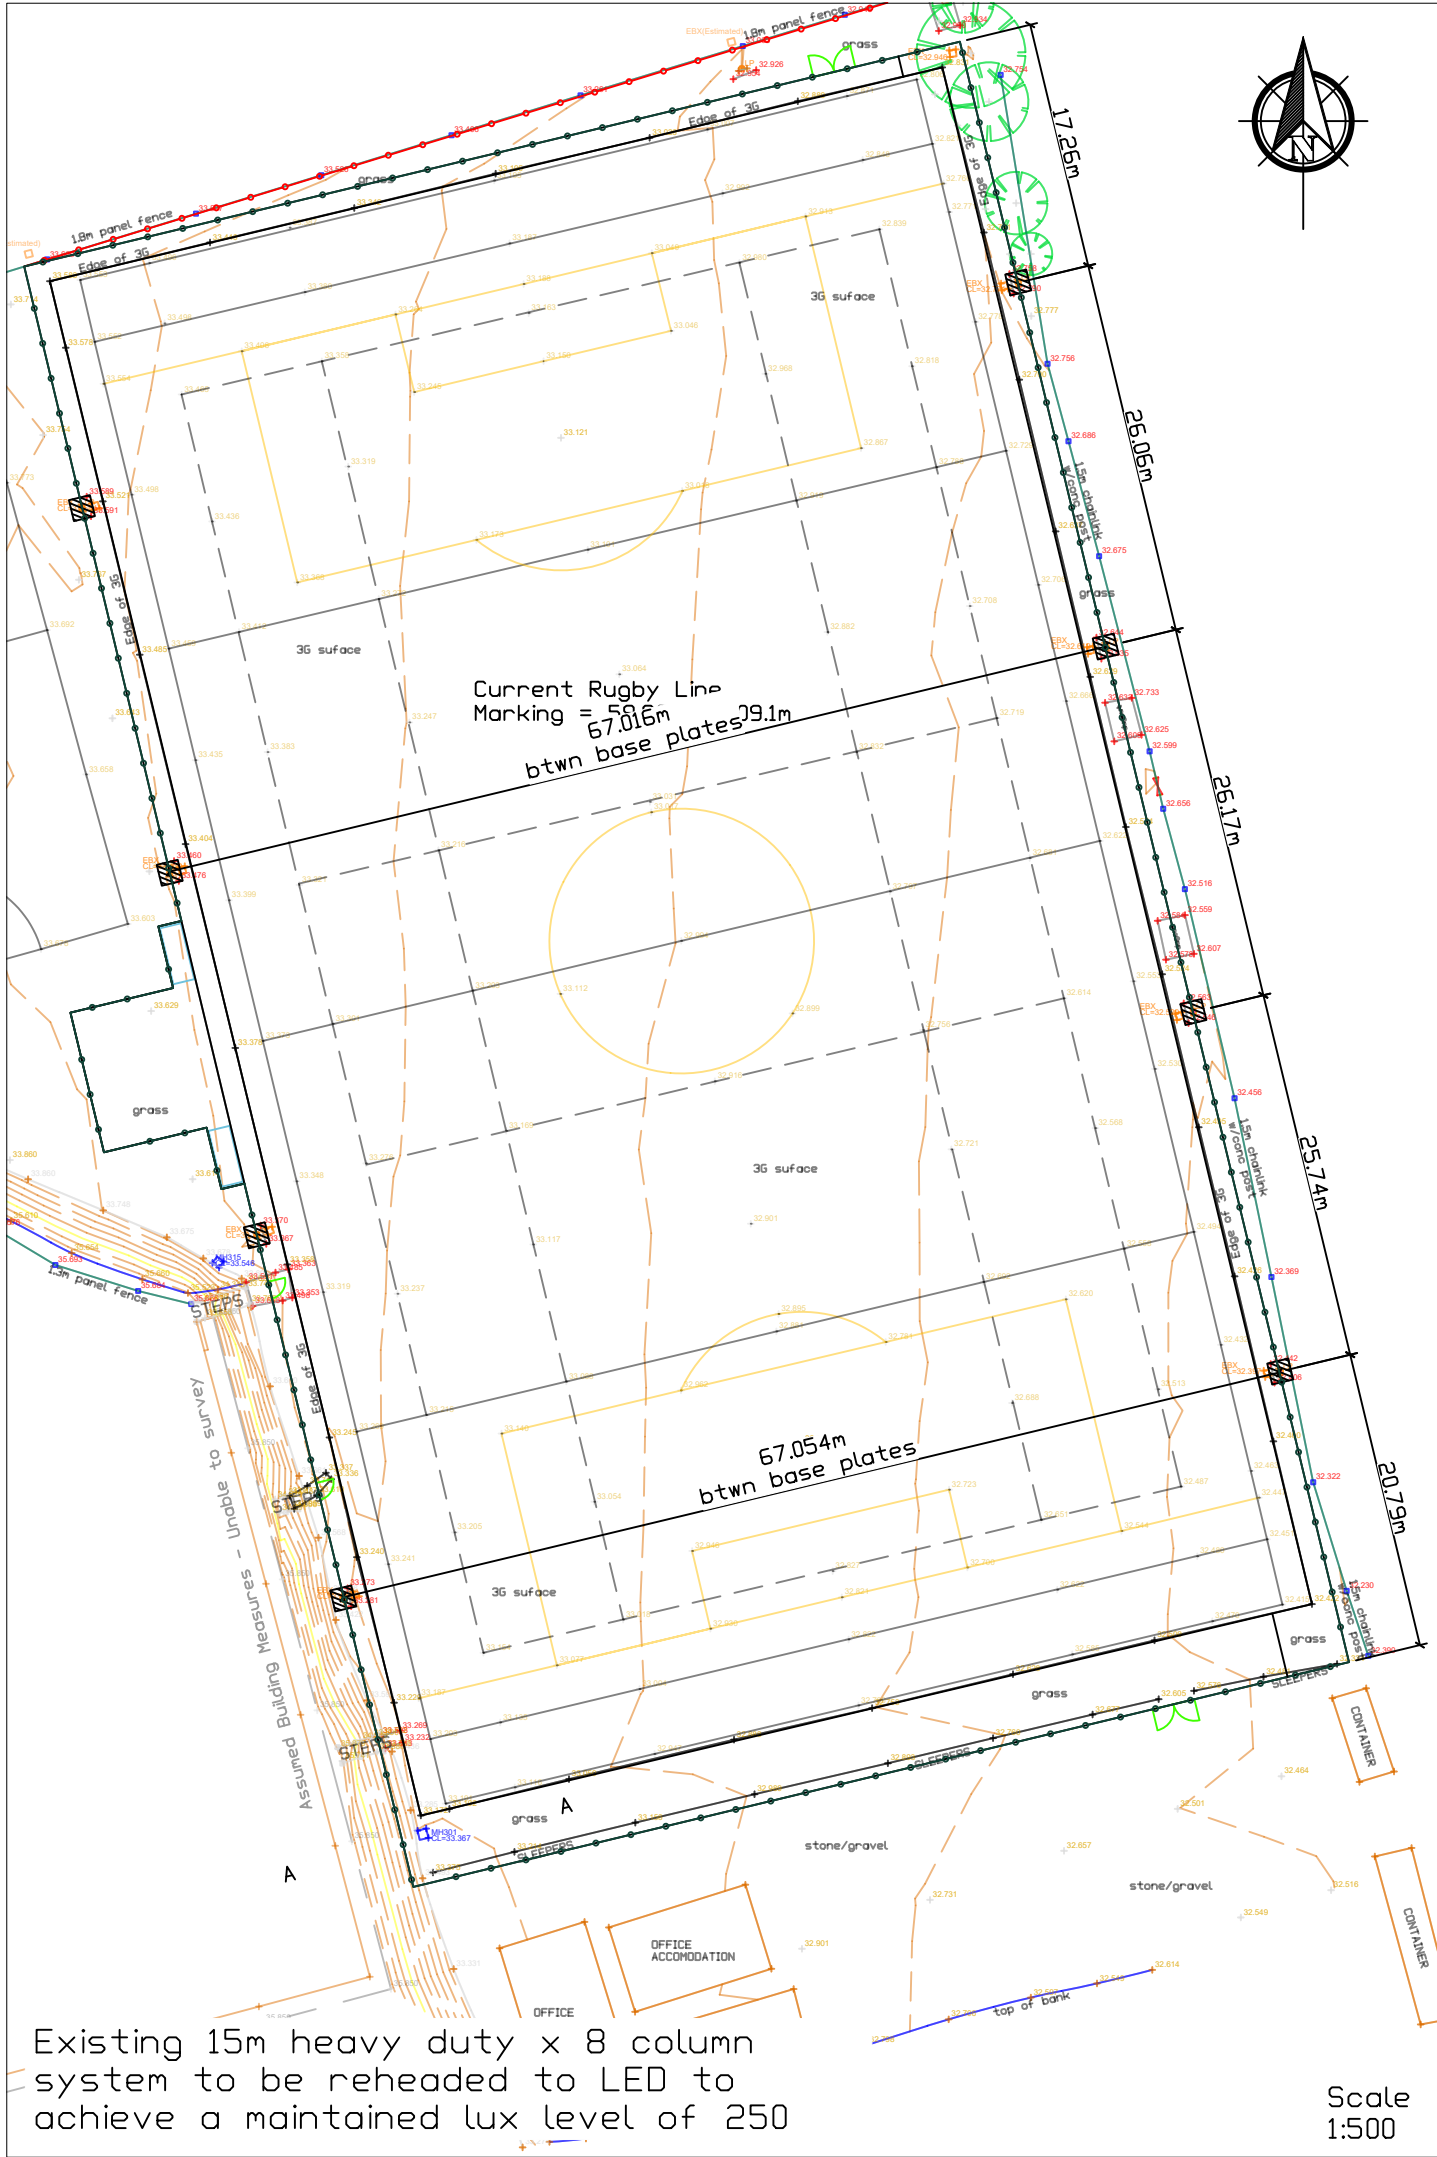

Summerleaze Acres, Pill Street, Magor
Monmouthshire, NP26 3DE
TEL: 01633 880493 EMAIL: info@swsgl.co.uk

Registered address as above
Reg no. 832363

NOTES :

KEY

REV	DATE	DESCRIPTION	BY
P02	17 / 04 / 2023	Root protection areas and descriptions.	GWT

DRAWING NUMBER :
Q20221207-LLDY-0004

BIM NUMBER

PROJECT TITLE :
LLANDARCY SPORTS ACADEMY

DRAWING TITLE :
PROPOSED LIGHTING CHANGES AND
BASE / EDGING INTERFACE

DATE : 08 / 12 / 2022

JOB NO :

DRAWN BY : GWT

SCALE : VARIES - SEE DETAILS
Printed @ A3

Numbering :

T	= Tender	C	= Construction	D	= Design
AB	= As Built	Pr	= Proposed	L	= Live

THIS DRAWING WAS DRAWN BY SOUTH WALES SPORTS GROUNDS AND IS CORRECT TO THE COMPANIES KNOWLEDGE

DO NOT SCALE FROM THIS DRAWING

CONTRACTORS MUST CHECK ALL DIMENSIONS ON SITE. ANNOTATED DIMENSIONS MAY REFLECT INACCURATELY ON SITE. ANY NOTICED DISCREPANCIES MUST BE REPORTED IMMEDIATELY TO SOUTH WALES SPORTS GROUND CONTRACTORS LTD.

CONTRACTORS TO REFER TO THE SPECIFICATION BY DEFAULT.

RESIDUAL RISKS ARE NOT HIGHLIGHTED IN THIS DRAWING AND FURTHER INFORMATION SHOULD BE SOUGHT

ALWAYS CHECK FOR LATER REVISIONS OF THIS DRAWING