




Proposed Front Elevation
1 : 100



Proposed Rear Elevation
1 : 100

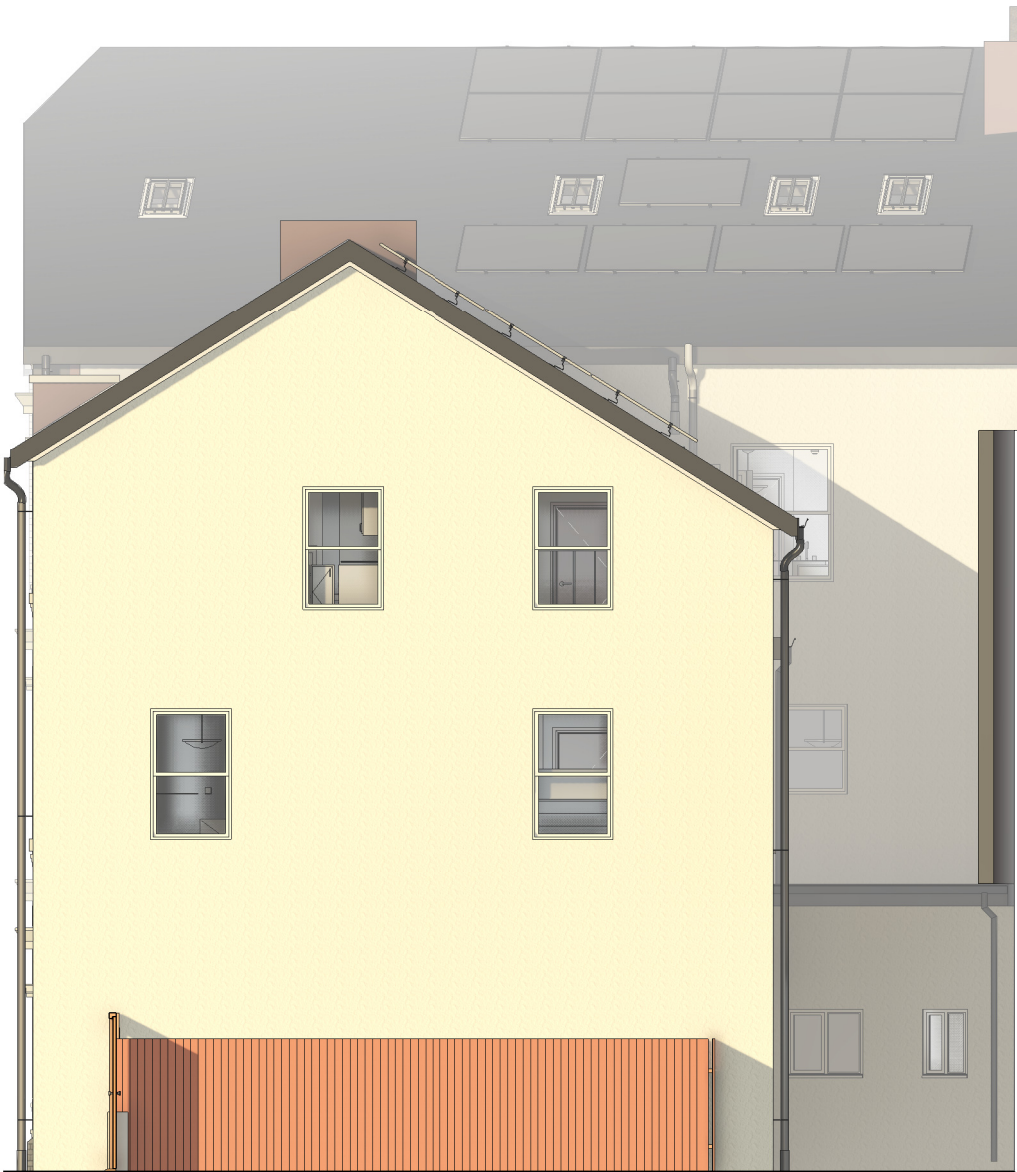

Proposed East Elevation
1 : 100



Proposed West Elevation
1 : 100

darkin
architects


drawing on
experience

www.darkinarchitects.com

CARDIFF 02921 197 196
LLANELLI 01554 778 730
NEATH 01639 383 000

info@darkinarchitects.com

RIBA

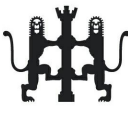

Chartered Practice

THIS DRAWING IS THE COPYRIGHT OF DARKIN ARCHITECTS AND MAY NOT BE COPIED, ALTERED OR REPRODUCED IN ANY FORM OR PASSED TO A THIRD PARTY WITHOUT THEIR CONSENT. DIMENSIONS MUST BE CHECKED AND VERIFIED ON SITE AND ANY DISCREPANCIES SHOULD BE REPORTED TO THE ARCHITECT. THIS DRAWING MUST NOT BE SCALED AND SHOULD BE READ IN CONJUNCTION WITH ALL OTHER CONSULTANT'S DRAWINGS. IF IN DOUBT ASK FOR CONFIRMATION.

NOTES

Rev	Description	By	Date
G	Render reinstaterd to elevations as per original design	JDH	02.02.2021
H	Amendments	NCR	30.06.23
I	Annotations Removed	NCR	04.07.23
J	Amended note	AV	05.07.23

CLIENT:

Castell Group

PROJECT

Big Cam

PROJECT ADDRESS

The Big Cam, 9 Windsor Rd,
Neath, SA11 1LS

DRAWING TITLE

'As Built' Elevations

DRAWN BY	CHECKED BY	© Copyright Darkin Architects 2021
TOM	DLD	
PROJECT REF	SCALE	PAPER SIZE
RC176	1 : 100	A2
DRAWING	REVISION	DATE
302	J	26.10.2020