




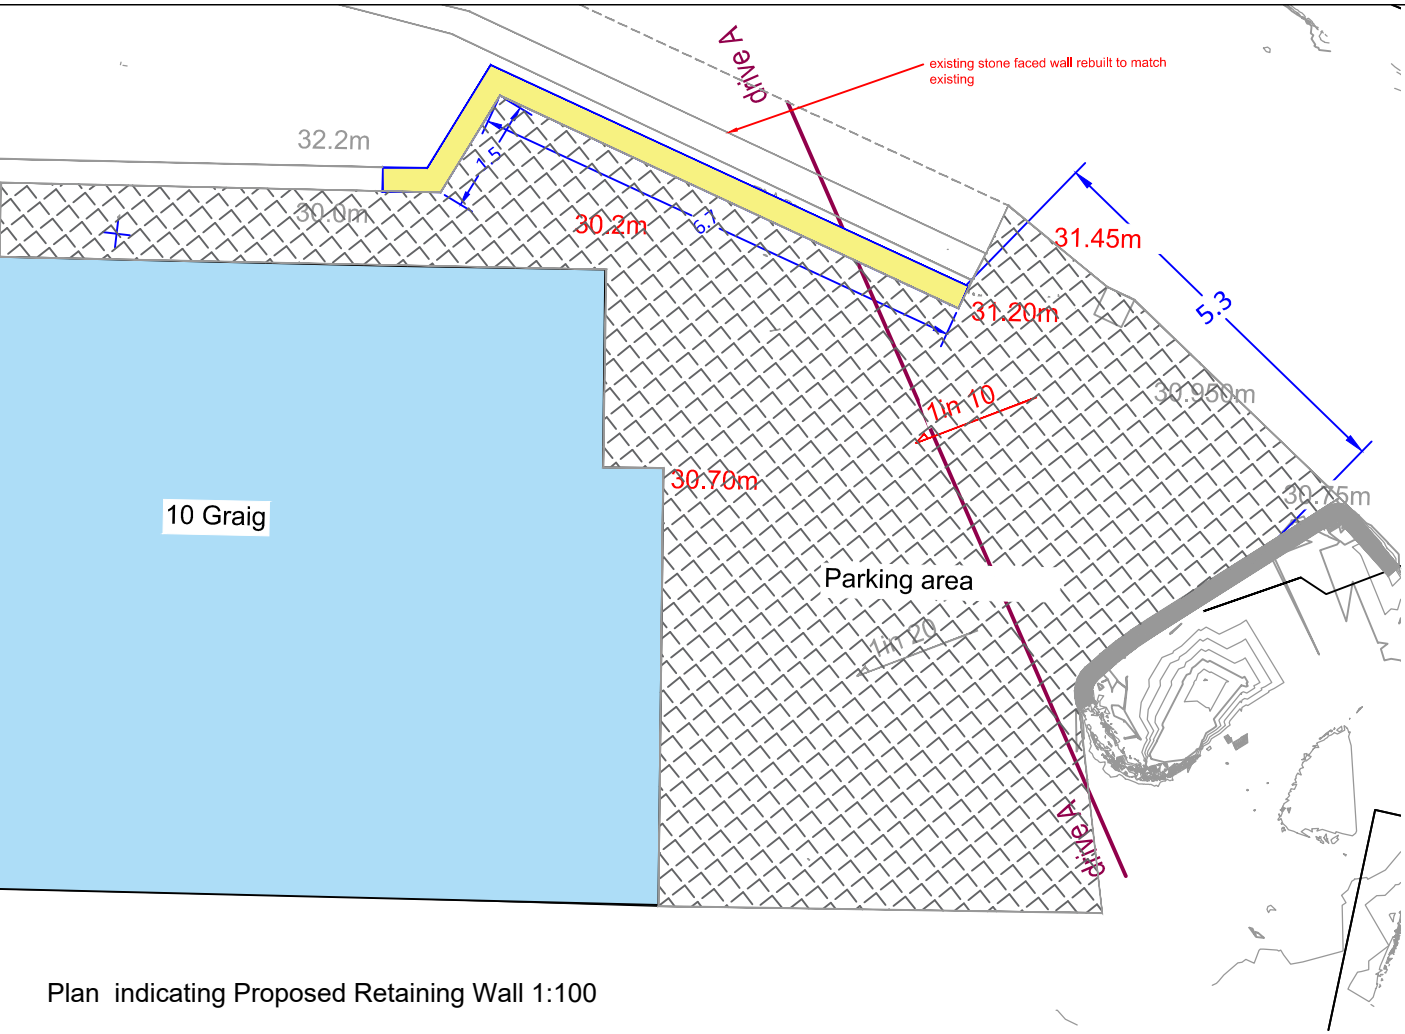

Plan indicating Proposed Retaining Wall 1:100

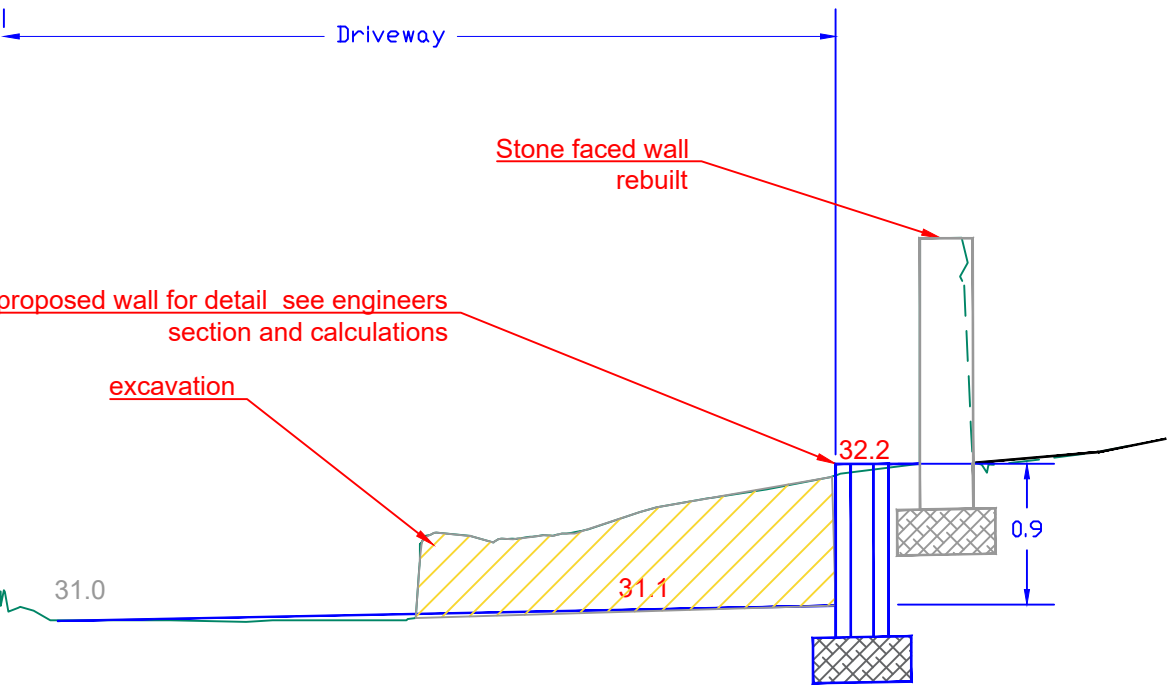

Drive Section A-A

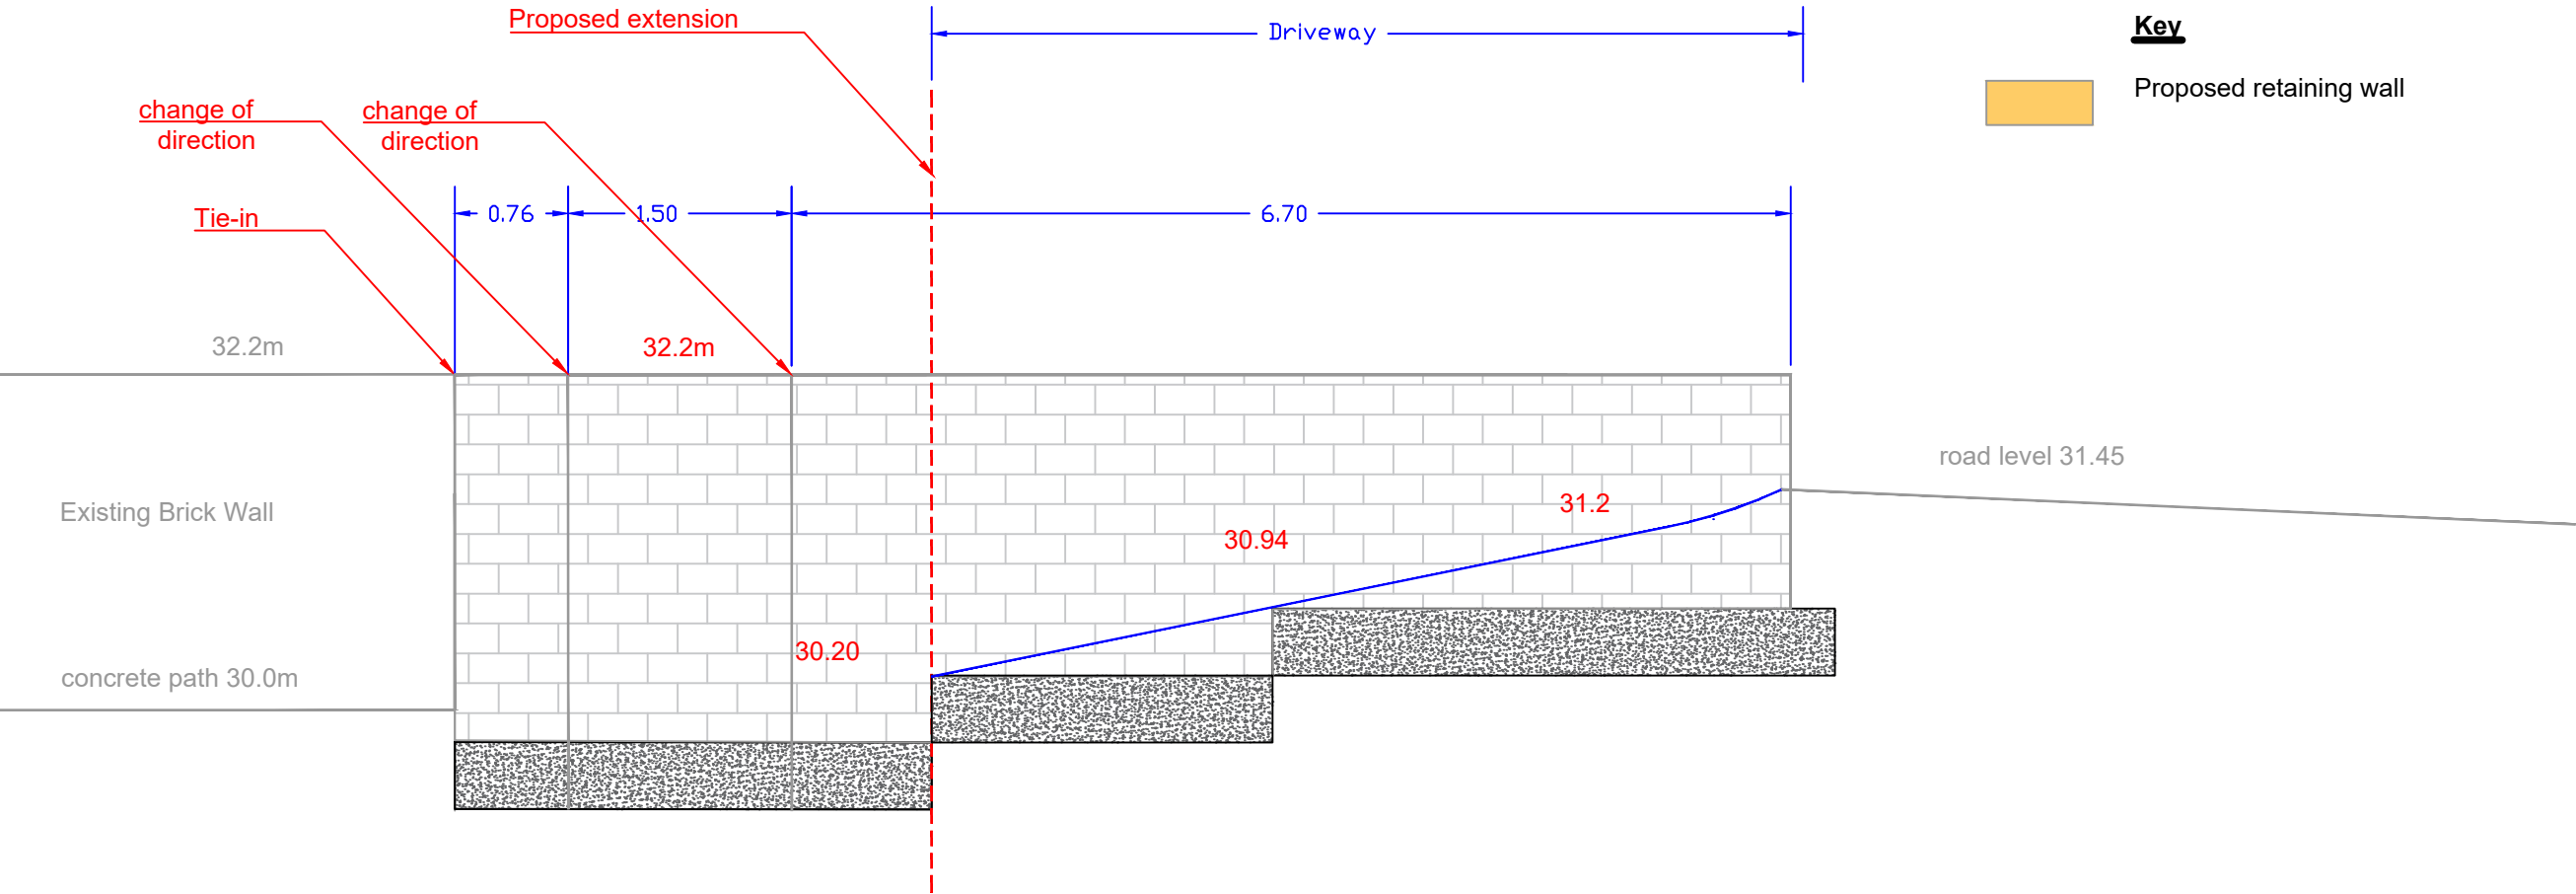

Long-section through Proposed retaining wall

Key
Proposed retaining wall

Title:			
10 Graig Road Retaining wall section as built			
Scale	Drawn	Checked	Approved
SHOWN	KJS	DP	
Original drawing A3	Date	Date	Date
Job No. GC	02.23	02.23	
Drp No. 1001	B		