
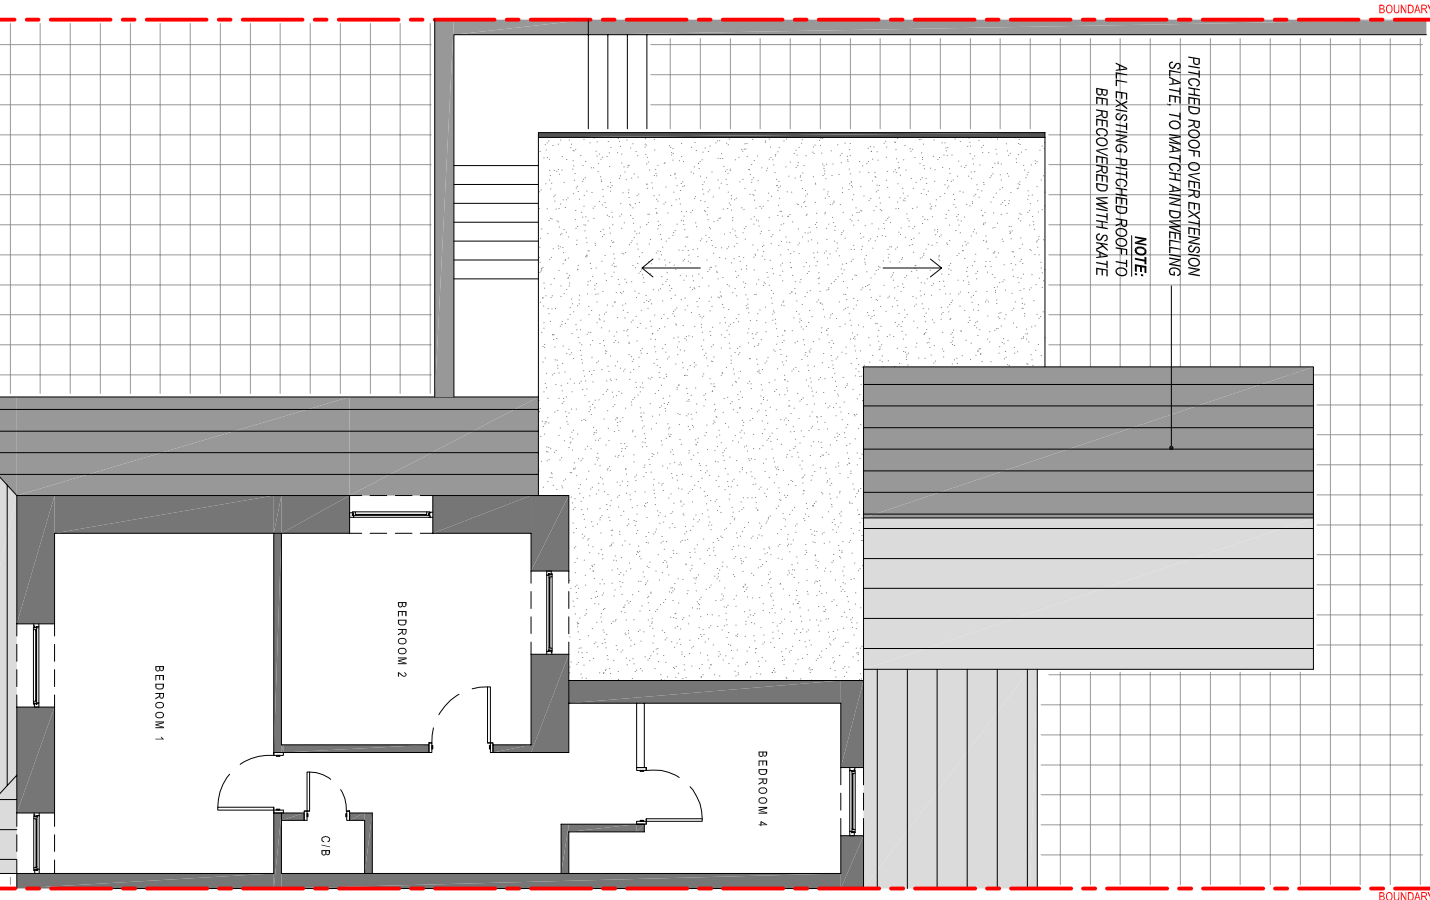
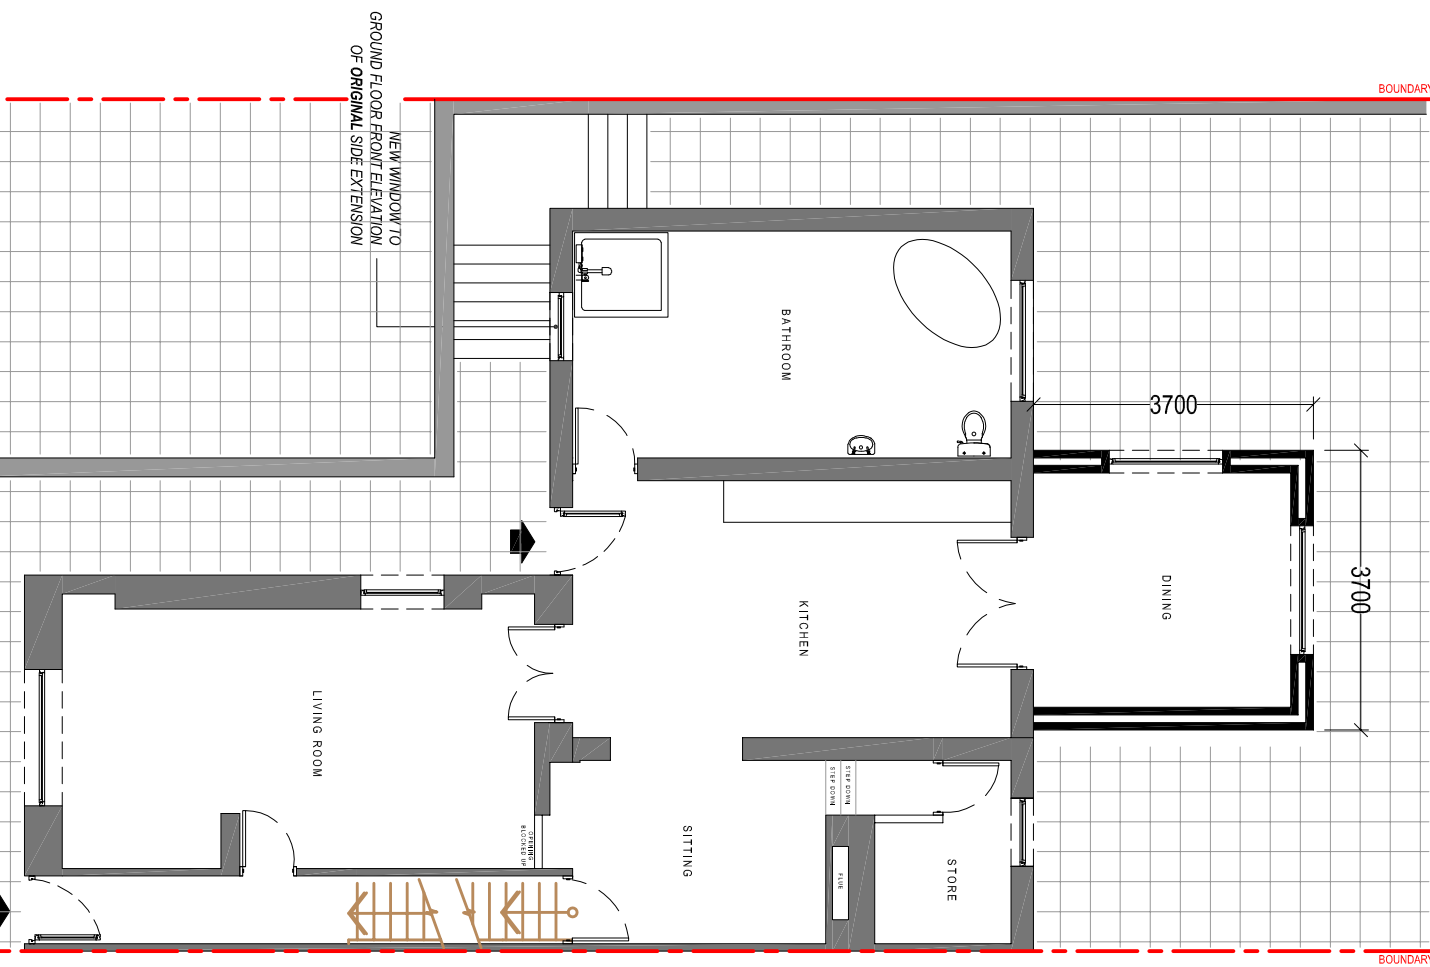
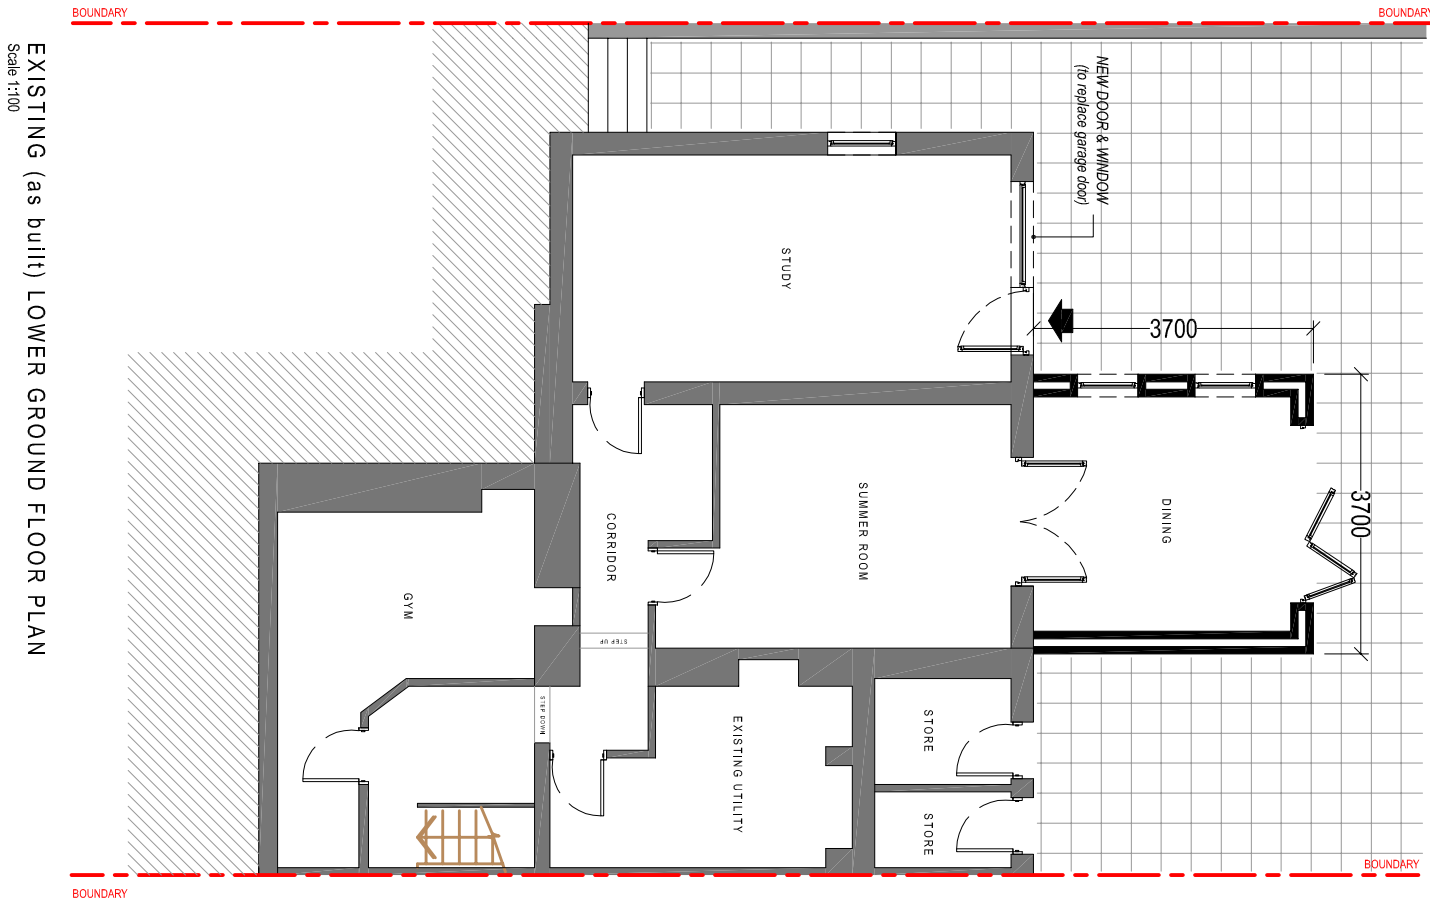


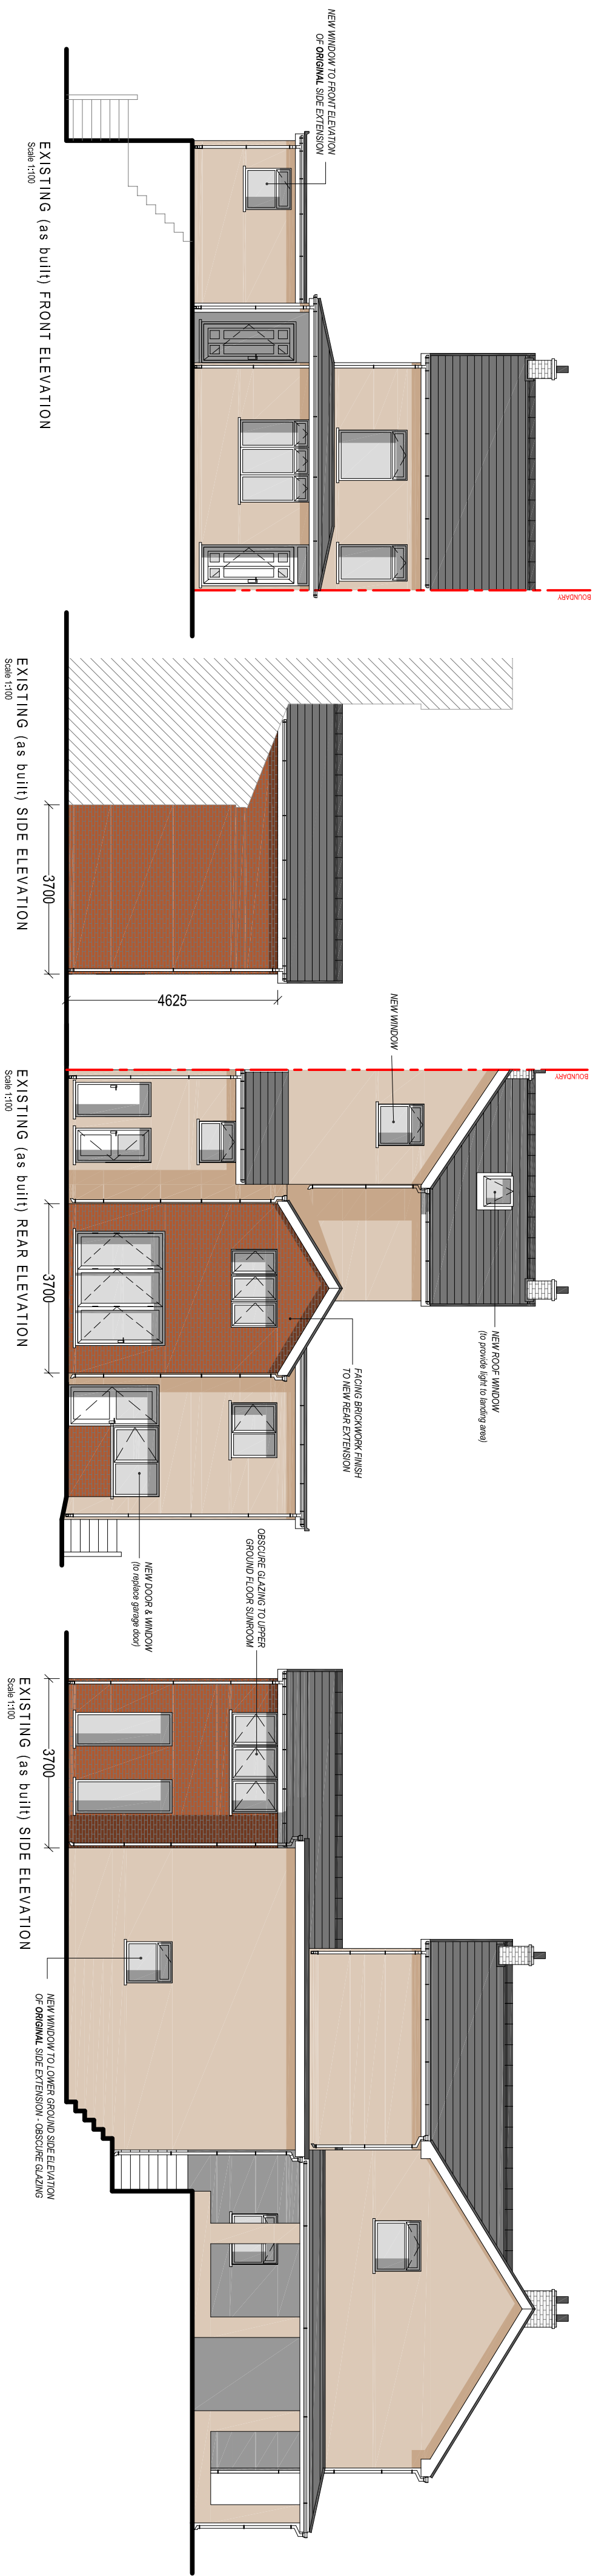

MATERIAL FINISHES (Proposed Rear extension):

Roof Covering:
slate (to match main dwelling)
Concrete ridge (to match main dwelling)

Wall Covering:
Facing Brickwork

Windows & Doors:
uPVC Double Glazed.
Colour: Black

Weather boarding:
uPVC bulltosed
Colour: Black

Rainwater goods:
Plastic, universal
Colour: Black

Client:
Mr. Stephen Trollope
18 Martyns Avenue,
Seven Sisters,
Neath,
SA10 9DR

Project Title:
**PROPOSED REAR
EXTENSION
& DETACHED GARAGE**

General Notes:
1. Do not scale from this drawing. Scale figures dimensions only.
2. Dimensions are in millimeters unless otherwise stated.
Drawing Issue:

PLANNING

Drawing Title: EXISTING (AS-BUILT) ELEVATIONS & FLOOR PLANS			
Drawing No:	CPD-004	Revision:	
Date:	03-06-2023	Revised:	
Scale:	1:100	Paper Size:	A2



Cwm Planning & Design Ltd.
(Architectural and Drafting Services)