


GLYNNEATH DEVELOPMENT

PLANTING PLAN

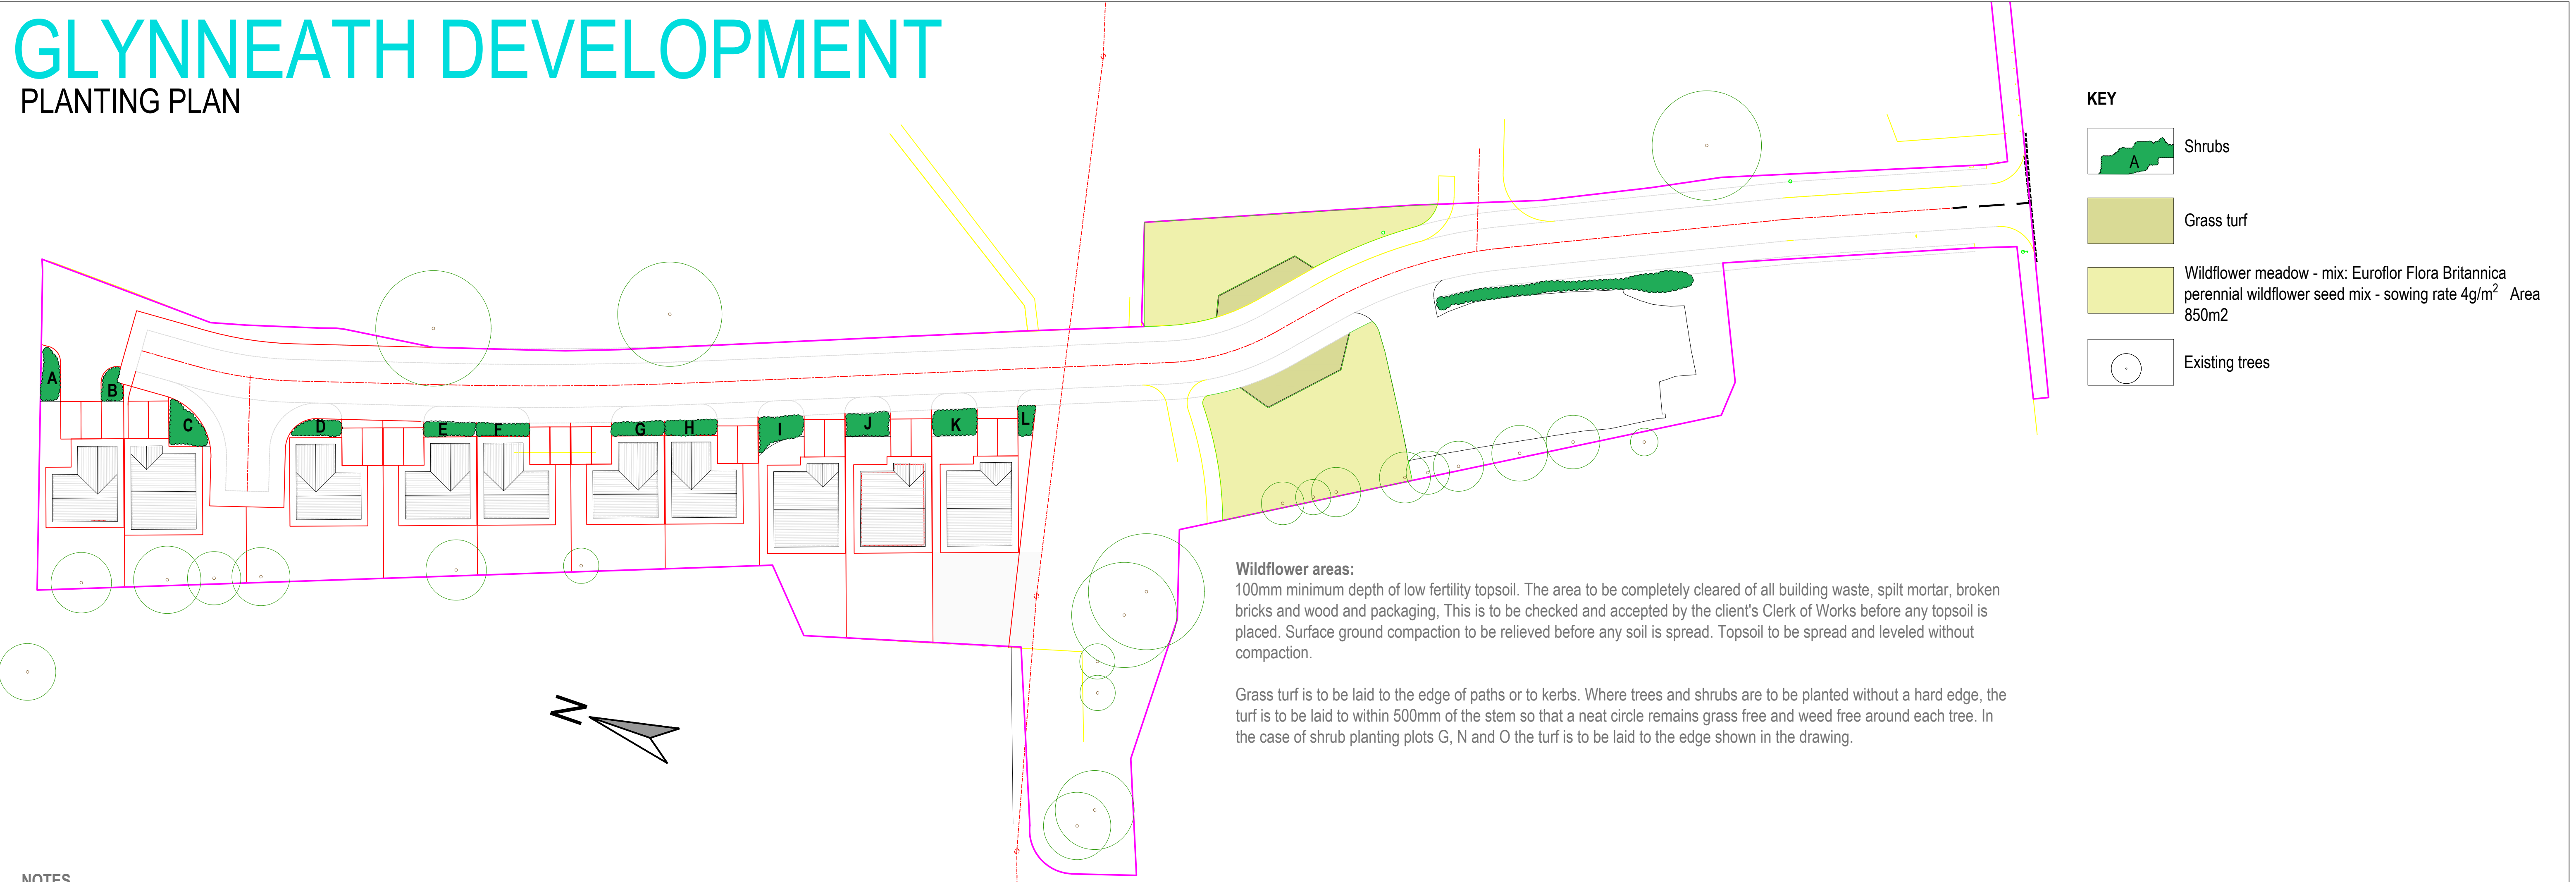

NOTES

All trees to be pit planted with double stakes and fixed with rubber or nylon tube tie. Stakes to be 2m and driven into bottom of pit. Final height of stakes to be one third of clear stem height.

Tree planting areas: 300mm minimum depth in the area to be planted. Before any topsoil is spread an area of 4m² (2x2m) around each tree station is to be excavated 200mm into the underlying material and all arisings taken from the site. This is to be checked and accepted by the client's Clerk of Works before any top soil is placed. Topsoil to be spread and leveled to a minimum of 300mm without compaction.

Tree pits are to be dug 200mm deeper than would be required for the hole to accommodate the root ball, and 400mm wider than the diameter of the rootball. The base of the excavation is to be broken up to relieve compaction. The topsoil is to be placed around the rootball and firmed so that the finished surface is level with the soil mark on the stem.

Following tree planting bark mulch is to be spread over the full extent of the tree circle to depth of 50mm.

Shrub Planting Schedule																		
Species	Pot size	No./m ²	A	B	C	D	E	F	G	H	I	J	K	L	M	N	O	TOTAL
Rubus tricolor	9cm	4															36	36
Viburnum plicatum tomentosum Kilimanjaro	3L	2													24	24		48
Salvia officionalis 'Purpurescens'	3L	3			9													9
Rosmarinus officionalis 'Prostratus'	3L	2			6		6											12
Ribes alpinum	2L	2													18	18		36
Potentilla 'Vilmoriniana'	3L	3			6	6												12
Pittosporum tenuifolium 'Tom Thumb'	3L	2	4	4							4	4	4	4				24
Mahonia x media 'Winter Sun'	3L	2													22	24		46
Lavendula angustifolia	1.5L	4			16	12	8	8	8	12								64
Hypericum calycinum	2L	8															48	48
Hebe brachysiphon 'White Gem'	4L	3	6	6	6	6					6	6	6	6				48
Genista lydia	3L	2				4		6	6	6								22
Euonymous fortune 'Silver Queen'	3L	3	18	6							15	12	15	6			33	105
Euonymous fortune 'Emerald and Gold'	3L	3	6	6							6	6	6	6				36
Cotoneaster adpressus	3L	3	9	6			6				9	9	9	3			30	81
Cornus sanguinea 'Midwinter Fire'	3L	3													24	26		50
Cistus x corbariensis	3L	2			6	6	6	6	6	6								36
Caenothus thyrsiflorus 'Repens'	3L	2			6			6	6	6								24
TOTAL			43	28	55	34	26	26	26	30	40	37	40	25	88	92	147	737

NOTES

Plots A to O: 300mm min. depth of topsoil. Plot to be excavated to a minimum depth of 200mm with all arisings, including all building debris to be removed from site. This is to be checked and accepted by Clerk of Works before any topsoil is placed. Immediately before placing of topsoil, the base of the plot is to be broken up to a depth of 100mm to relieve compaction and allow future root penetration. Topsoil to be placed to full depth of 300mm with no compaction.

Plots N and O: 300mm min depth of topsoil. Plot to be excavated to a minimum depth of 300mm with all arisings, including all building debris to be removed from site. This is to be checked and accepted by Clerk of Works before any topsoil is placed. Immediately before placing of topsoil, the base of the plot is to be broken up to a depth of 100mm to relieve compaction and allow future root penetration. Topsoil to be placed to full depth of 300mm with no compaction.

Plots A, B and I,J,K,L: Cotoneaster and Euonymous spread throughout the plot. Pittosporum and Hebe distributed as specimens towards the back of the plot.

Plots C to H: Lavendula distributed along the front of each plot. Other species grouped as feature plants towards the middle and back of the plots.

Plots M and N: Cornus, Viburnum and Mahonia in groups of 7 to the rear of the plot, with Ribes to the front.

All Plots: After planting bark mulch is to be spread across the full extent of the plot, to depth of 50mm and gently compacted by foot.

Rev.	Date.	Details.	By.	Chk.
Whittington Landscape Architecture 50 Penprysg Road Pencoed Bridgend CF35 6RH Contact: Geoff Whittington Mob: 07724 680490 Email: geoffwhittington4@gmail.com				
Client:		Manning Construction		
Project:		Glynneath Development		
Title:		Landscape Proposals AS BUILT		
Drawn:	Checked.	Scale(s).		
GW		1:400 @ A1		
Date.	Job no.	Drg. no.	Rev.	
17/07/23	291	002		