




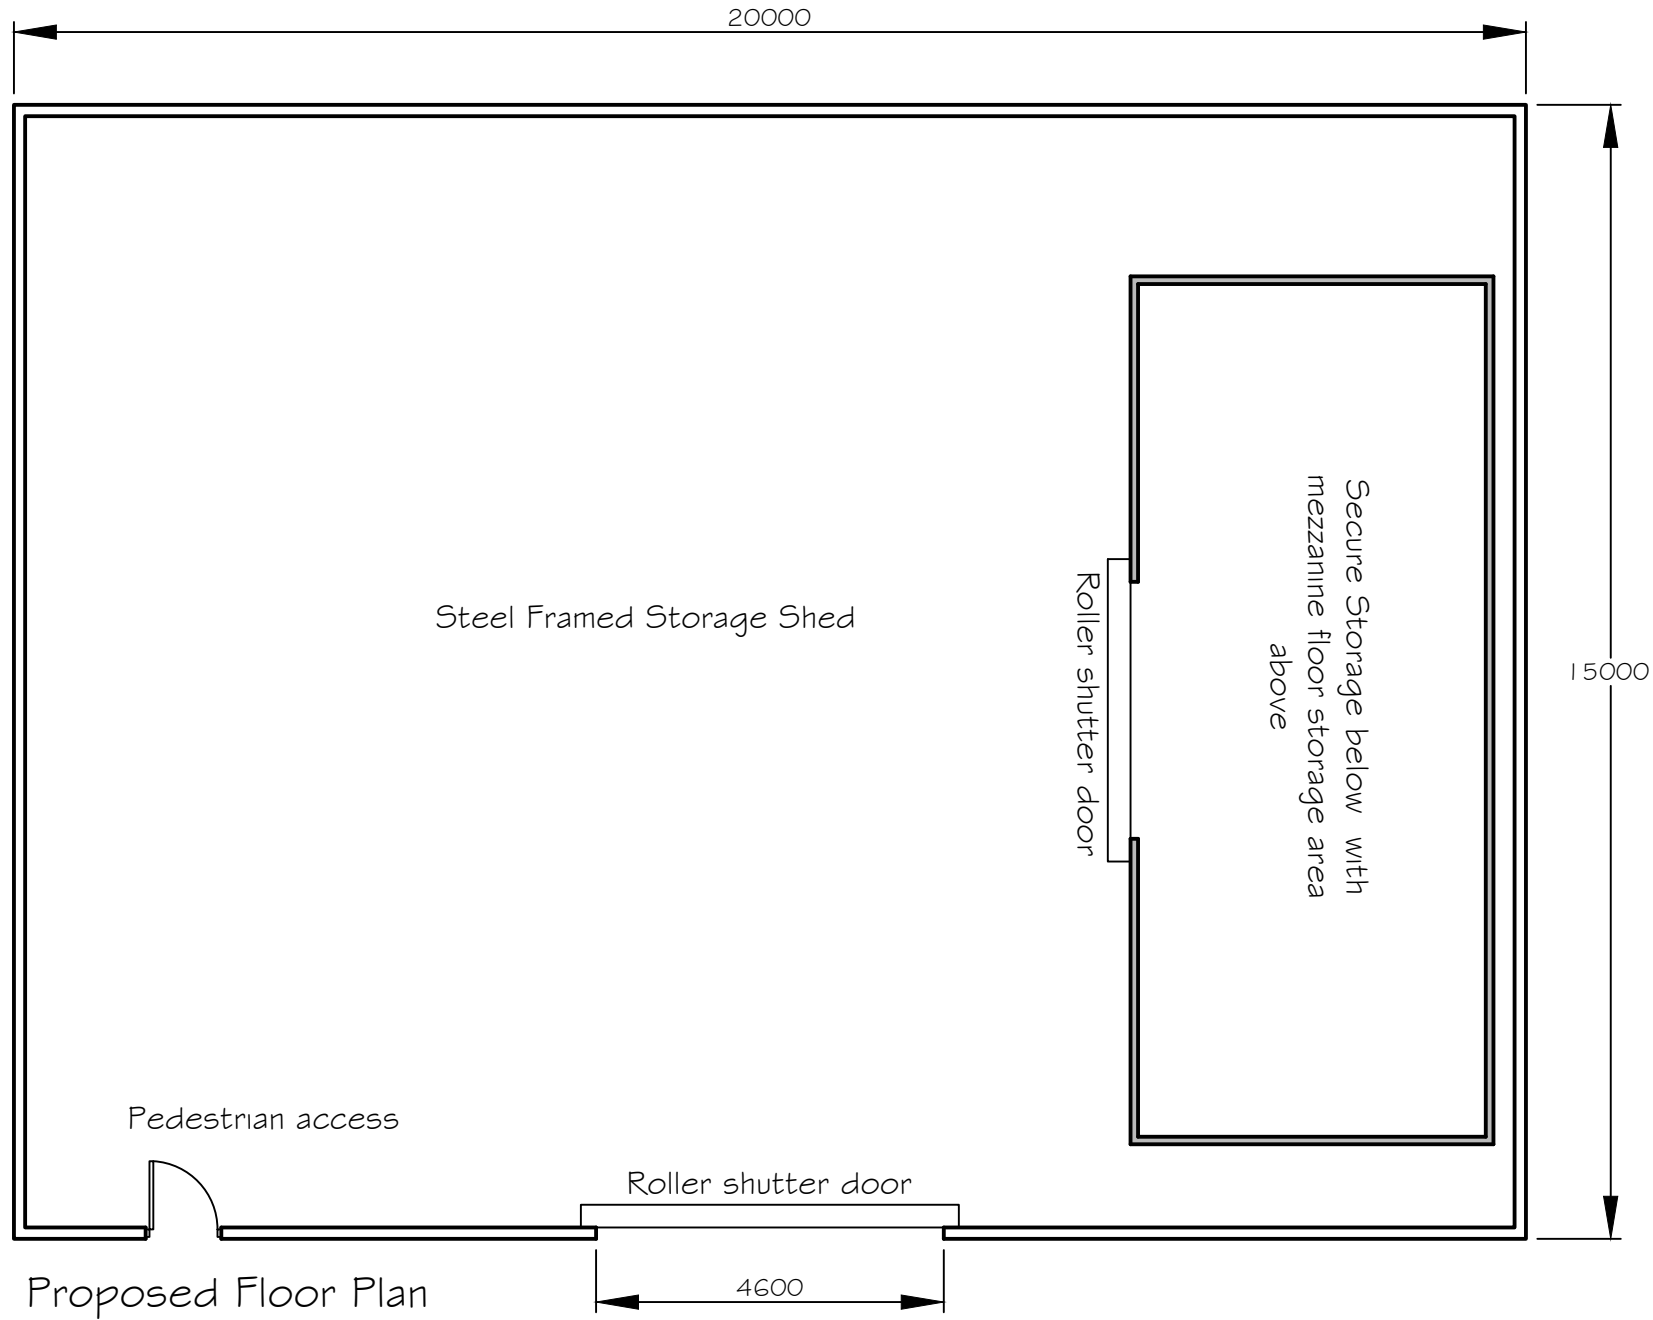


Proposed Floor Plan

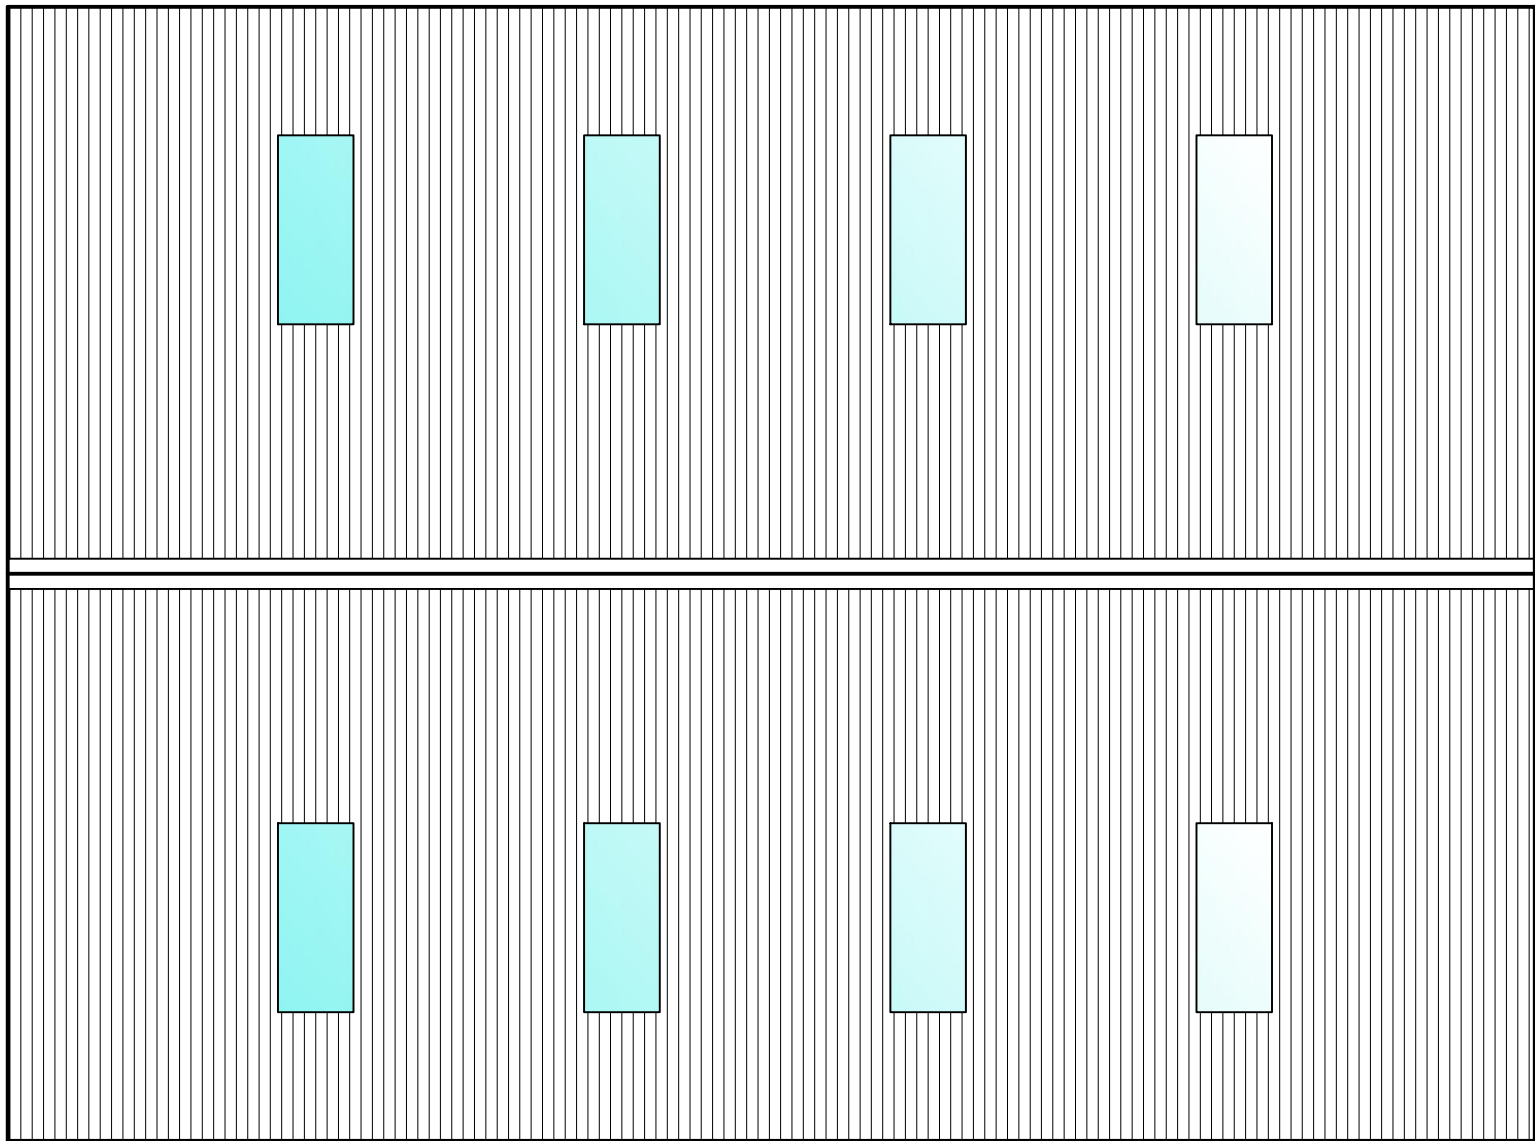

Proposed Roof Plan

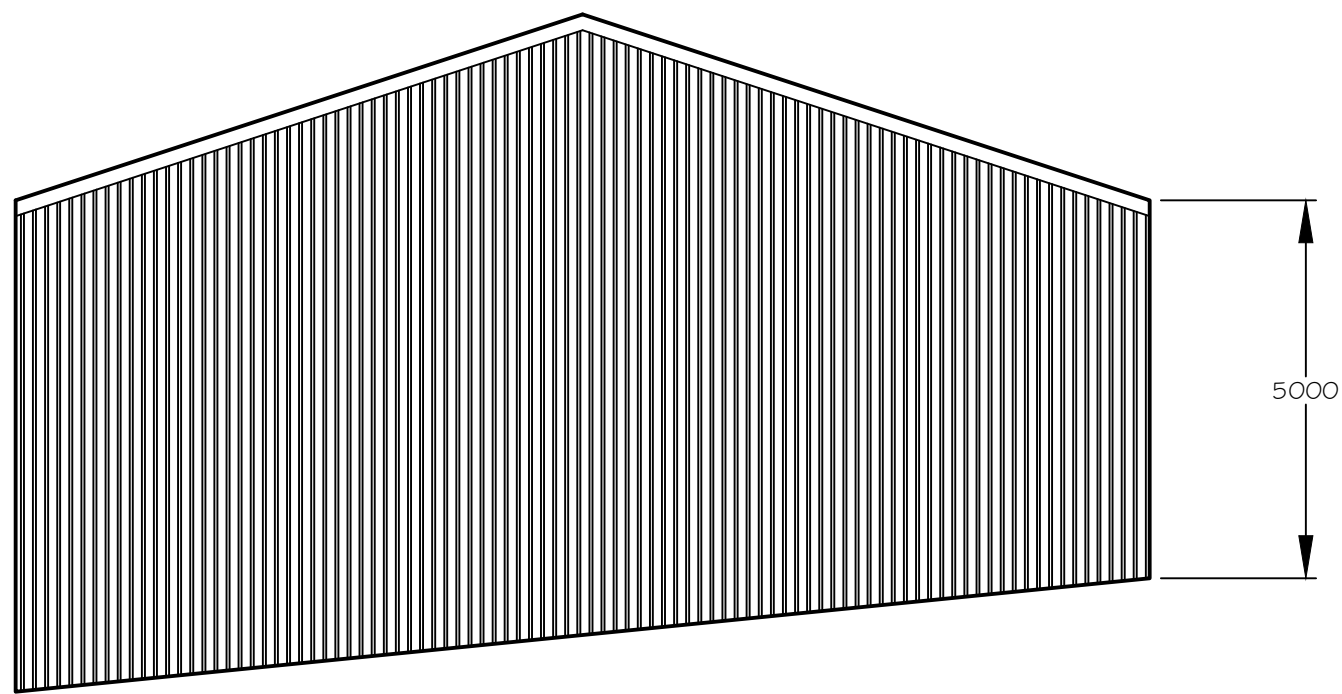


Proposed Side Elevation

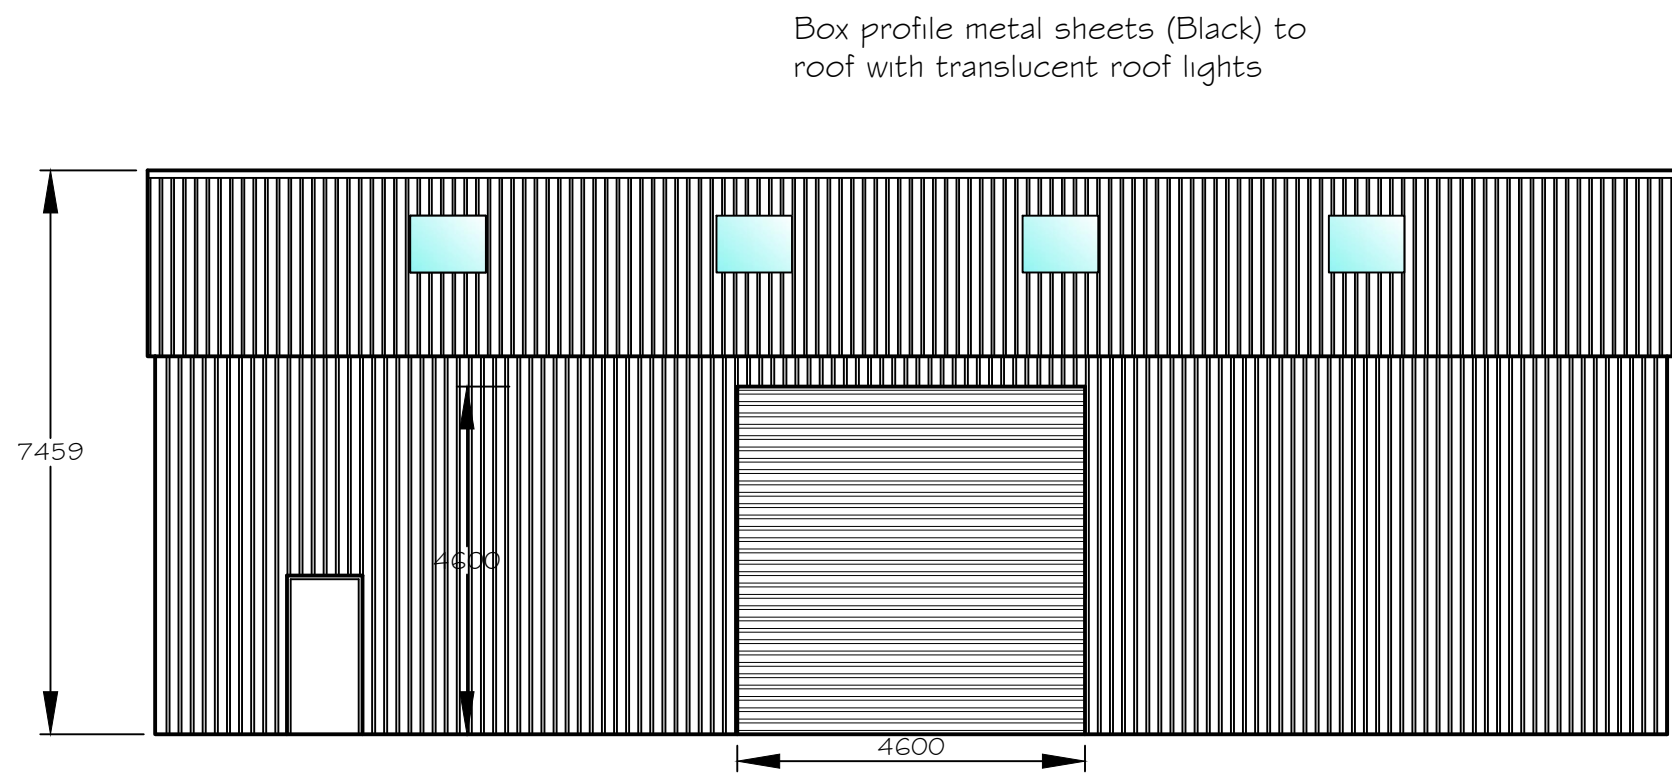


Proposed Front Elevation


Walls to be constructed of box profile metal sheets (Black)

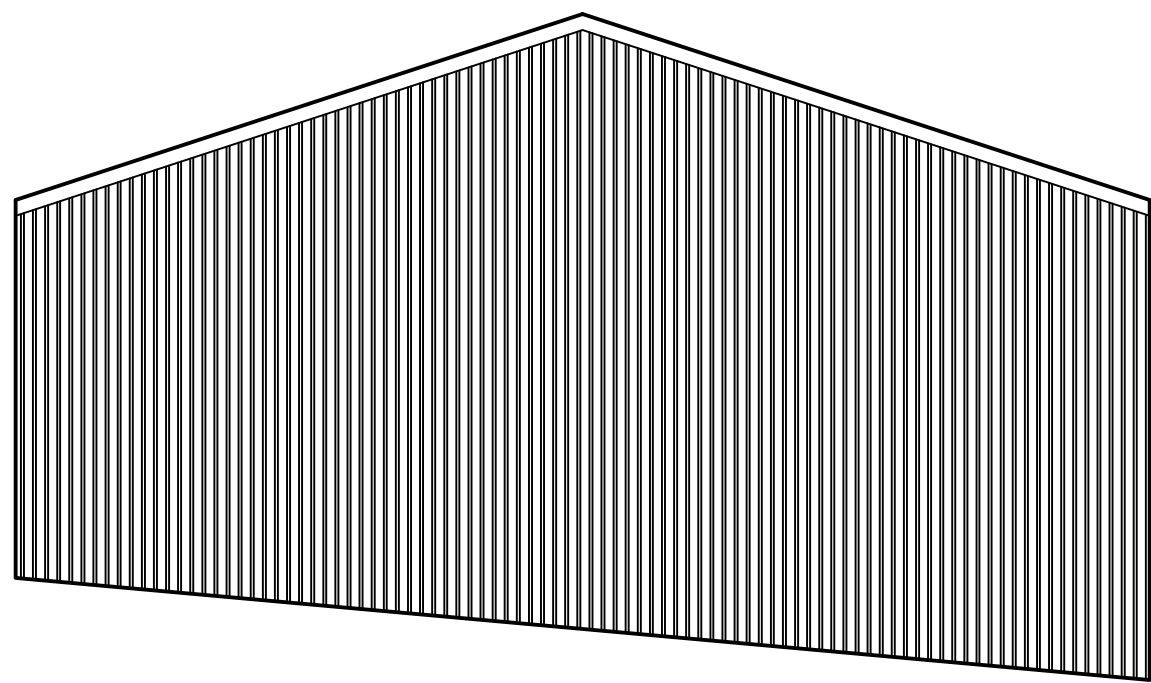


Proposed Side Elevation

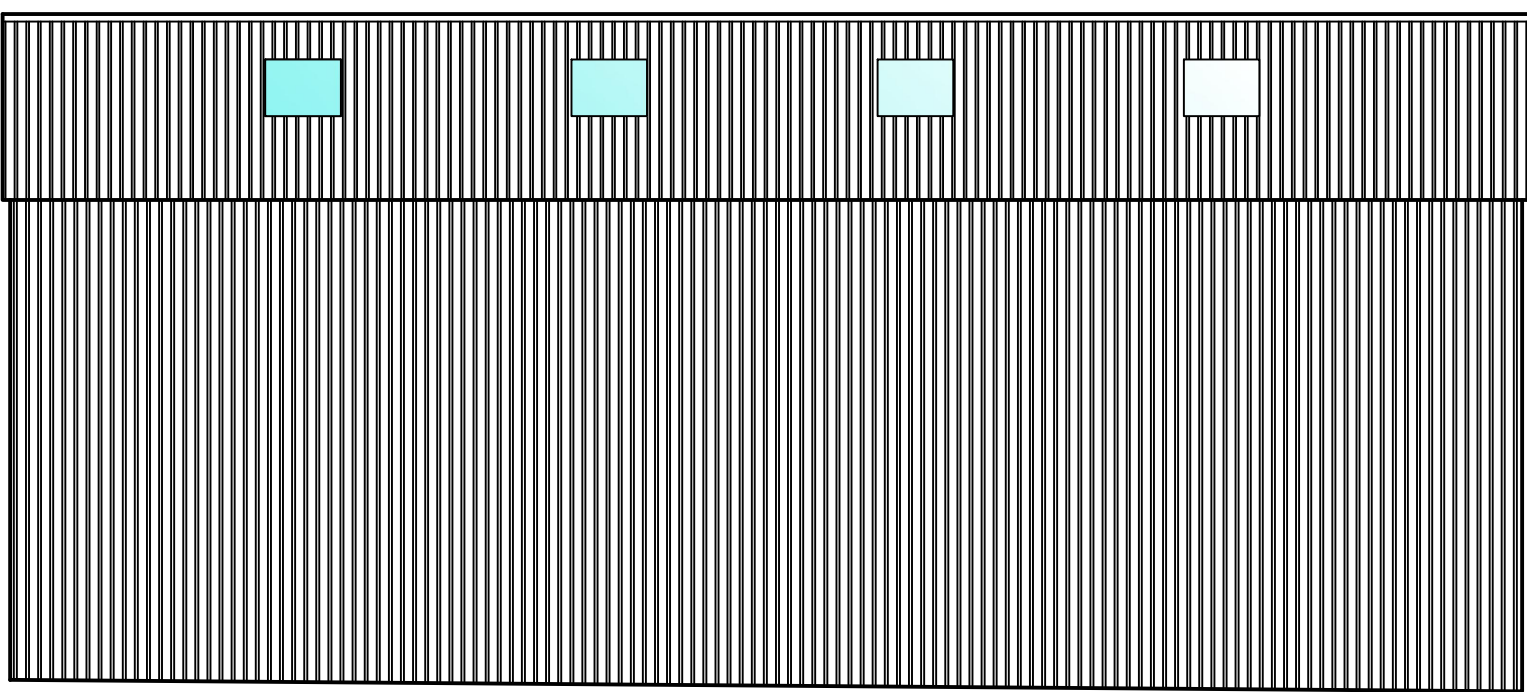


Proposed Rear Elevation

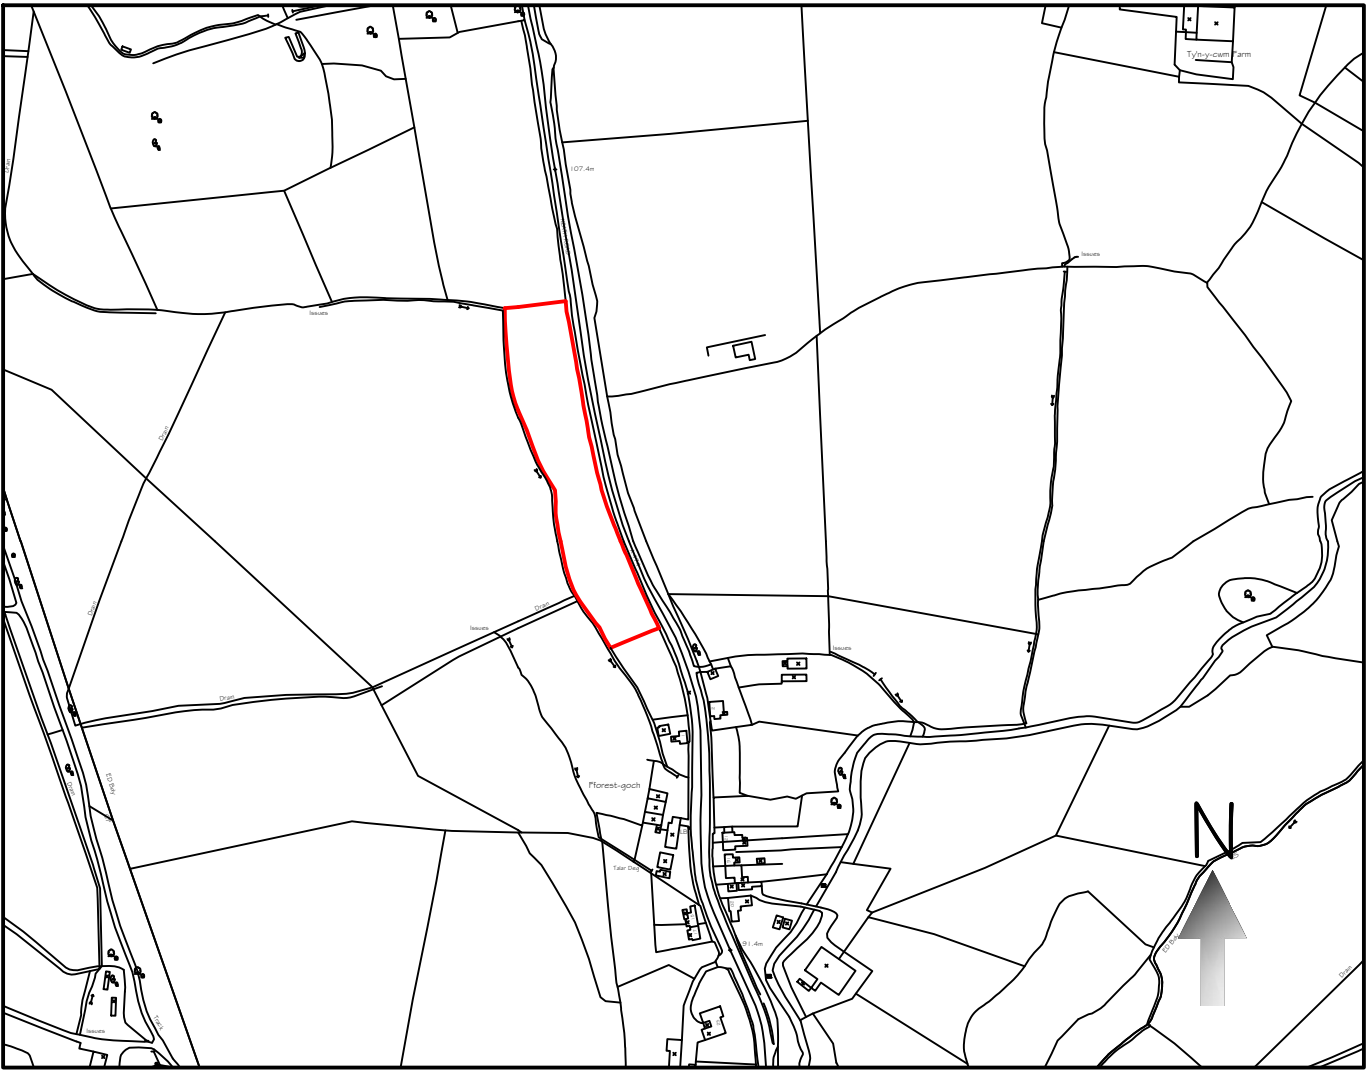

Site Location Plan at 1 : 5000 Scale

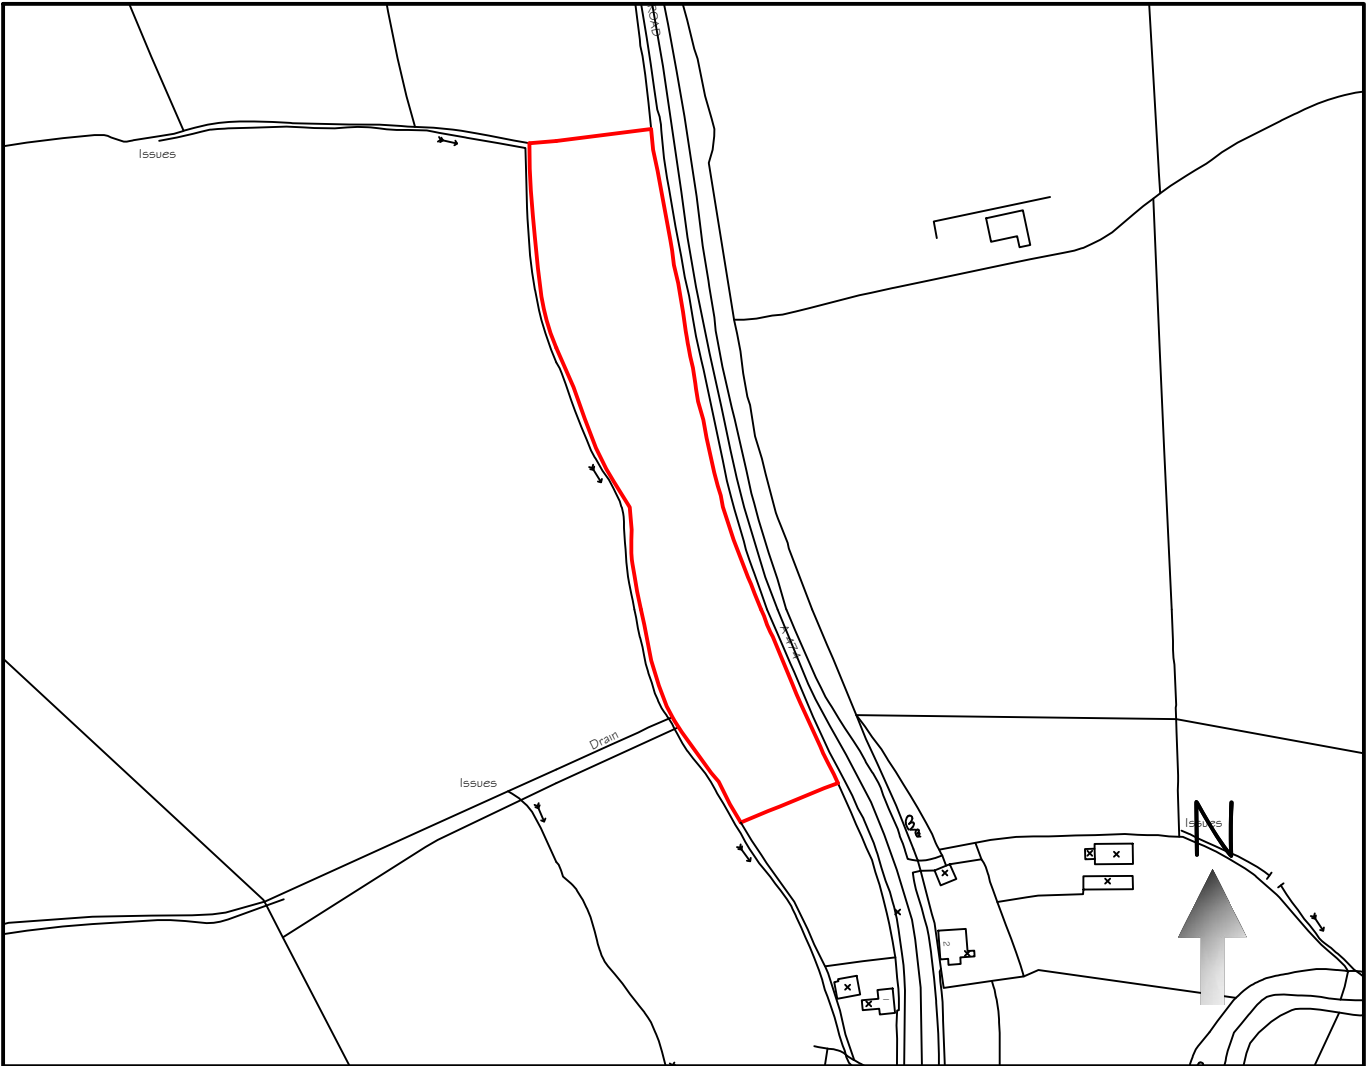

Existing Site Plan At 1 :2500 Scale

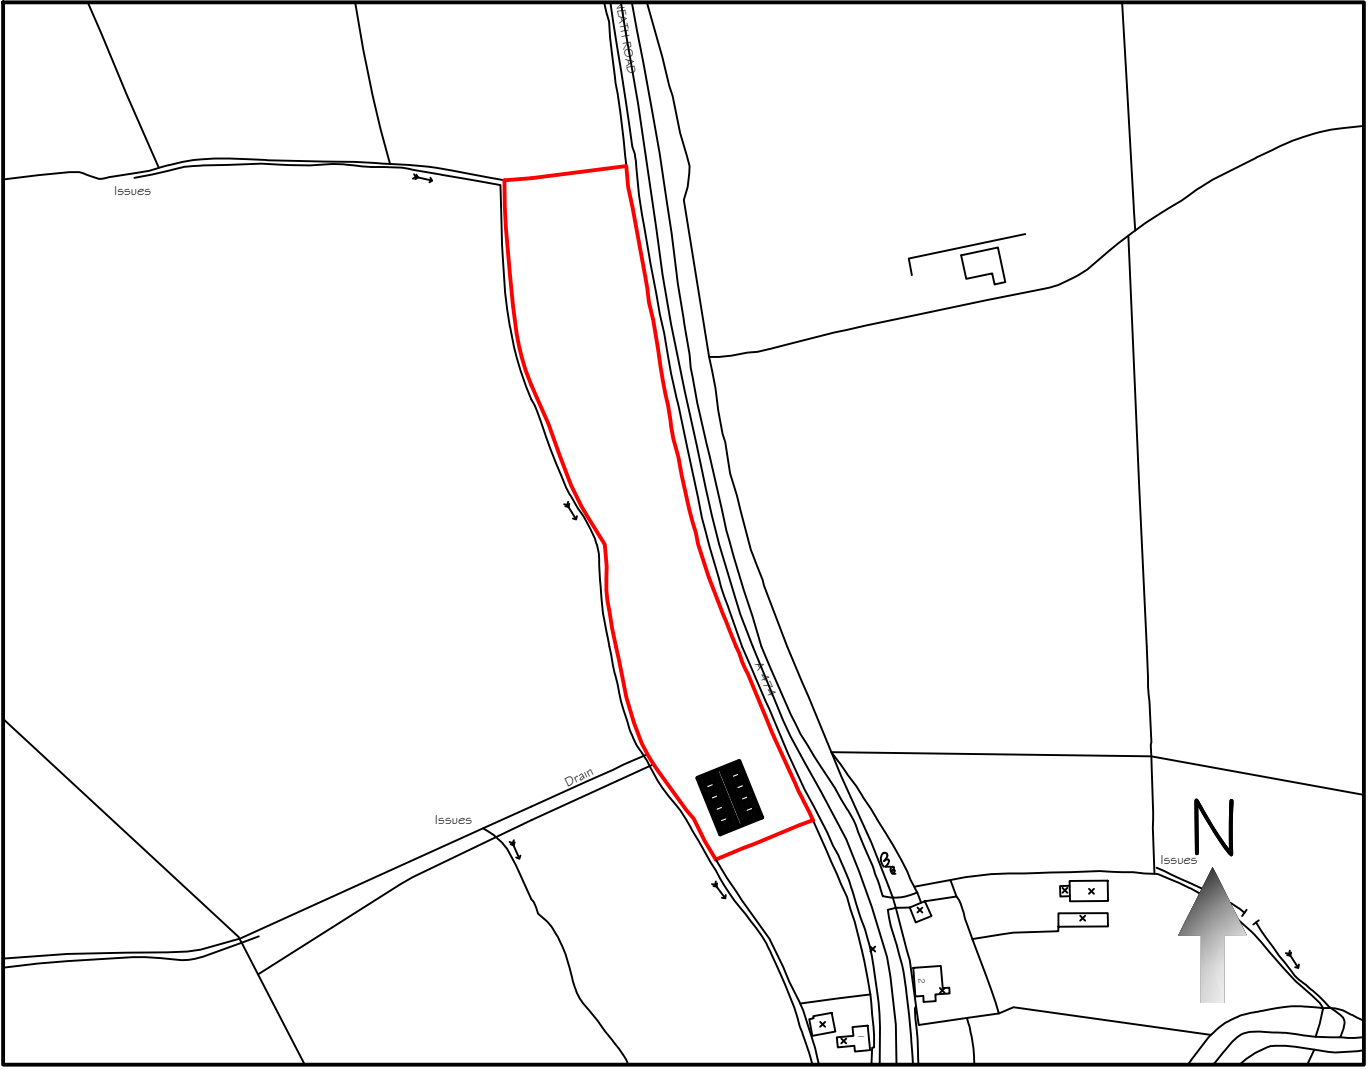

Proposed Site Plan At 1:2500 Scale

- Rev - A Shed moved to new position and height reduced by 500mm Feb 22
- Rev - B Shed (as built) position amended March 23
- Rev - C Internal storage area added Nov 23

Tecta Associates Ltd Mobile:- 07765800405 E-mail:- info@tecta-associates.co.uk			
Title: Land At Neath Road, Fforest Goch, Pontardawe Proposed Agncultural Storage		Date: June 2021	Scale: 1:100 (At A1)
Client: Mr Marc O'Mahoney 18 Maes Y Den, Cilfrew, Neath, SA10 8LT		Number: TAL21/24/01 Rev - C	