


MAINTENANCE:

WEED CONTROL:

- Maintain weed free all shrub beds - Keep clear of weeds: [By use of suitable herbicides or hand weed where necessary].
- Take care not to reduce depth or effect of mulch.
- Precautions: Ensure that trees and shrubs are not damaged by use of mowers, nylon filament rotary cutters and similar power tools.
- Firming up: Gently firm loosened soil around trees/ shrubs.
- Straighten leaning trees/ shrubs.
- Tree accessories: Check condition of stakes, ties, guys, guards and irrigation.
- Frequency: 6 visits per year during growing season.

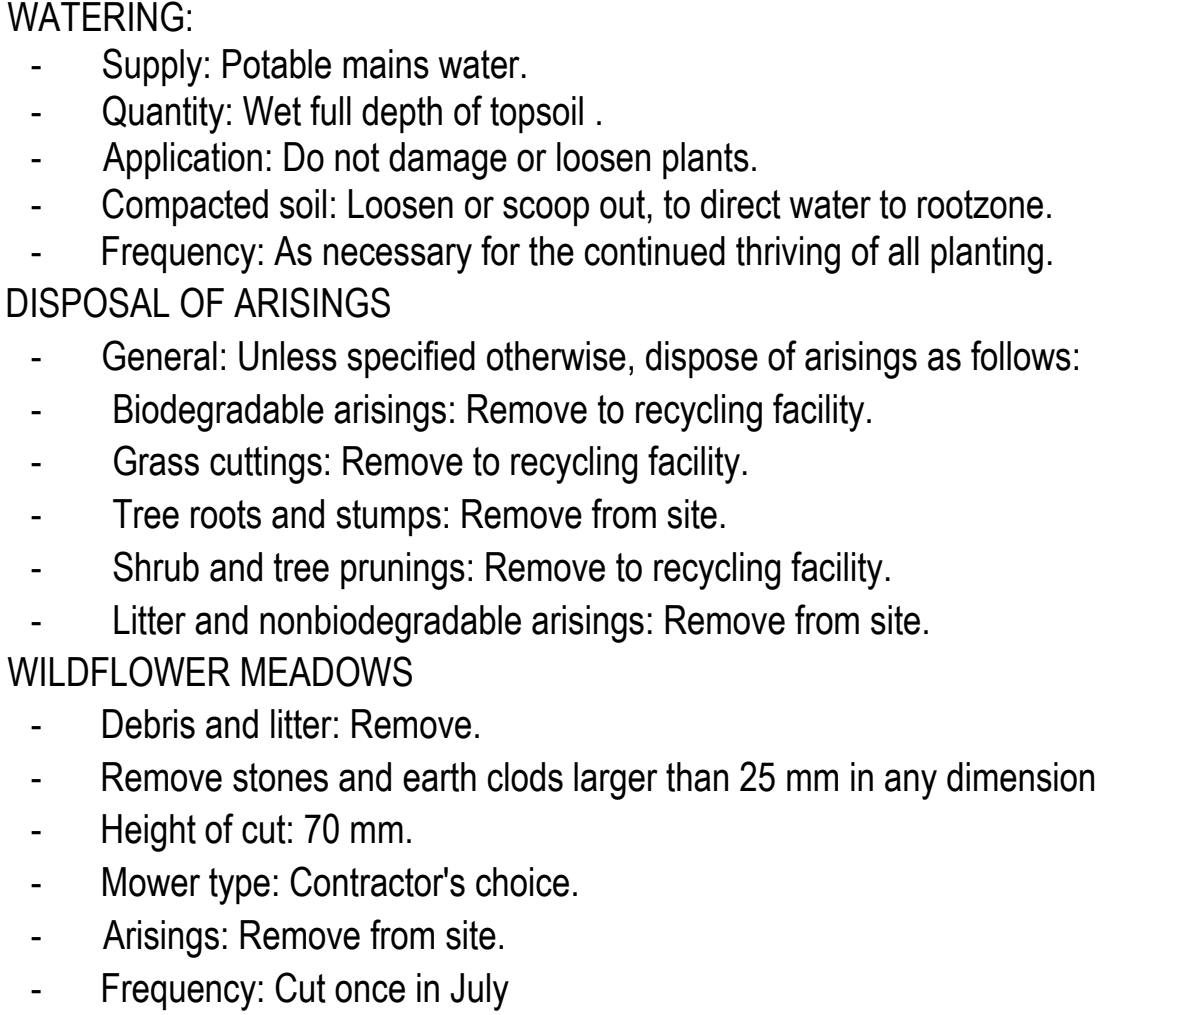

FINAL MULCHING

- Timing: At end of the maintenance period.
- Watering: Ensure that soil is thoroughly moistened prior to remulching, applying water where necessary.
- Planting beds: Remulch.
- Depth (minimum): 75 mm.
- Trees: Remulch.
- Depth (minimum): 75 mm.

REINSTATEMENT OF SHRUB/ HERBACEOUS AREAS

- Dead and damaged plants: Remove.
- Mulch/ matting materials:
Carefully move mulch to one side and dig over the soil, leaving it fit for replanting.
- Do not disturb roots of adjacent plants.
- Replacement plants to original specification or to match the size of adjacent or nearby plants of the same species in original pits.
- Dressing: Slow release organic fertilizers as per manufacturers recommendations:

Rev.	Date.	Details.	By.	Chk.

Whittington Landscape Architecture

50 Penprysg Road
Pencoed
Bridgend
CF35 6RH

Contact: Geoff Whittington
Mob: 07724 680490
Email: geoffwhittington4@gmail.com

Client: Manning Construction

Project:

Glynneath
Development

Title:

Landscape Proposals
AS BUILT

Drawn: GW	Checked.	Scale(s). 1:400 @ A1	
Date. 25/01/24	Job no. 291	Drg. no. 002	Rev. D
