



**Location Plan 1:1250**

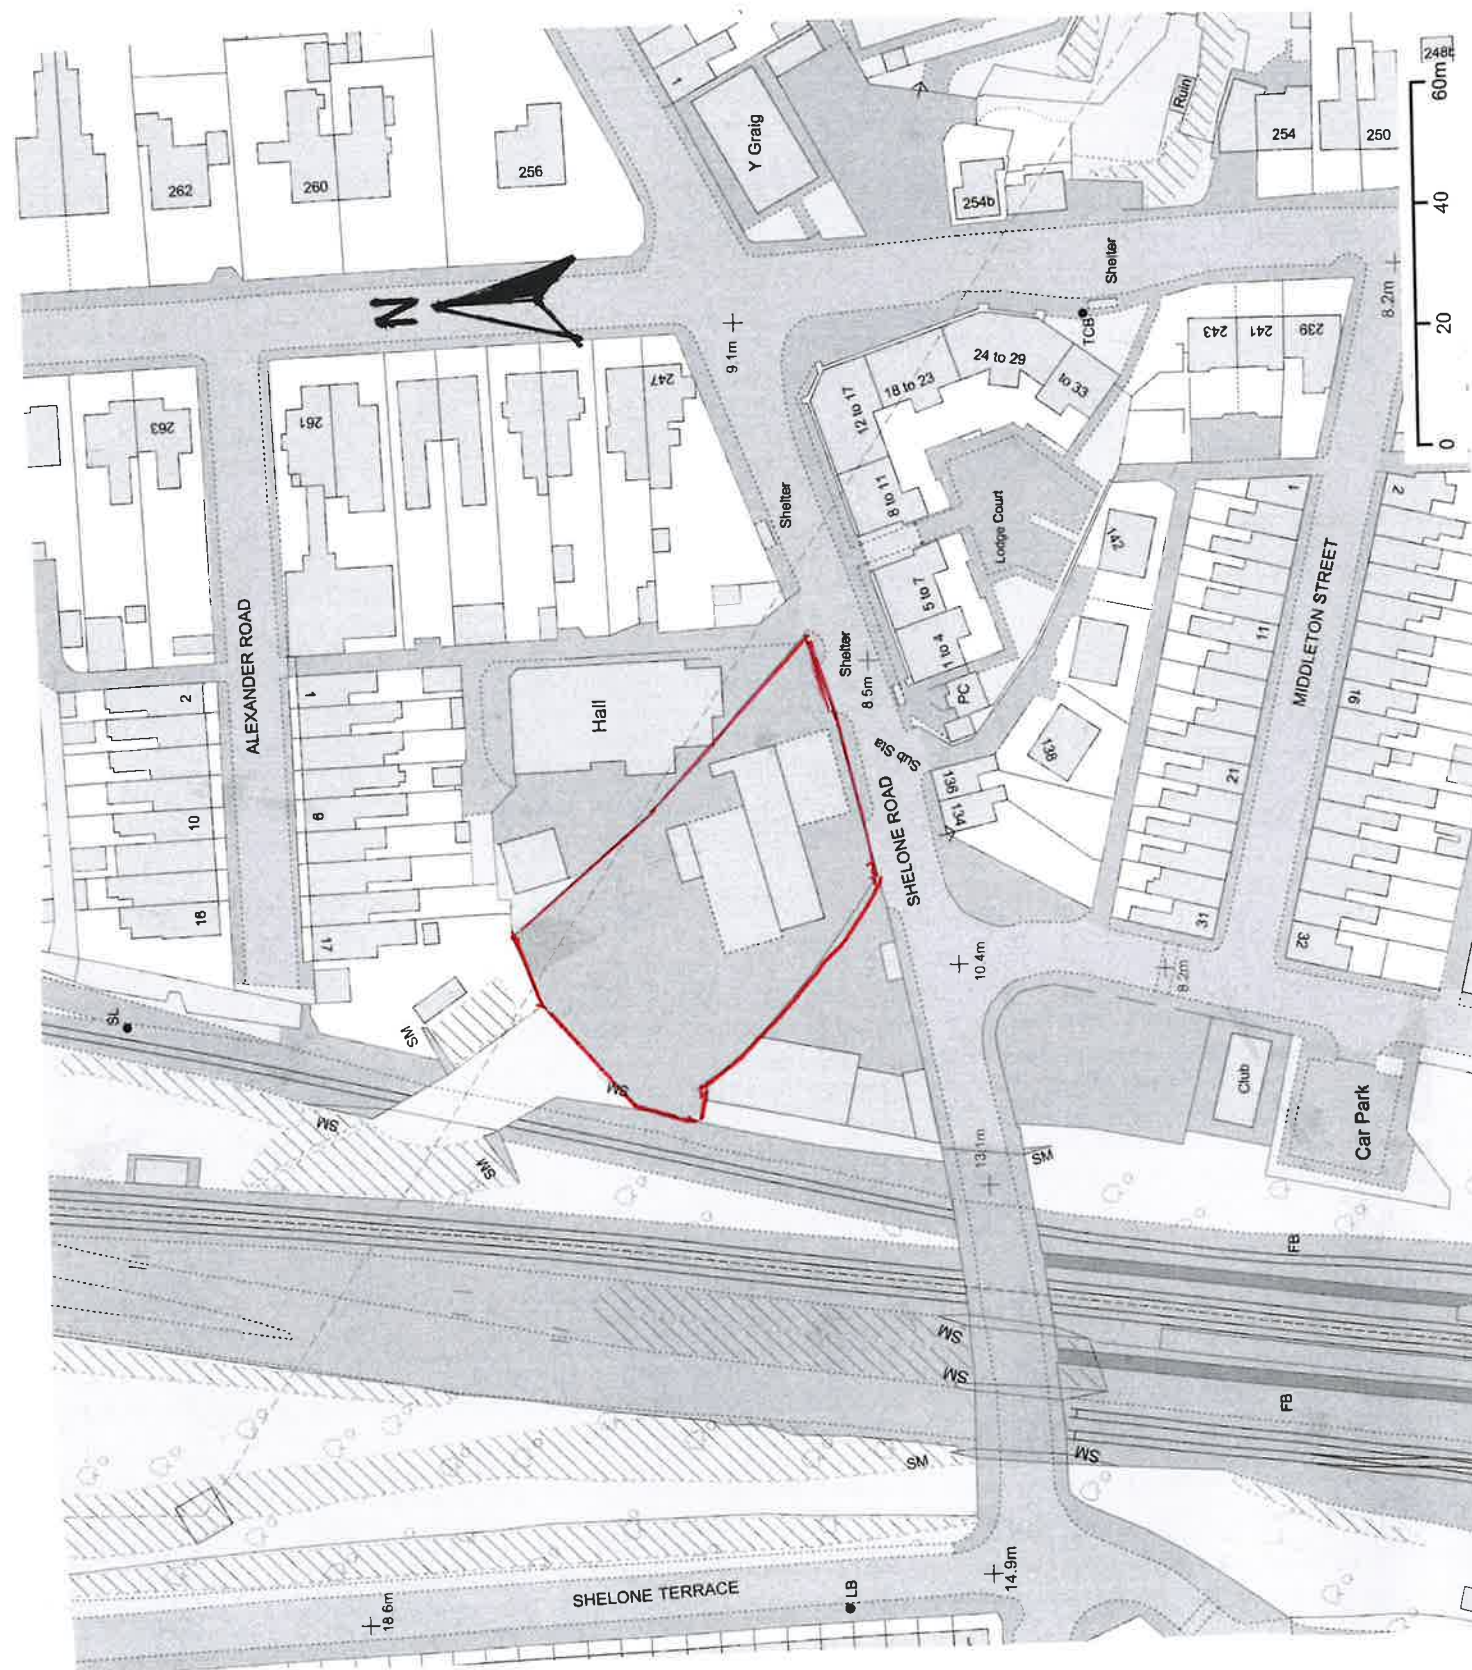

**Block Plan 1:500**

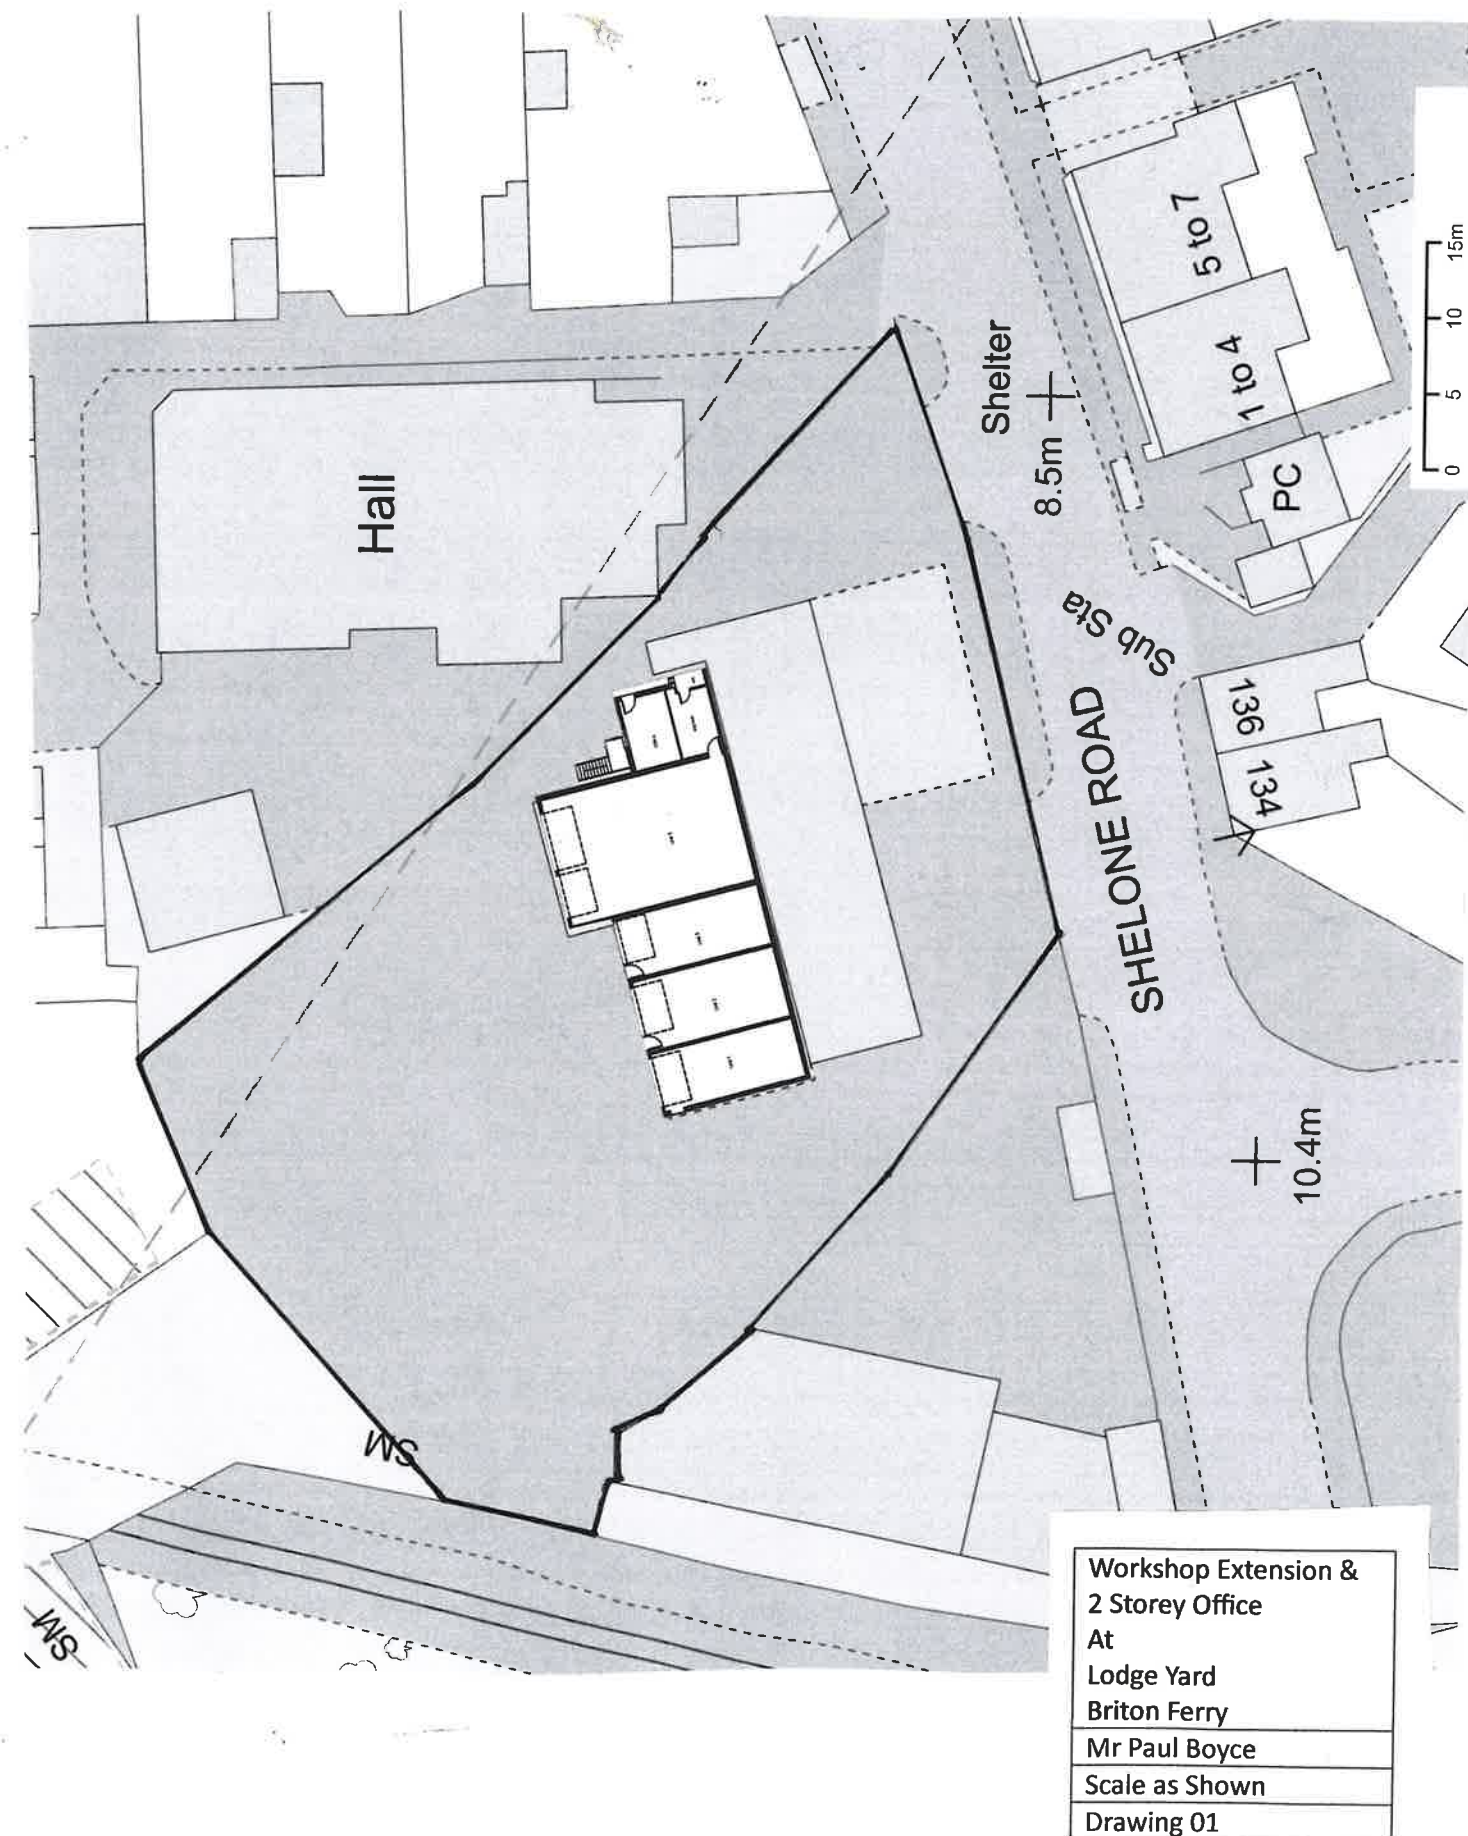


|                                                                                                                              |
|------------------------------------------------------------------------------------------------------------------------------|
| Workshop Extension &<br>2 Storey Office<br>At<br>Lodge Yard<br>Briton Ferry<br>Mr Paul Boyce<br>Scale as Shown<br>Drawing 01 |
|------------------------------------------------------------------------------------------------------------------------------|




**GF (As Built 2023) 1:100**

|                                                                                                                              |
|------------------------------------------------------------------------------------------------------------------------------|
| Workshop Extension &<br>2 Storey Office<br>At<br>Lodge Yard<br>Briton Ferry<br>Mr Paul Boyce<br>Scale as Shown<br>Drawing 02 |
|------------------------------------------------------------------------------------------------------------------------------|

**Front**

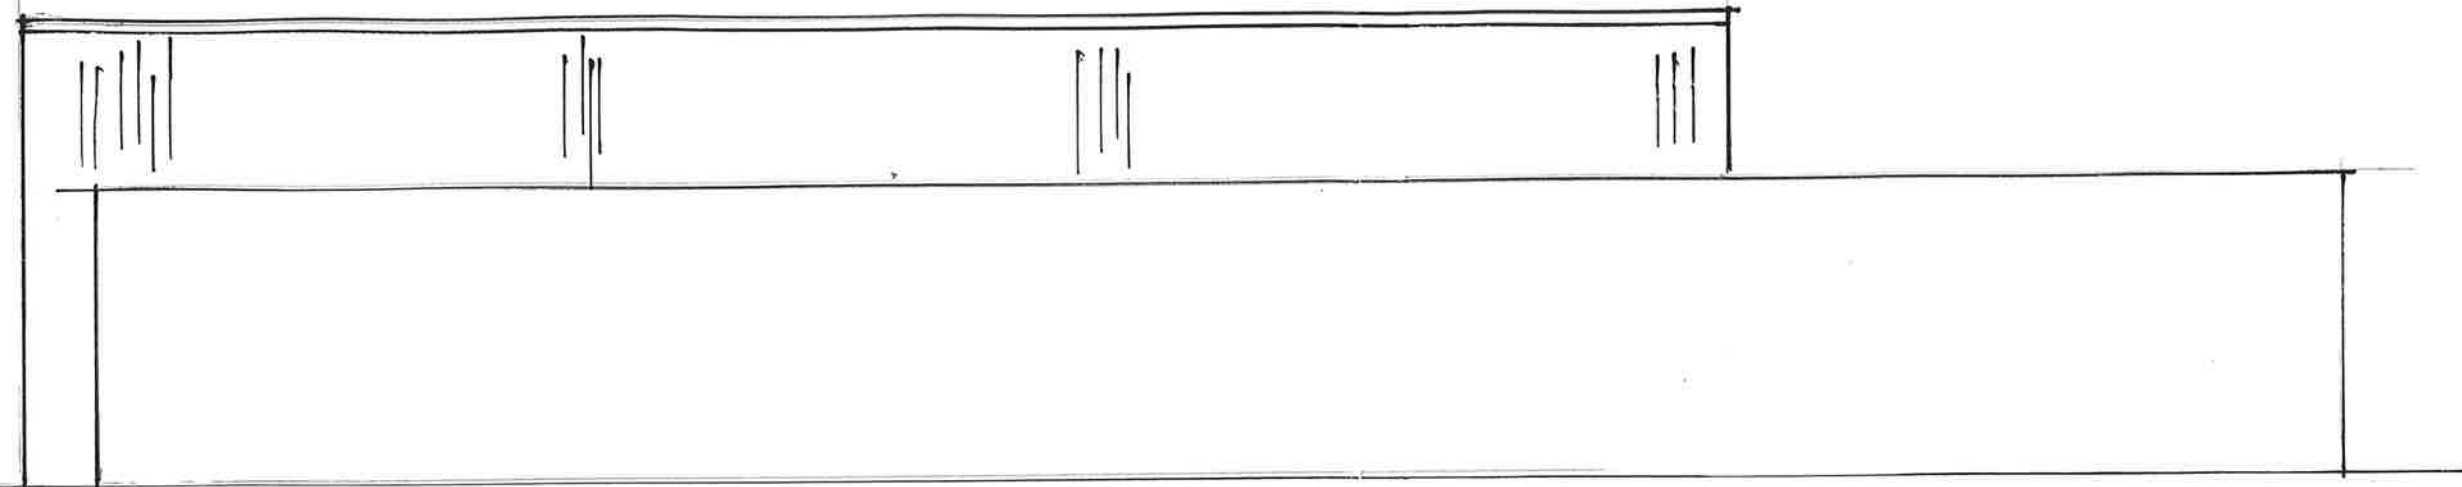

**Side**

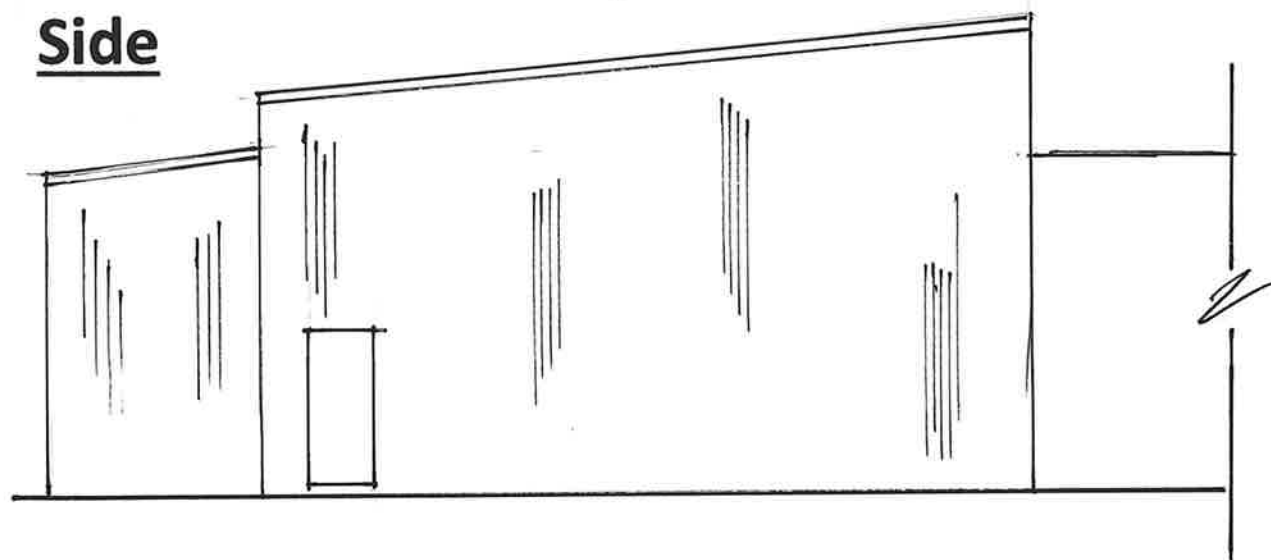

**Side**



**PROFILED GREY STEEL SHEET CLADDING**

**FIBREGLOSS FLAT ROOF**

**SMOOTH RENDER**

**BROWN UPVC WINDOWS**

**BLACK RWG**

**Rear**




**Elevations (As Built) 2023**

**1:100**

|                                                                                                                              |
|------------------------------------------------------------------------------------------------------------------------------|
| Workshop Extension &<br>2 Storey Office<br>At<br>Lodge Yard<br>Briton Ferry<br>Mr Paul Boyce<br>Scale as Shown<br>Drawing 03 |
|------------------------------------------------------------------------------------------------------------------------------|

GF (As Existing 2008) 1:100

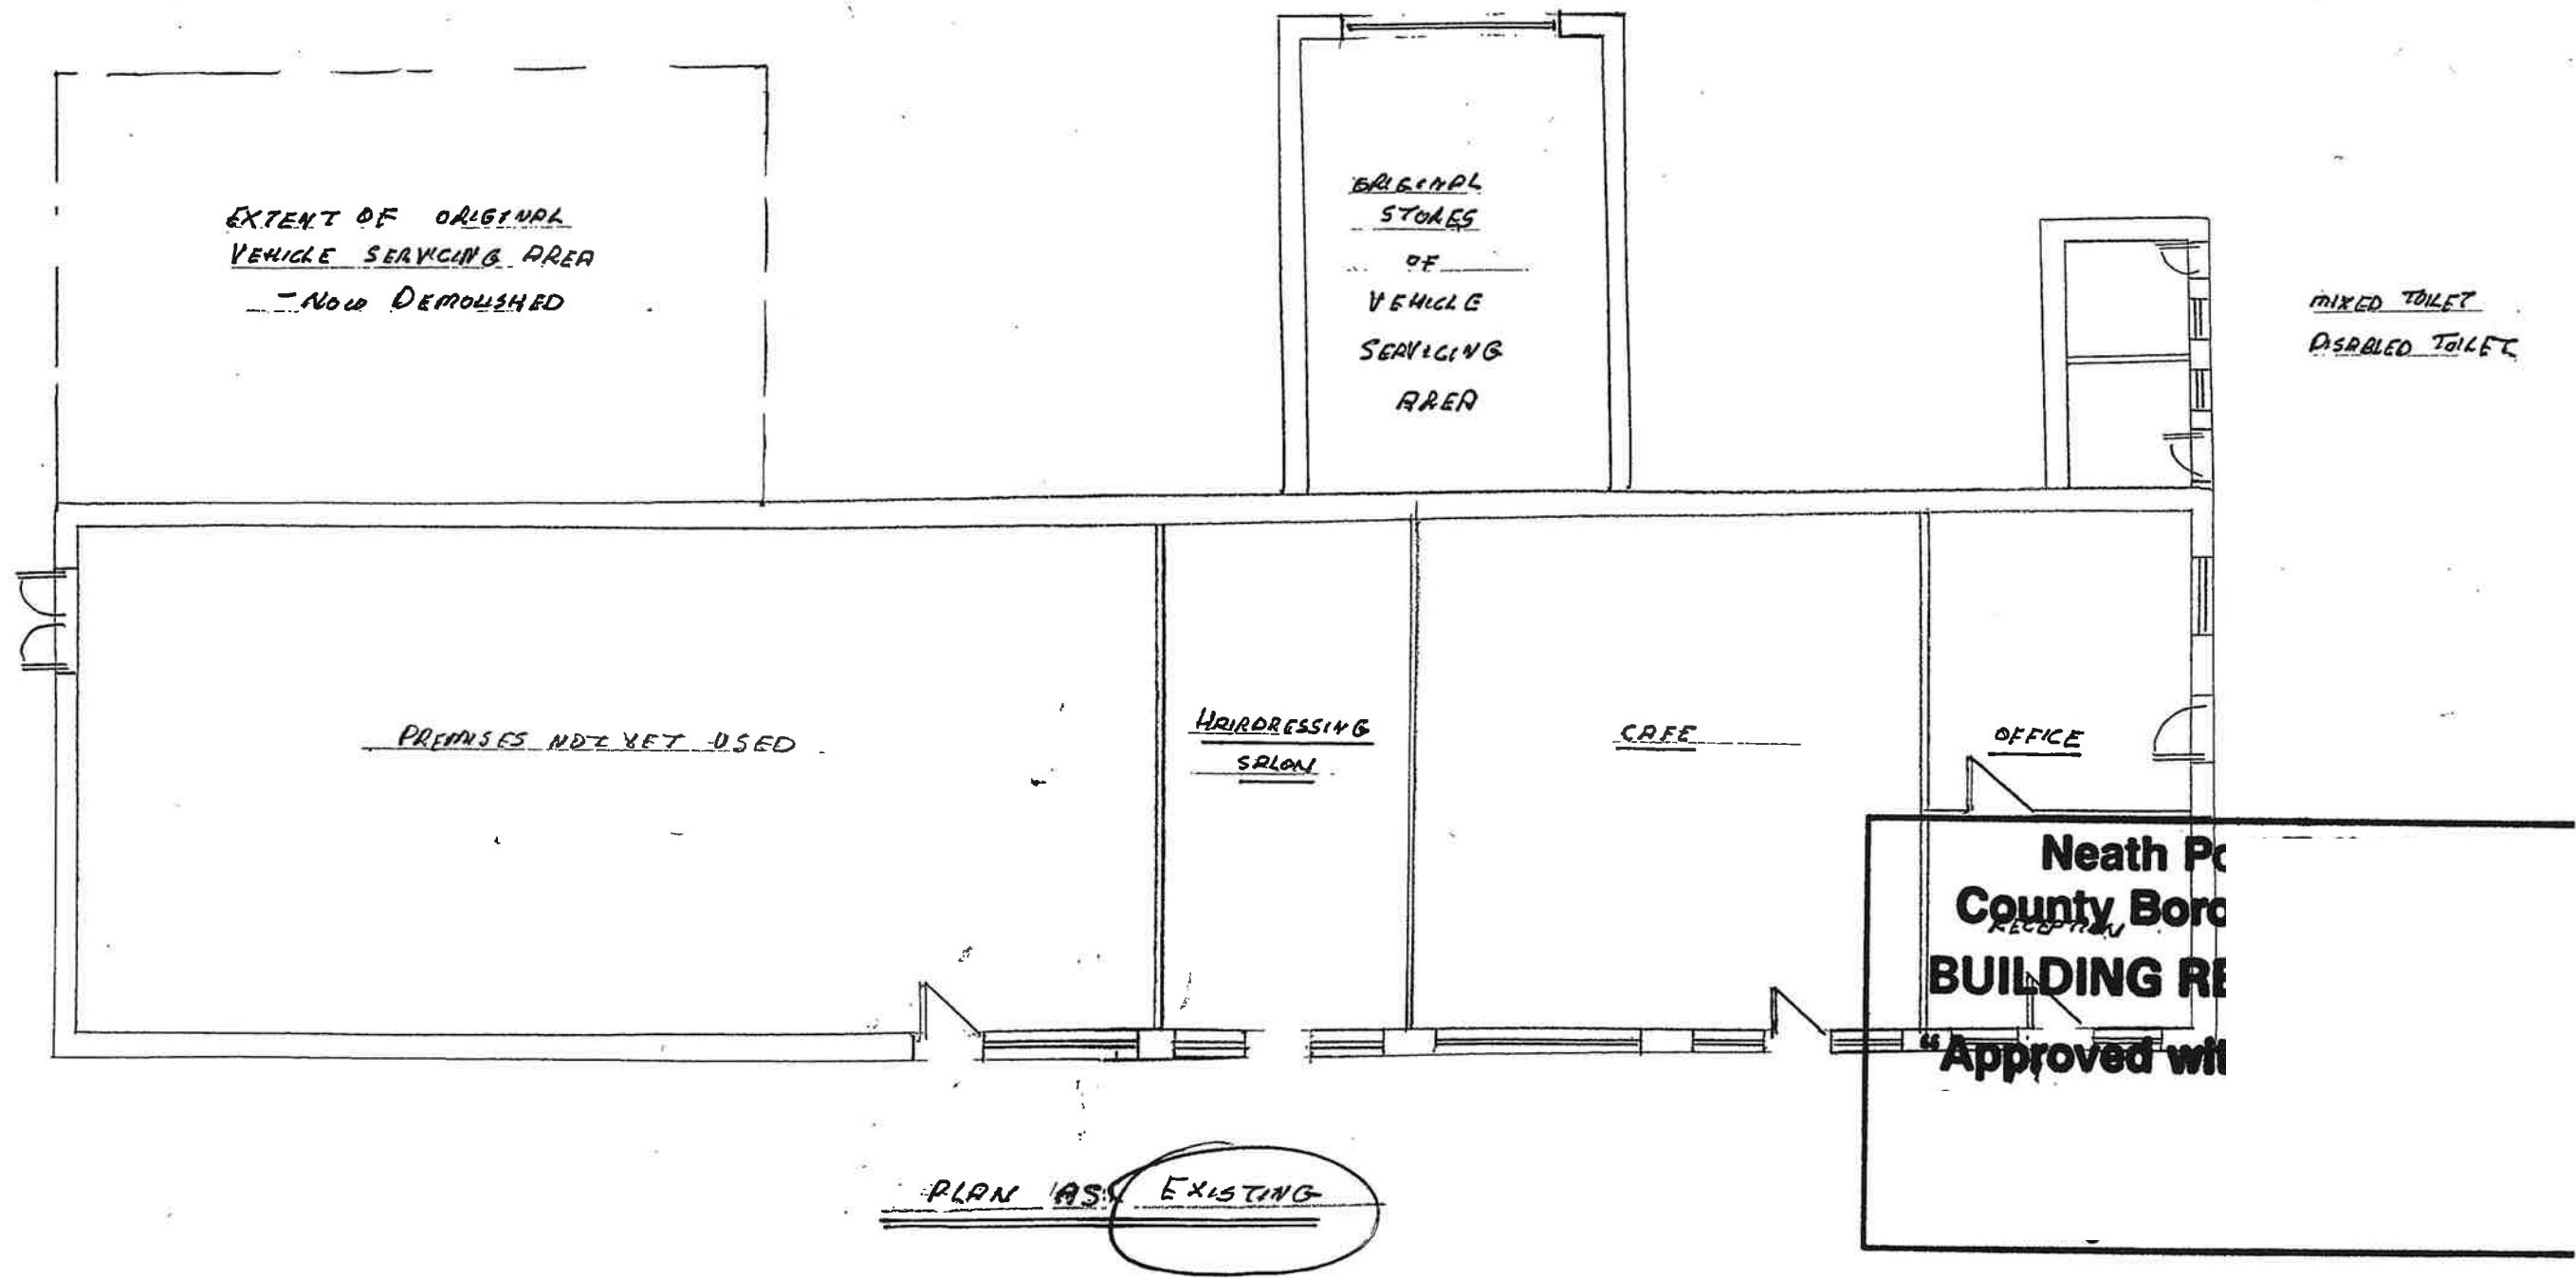

PROPOSED NEW SINGLE STOREY VEHICLE SERVICING / TESTING UNIT.

at

LODGE YARD, LODGE CROSS, BRITON FERRY

for


MR PAUL BOYCE

MAY 2001


|                                                                                                                              |
|------------------------------------------------------------------------------------------------------------------------------|
| Workshop Extension &<br>2 Storey Office<br>At<br>Lodge Yard<br>Briton Ferry<br>Mr Paul Boyce<br>Scale as Shown<br>Drawing 04 |
|------------------------------------------------------------------------------------------------------------------------------|

# Elevations (As Existing 2008)


1:100

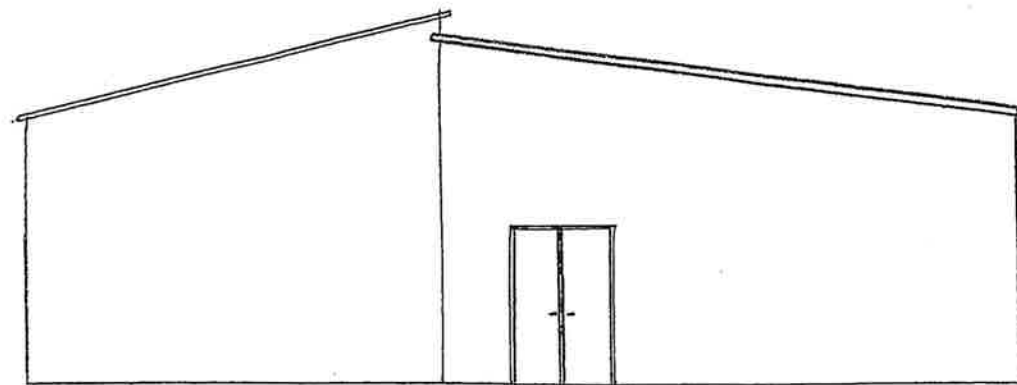

SIDE ELEVATION EXISTING

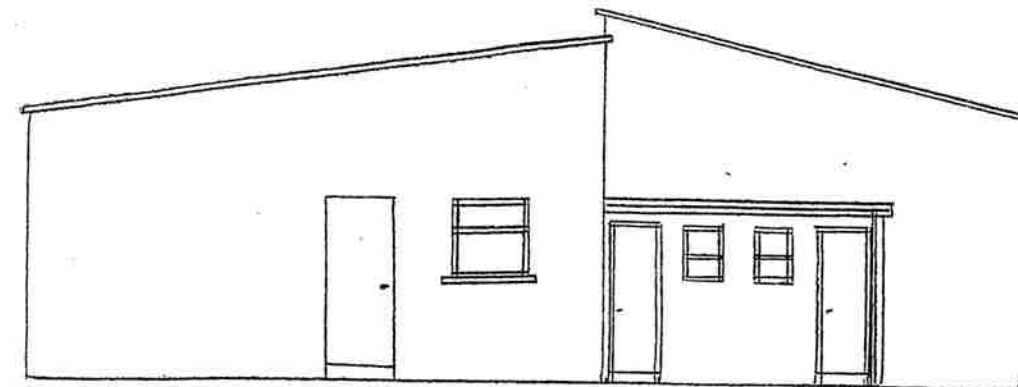


SIDE ELEVATION EXISTING

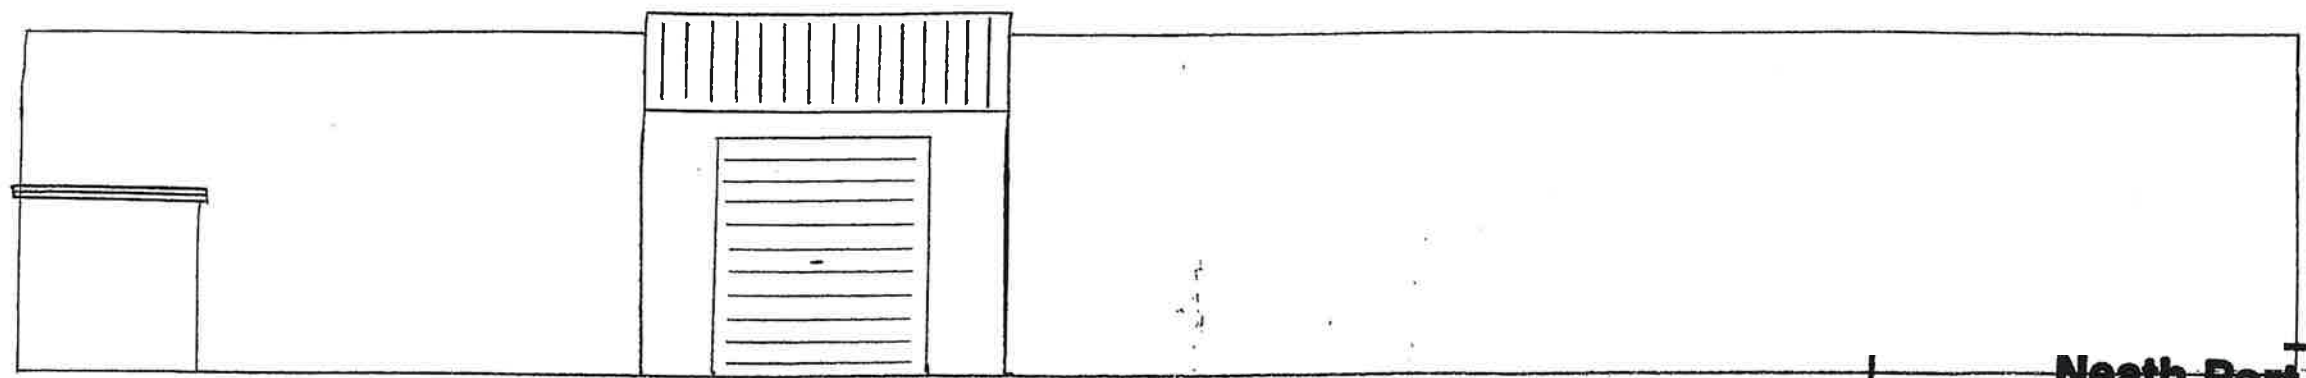

REAR ELEVATION EXISTING

**North Arrow**

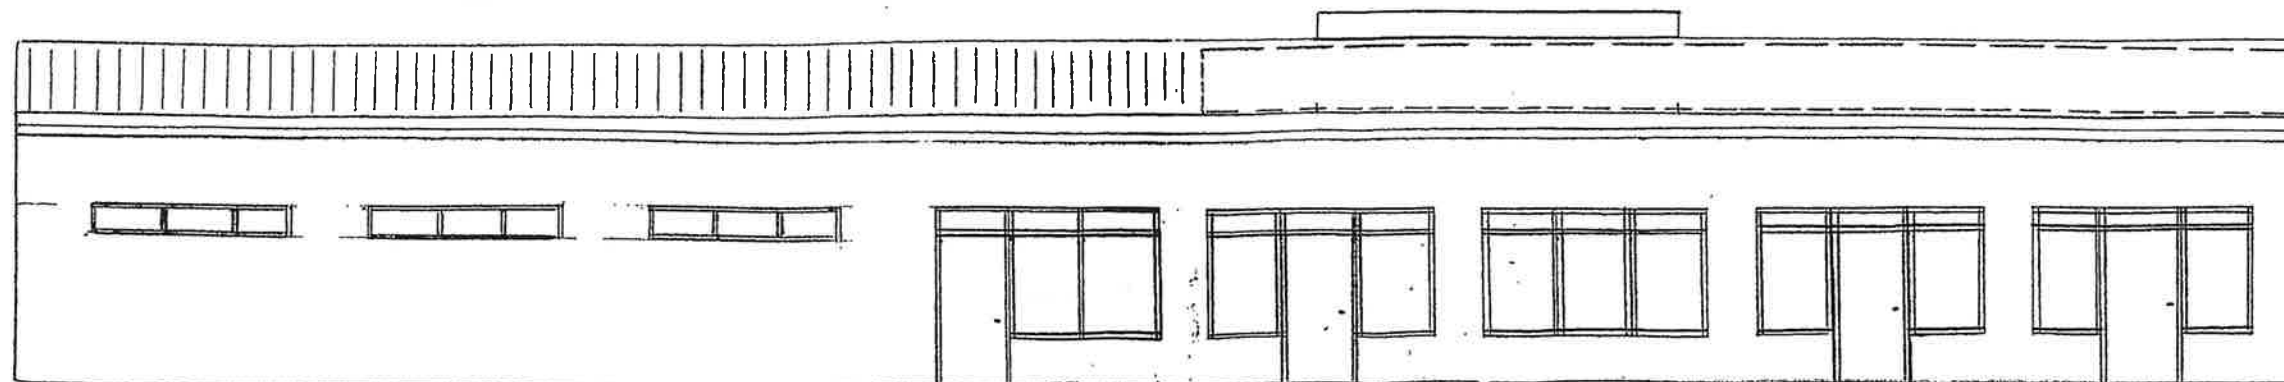

FRONT ELEVATION EXISTING

|                                                                                                                              |
|------------------------------------------------------------------------------------------------------------------------------|
| Workshop Extension &<br>2 Storey Office<br>At<br>Lodge Yard<br>Briton Ferry<br>Mr Paul Boyce<br>Scale as Shown<br>Drawing 05 |
|------------------------------------------------------------------------------------------------------------------------------|