



Date	Drawn	Check	Description
19.08.24			Proposed farmac to remain the same as existing
28.08.24			Vision splays noted
28.08.24			Plan amended
29.08.24			Plan amended

Rev.
A
B
C
D

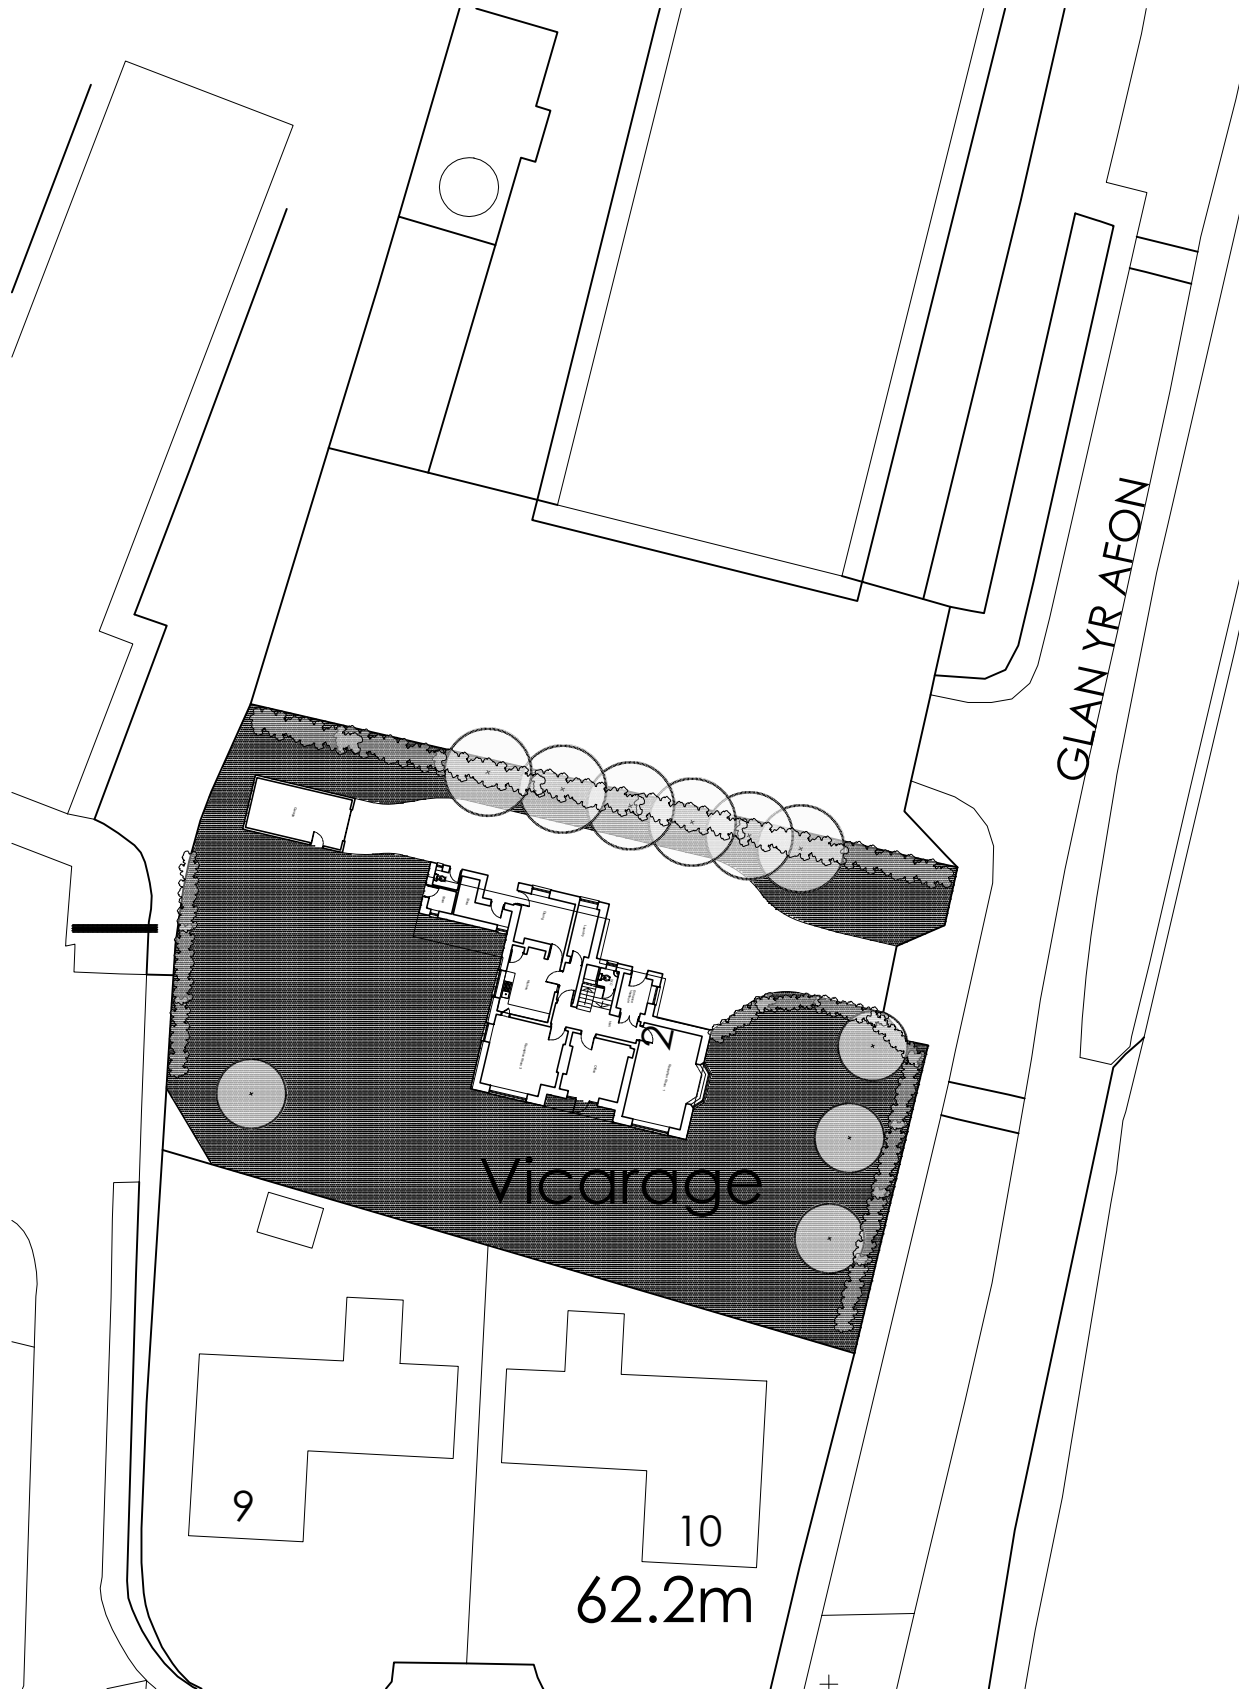

Existing block plan
1:500

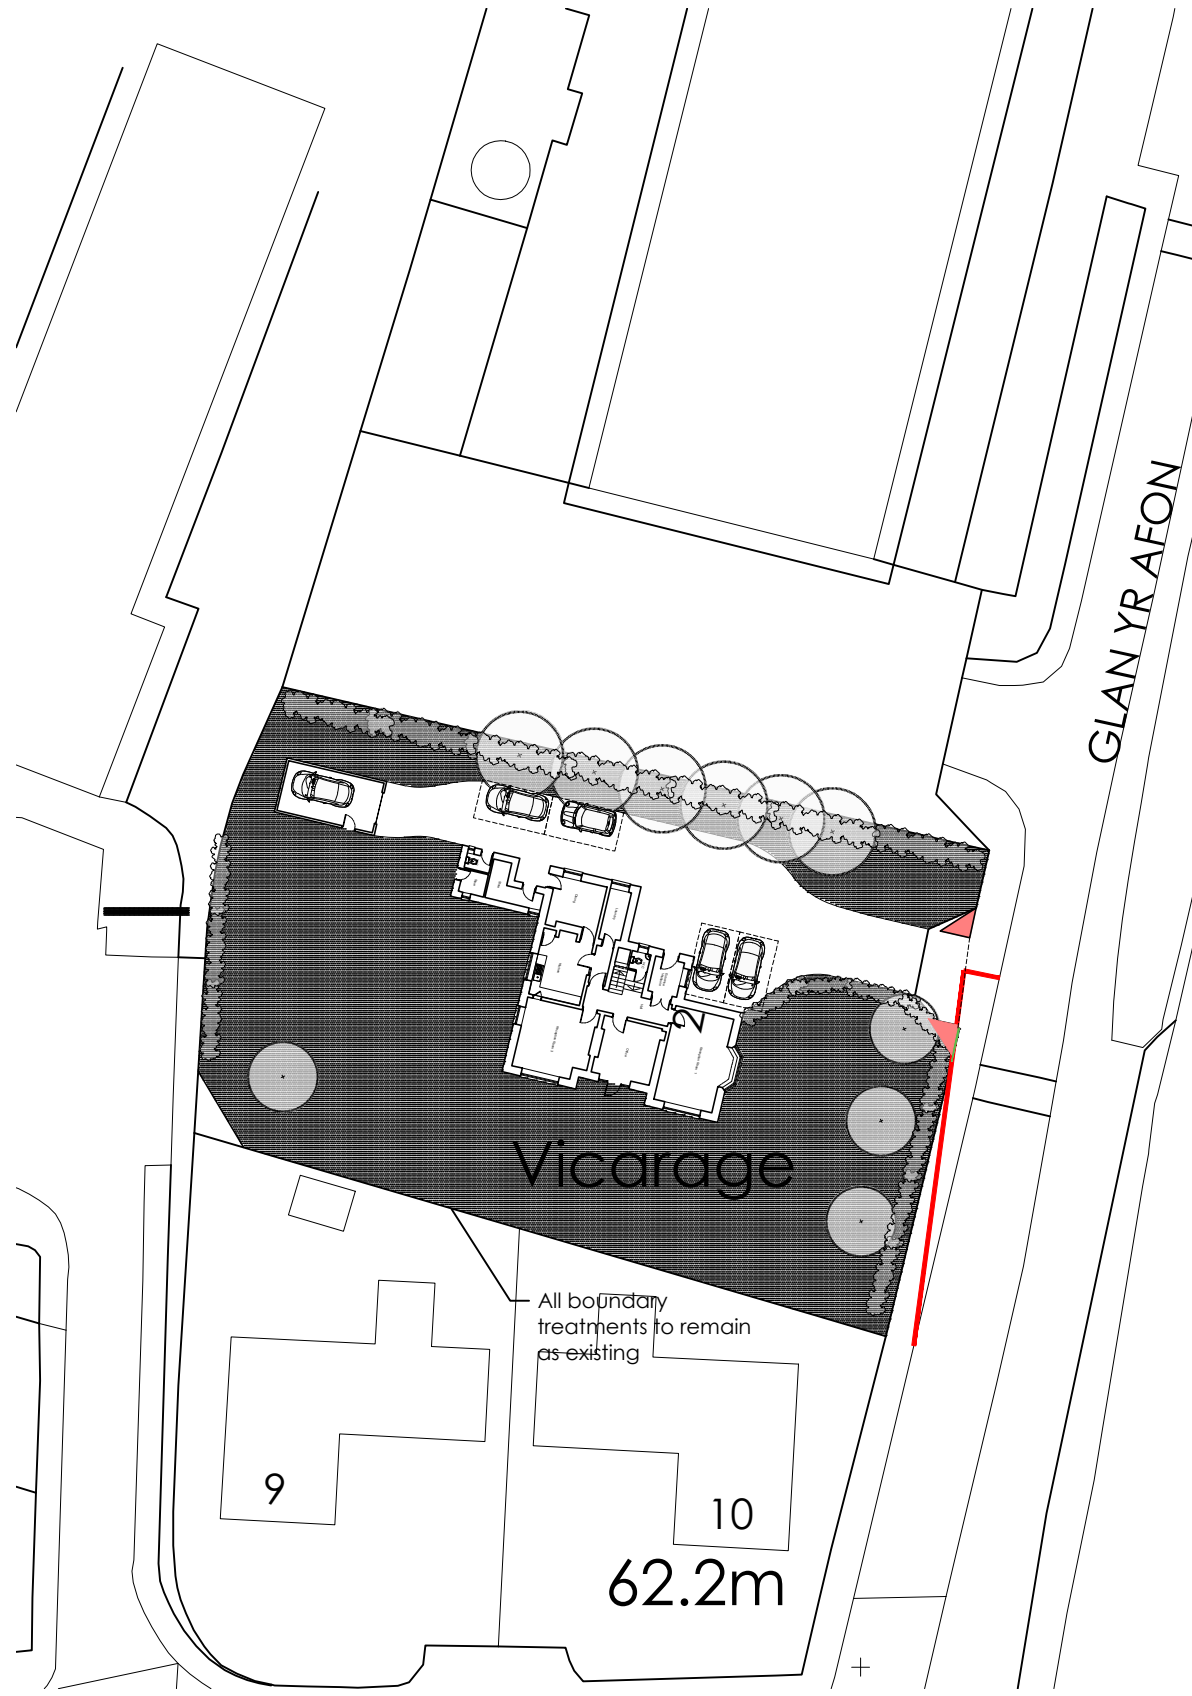

Proposed block plan
1:500

Pedestrian vision splay.
Pink hatch denotes area where hedge must be kept below 600mm. at retain as such thereafter.

Pedestrian vision splay.
Red line denotes 2.4 x25 vehicular vision splay

Green hatch denotes area where hedge must be kept below 600mm. at retain as such thereafter.

The Vicarage, Glanyrafon road, Ystalyfera		Job No. 24_040	Rev. D
Title Block plans			
Date 12.07.24	Drawn ***	Scale 1:500 @ A3	
 C² Architects Environmental & Urban design		Town planners & Urban design	
Unit 1A, Compass Business Park, Pacific Road, Cardiff. CF24 5HL		www.c2architects.co.uk tel: 029 20452100	