

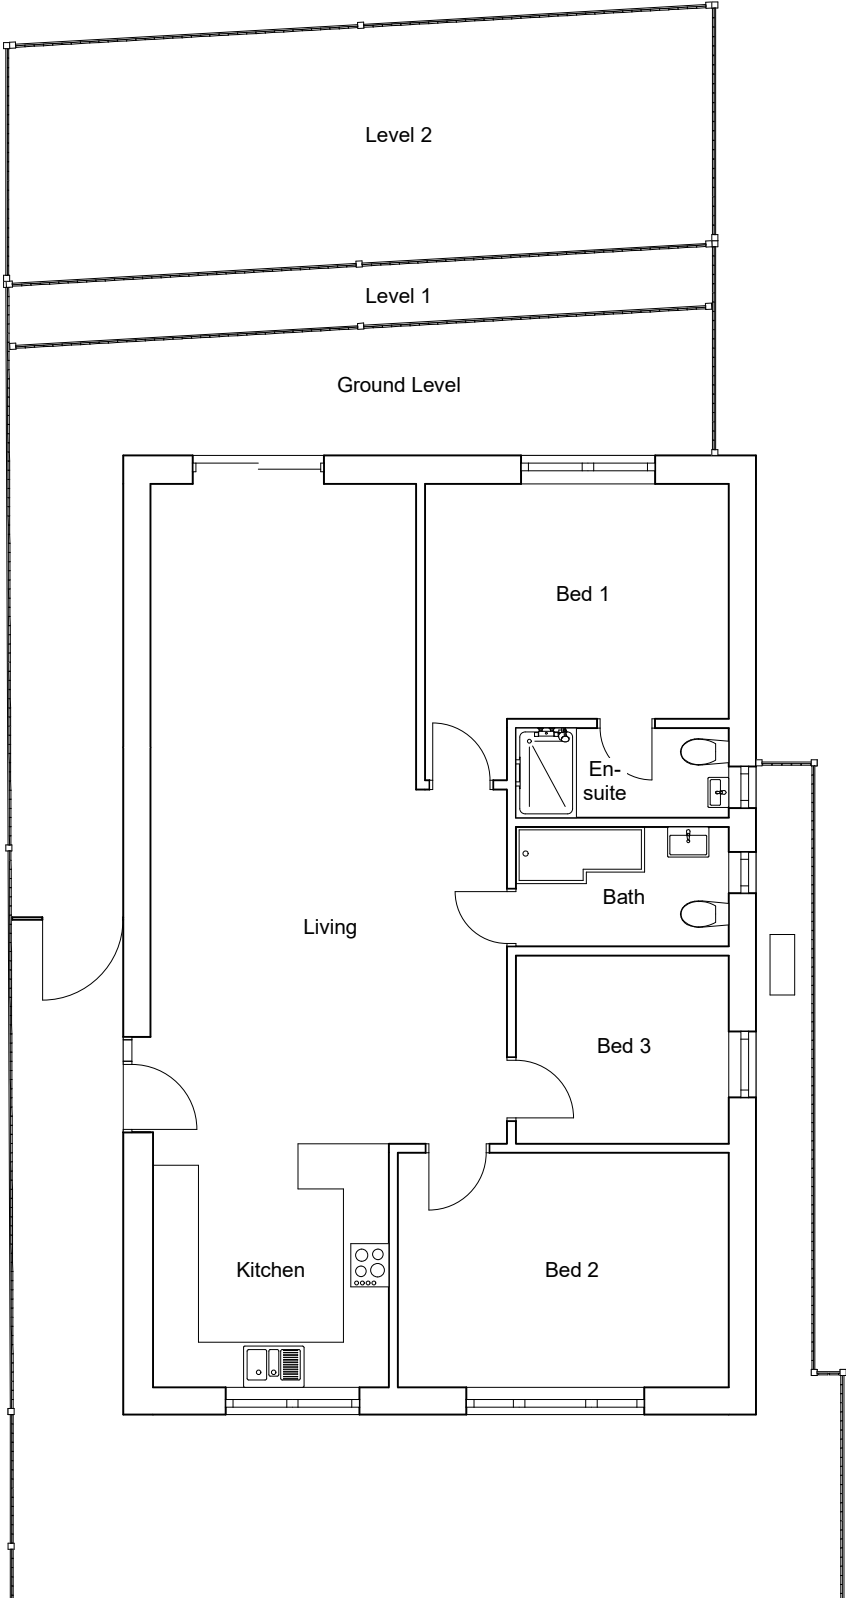


Superseded


NO.	NOTES
1	All dimensions in millimetres unless otherwise stated.
2	Do not scale off drawing. All dimensions to be checked on site by contractor.
3	Drawings to be used for purpose of Planning Application only.
4	These are not Construction Drawings.
5	The contractor is to set out, check and co-ordinate all dimensions on site during the course of works.

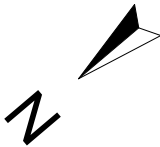


GROUND FLOOR

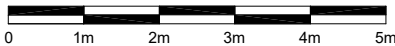


SCALE 1:100

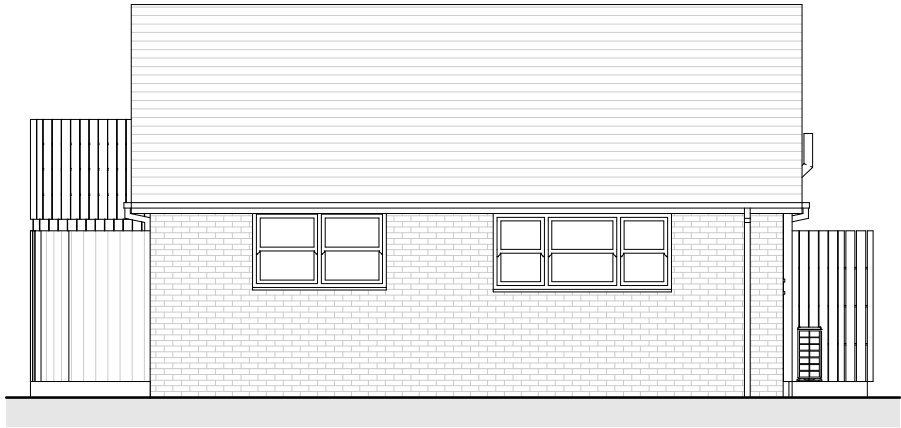

FRONT ELEVATION

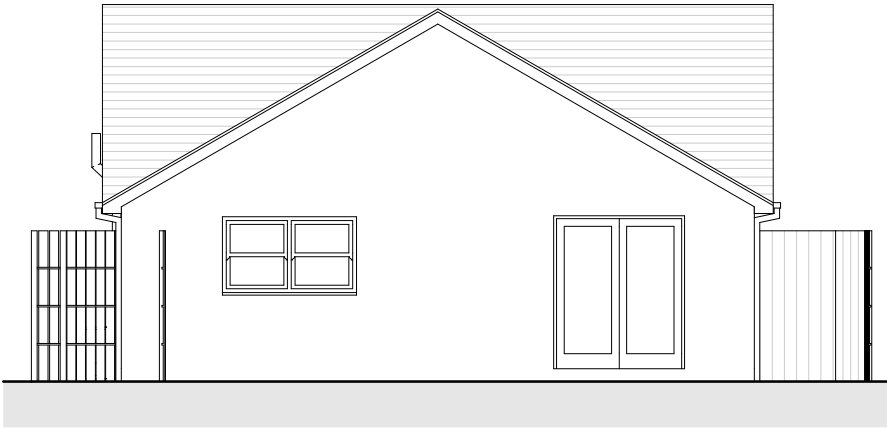

REAR ELEVATION

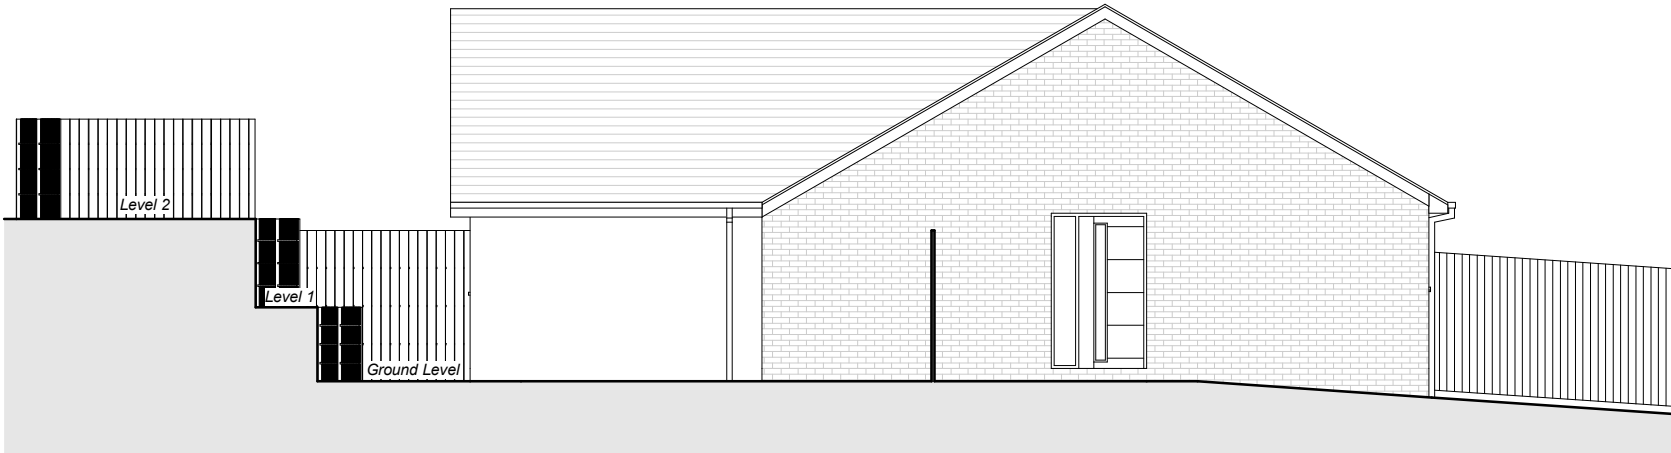

SIDE ELEVATION



SIDE ELEVATION



REVISIONS:

SHEET TITLE:
As Built Floor Plan and Elevations

PROJECT DESCRIPTION:
PROJECT: As Built Survey
SITE: 8 Station Terrace, Seven Sisters SA10 9DH
CLIENT: Neil Avery



DATE:
January 2025

SCALE:
1:100

SHEET:
A-3