



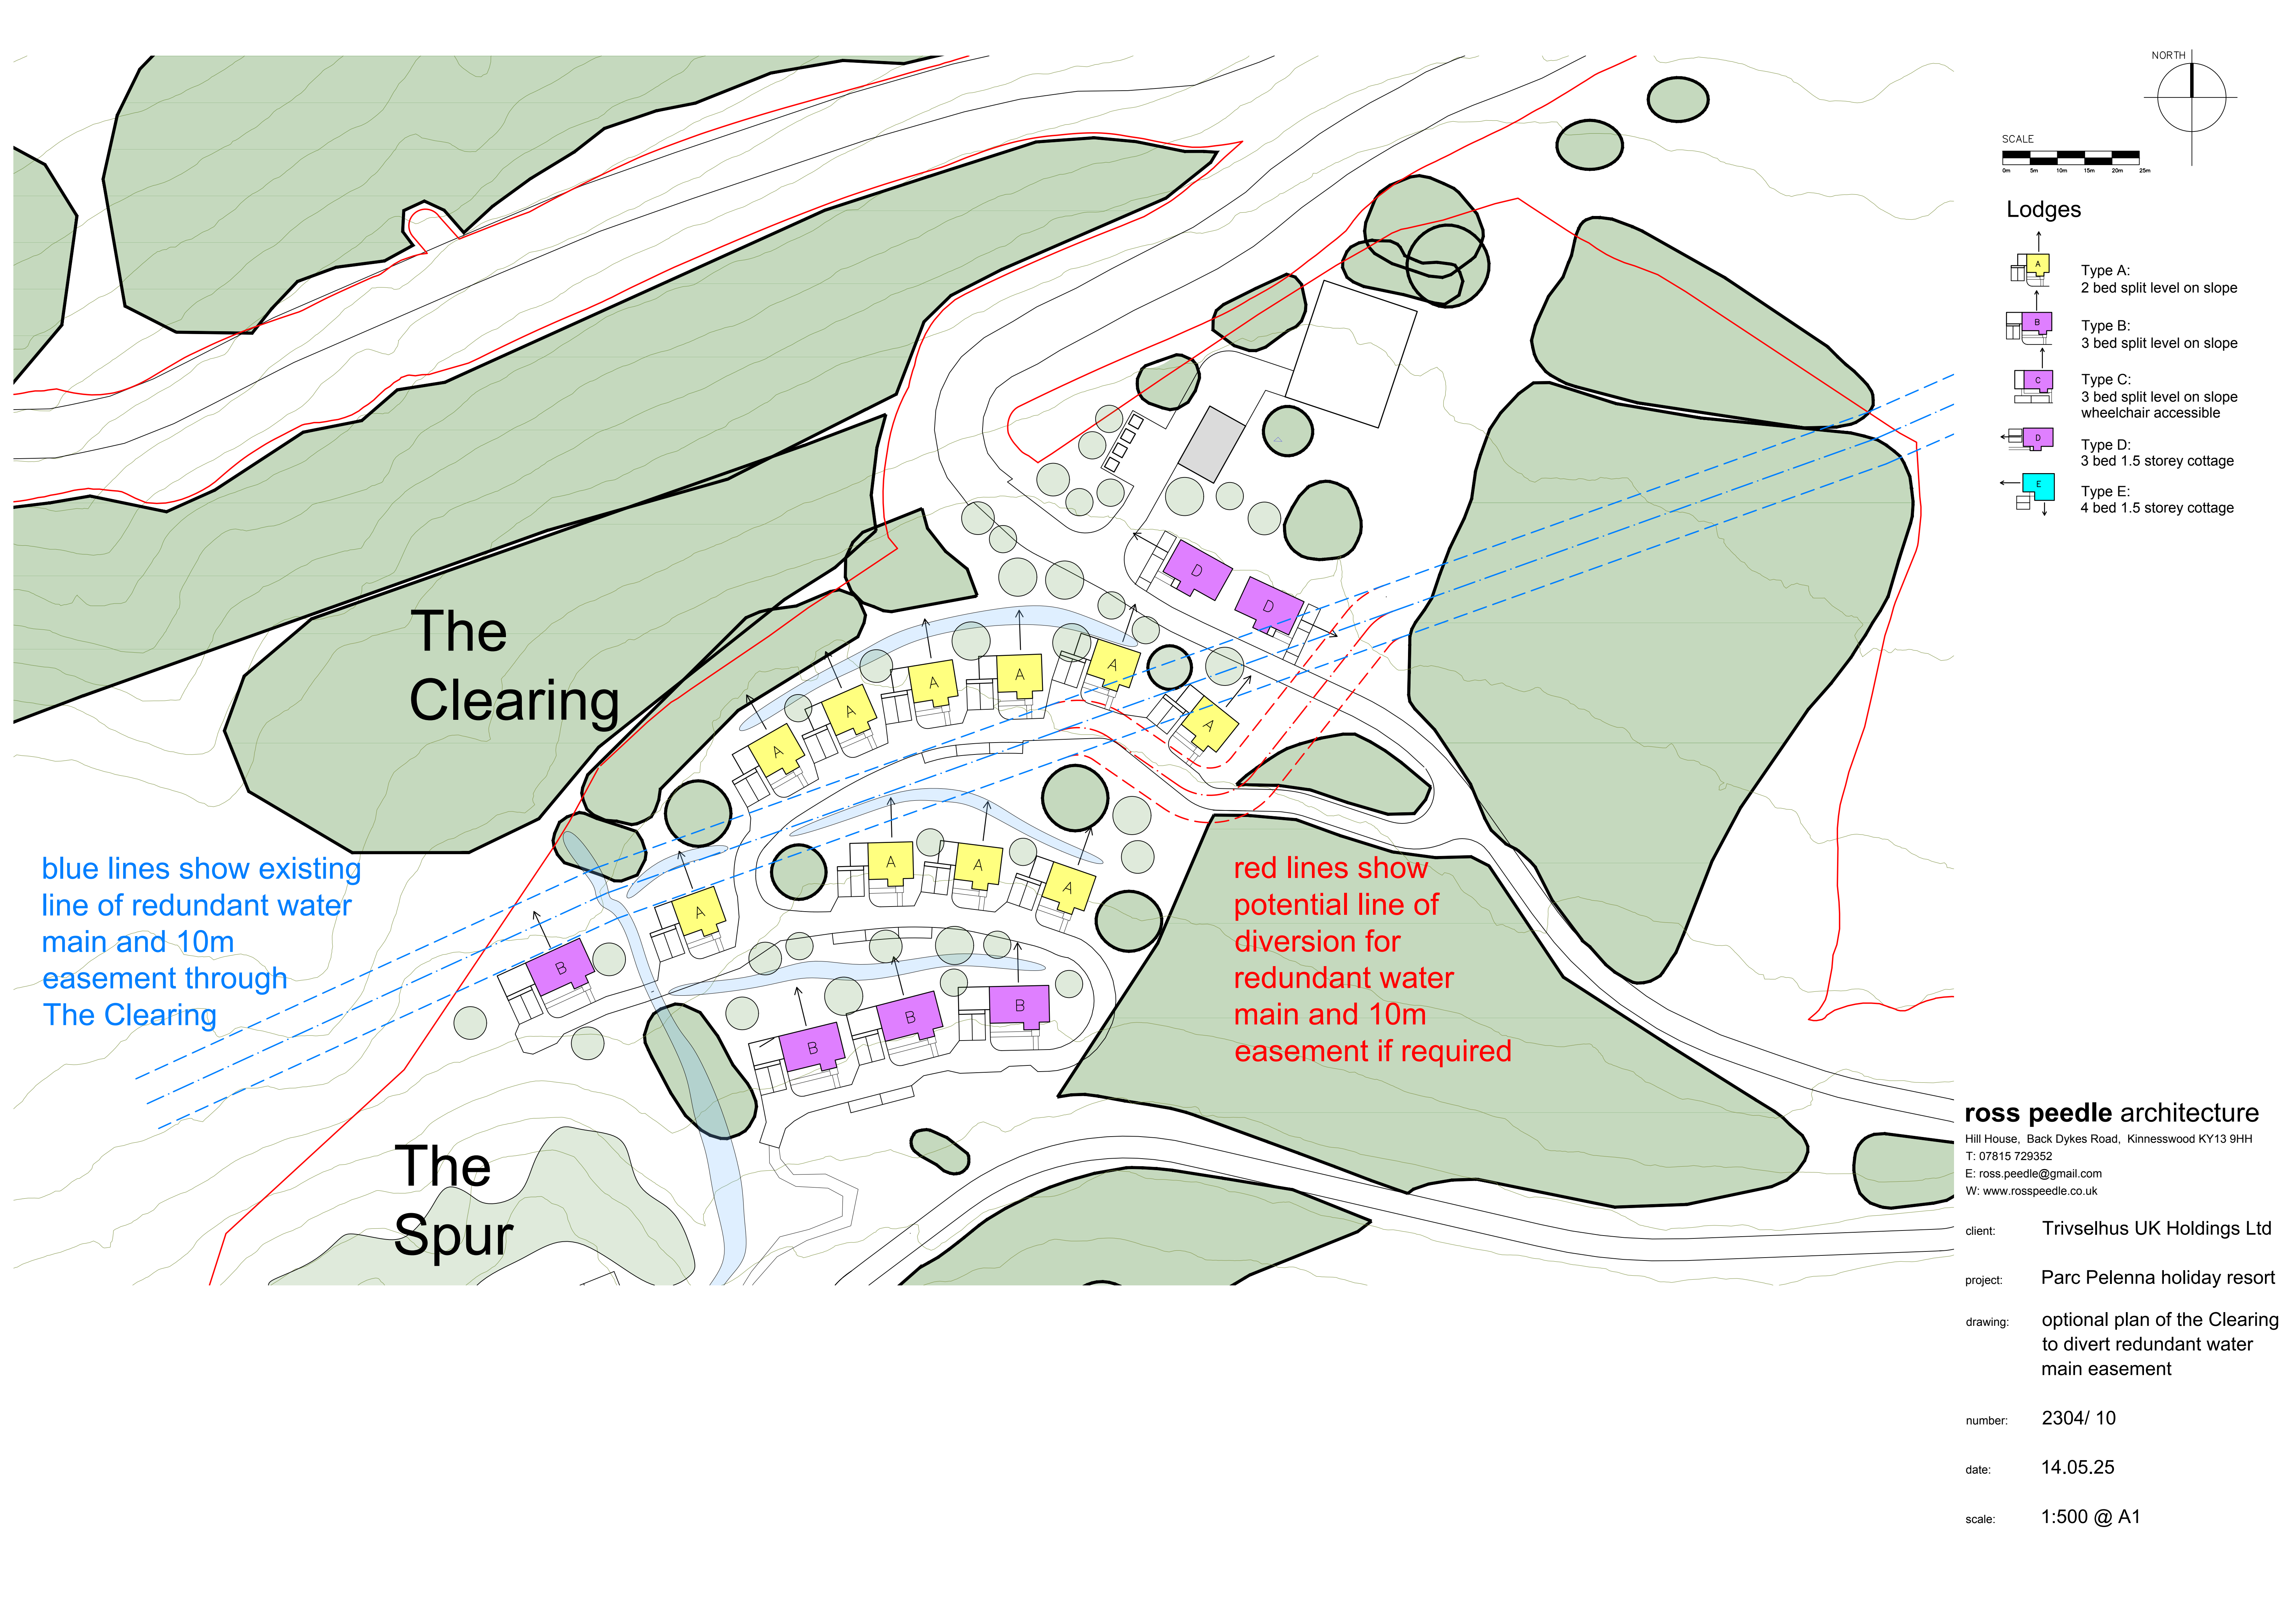

blue lines show existing
line of redundant water
main and 10m
easement through
The Clearing

red lines show
potential line of
diversion for
redundant water
main and 10m
easement if required

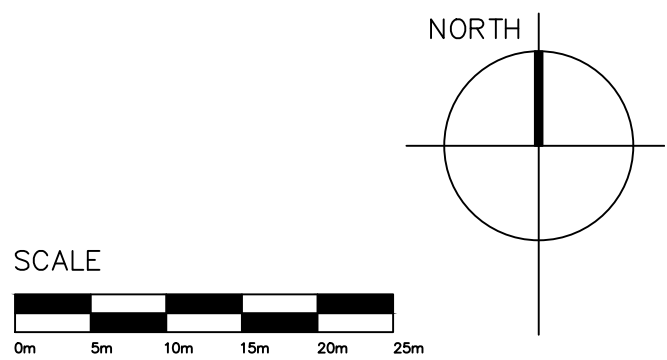

Lodges

- Type A:
2 bed split level on slope
- Type B:
3 bed split level on slope
- Type C:
3 bed split level on slope
wheelchair accessible
- Type D:
3 bed 1.5 storey cottage
- Type E:
4 bed 1.5 storey cottage

ross peedle architecture
 Hill House, Back Dykes Road, Kinnesswood KY13 9HH
 T: 07815 729352
 E: ross.peedle@gmail.com
 W: www.rosspeedle.co.uk

client:	Trivselhus UK Holdings Ltd
project:	Parc Pelenna holiday resort
drawing:	optional plan of the Clearing to divert redundant water main easement
number:	2304/ 10
date:	14.05.25
scale:	1:500 @ A1