


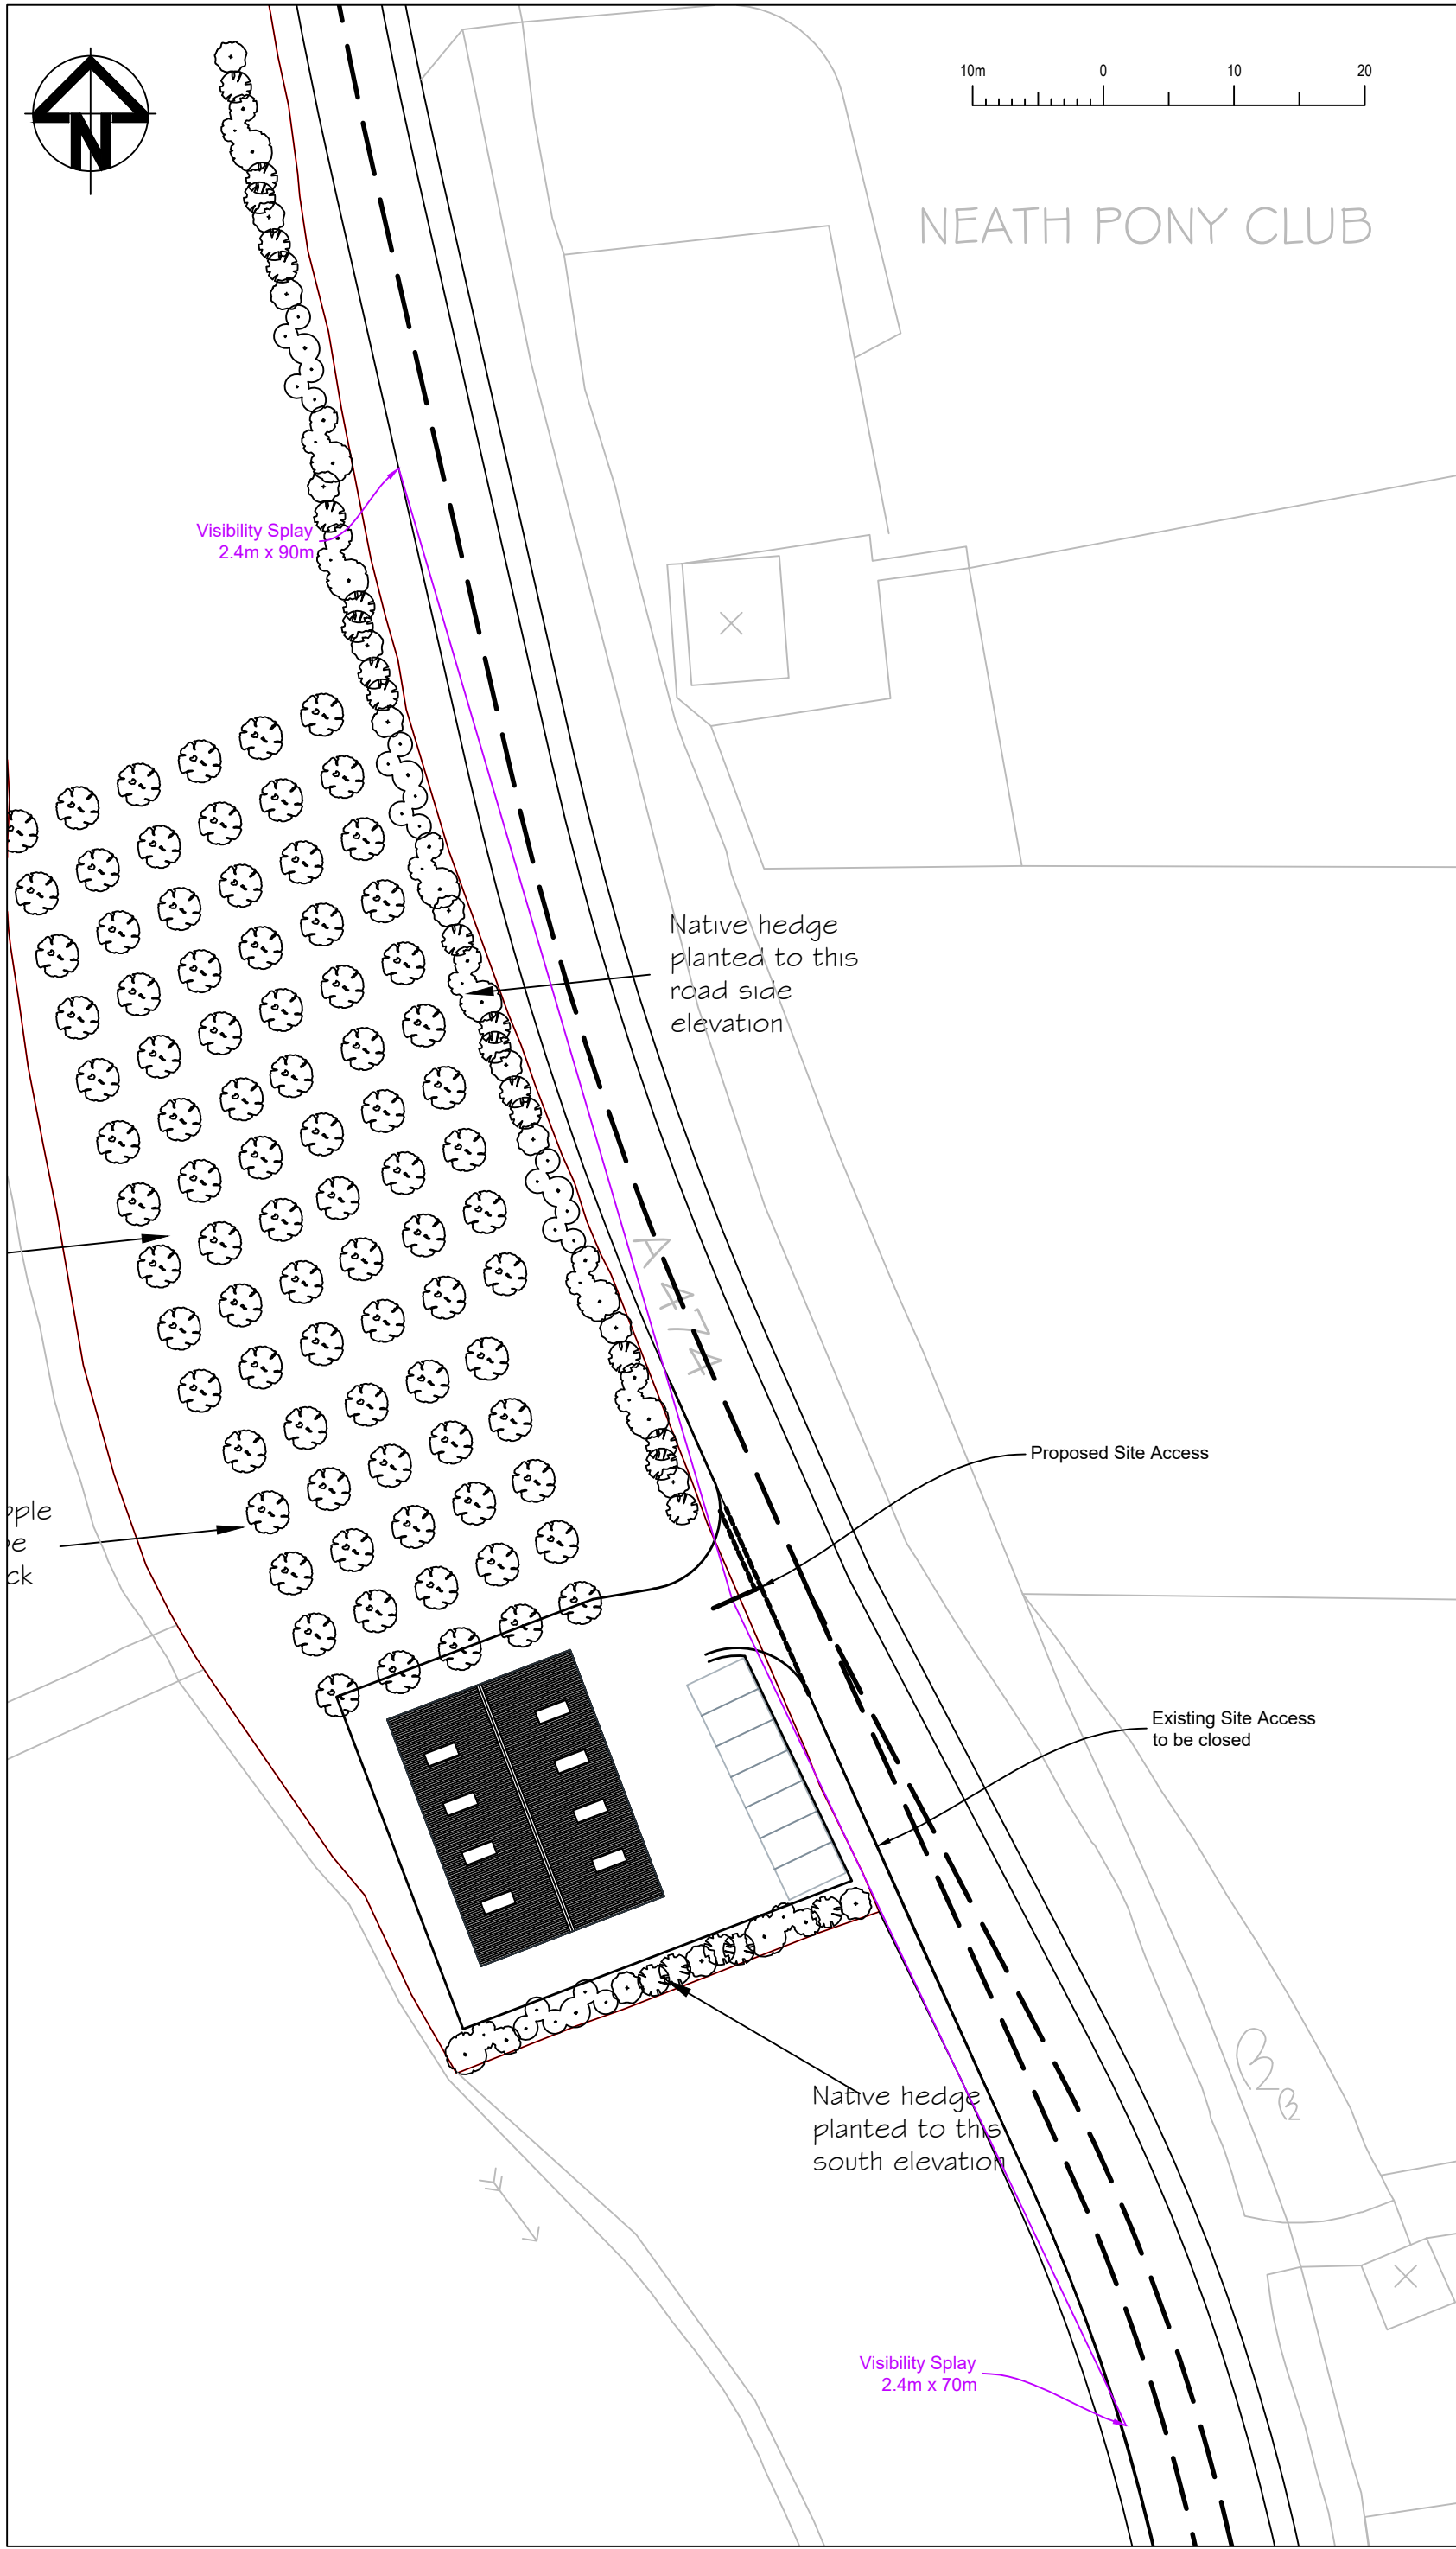

General Notes

1. ALL DIMENSIONS ARE INDICATIVE AND IN METRES UNLESS NOTED OTHERWISE.
2. DO NOT SCALE THIS DRAWING, USE FIGURED DIMENSIONS ONLY.
3. ALL LEVELS ARE IN METRES ABOVE ORDNANCE DATUM (AOD) BASED ON THE TOPOGRAPHICAL SURVEY DRAWING SUPPLIED BY THE CLIENT.
4. ANY DISCREPANCIES TO BE REPORTED TO THE ENGINEER.
5. THIS DRAWING IS TO BE READ IN CONJUNCTION WITH ALL OTHER RELEVANT ARCHITECTS AND ENGINEERS DRAWINGS AND SPECIFICATIONS.
6. THE SPECIFICATION IN ALL ASPECTS SHALL BE IN ACCORDANCE WITH THE CURRENT RESIDENTIAL DESIGN GUIDE AND SPECIFICATION IN FORCE WITHIN THE COUNTY AT THE TIME OF CONSTRUCTION.
7. COPYRIGHT OF THIS DRAWING IS RETAINED BY THE ENGINEER AND IT MUST NOT BE REPRODUCED IN WHOLE OR PART WITHOUT WRITTEN CONSENT.

A		
For Discussion		07.04.2025
No.	Revision/Issue	Date

Drawing Status
S0 - Work in progress

Firm Name and Address

LvW Highways
www.LvWHighways.com

Client
Mr Marc O'Mahoney

Architect
Architect

Project Name and Address
Land off Neath Road (A474)
Bryn Celyn, Fforest Goch
Pontardawe
NPTCBC

Drawing Title
Retention of agricultural building
and access as constructed
Amended location of access
with achievable visibility splays

Designed KvW	Drawn KvW	Approved KvW
-----------------	--------------	-----------------

Scale 1:500@A3P	Date 28.03.2025
--------------------	--------------------

Drawing Number 916b-LVWH-GEN-A474-DR-GEN-001	Rev: A
---	-----------