



D:\STEVE\darren and emma\DARREN AND EMMA\DWG 2025 03.dwg

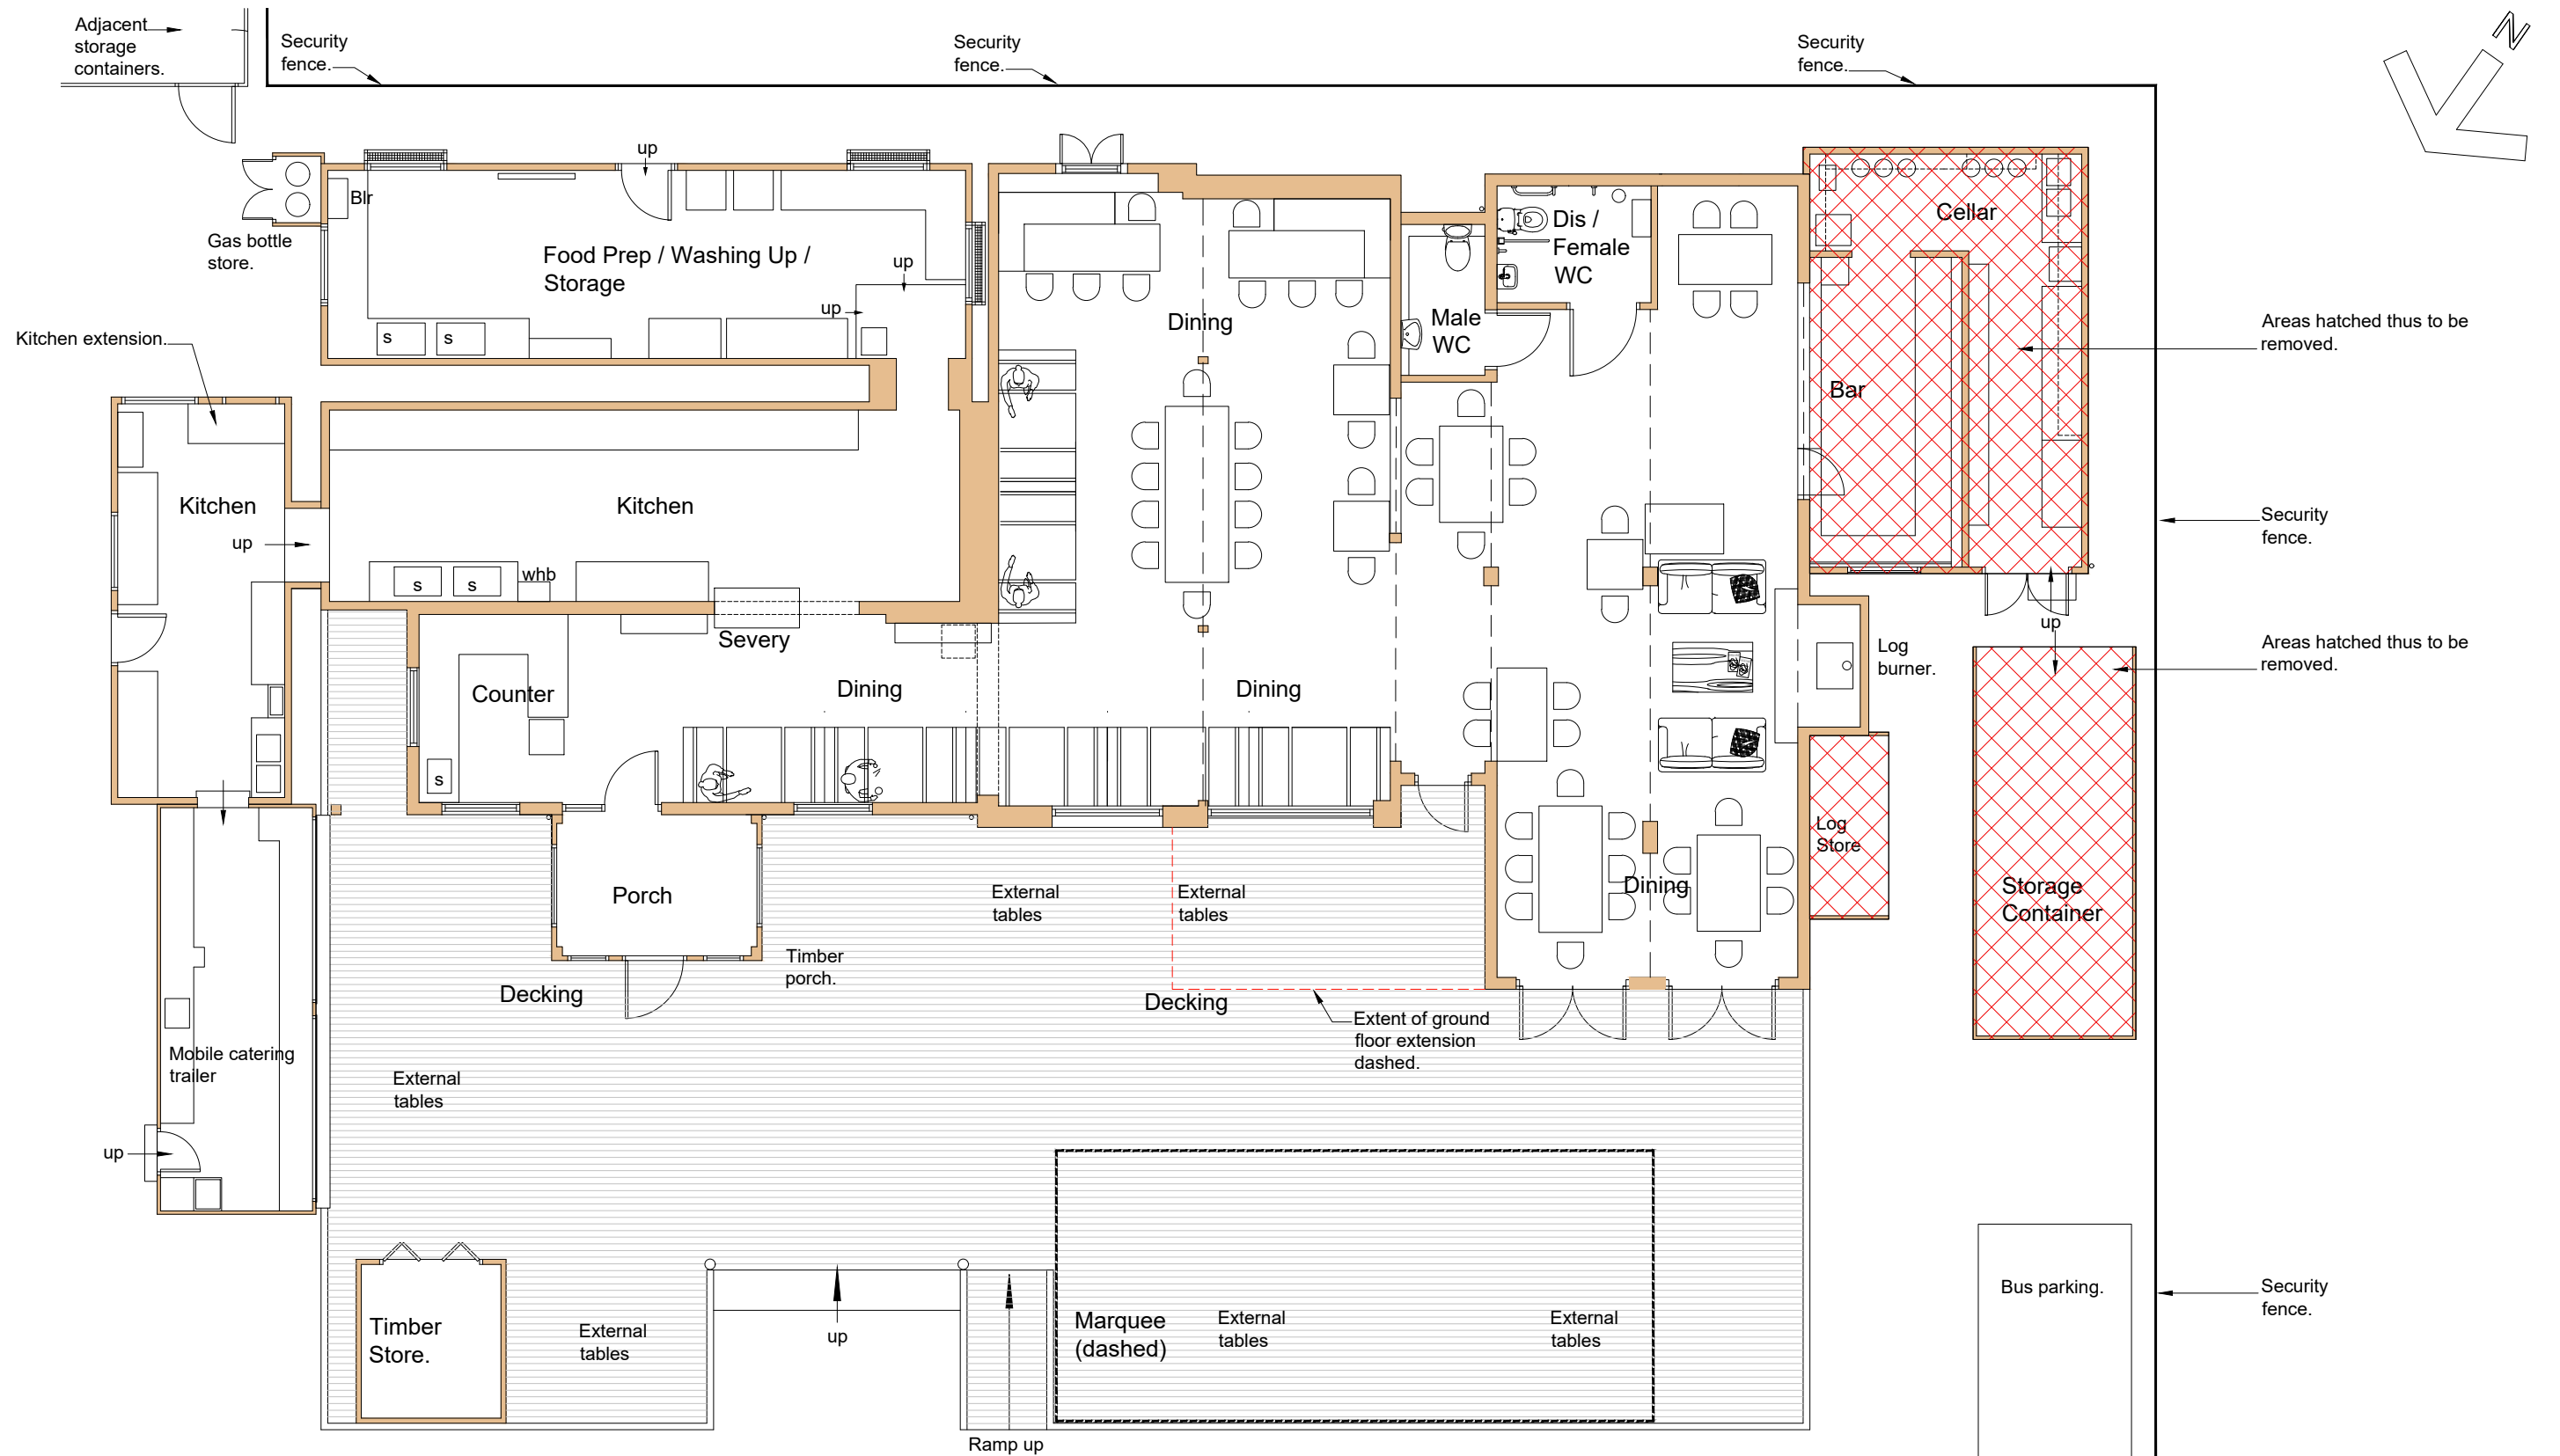

Floor Plan (as constructed to date) 1:100

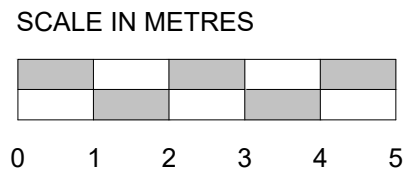

FOR PLANNING
PURPOSES ONLY

A	Existing title amended to "as constructed to date"			Aug'25	
Revision	Description			Date	
Drawing Title					
Ground Floor Plan (as constructed to date)					
Client					
Mr & Mrs Hughes					
Project Name					
Proposed Alterations + Extensions to Breakfast Bar and Grill, Old TRW Works Neath Vale Supplier Park, Resolven, Neath Port Talbot, SA11 4SR					
Job No.	Drawing No.	Revision:	Size:	Scale:	Date:
109	03	A	A3	1:100	May '25