


North Elevation (as constructed to date) 1:100

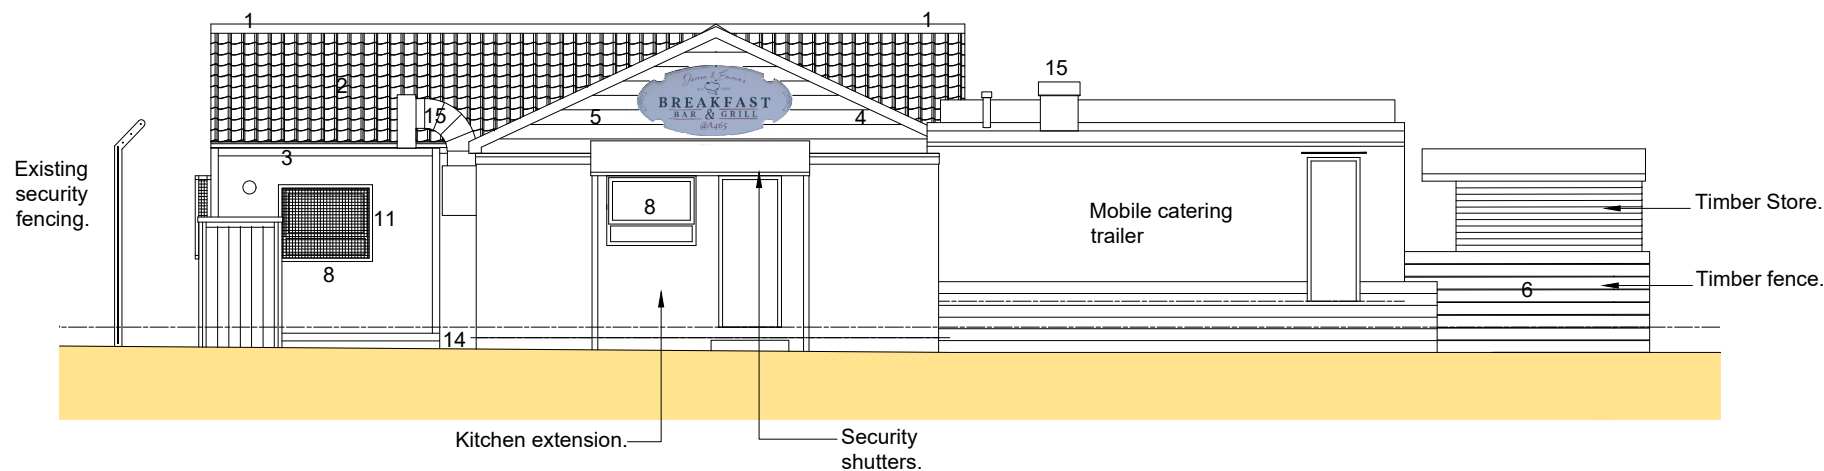


East Elevation (as constructed to date) 1:100

FINISHES.

1. Terracotta ridge tiles.
2. Profiled tiled roof.
3. Black Upvc rainwater goods.
4. White Upvc / timber fascias / soffits / barge boards.
5. Horizontal timber cladding, painted.
6. Timber balustrade.
7. Painted steel shipping containers.
8. White Upvc windows / doors.
9. Painted steel windows.
10. Painted steel security door.
11. Painted steel security mesh to rear windows.
12. Steel security shutters.
13. Profiled metal cladding to canopy roof.
14. Brick / block supports to containers.
15. Stainless steel mechanical ventilation ducts.

SCALE IN METRES

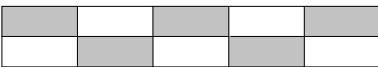

FOR PLANNING
PURPOSES ONLY

A	Existing title amended to "as constructed to date"	Aug'25
Revision	Description	Date
Drawing Title Elevations (as constructed to date)		
Client Mr & Mrs Hughes		
Project Name Proposed Alterations + Extensions to Breakfast Bar and Grill, Old TRW Works Neath Vale Supplier Park, Resolven, Neath Port Talbot, SA11 4SR		
Job No. 109	Drawing No. 05	Revision: A
Size: A3	Scale: 1:100	Date: May '25