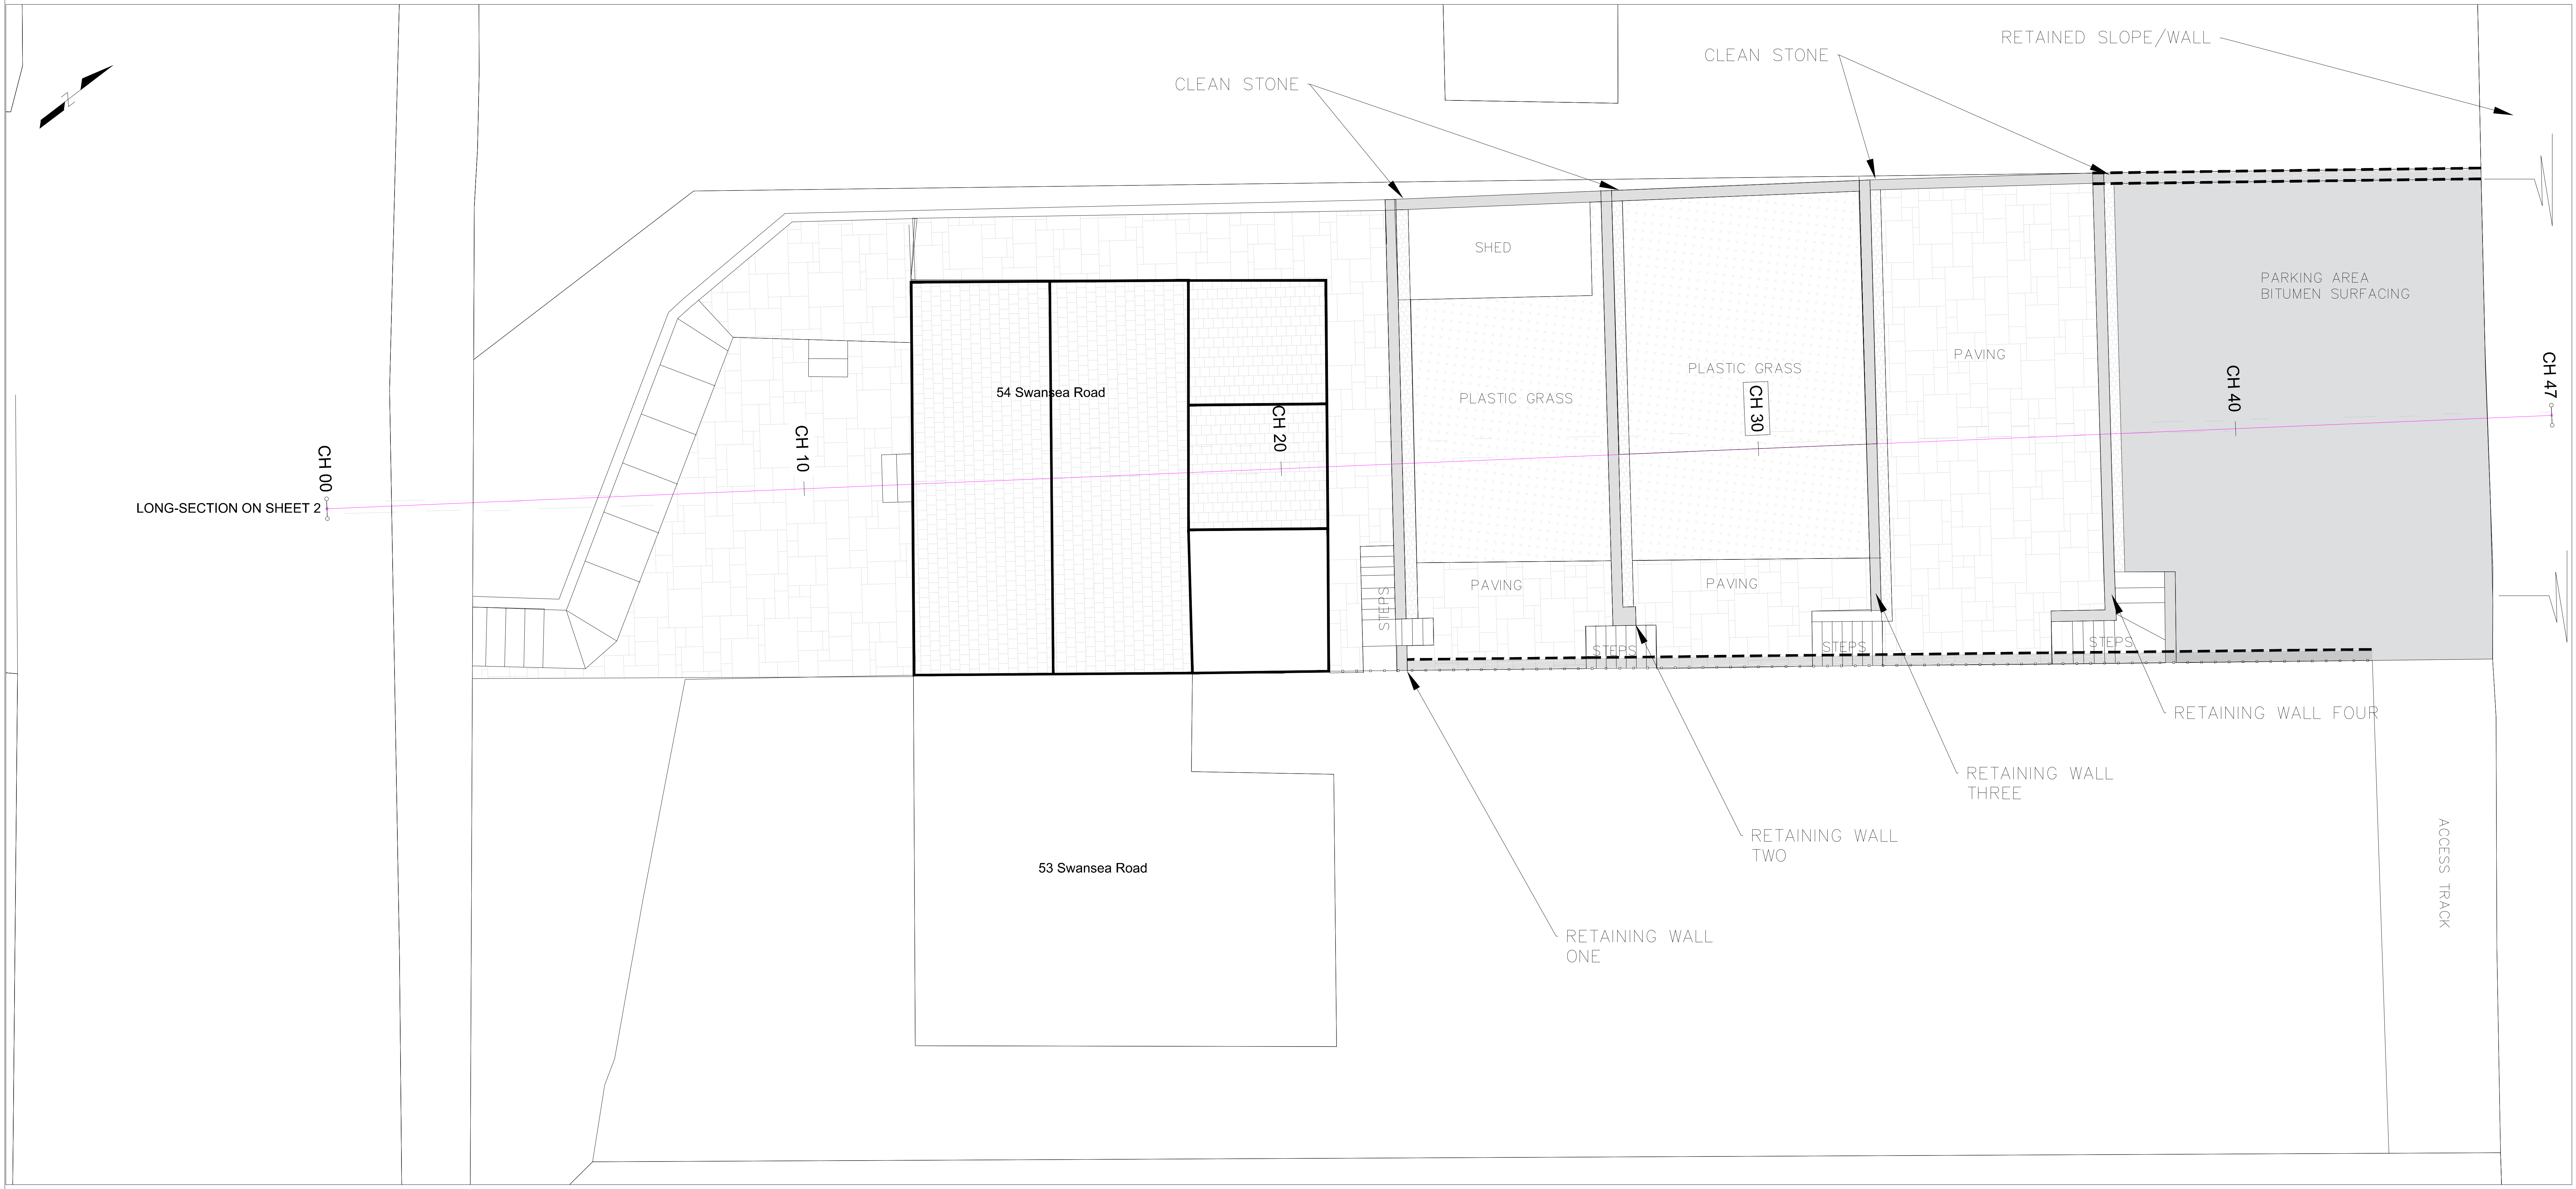

PLAN SCALE 1 TO 100

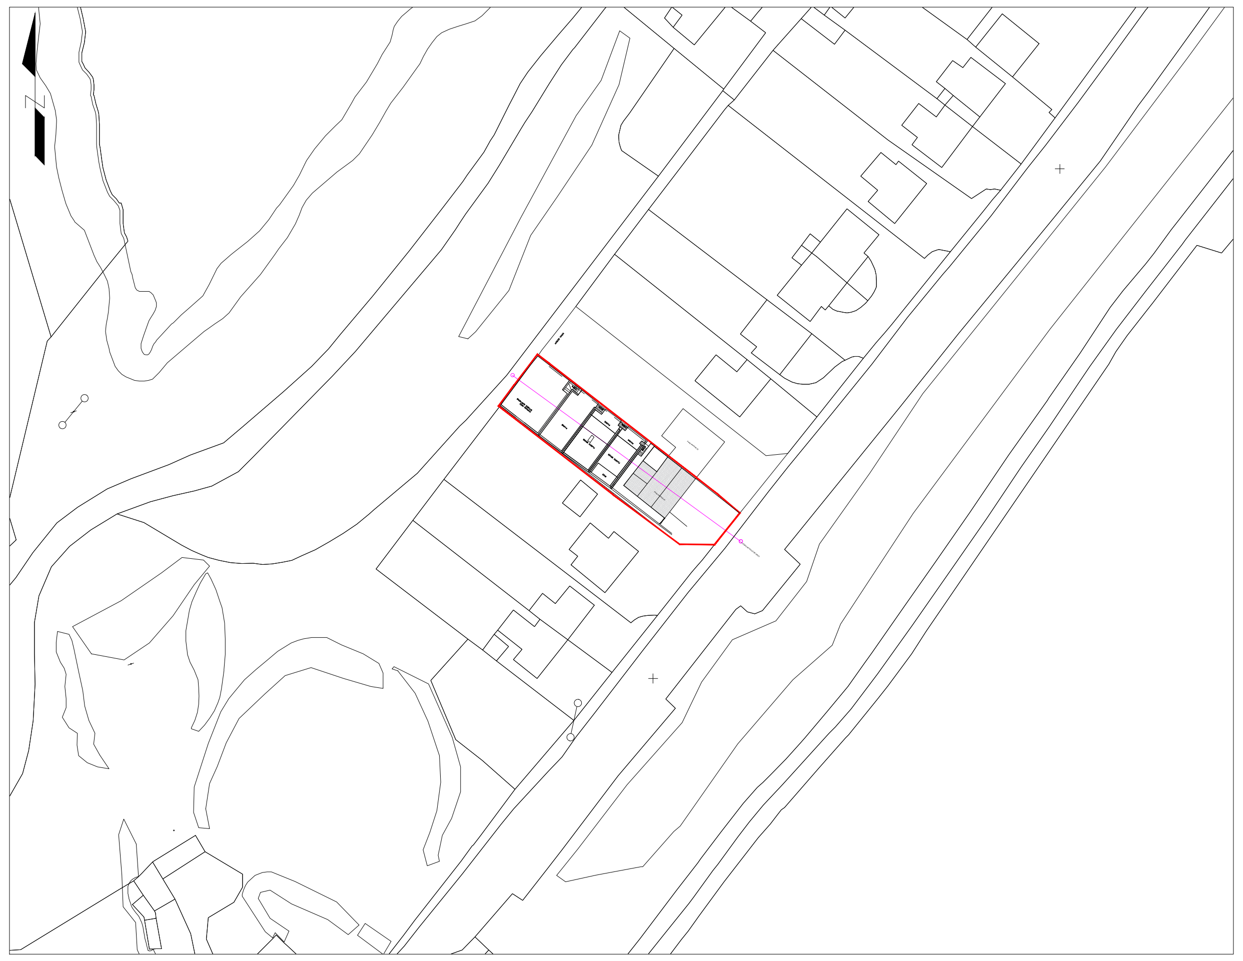

LOCATION PLAN SCALE 1 TO 1250

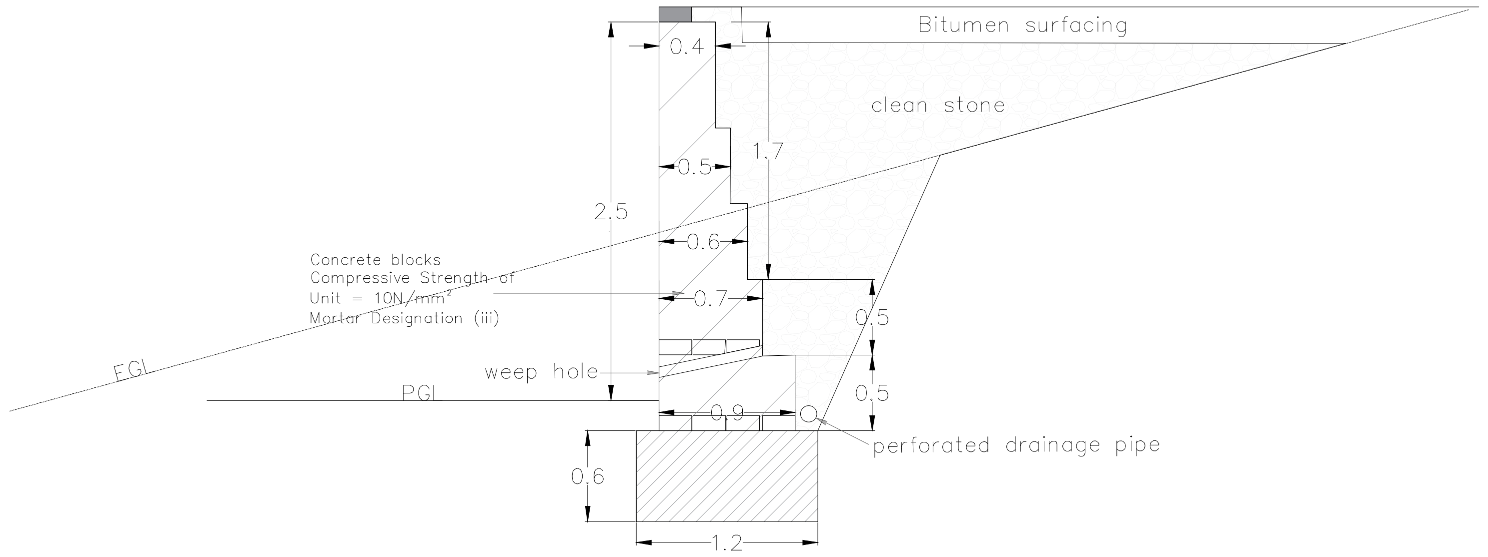

RETAINING WALL FOUR AS BUILT

Matt John
BSc (Hons) City and Regional Planning
MSc Regeneration

RTPI
Accredited Degrees

NO.	NOTES	BY	DATE
1	All dimensions in millimetres unless otherwise stated.		
2	Do not scale off drawing. All dimensions to be checked on site by contractor.		
3	Drawings to be used for purposes of Planning Application only.		
4	These are not Construction Drawings.		
5	The contractor is to set out, check and co-ordinate all dimensions on site during the course of works		

SHEET TITLE:
EXISTING PLAN P01
SHEET 1 OF 2

PROJECT DESCRIPTION:
54 SWANSEA ROAD PONTARDAWE
GARDEN WALL SURVEY

Atrium
Planning Consultants

DATE:
AUGUST
2022

SCALE:
as shown

SHEET:
A-2