


GLYNNEATH DEVELOPMENT

PLANTING PLAN

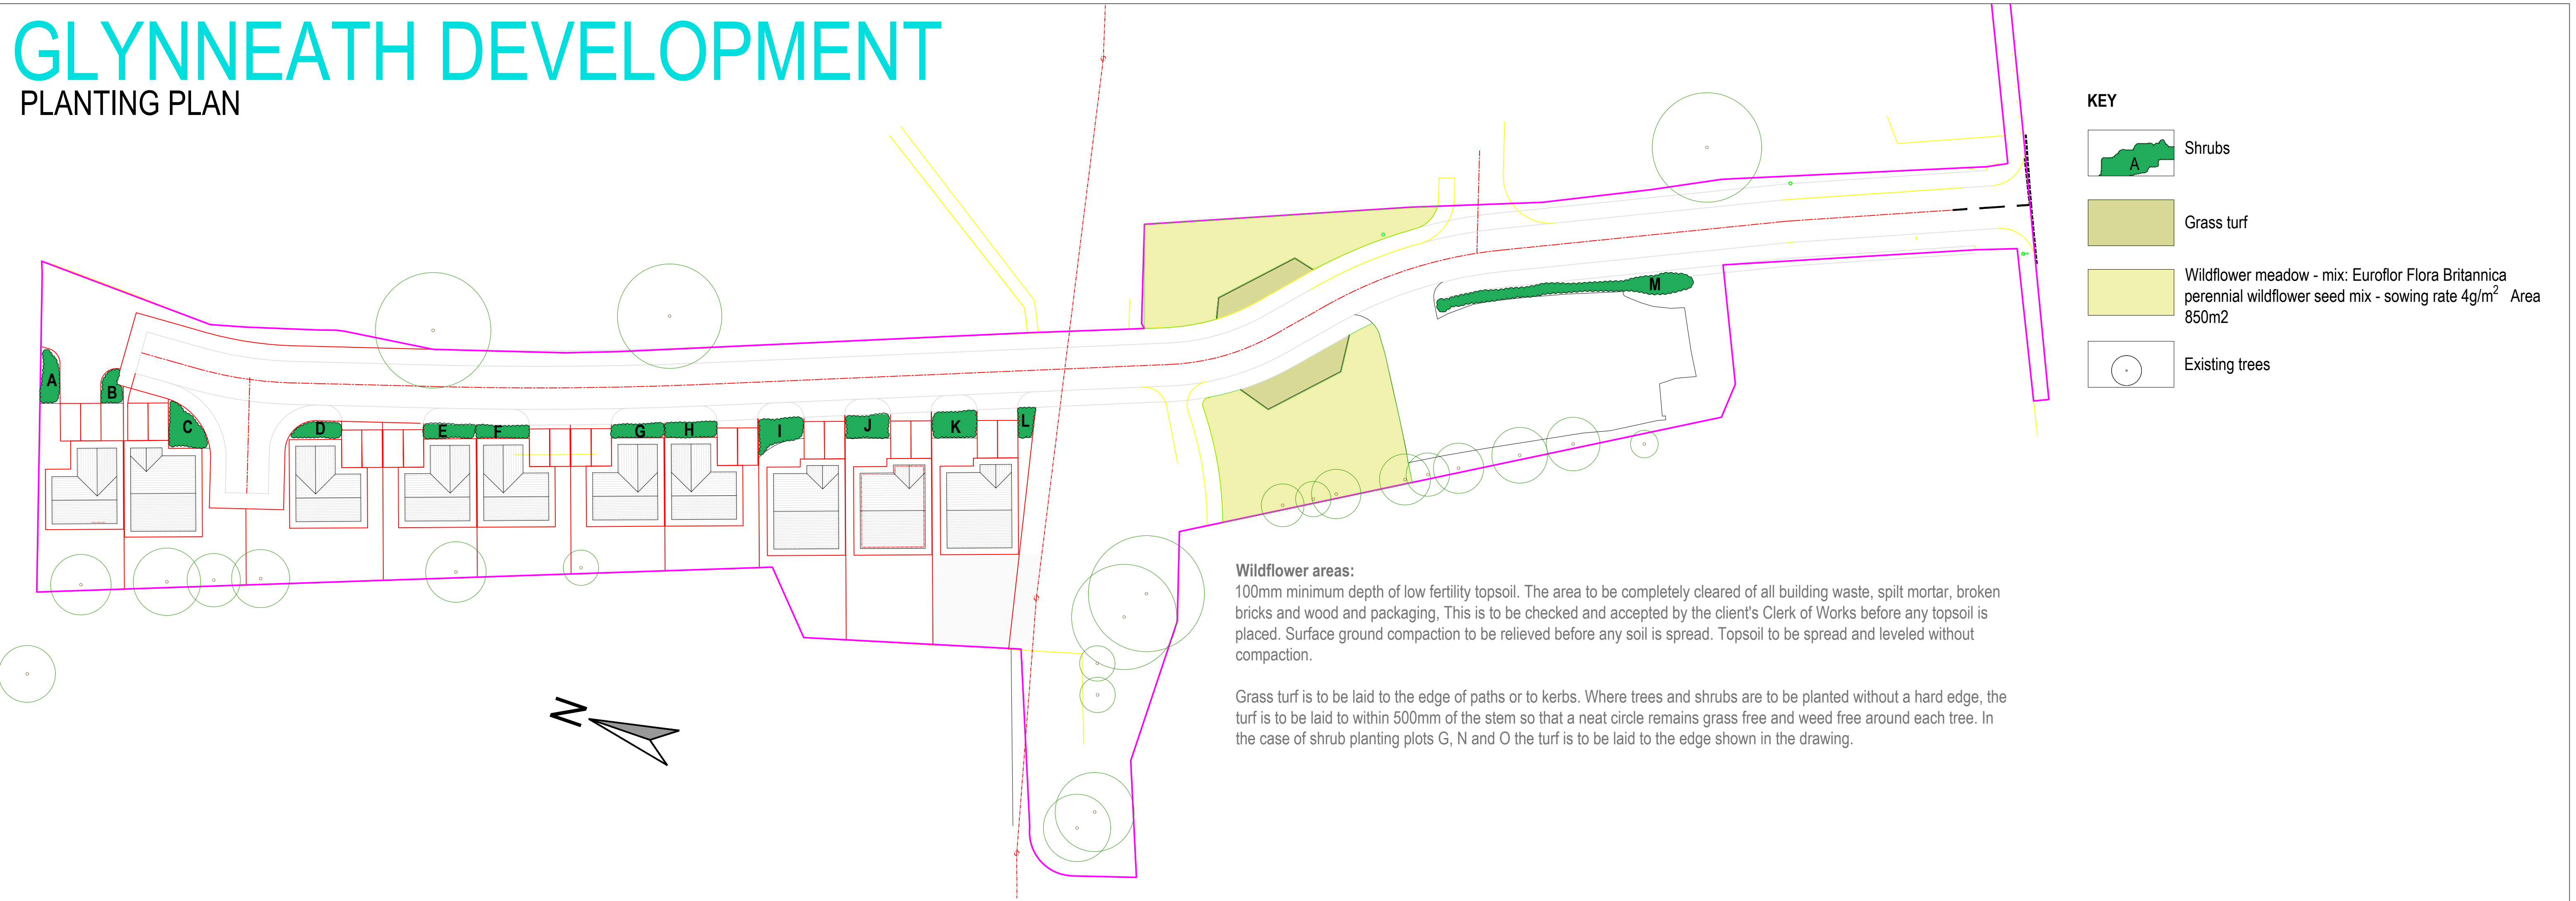

Shrub Planting Schedule

Species		No./m ²	A	B	C	D	E	F	G	H	I	J	K	L	M	TOTAL
Salvia officinalis 'Purpurescens'	3L	3			9											9
Rosmarinus officionalis 'Prostratus'	3L	2			6		6									12
Potentilla 'Vilmoriniana'	3L	3			6	6										12
Pittosporum tenuifolium 'Tom Thumb'	3L	2	4	4							4	4	4	4		24
Mahonia x media 'Winter Sun'	3L	2														31
Lavendula angustifolia	1.5L	4			16	12	8	8	8	12						64
Hebe brachysiphon 'White Gem'	4L	3	6	6	6	6					6	6	6	6		48
Genista lydia	3L	2				4		6	6	6						22
Euonymous fortune 'Silver Queen'	3L	3	18	6							15	12	15	6		72
Euonymous fortune 'Emerald and Gold'	3L	3	6	6							6	6	6	6		36
Cotoneaster adpressus	3L	3	9	6			6				9	9	9	3		45
Cistus x corbariensis	3L	2			6	6	6	6	6	6						36
Caenothus thrysoflorus 'Repens'	3L	2			6			6	6	6						24
Crataegus monogyna	60-80cm, BR	3													51	51
Corylus avellana	60-80cm, BR	3													32	32
Euonymus europaeus	60-80cm, BR	3													15	15
Ilex aquifolium	3L	3													15	15
Prunus spinosa	60-80cm, BR	3													32	32
Rosa canina	60-80cm, BR	3													15	15
TOTAL			43	28	55	34	26	26	26	30	40	37	40	25	160	570

NOTES

Plots A to L: 300mm min. depth of topsoil. Plot to be excavated to a minimum depth of 200mm with all arisings, including all building debris to be removed from site. This is to be checked and accepted by Clerk of Works before any topsoil is placed. Immediately before placing of topsoil, the base of the plot is to be broken up to a depth of 100mm to relieve compaction and allow future root penetration. Topsoil to be placed to full depth of 300mm with no compaction.

Plots A, B and I,J,K,L: Cotoneaster and Euonymous spread throughout the plot. Pittosporum and Hebe distrubuted as specimens towards the back of the plot.

Plots C to H: Lavendula distributed along the front of each plot. Other species grouped as feature plants towards the middle and back of the plots.

Plot M: Plants to be planted in groups of 7. Ilex aquifolium to be spaced individually through the plot

All Plots: After planting bark mulch is to be spread across the full extent of the plot, to depth of 50mm and gently compacted by foot.

Rev.	Date.	Details.	By.	Chk.
Whittington Landscape Architecture 50 Penprysg Road Pencoed Bridgend CF35 6RH Contact: Geoff Whittington Mob: 07724 680490 Email: geoffwhittington4@gmail.com				
Client:		Manning Construction		
Project:		Glynneath Development		
Title:		Landscape Proposals AS BUILT		
Drawn: GW		Checked.	Scale(s). 1:400 @ A1	
Date. 04/01/24		Job no. 291	Drg. no. 002	Rev. C