


Appendix E – Available Service Drawings

[illegible]

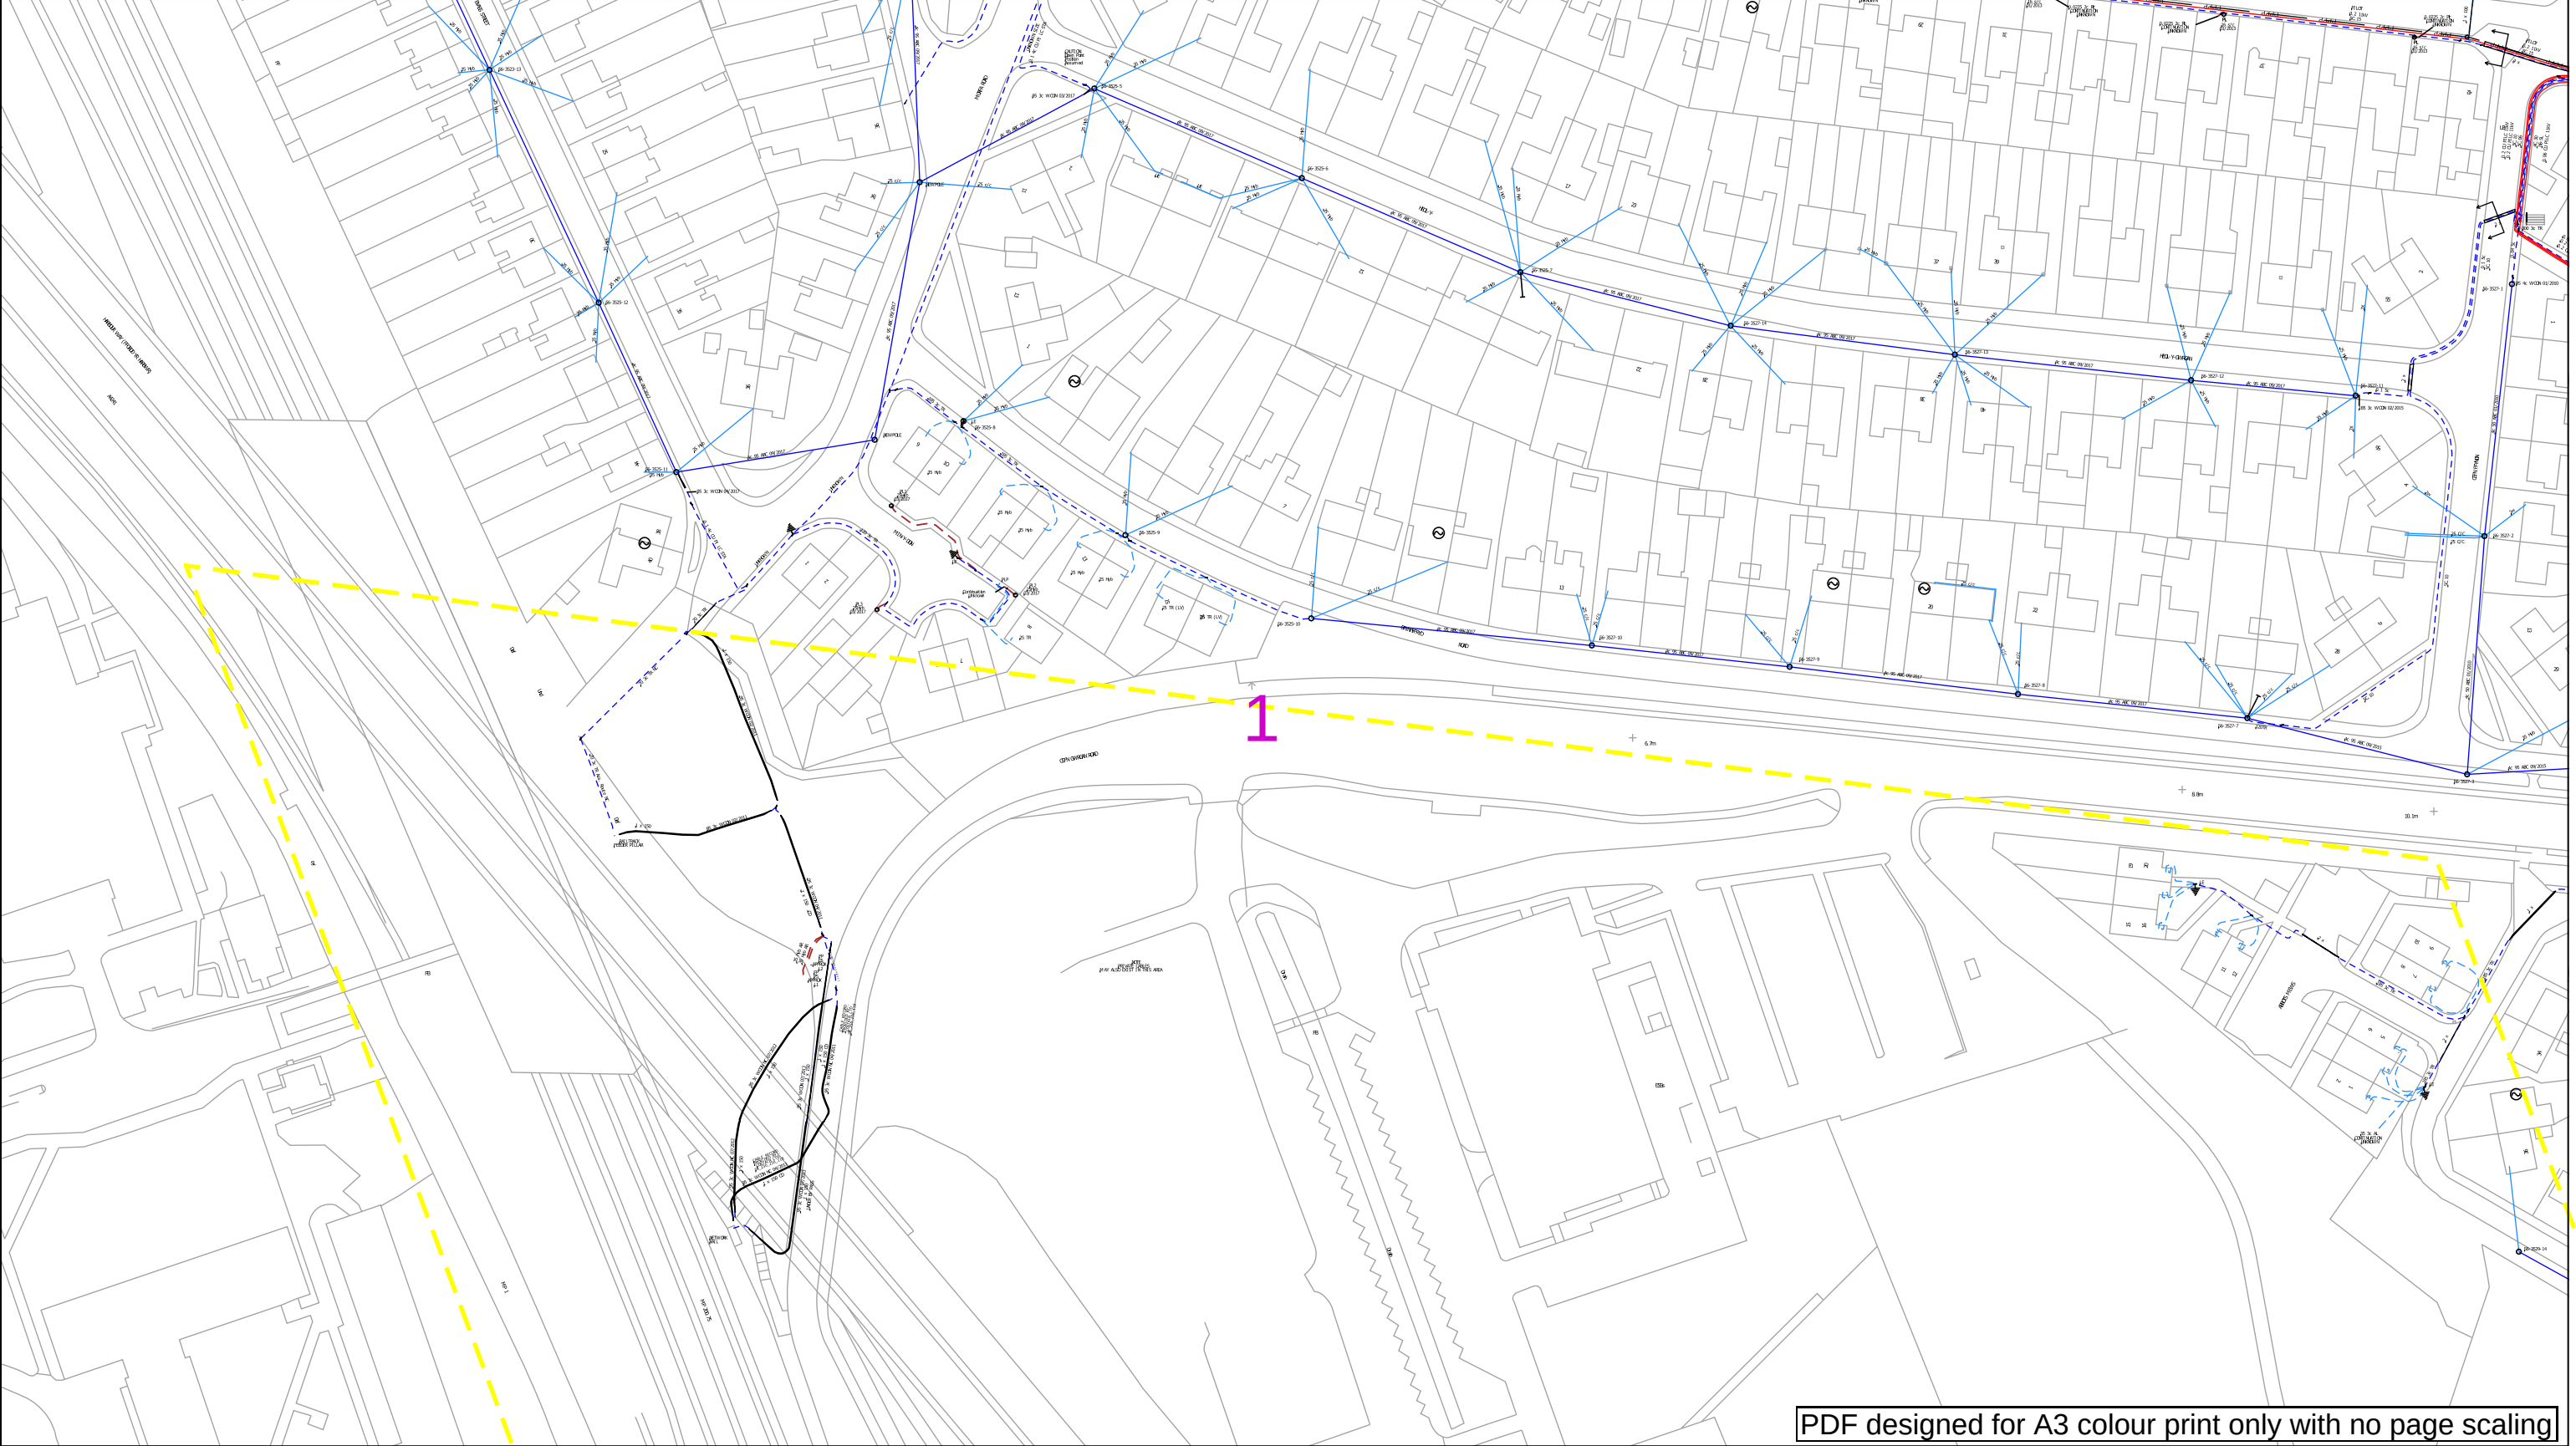

Contact Us

Mapping Enquiries: 0121 623 9780

General Enquiries: 0800 096 3080

Date Requested: 24/11/2023

Job Reference: 31654782

Site Location: 278649 186231

Requested by:

Mr Farhan Aslam

Your Scheme/Reference: NG TATA Steel Margam FEED

Scale: 1:1250 (When plotted at A3)

IMPORTANT NOTICES

- This information is given as a guide only and its accuracy cannot be guaranteed. Services or recent additions to the network may not be shown.
- Cables, overhead lines & substations owned by other electricity network owners or private companies may be present and may not be shown.
- You should always verify exact locations of cables using a cable locator and by careful use of hand tools in accordance with HSE guidance note HSG47.
- When working within 10m of any overhead electric line you should follow the requirements of HSE Guidance Note GS6.
- For further advice on working near our electricity cables or lines, call our Contact Centre on 0800 096 3080.
- Advice should be sought from the National Grid Electricity Distribution Contact Centre for any work that is to take place in proximity to 66kV or 132kV underground cables and 66kV 132kV overhead lines – 0800 096 3080


0 100m

Link Box	Overhead Line	Underground Cable	National Grid Telecoms	Pilot Cables
●	— PL	—	— S — S —	— P — P —
	— Service	—		
Site Location	— LV		Private Cables	
Line/Area	— HV (11kV)		— PME Earth	
—	— HV (33kV)		— Underground Earth	
—	— HV (66kV)			
—	— HV (132kV)			

Report damage immediately KEEP EVERYONE AWAY FROM THE AREA

0800 6783 105

Email: NGED.MapResponse@NationalGrid.co.uk

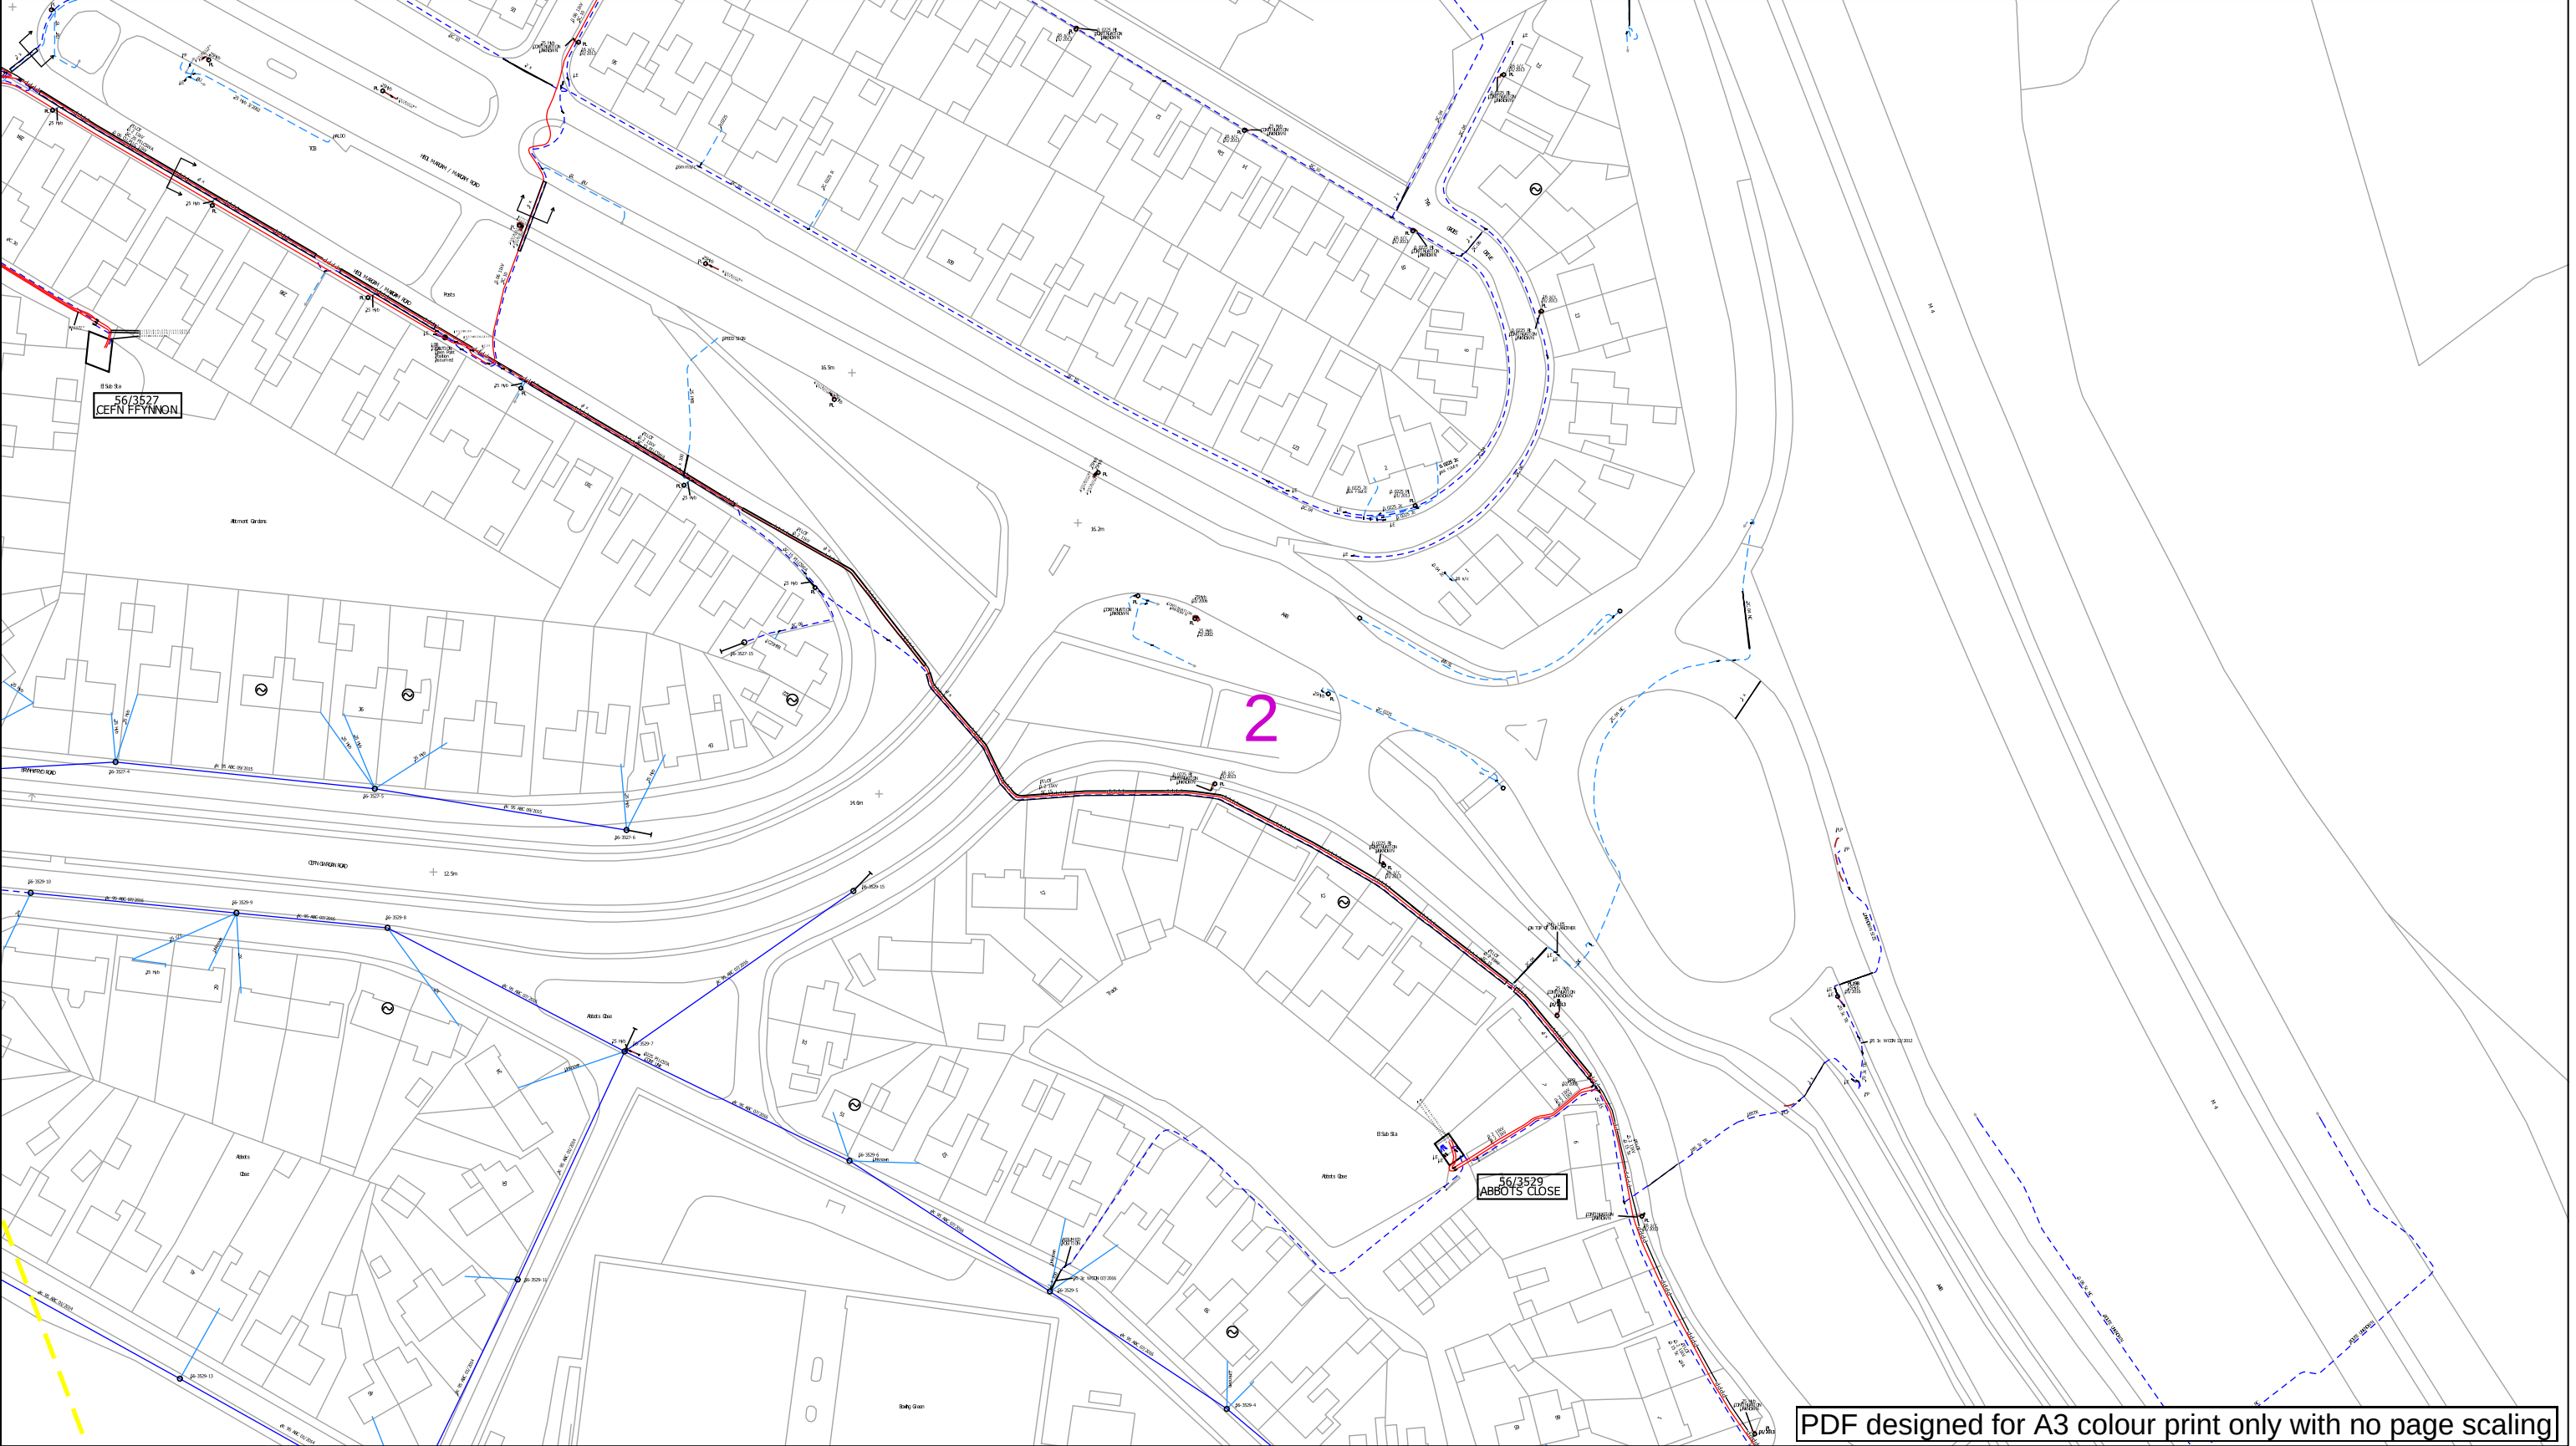

PDF designed for A3 colour print only with no page scaling

Contact Us

Mapping Enquiries: 0121 623 9780

General Enquiries: 0800 096 3080

Date Requested: 24/11/2023

Job Reference: 31654782

Site Location: 278649 186231

Requested by:
Mr Farhan Aslam

Your Scheme/Reference: NG TATA Steel Margam FEED

Scale: 1:1250 (When plotted at A3)

IMPORTANT NOTICES

- This information is given as a guide only and its accuracy cannot be guaranteed. Services or recent additions to the network may not be shown.
- Cables, overhead lines & substations owned by other electricity network owners or private companies may be present and may not be shown.
- You should always verify exact locations of cables using a cable locator and by careful use of hand tools in accordance with HSE guidance note HSG47.
- When working within 10m of any overhead electric line you should follow the requirements of HSE Guidance Note GS6.
- For further advice on working near our electricity cables or lines, call our Contact Centre on 0800 096 3080.
- Advice should be sought from the National Grid Electricity Distribution Contact Centre for any work that is to take place in proximity to 66kV or 132kV underground cables and 66kV 132kV overhead lines – 0800 096 3080


0 100m

Link Box	Overhead Line	Underground Cable	National Grid Telecoms	Pilot Cables
●	— PL	—	— S — S —	— P — P —
	— Service	—		
Site Location	— LV		Private Cables	Pole Mounted Transformer
Line/Area	— HV (11kV)	—	— PME Earth	○
—	— HV (33kV)	—	— Underground Earth	□
—	— HV (66kV)	—		Ground Mounted Transformer
—	— HV (132kV)	—		

Report damage immediately KEEP EVERYONE AWAY FROM THE AREA

0800 6783 105

Email: NGED.MapResponse@NationalGrid.co.uk

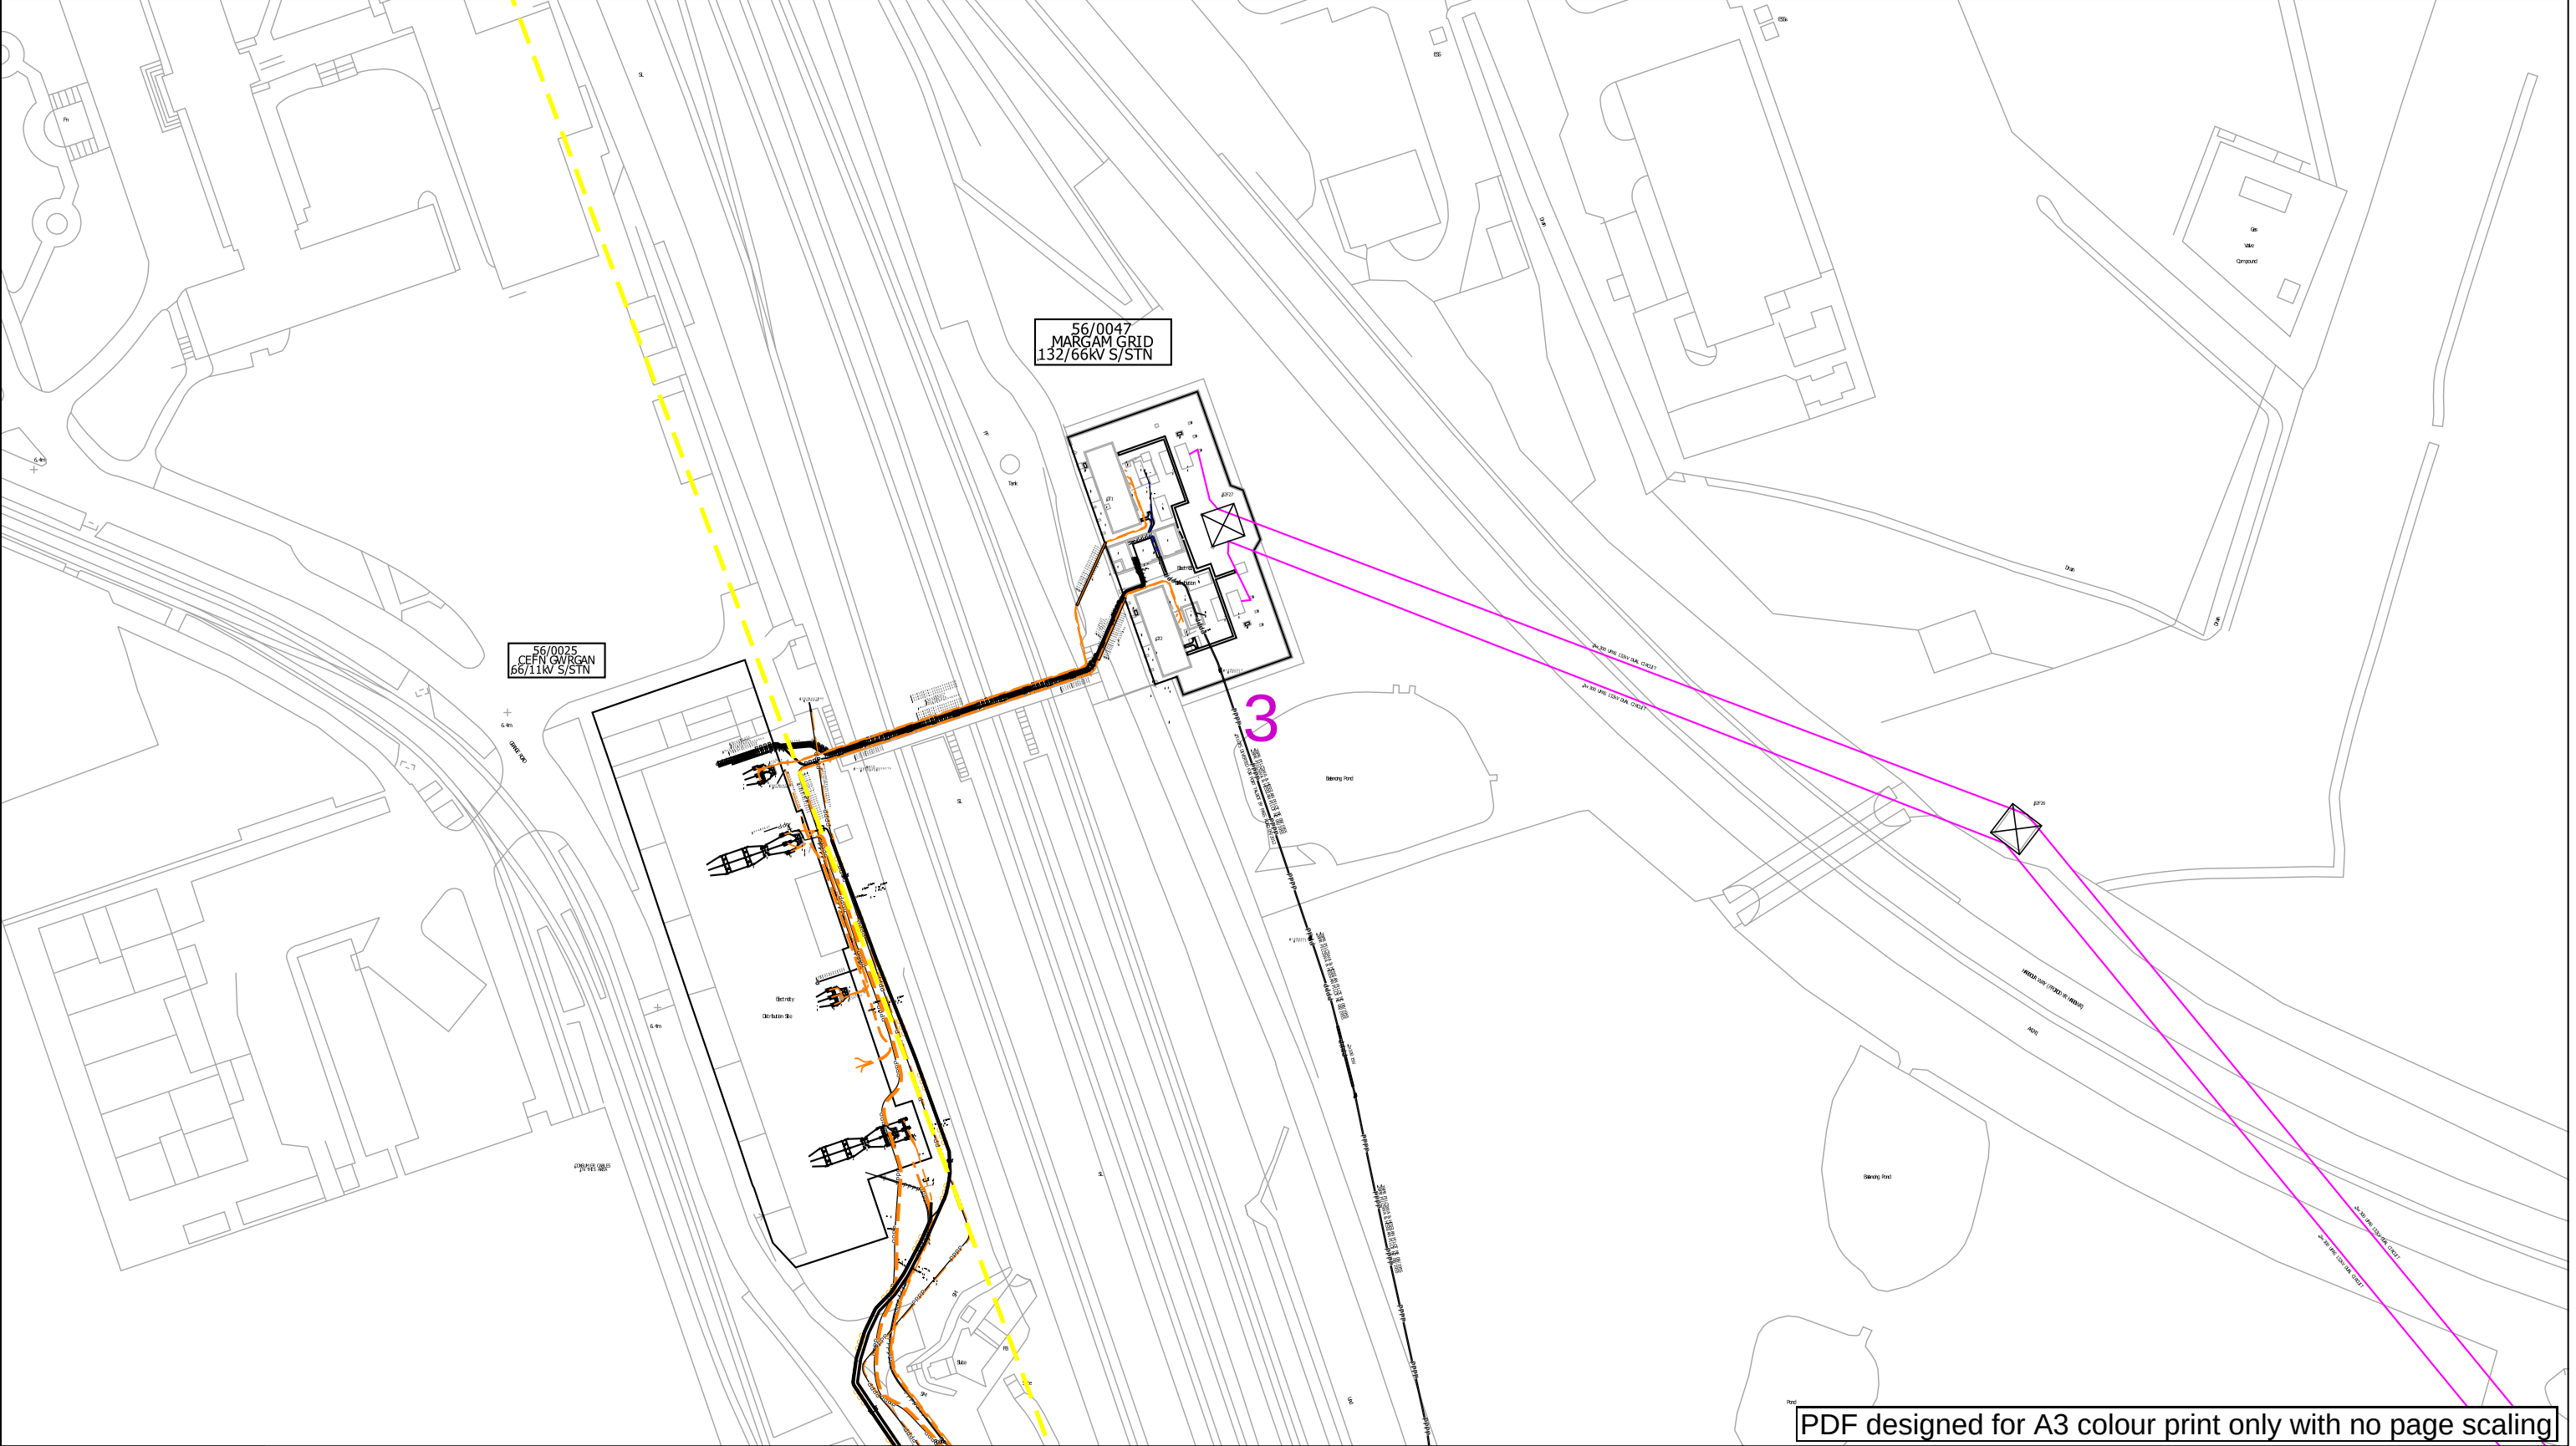

PDF designed for A3 colour print only with no page scaling

Contact Us

Mapping Enquiries: 0121 623 9780

General Enquiries: 0800 096 3080

Date Requested: 24/11/2023

Job Reference: 31654782

Site Location: 278649 186231

Requested by:

Mr Farhan Aslam

Your Scheme/Reference: NG TATA Steel Margam FEED

Scale: 1:1250 (When plotted at A3)

IMPORTANT NOTICES

- This information is given as a guide only and its accuracy cannot be guaranteed. Services or recent additions to the network may not be shown.
- Cables, overhead lines & substations owned by other electricity network owners or private companies may be present and may not be shown.
- You should always verify exact locations of cables using a cable locator and by careful use of hand tools in accordance with HSE guidance note HSG47.
- When working within 10m of any overhead electric line you should follow the requirements of HSE Guidance Note GS6.
- For further advice on working near our electricity cables or lines, call our Contact Centre on 0800 096 3080.
- Advice should be sought from the National Grid Electricity Distribution Contact Centre for any work that is to take place in proximity to 66kV or 132kV underground cables and 66kV 132kV overhead lines – 0800 096 3080

Report damage immediately KEEP EVERYONE AWAY FROM THE AREA


0800 6783 105

0 **100m**

Link Box	Overhead Line	Underground Cable	National Grid Telecoms	Pilot Cables
	PL	PL	S S	P P
Site Location	Service	LV	Private Cables	Pole Mounted Transformer
Line/Area	HV (11kV)	HV (33kV)	PME Earth	Ground Mounted Transformer
	HV (66kV)	HV (132kV)	Underground Earth	

0800 6783 105

Email: NGED.MapResponse@NationalGrid.co.uk

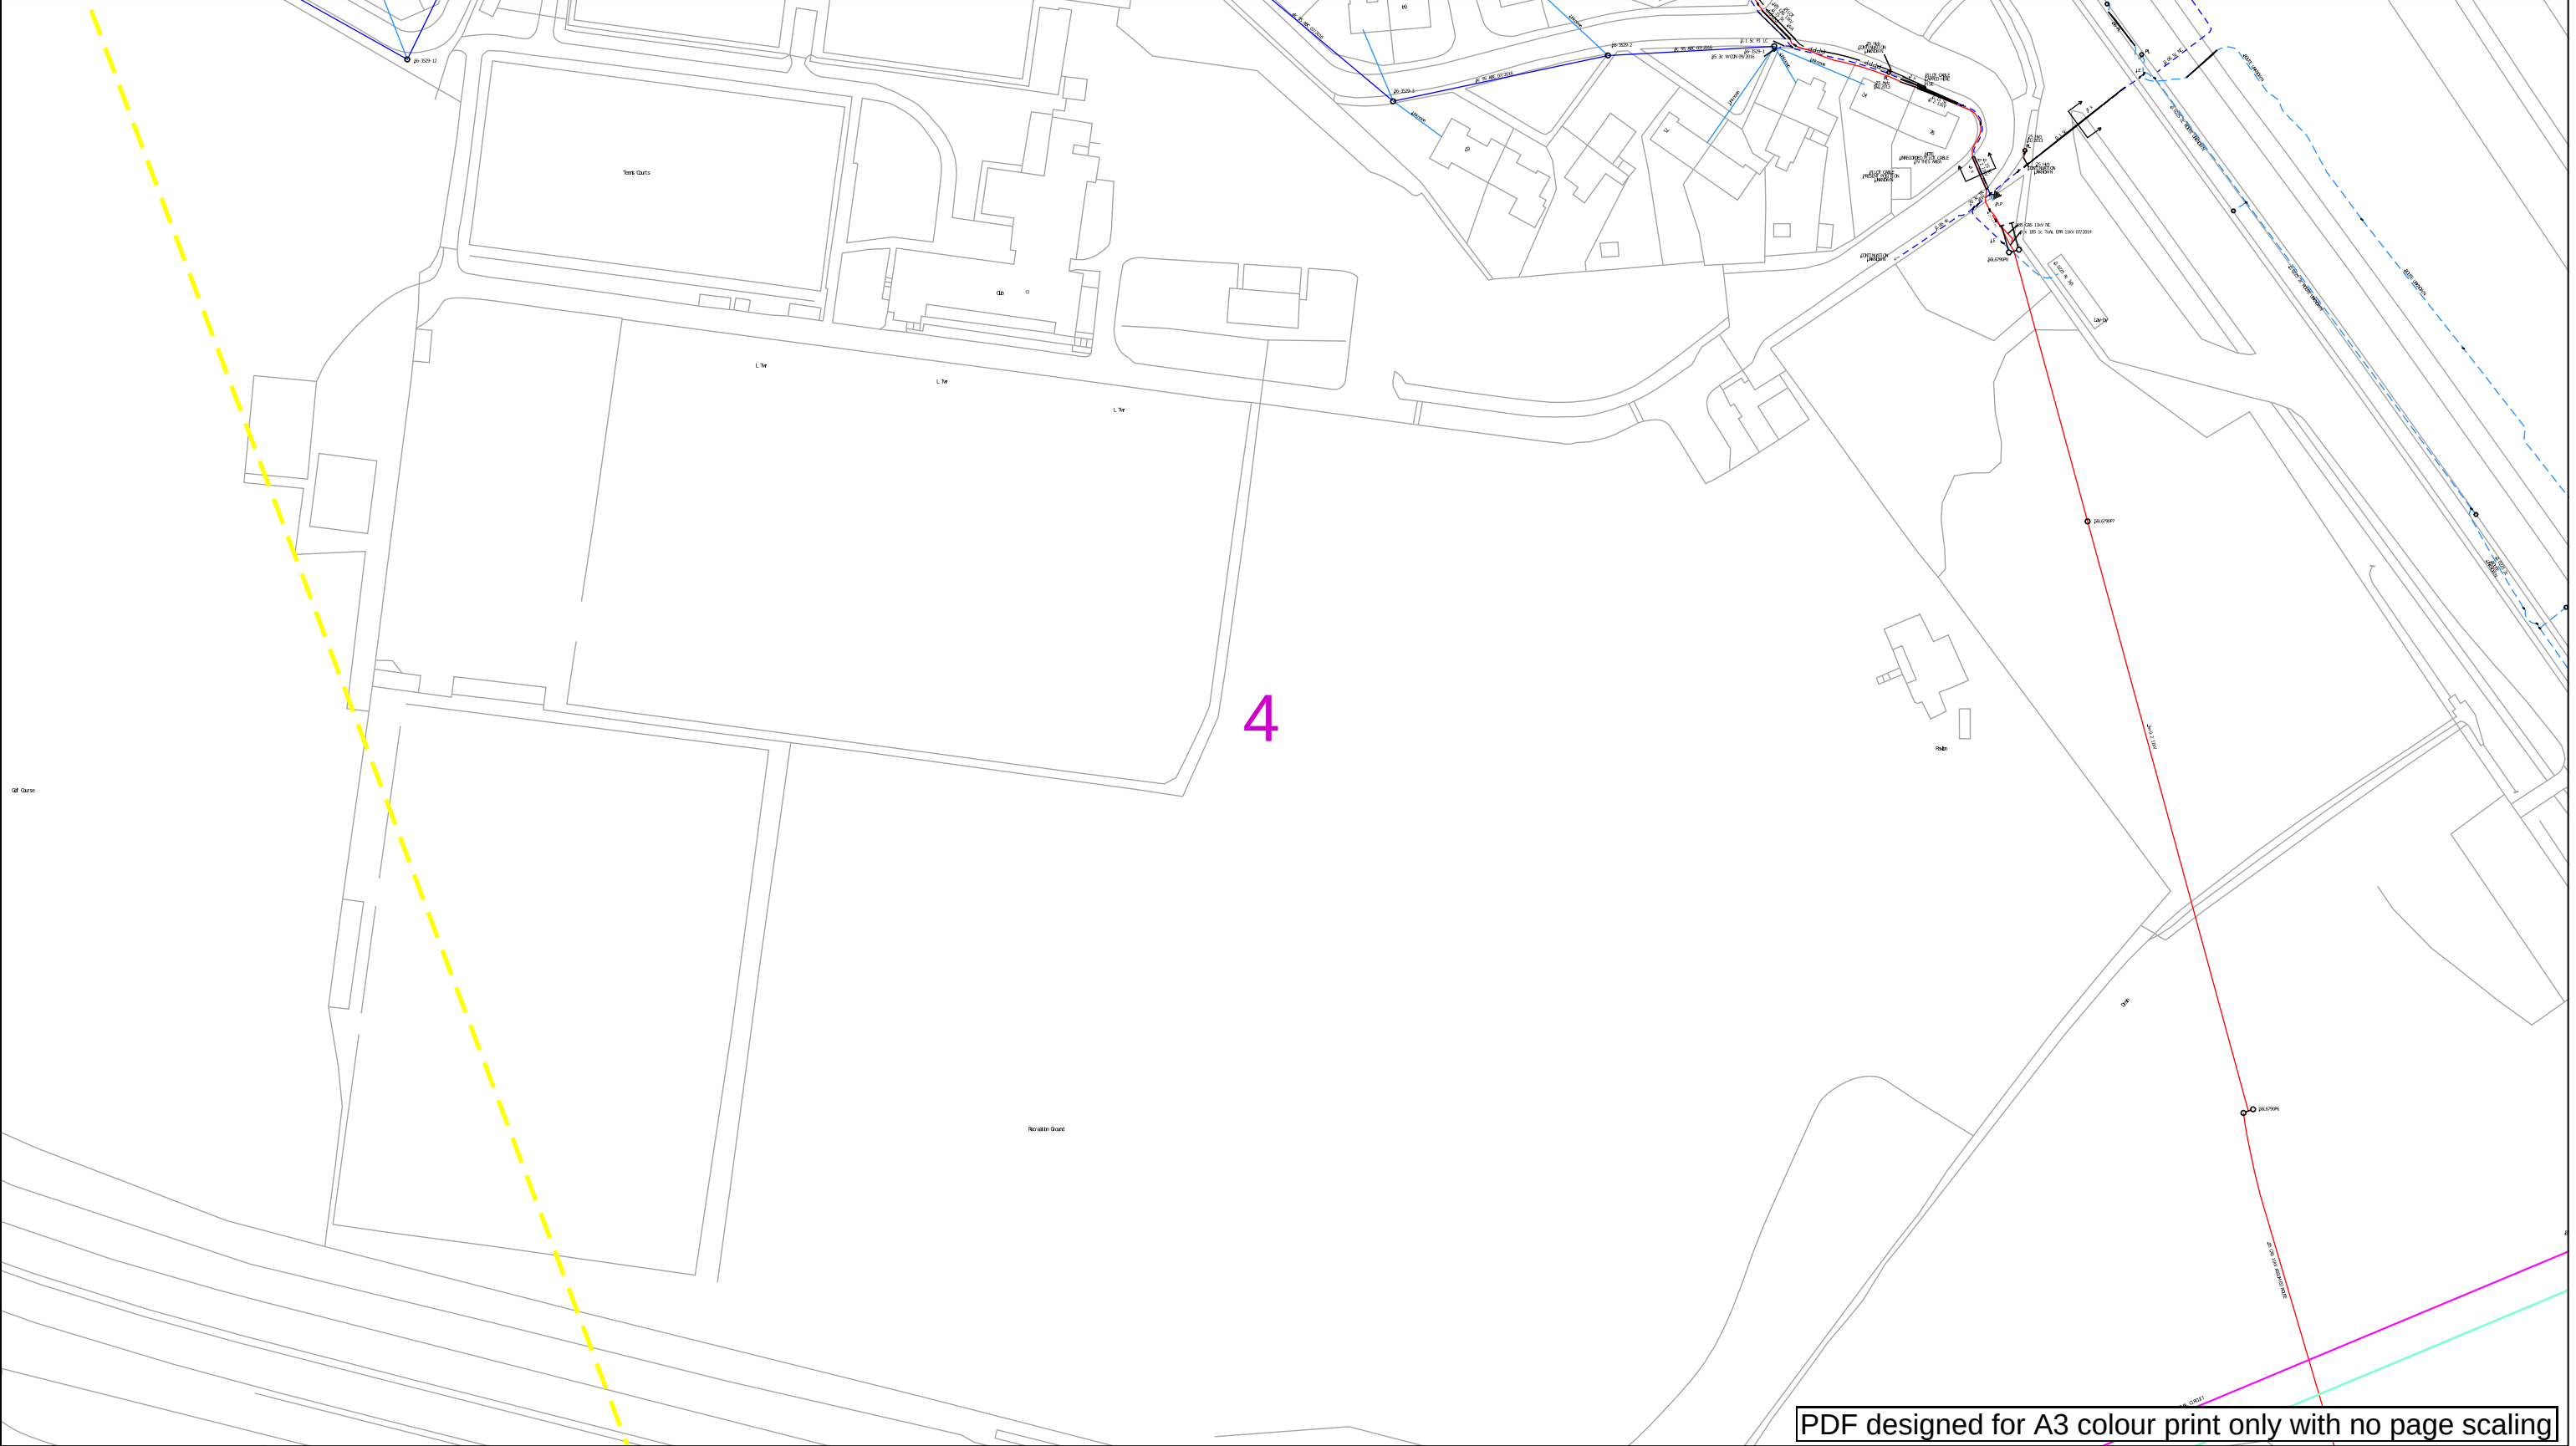

Contact Us

Mapping Enquiries: 0121 623 9780

General Enquiries: 0800 096 3080

Date Requested: 24/11/2023

Job Reference: 31654782

Site Location: 278649 186231

Requested by:

Mr Farhan Aslam

Your Scheme/Reference: NG TATA Steel Margam FEED

Scale: 1:1250 (When plotted at A3)

IMPORTANT NOTICES

- This information is given as a guide only and its accuracy cannot be guaranteed. Services or recent additions to the network may not be shown.
- Cables, overhead lines & substations owned by other electricity network owners or private companies may be present and may not be shown.
- You should always verify exact locations of cables using a cable locator and by careful use of hand tools in accordance with HSE guidance note HSG47.
- When working within 10m of any overhead electric line you should follow the requirements of HSE Guidance Note GS6.
- For further advice on working near our electricity cables or lines, call our Contact Centre on 0800 096 3080.
- Advice should be sought from the National Grid Electricity Distribution Contact Centre for any work that is to take place in proximity to 66kV or 132kV underground cables and 66kV 132kV overhead lines – 0800 096 3080

0 100m

Link Box

●

Site Location

Line/Area

— — — — —

Overhead Line

- PL
- Service
- LV
- HV (11kV)
- HV (33kV)
- HV (66kV)
- HV (132kV)

Underground Cable

- — — — —
- — — — —
- — — — —
- — — — —
- — — — —
- — — — —

National Grid Telecoms

— S — S —

Private Cables

— — — — —

PME Earth

— E —

Underground Earth

— — — — —

Pilot Cables

— P — P —

Pole Mounted Transformer

○

Ground Mounted Transformer

□

Report damage immediately KEEP EVERYONE AWAY FROM THE AREA

0800 6783 105

Email: NGED.MapResponse@NationalGrid.co.uk

Crown Copyright © All Rights Reserved. Ordnance Survey Licence numbers: 100022432. NGED Copyright: This copy has been made by or with the authority of National Grid Electricity Distribution (NGED) pursuant to Section 47 of the Copyright Designs and Patents Act 1988 unless that Act provides a relevant exception to copyright the copy must not be copied without the prior permission of the copyright owner.



PDF designed for A3 colour print only with no page scaling

Contact Us

Mapping Enquiries: 0121 623 9780

General Enquiries: 0800 096 3080

Date Requested: 24/11/2023

Job Reference: 31654782

Site Location: 278649 186231

Requested by:
Mr Farhan Aslam

Your Scheme/Reference: NG TATA Steel Margam FEED

Scale: 1:1250 (When plotted at A3)

IMPORTANT NOTICES

- This information is given as a guide only and its accuracy cannot be guaranteed. Services or recent additions to the network may not be shown.
- Cables, overhead lines & substations owned by other electricity network owners or private companies may be present and may not be shown.
- You should always verify exact locations of cables using a cable locator and by careful use of hand tools in accordance with HSE guidance note HSG47.
- When working within 10m of any overhead electric line you should follow the requirements of HSE Guidance Note GS6.
- For further advice on working near our electricity cables or lines, call our Contact Centre on 0800 096 3080.
- Advice should be sought from the National Grid Electricity Distribution Contact Centre for any work that is to take place in proximity to 66kV or 132kV underground cables and 66kV 132kV overhead lines – 0800 096 3080


0 100m

Link Box	Overhead Line	Underground Cable	National Grid Telecoms	Pilot Cables
●	PL Service LV HV (11kV) HV (33kV) HV (66kV) HV (132kV)	---	S S	P P
Site Location			Private Cables	Pole Mounted Transformer
Line/Area			PME Earth	○
			Underground Earth	□ Ground Mounted Transformer

Report damage immediately KEEP EVERYONE AWAY FROM THE AREA

0800 6783 105

Email: NGED.MapResponse@NationalGrid.co.uk

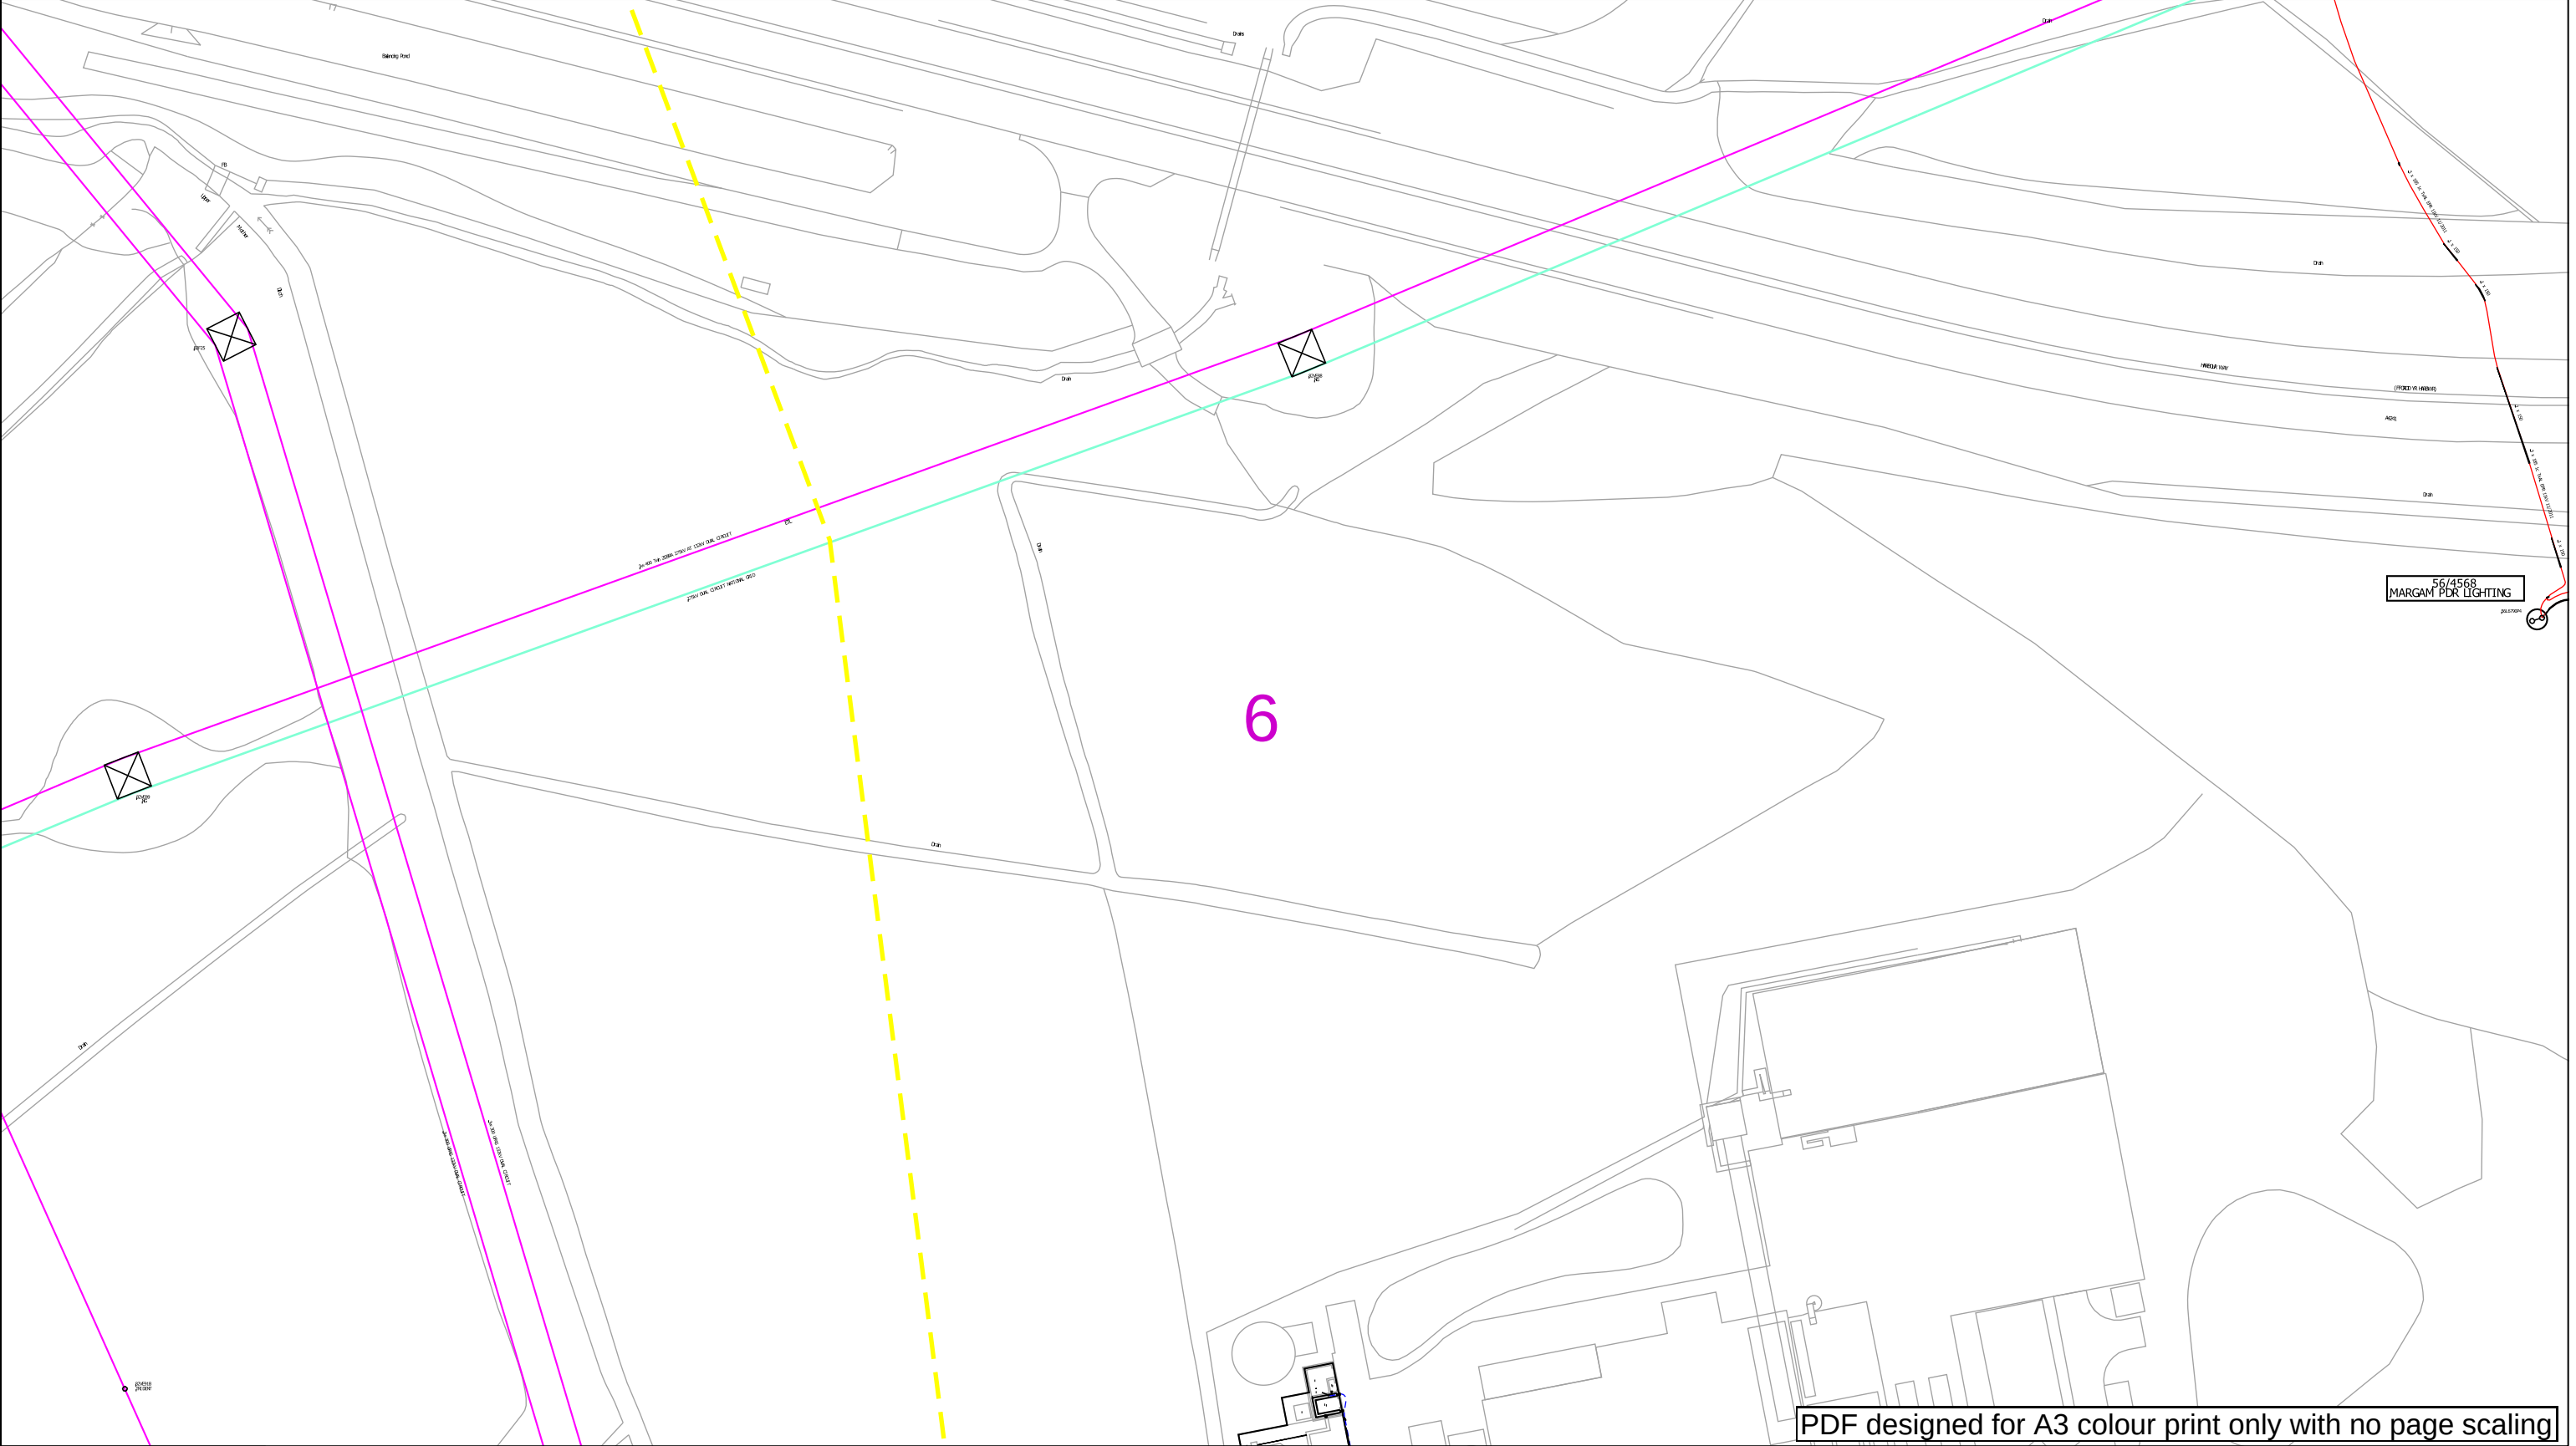

PDF designed for A3 colour print only with no page scaling

Contact Us

Mapping Enquiries: 0121 623 9780

General Enquiries: 0800 096 3080

Date Requested: 24/11/2023

Job Reference: 31654782

Site Location: 278649 186231

Requested by:

Mr Farhan Aslam

Your Scheme/Reference: NG TATA Steel Margam FEED

Scale: 1:1250 (When plotted at A3)

IMPORTANT NOTICES

- This information is given as a guide only and its accuracy cannot be guaranteed. Services or recent additions to the network may not be shown.
- Cables, overhead lines & substations owned by other electricity network owners or private companies may be present and may not be shown.
- You should always verify exact locations of cables using a cable locator and by careful use of hand tools in accordance with HSE guidance note HSG47.
- When working within 10m of any overhead electric line you should follow the requirements of HSE Guidance Note GS6.
- For further advice on working near our electricity cables or lines, call our Contact Centre on 0800 096 3080.
- Advice should be sought from the National Grid Electricity Distribution Contact Centre for any work that is to take place in proximity to 66kV or 132kV underground cables and 66kV 132kV overhead lines – 0800 096 3080


0 100m

Link Box	Overhead Line	Underground Cable	National Grid Telecoms	Pilot Cables
●	—○— PL	— — — — —	— S — S —	— P — P —
	—○— Service	— — — — —		
Site Location	—○— LV		Private Cables	Pole Mounted Transformer
Line/Area	—○— HV (11kV)	— — — — —		
— — — —	—○— HV (33kV)	— — — — —		
	—○— HV (66kV)	— — — — —	PME Earth	Ground Mounted Transformer
	—■— HV (132kV)	— — — — —	Underground Earth	

Report damage immediately KEEP EVERYONE AWAY FROM THE AREA

0800 6783 105

Email: NGED.MapResponse@NationalGrid.co.uk

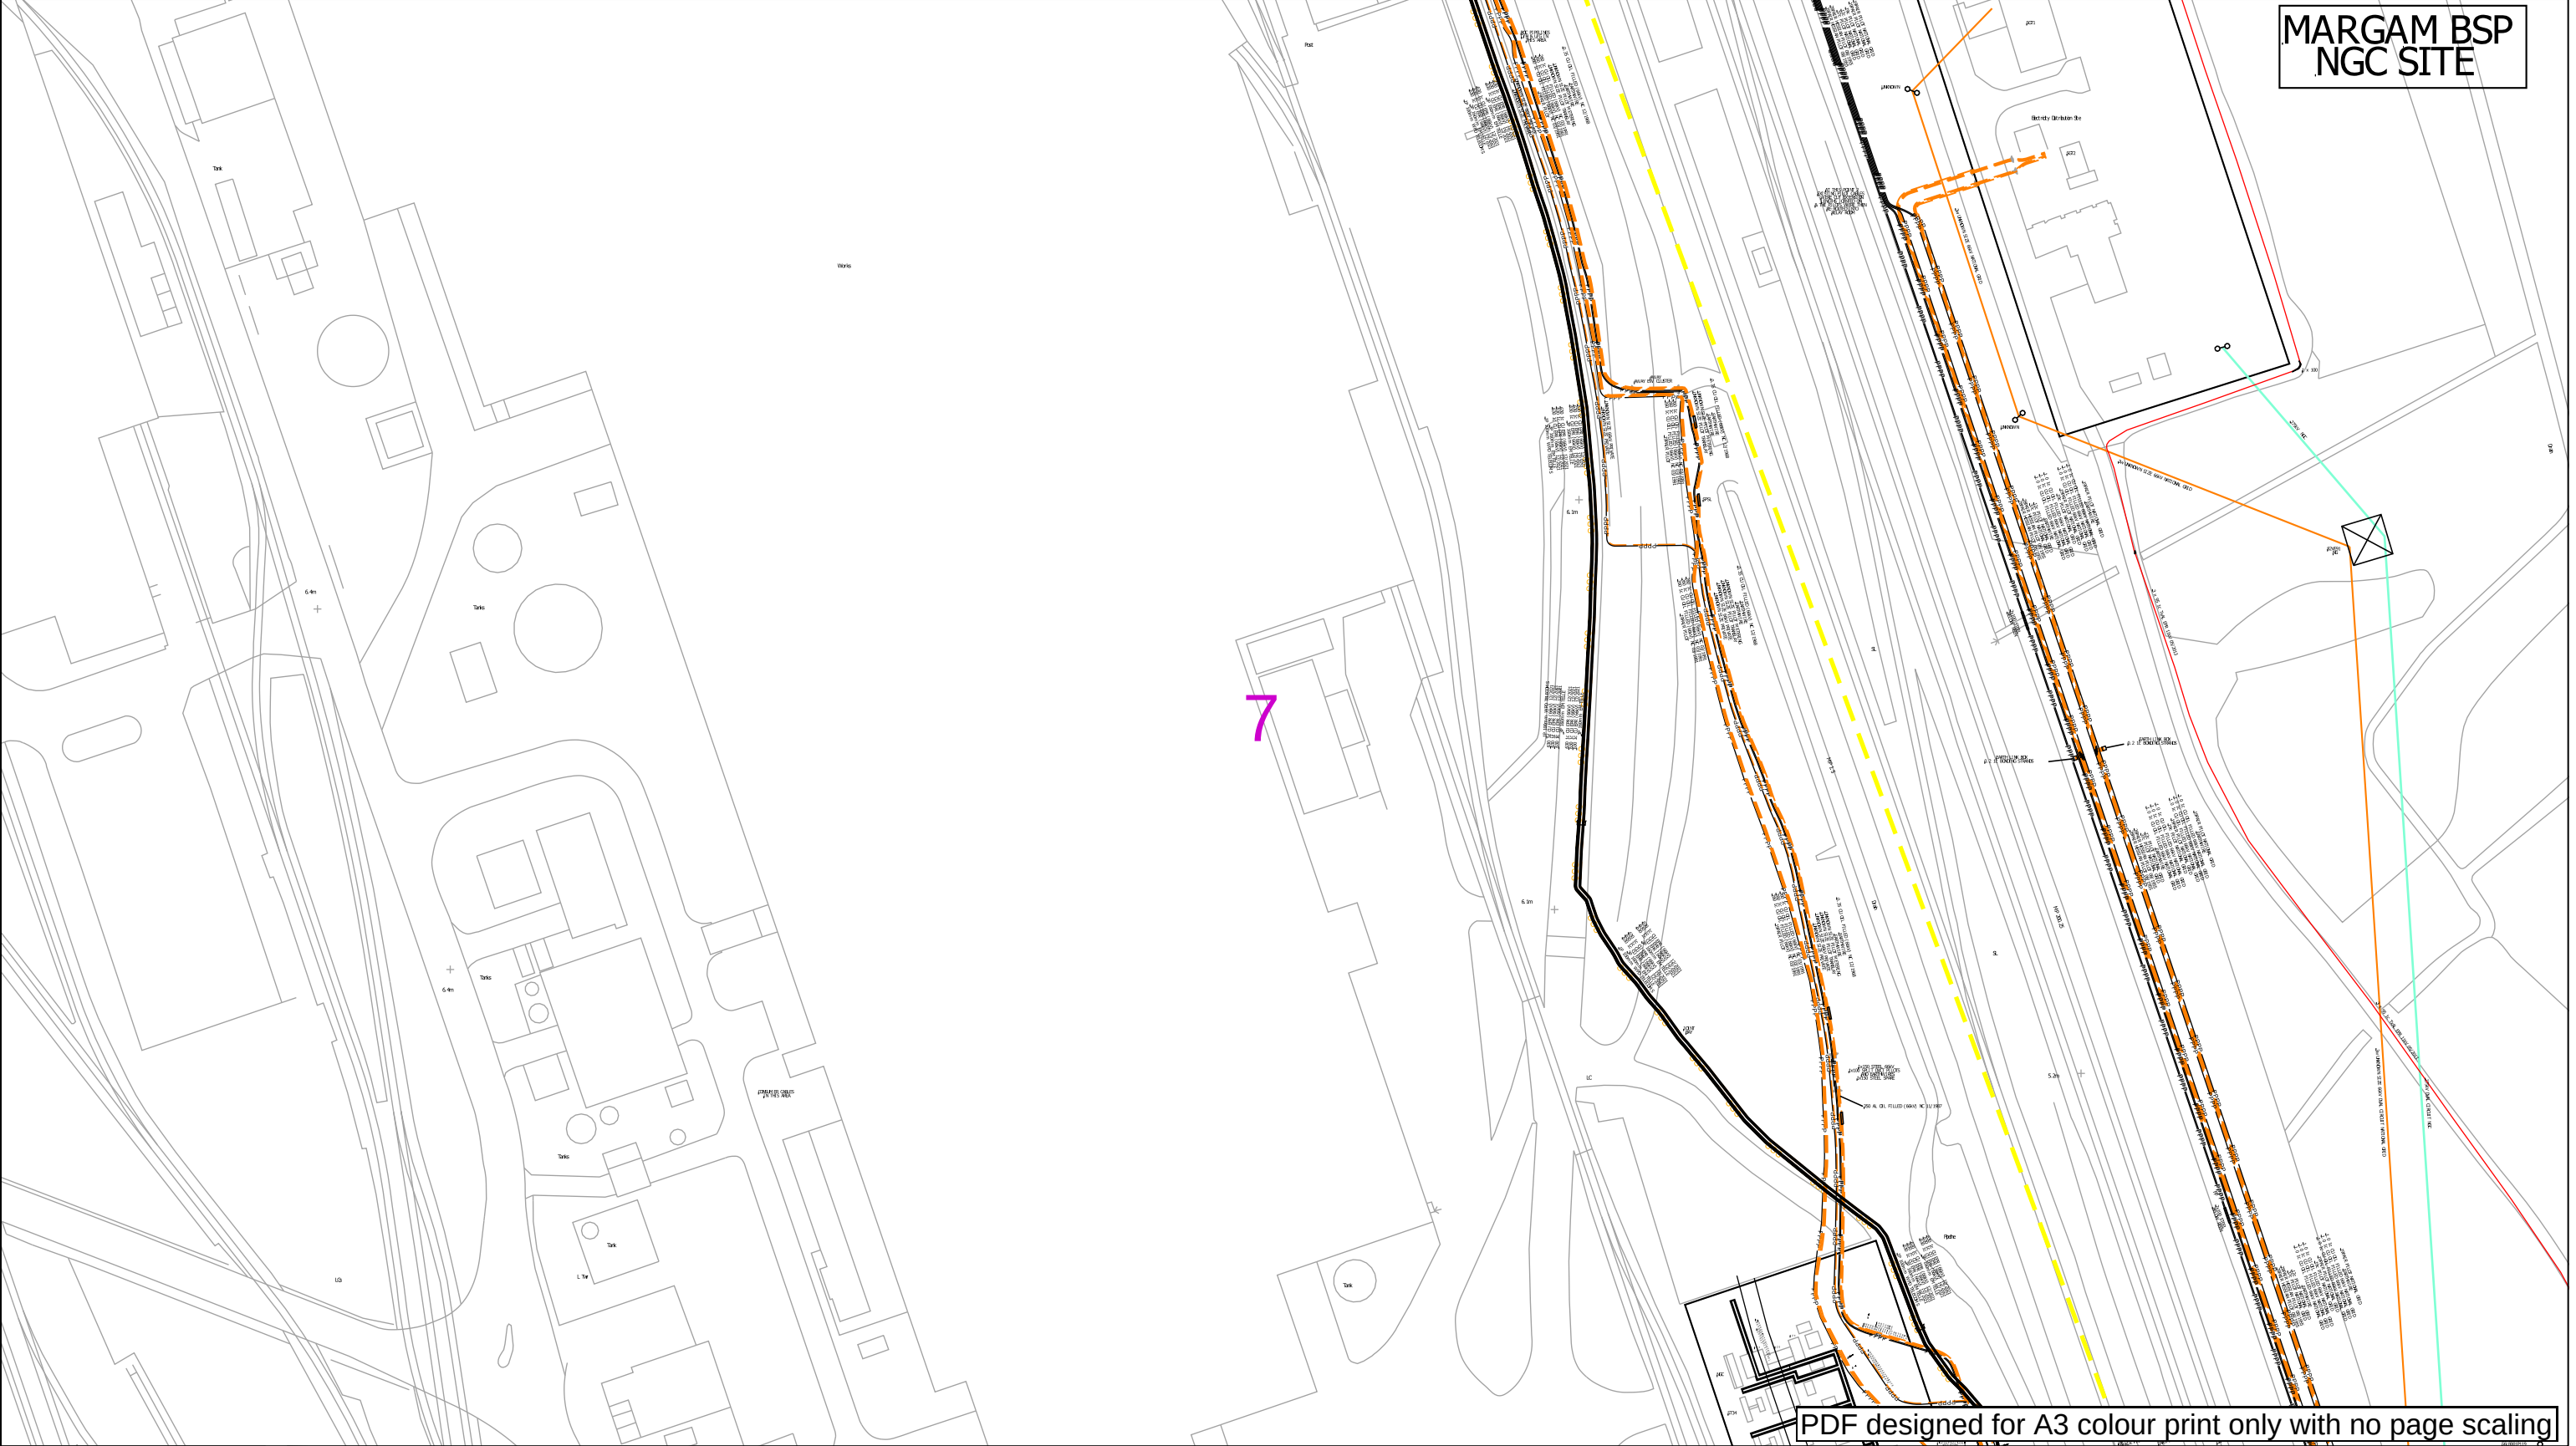

PDF designed for A3 colour print only with no page scaling

Contact Us

Mapping Enquiries: 0121 623 9780

General Enquiries: 0800 096 3080

Date Requested: 24/11/2023
Job Reference: 31654782
Site Location: 278649 186231
Requested by:
Mr Farhan Aslam
Your Scheme/Reference: NG TATA
Steel Margam FEED

Scale: 1:1250 (When plotted at A3)

IMPORTANT NOTICES

- This information is given as a guide only and its accuracy cannot be guaranteed. Services or recent additions to the network may not be shown.
- Cables, overhead lines & substations owned by other electricity network owners or private companies may be present and may not be shown.
- You should always verify exact locations of cables using a cable locator and by careful use of hand tools in accordance with HSE guidance note HSG47.
- When working within 10m of any overhead electric line you should follow the requirements of HSE Guidance Note GS6.
- For further advice on working near our electricity cables or lines, call our Contact Centre on 0800 096 3080.
- Advice should be sought from the National Grid Electricity Distribution Contact Centre for any work that is to take place in proximity to 66kV or 132kV underground cables and 66kV 132kV overhead lines – 0800 096 3080

0100m

Link Box
●
Site Location
Line/Area
| | |

Overhead Line

- PL
- Service
- LV
- HV (11kV)
- HV (33kV)
- HV (66kV)
- HV (132kV)

Underground Cable

-
-
-
-
-
-
-

National Grid Telecoms
S S
Private Cables


PME Earth
Underground Earth

Pilot Cables
P P
Pole Mounted Transformer

Ground Mounted Transformer

Report damage immediately KEEP EVERYONE AWAY FROM THE AREA
0800 6783 105

Email: NGED.MapResponse@NationalGrid.co.uk

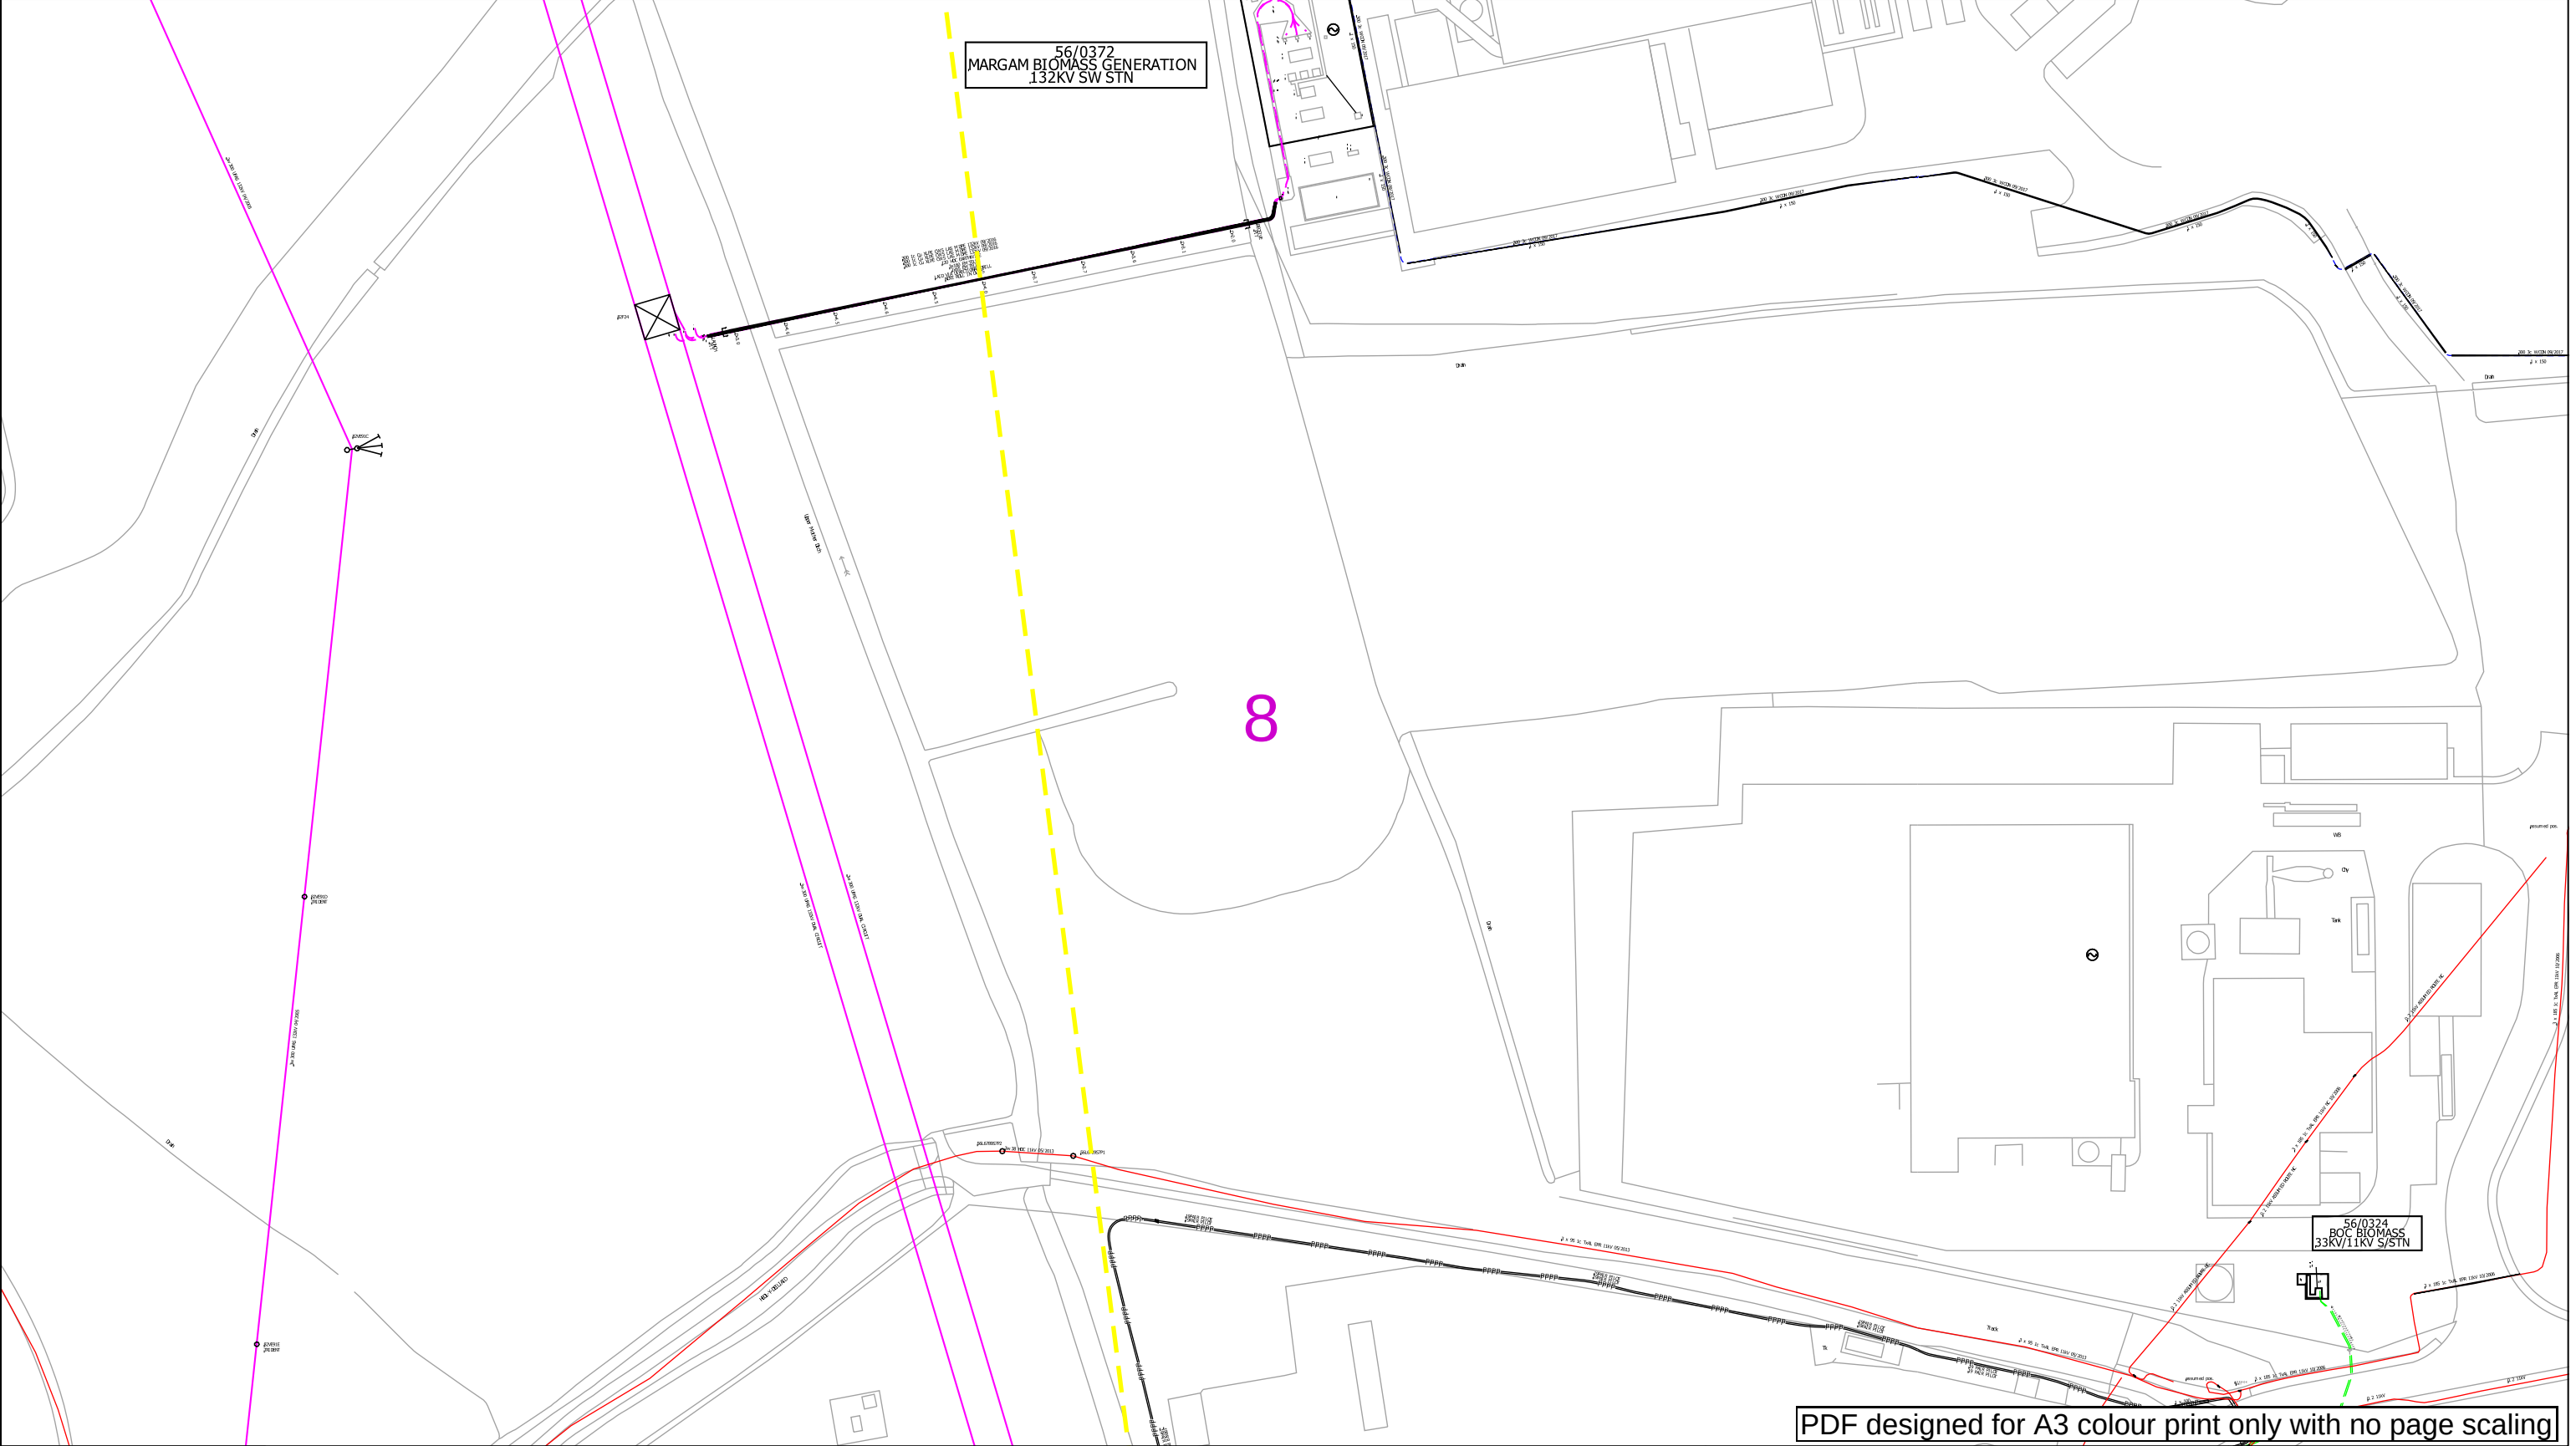

PDF designed for A3 colour print only with no page scaling

Contact Us

Mapping Enquiries: 0121 623 9780

General Enquiries: 0800 096 3080

Date Requested: 24/11/2023

Job Reference: 31654782

Site Location: 278649 186231

Requested by:

Mr Farhan Aslam

Your Scheme/Reference: NG TATA Steel Margam FEED

Scale: 1:1250 (When plotted at A3)

IMPORTANT NOTICES

- This information is given as a guide only and its accuracy cannot be guaranteed. Services or recent additions to the network may not be shown.
- Cables, overhead lines & substations owned by other electricity network owners or private companies may be present and may not be shown.
- You should always verify exact locations of cables using a cable locator and by careful use of hand tools in accordance with HSE guidance note HSG47.
- When working within 10m of any overhead electric line you should follow the requirements of HSE Guidance Note GS6.
- For further advice on working near our electricity cables or lines, call our Contact Centre on 0800 096 3080.
- Advice should be sought from the National Grid Electricity Distribution Contact Centre for any work that is to take place in proximity to 66kV or 132kV underground cables and 66kV 132kV overhead lines – 0800 096 3080


0 100m

Link Box	Overhead Line	Underground Cable	National Grid Telecoms	Pilot Cables
●	— PL	—	— S — S —	— P — P —
	— Service	—		
Site Location	— LV	—	Private Cables	Pole Mounted Transformer
Line/Area	— HV (11kV)	—	— PME Earth	○
—	— HV (33kV)	—	— Underground Earth	□
—	— HV (66kV)	—		Ground Mounted Transformer
—	— HV (132kV)	—		

Report damage immediately KEEP EVERYONE AWAY FROM THE AREA

0800 6783 105

Email: NGED.MapResponse@NationalGrid.co.uk

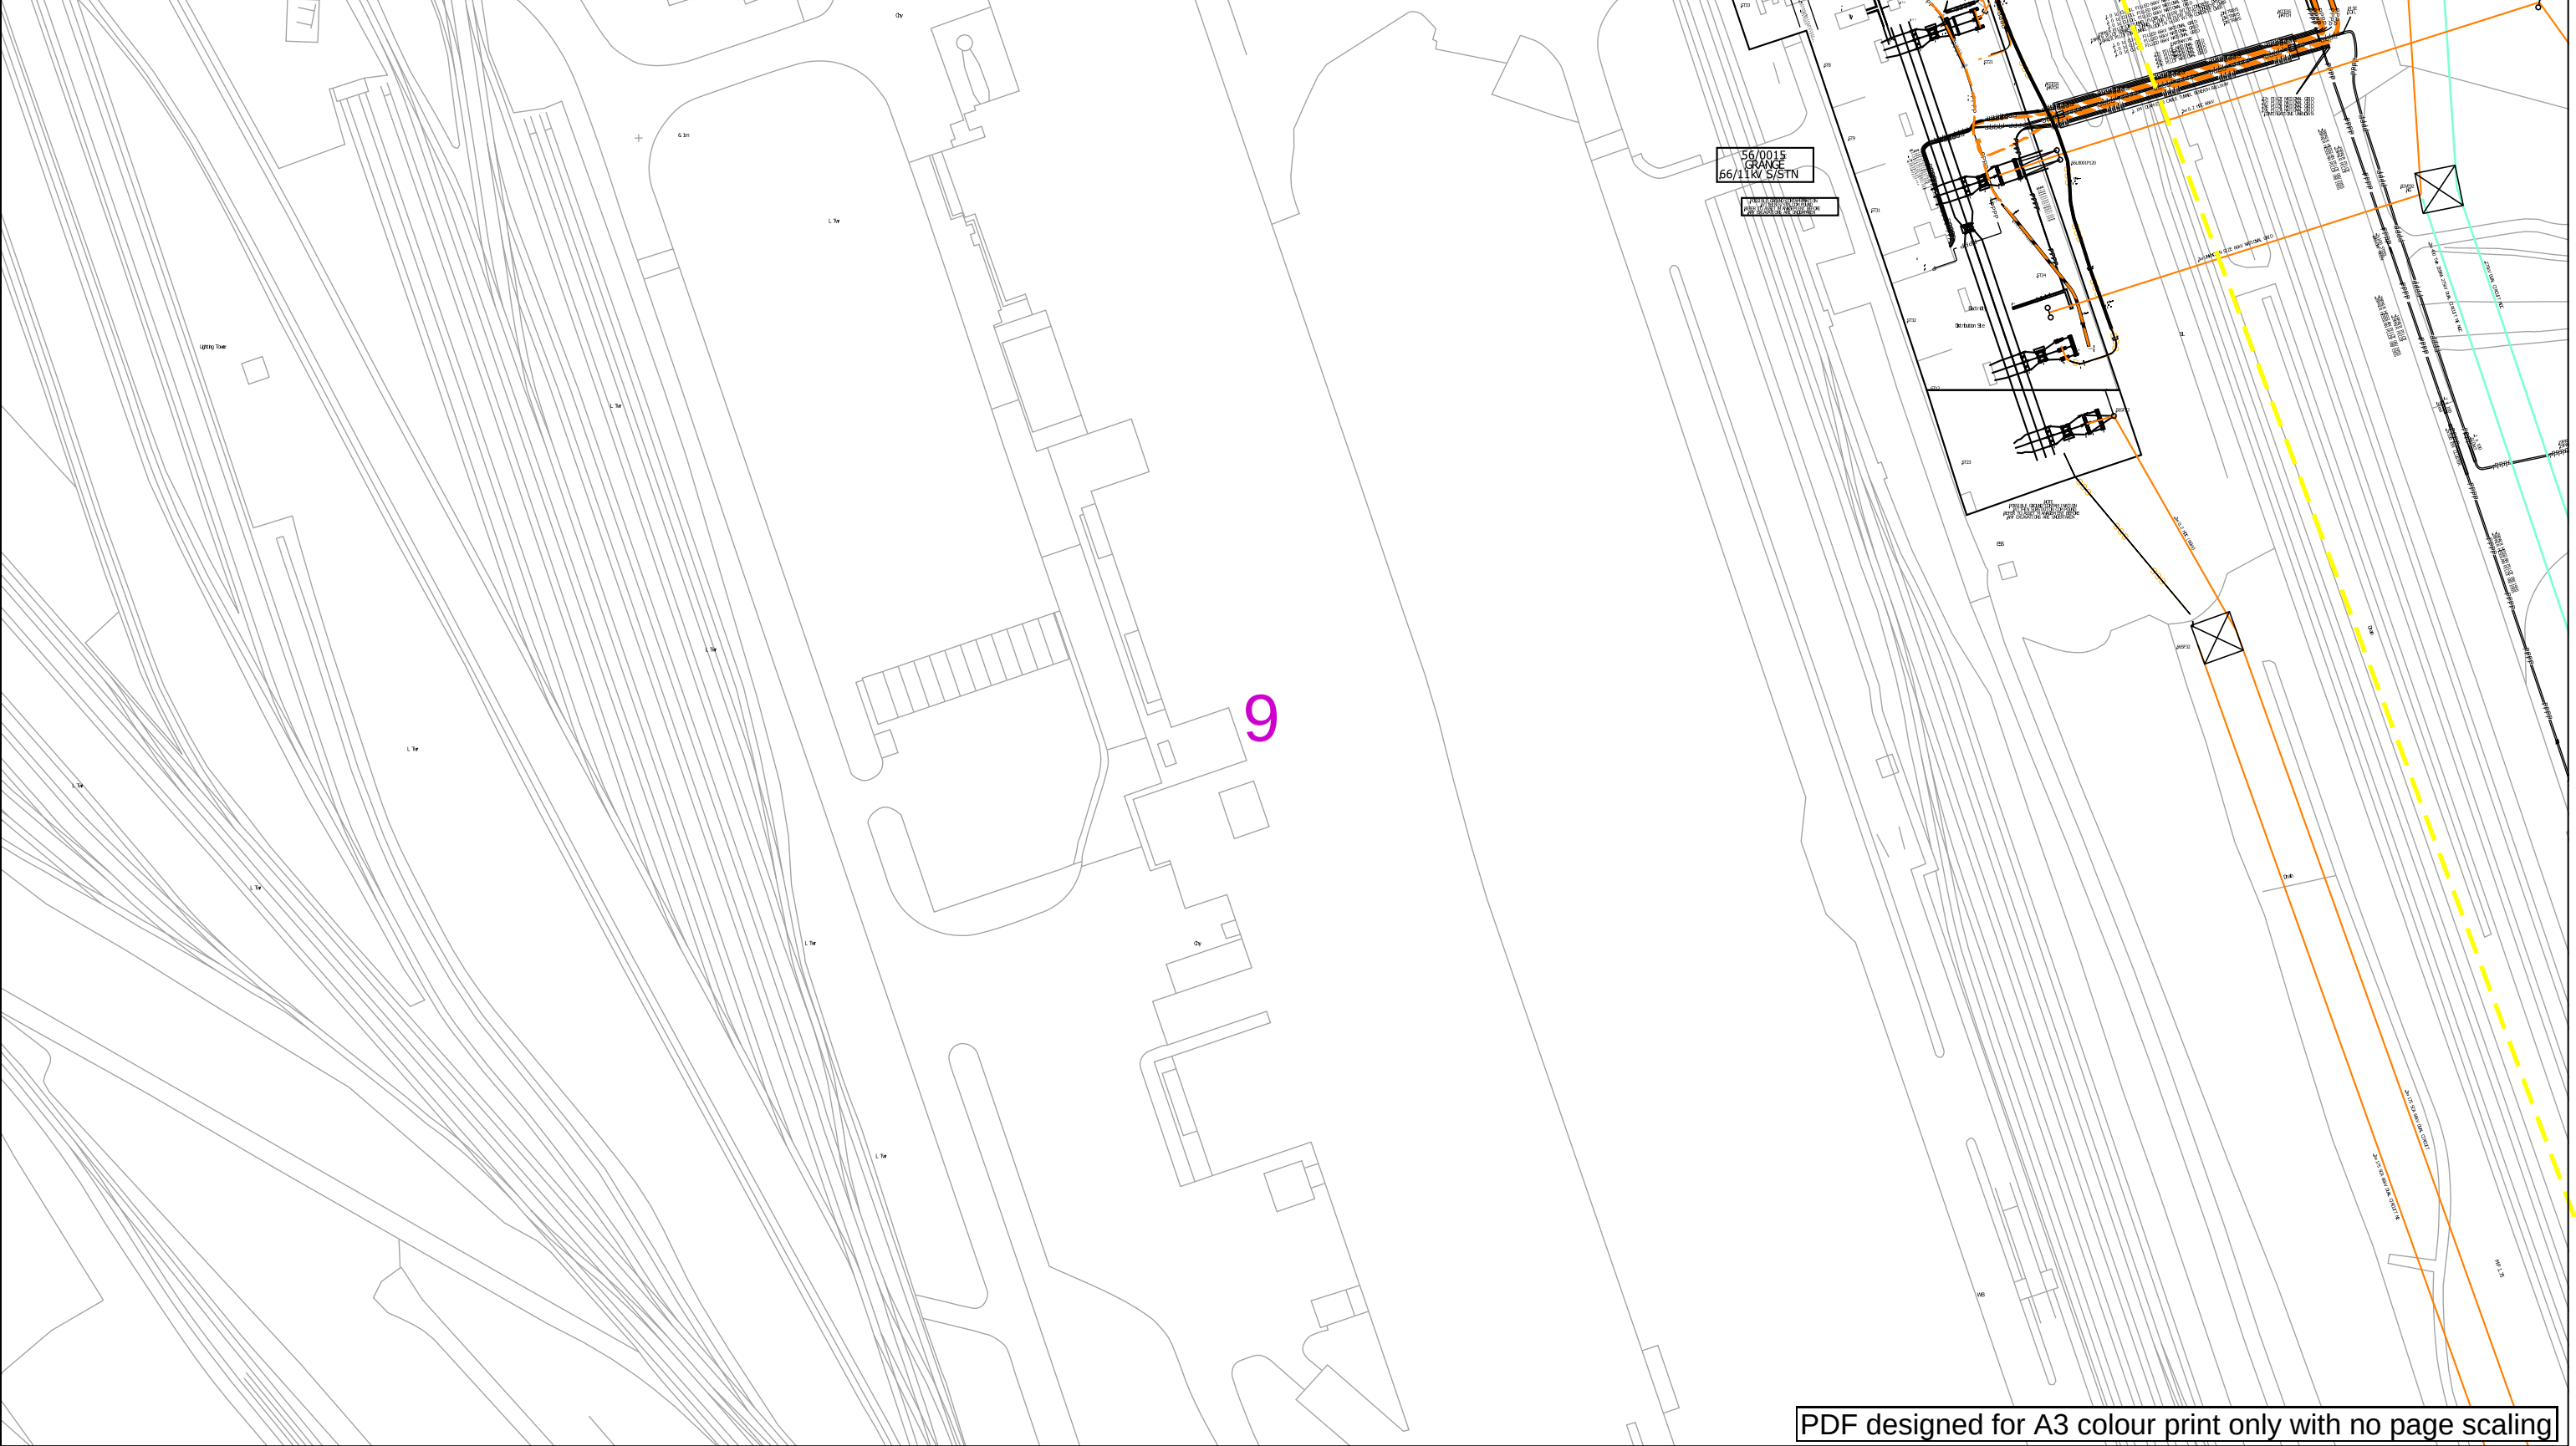

PDF designed for A3 colour print only with no page scaling

Contact Us

Mapping Enquiries: 0121 623 9780

General Enquiries: 0800 096 3080

Date Requested: 24/11/2023

Job Reference: 31654782

Site Location: 278649 186231

Requested by:

Mr Farhan Aslam

Your Scheme/Reference: NG TATA Steel Margam FEED

Scale: 1:1250 (When plotted at A3)

IMPORTANT NOTICES

- This information is given as a guide only and its accuracy cannot be guaranteed. Services or recent additions to the network may not be shown.
- Cables, overhead lines & substations owned by other electricity network owners or private companies may be present and may not be shown.
- You should always verify exact locations of cables using a cable locator and by careful use of hand tools in accordance with HSE guidance note HSG47.
- When working within 10m of any overhead electric line you should follow the requirements of HSE Guidance Note GS6.
- For further advice on working near our electricity cables or lines, call our Contact Centre on 0800 096 3080.
- Advice should be sought from the National Grid Electricity Distribution Contact Centre for any work that is to take place in proximity to 66kV or 132kV underground cables and 66kV 132kV overhead lines – 0800 096 3080


0 100m

Link Box	Overhead Line	Underground Cable	National Grid Telecoms	Pilot Cables
●	—○— PL	— — — — —	—S—S—	—P—P—
	—○— Service	— — — — —		
Site Location	—○— LV		Private Cables	Pole Mounted Transformer
Line/Area	—○— HV (11kV)	— — — — —	— — — — —	—○—
— — — —	—○— HV (33kV)	— — — — —		
	—○— HV (66kV)	— — — — —	PME Earth	Ground Mounted Transformer
	—○— HV (132kV)	— — — — —	—E— — — — —	—□—

Report damage immediately KEEP EVERYONE AWAY FROM THE AREA

0800 6783 105

Email: NGED.MapResponse@NationalGrid.co.uk

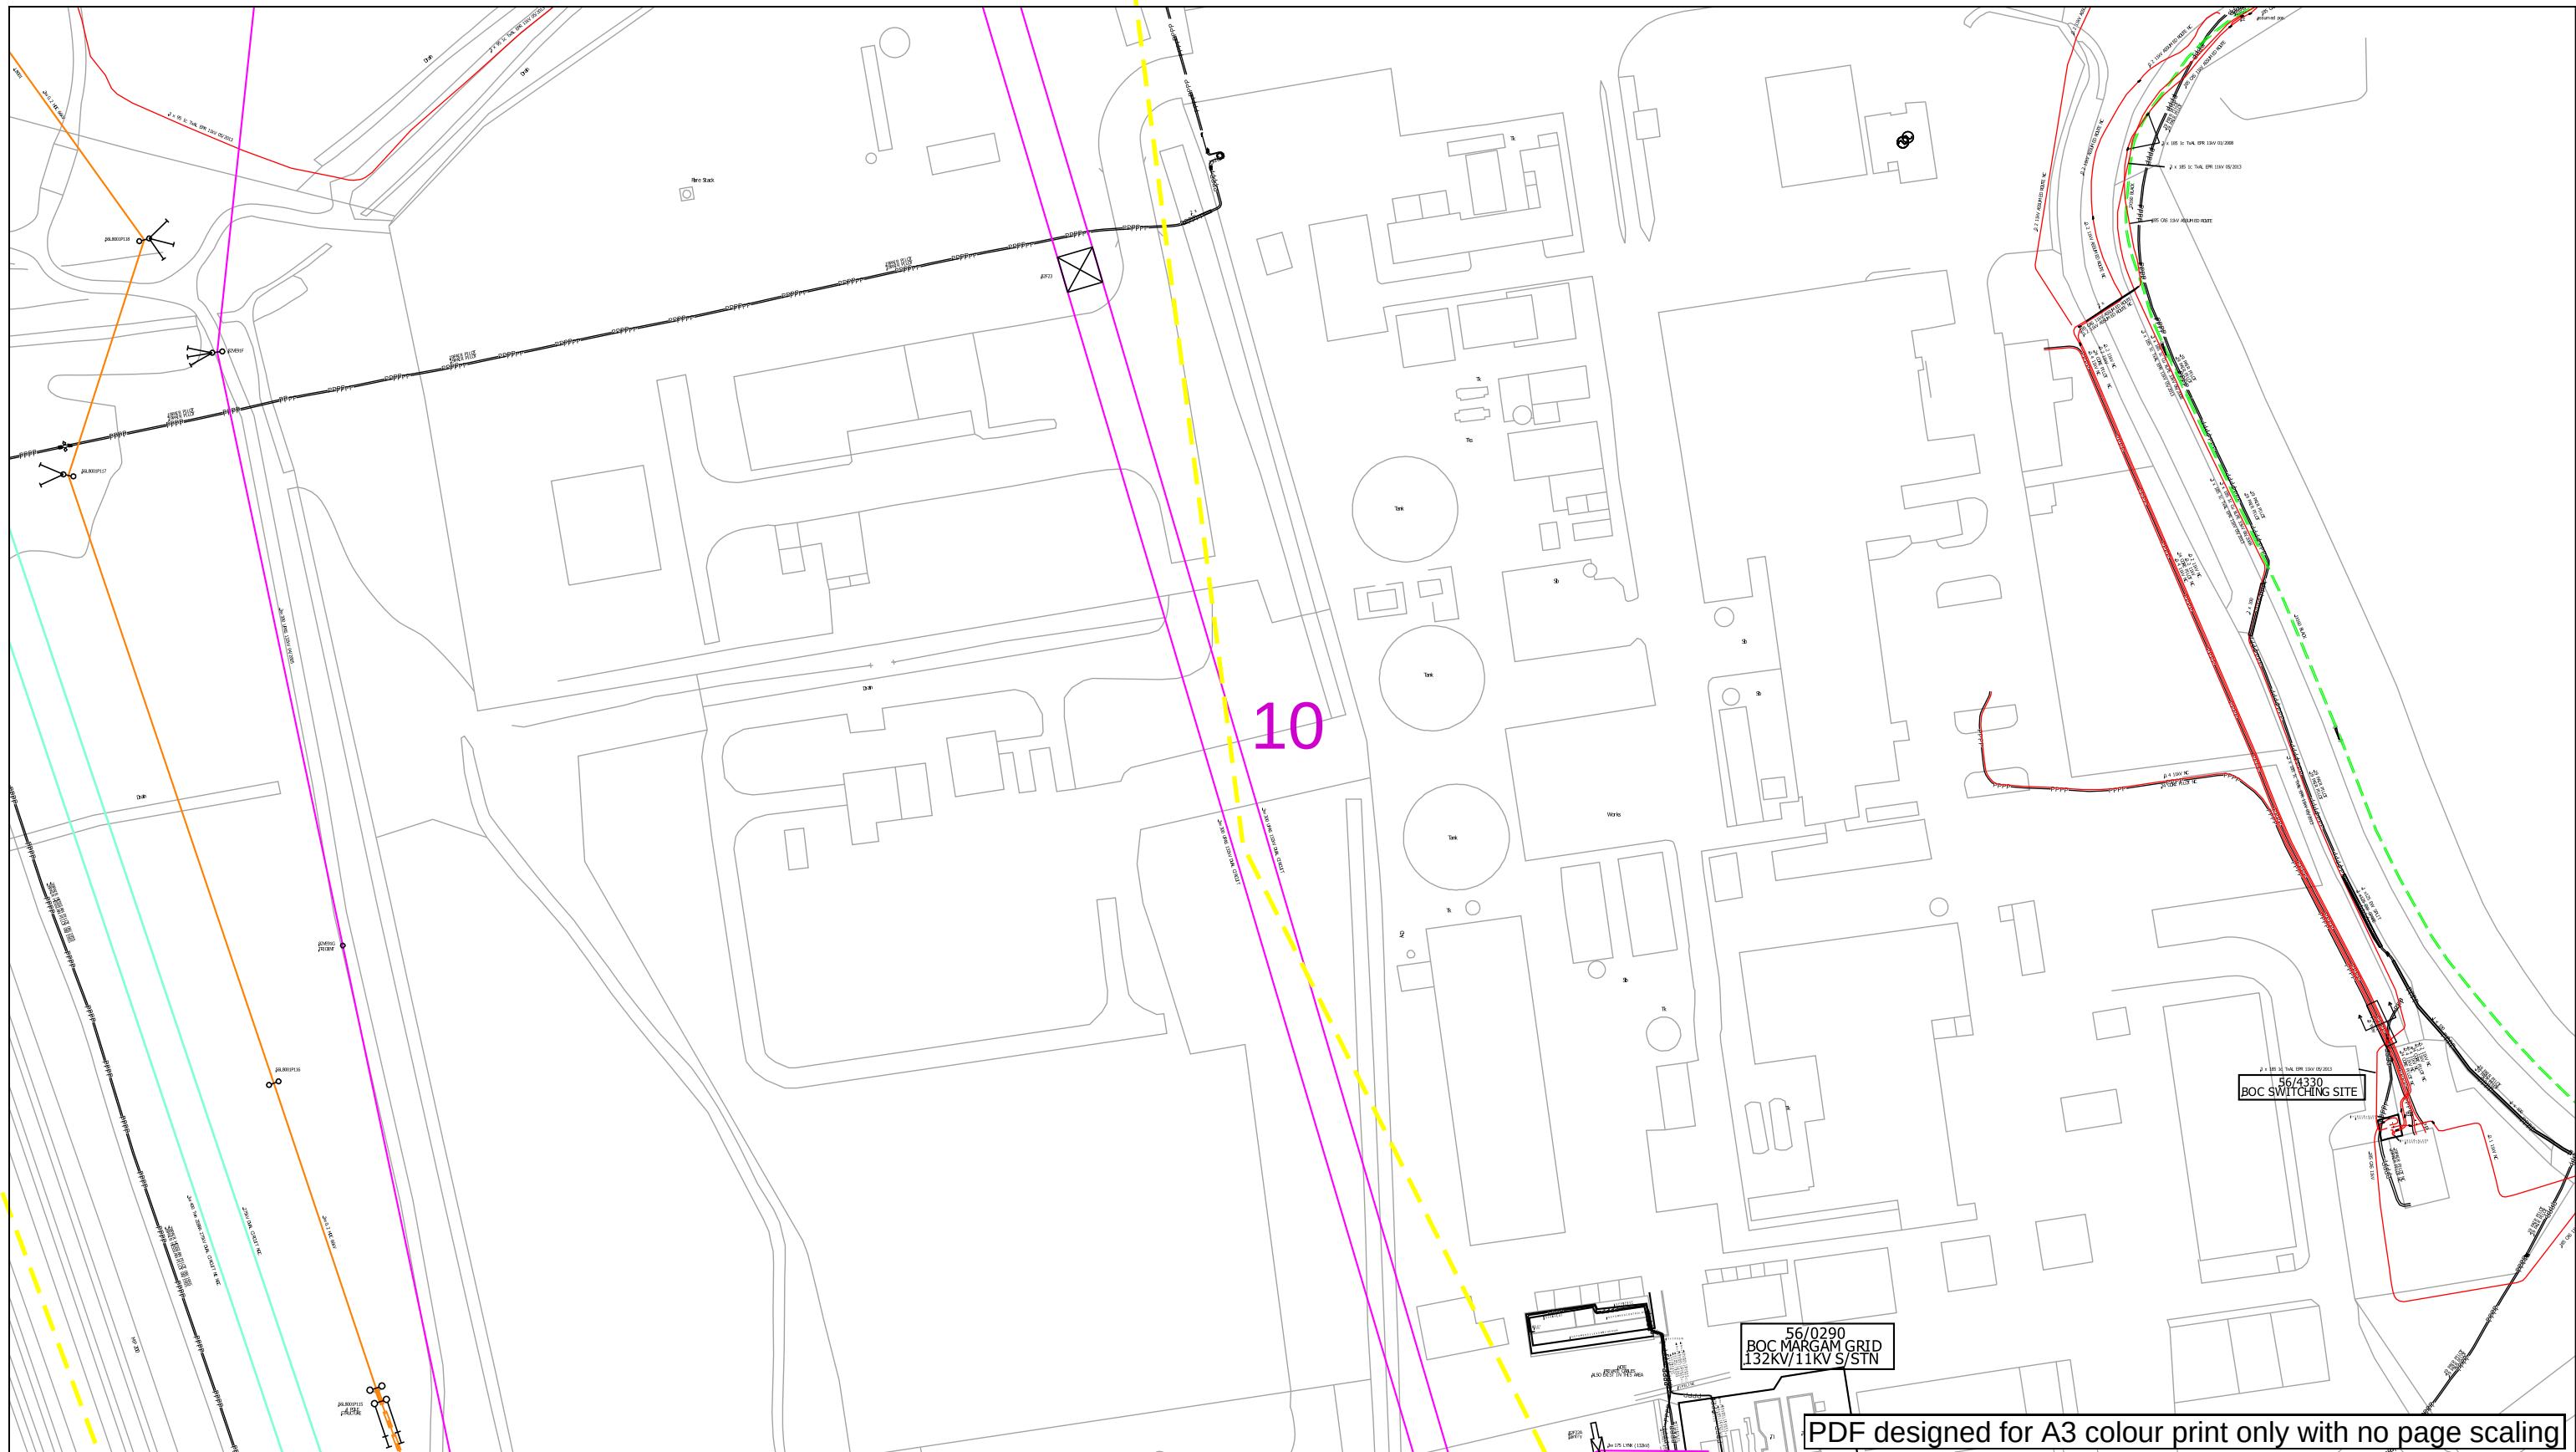

PDF designed for A3 colour print only with no page scaling

Contact Us

Mapping Enquiries: 0121 623 9780

General Enquiries: 0800 096 3080

Date Requested: 24/11/2023

Job Reference: 31654782

Site Location: 278649 186231

Requested by:

Mr Farhan Aslam
Your Scheme/Reference: NG TATA
Steel Margam FEED

Scale: 1:1250 (When plotted at A3)

IMPORTANT NOTICES

- This information is given as a guide only and its accuracy cannot be guaranteed. Services or recent additions to the network may not be shown.
- Cables, overhead lines & substations owned by other electricity network owners or private companies may be present and may not be shown.
- You should always verify exact locations of cables using a cable locator and by careful use of hand tools in accordance with HSE guidance note HSG47.
- When working within 10m of any overhead electric line you should follow the requirements of HSE Guidance Note GS6.
- For further advice on working near our electricity cables or lines, call our Contact Centre on 0800 096 3080.
- Advice should be sought from the National Grid Electricity Distribution Contact Centre for any work that is to take place in proximity to 66kV or 132kV underground cables and 66kV 132kV overhead lines – 0800 096 3080



Link Box

Site Location

Overhead Line

PL
Service
LV
HV (11kV)
HV (33kV)
HV (66kV)
HV (132kV)

Underground Cable

National Grid Telecoms

— S — S —

Private Cables

PME Earth

Underground Earth

Pilot Cables

— P — P —


Pole Mounted Transformer

☐ **Ground Mounted Transformer**

Report damage immediately KEEP EVERYONE AWAY FROM THE AREA
0800 6783 105

Email: NGED.MapResponse@NationalGrid.co.uk

PDF designed for A3 colour print only with no page scaling

Contact Us

Mapping Enquiries: 0121 623 9780

General Enquiries: 0800 096 3080

Date Requested: 24/11/2023

Job Reference: 31654782

Site Location: 278649 186231

Requested by:


Mr Farhan Aslam

Steel Margam FEED

Scale: 1:1250 (When plotted at A3)


IMPORTANT NOTICES

- This information is given as a guide only and its accuracy cannot be guaranteed. Services or recent additions to the network may not be shown.
- Cables, overhead lines & substations owned by other electricity network owners or private companies may be present and may not be shown.
- You should always verify exact locations of cables using a cable locator and by careful use of hand tools in accordance with HSE guidance note HSG47.
- When working within 10m of any overhead electric line you should follow the requirements of HSE Guidance Note GS6.
- For further advice on working near our electricity cables or lines, call our Contact Centre on 0800 096 3080.
- Advice should be sought from the National Grid Electricity Distribution Contact Centre for any work that is to take place in proximity to 66kV or 132kV underground cables and 66kV 132kV overhead lines – 0800 096 3080

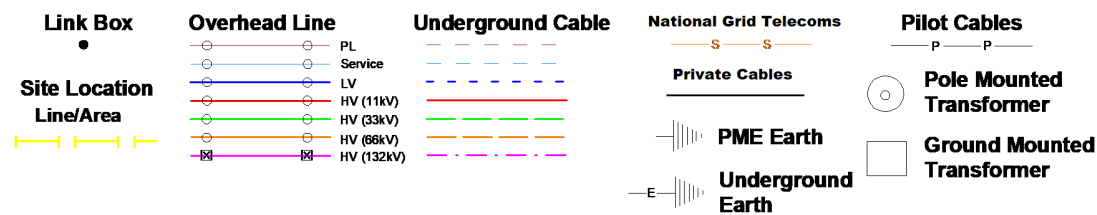

Report damage immediately KEEP EVERYONE AWAY FROM THE AREA
0800 6783 105

Email: NGED.MapResponse@NationalGrid.co.uk

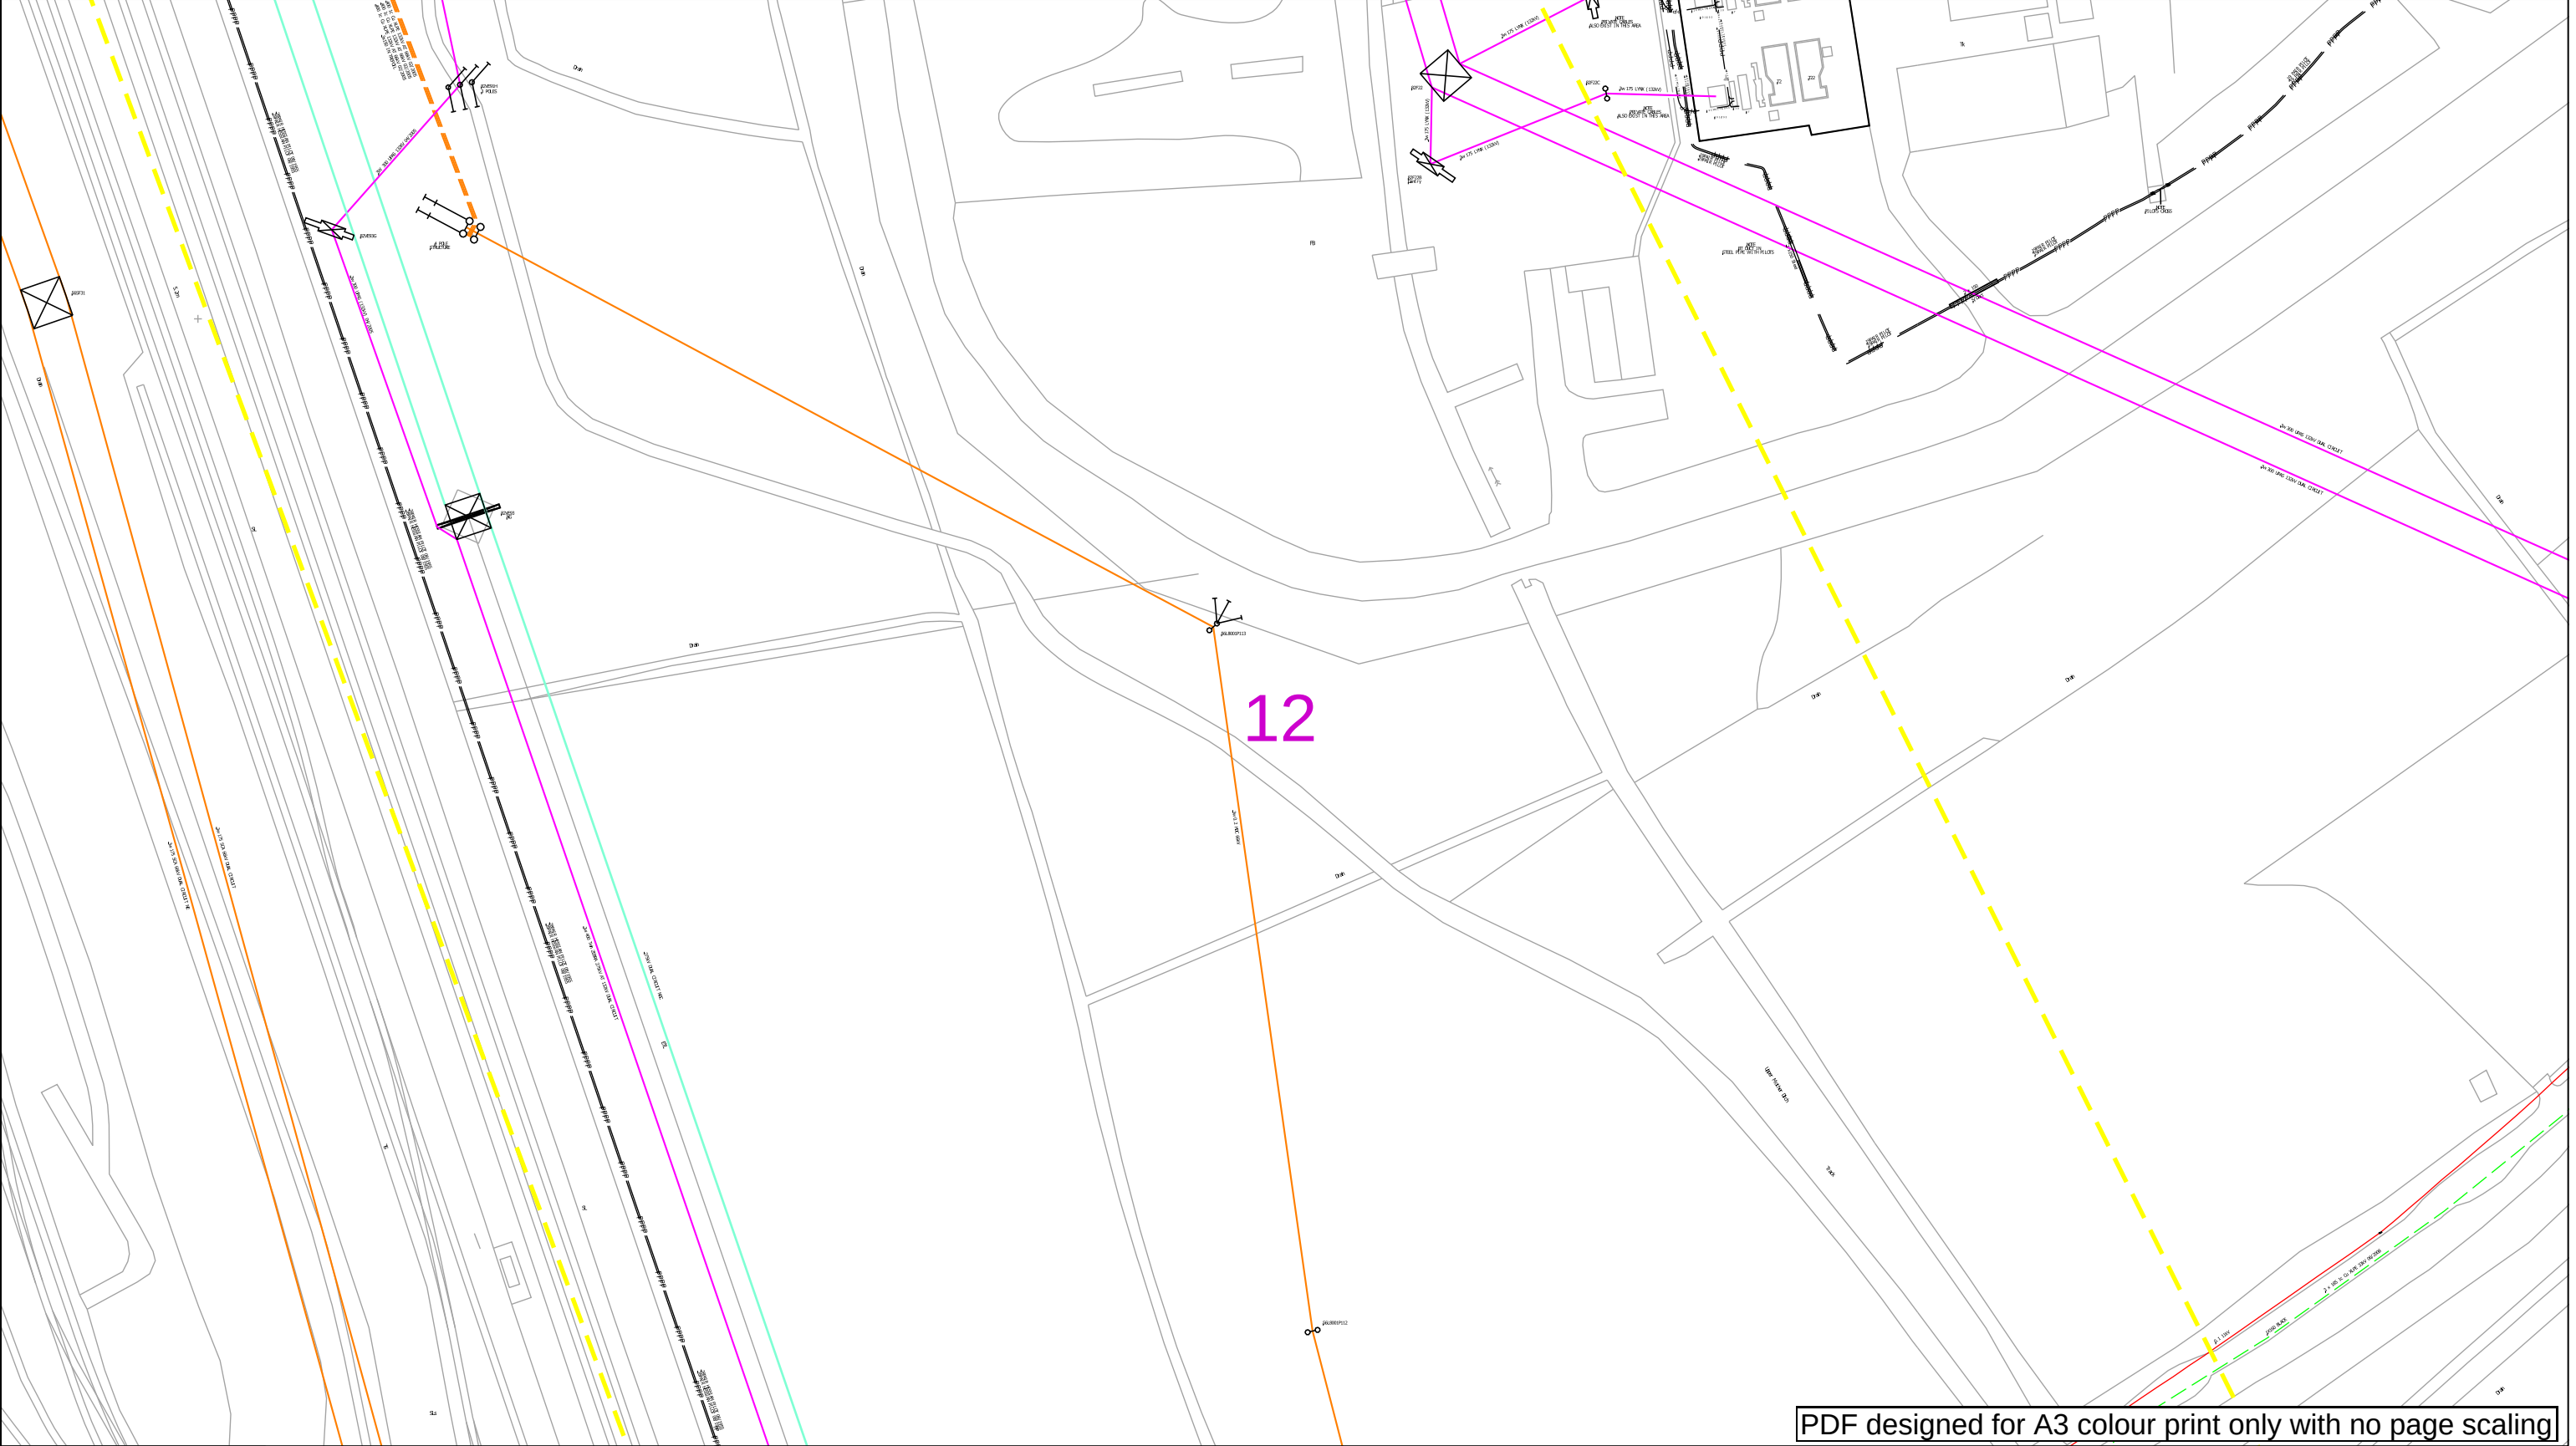

PDF designed for A3 colour print only with no page scaling

Contact Us

Mapping Enquiries: 0121 623 9780

General Enquiries: 0800 096 3080

Date Requested: 24/11/2023

Job Reference: 31654782

Site Location: 278649 186231

Requested by:
Mr Farhan Aslam
Your Scheme/Reference: NG TATA
Steel Margam FEED

Scale: 1:1250 (When plotted at A3)

IMPORTANT NOTICES

- This information is given as a guide only and its accuracy cannot be guaranteed. Services or recent additions to the network may not be shown.
- Cables, overhead lines & substations owned by other electricity network owners or private companies may be present and may not be shown.
- You should always verify exact locations of cables using a cable locator and by careful use of hand tools in accordance with HSE guidance note HSG47.
- When working within 10m of any overhead electric line you should follow the requirements of HSE Guidance Note GS6.
- For further advice on working near our electricity cables or lines, call our Contact Centre on 0800 096 3080.
- Advice should be sought from the National Grid Electricity Distribution Contact Centre for any work that is to take place in proximity to 66kV or 132kV underground cables and 66kV 132kV overhead lines – 0800 096 3080

0100m

Link Box

Site Location

Line/Area

Overhead Line

PL

Service

LV

HV (11kV)

HV (33kV)

HV (66kV)

HV (132kV)

Underground Cable

PL

Service

LV

HV (11kV)

HV (33kV)

HV (66kV)

HV (132kV)

National Grid Telecoms

Private Cables

PME Earth

Underground Earth

Pilot Cables

Pole Mounted Transformer

Ground Mounted Transformer


Report damage immediately

KEEP EVERYONE AWAY FROM THE AREA

0800 6783 105

Email: NGED.MapResponse@NationalGrid.co.uk

Crown Copyright © All Rights Reserved. Ordnance Survey Licence numbers: 100022432. NGED Copyright: This copy has been made by or with the authority of National Grid Electricity Distribution (NGED) pursuant to Section 47 of the Copyright Designs and Patents Act 1988 unless that Act provides a relevant exception to copyright the copy must not be copied without the prior permission of the copyright owner.

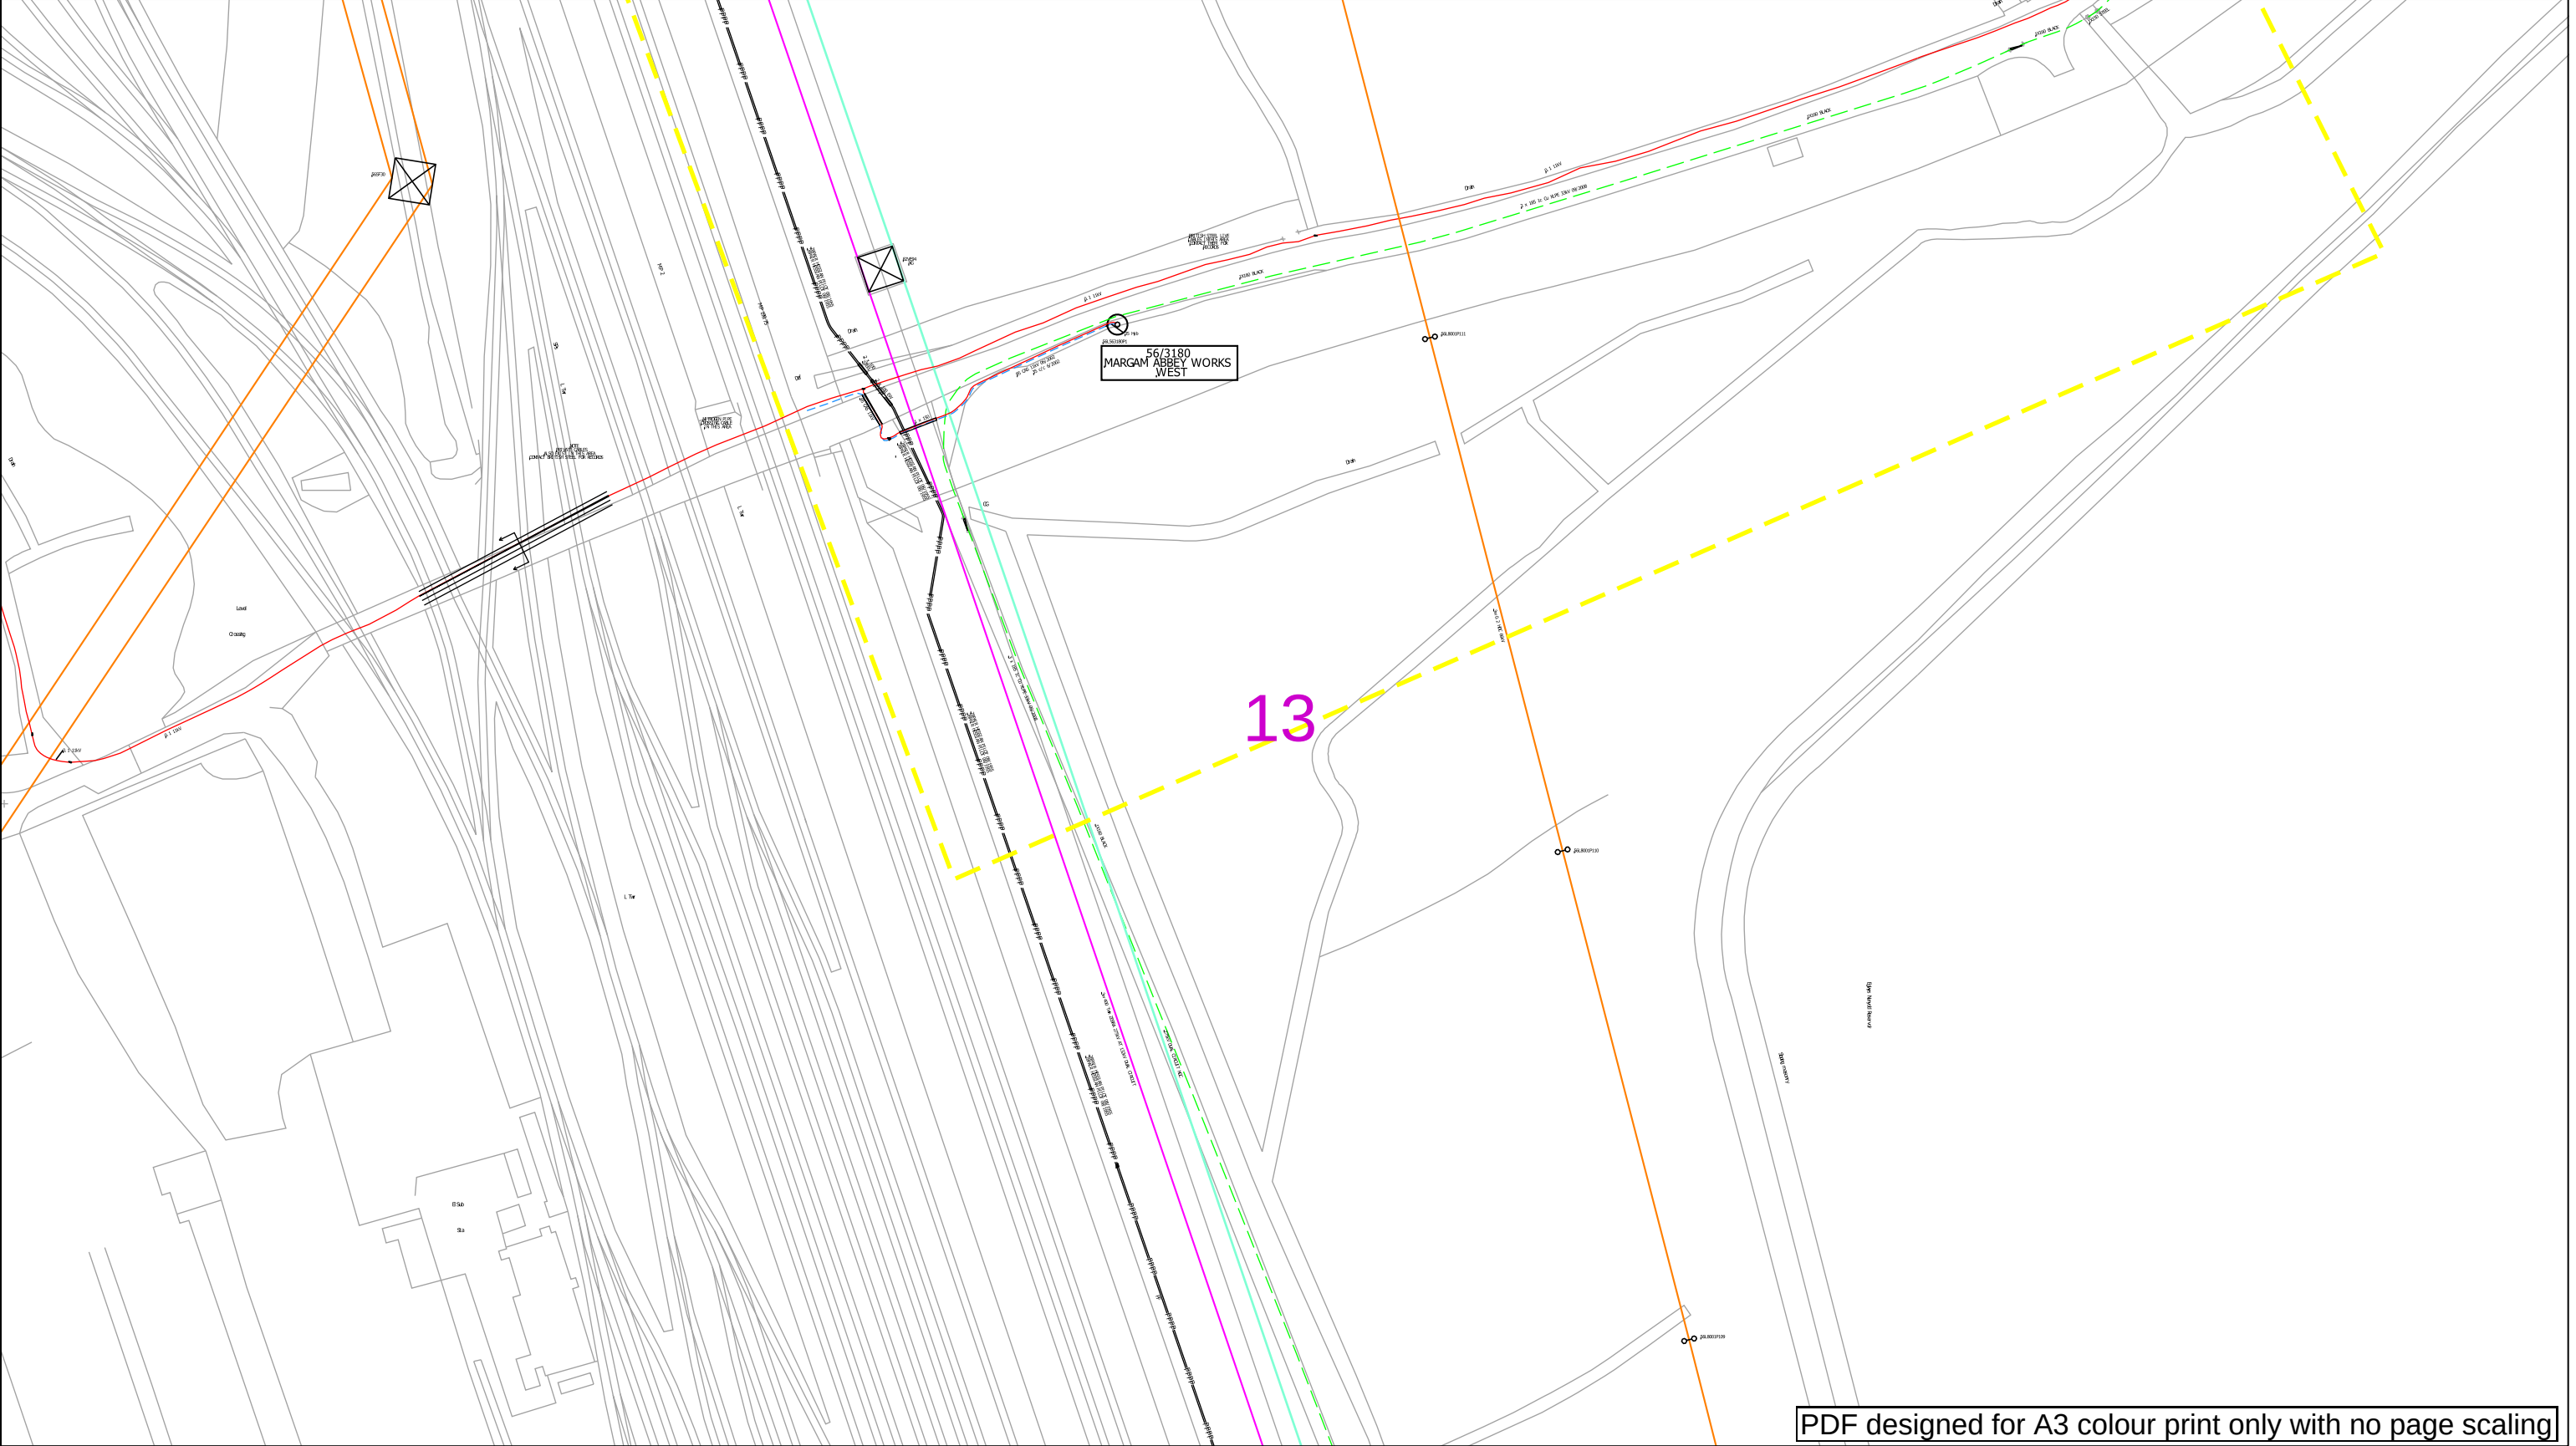


PDF designed for A3 colour print only with no page scaling

Contact Us Mapping Enquiries: 0121 623 9780 General Enquiries: 0800 096 3080 Date Requested: 24/11/2023 Job Reference: 31654782 Site Location: 278649 186231 Requested by: Mr Farhan Aslam Your Scheme/Reference: NG TATA Steel Margam FEED Scale: 1:1250 (When plotted at A3)	IMPORTANT NOTICES - This information is given as a guide only and its accuracy cannot be guaranteed. Services or recent additions to the network may not be shown. - Cables, overhead lines & substations owned by other electricity network owners or private companies may be present and may not be shown. - You should always verify exact locations of cables using a cable locator and by careful use of hand tools in accordance with HSE guidance note HSG47. - When working within 10m of any overhead electric line you should follow the requirements of HSE Guidance Note GS6. - For further advice on working near our electricity cables or lines, call our Contact Centre on 0800 096 3080. - Advice should be sought from the National Grid Electricity Distribution Contact Centre for any work that is to take place in proximity to 66kV or 132kV underground cables and 66kV 132kV overhead lines – 0800 096 3080	0100m Link Box Site Location Line/Area Overhead Line PL Service LV HV (11kV) HV (33kV) HV (66kV) HV (132kV) Underground Cable National Grid Telecoms Private Cables PME Earth Underground Earth Pilot Cables Pole Mounted Transformer Ground Mounted Transformer Report damage immediately KEEP EVERYONE AWAY FROM THE AREA 0800 6783 105	Email: NGED.MapResponse@NationalGrid.co.uk
---	---	--	---

Overview

Warning: PDF designed for A3 colour print only with no page scaling

Contact Us Mapping Enquiries: 02920 278 912 General Enquiries: 0800 912 2999 Date Requested: 24/11/2023 Job Reference: 31654782 Site Location: 278649 186231 Requested by: Mr Farhan Aslam Your Scheme/Reference: NG TATA Steel Margam FEED Scale: 1:8969 (When plotted at A3)	EXTREME CAUTION. Major Accident Hazard Pipeline in Vicinity **RISK OF DEATH OR SERIOUS INJURY** Prior to excavation starting you must contact the plant protection team on 02920 278912 IMPORTANT NOTICES • This information is given as a guide only and its accuracy cannot be guaranteed • The plan only shows those pipes owned by Wales & West Utilities (WWU) as its role as a licensed Gas Transporter • Service pipes, valves, syphons, stub connections etc. may not be shown but their presence should be anticipated • You must use safe digging practices in accordance with HS(G)47 to establish the actual position of mains, services and other apparatus before any mechanical excavation is used • It is your responsibility to ensure this information is provided to all persons working near our plant • If in doubt call the WWU dig team on 02920 278912	In case of an emergency call 0800 111 999 <table><tr><td>Dig Sites</td><td>Area:  Line: </td><td rowspan="5">    </td></tr><tr><td></td><td>Low Pressure (LP) 21mbar – 75mbar</td><td>Line/Fire Valve</td></tr><tr><td></td><td>Medium Pressure (MP) 350mbar – 2bar</td><td>Governor Station</td></tr><tr><td></td><td>Intermediate Pressure (IP) 2bar – 7bar</td><td>Change of Diameter</td></tr><tr><td></td><td>High Pressure (HP) >7bar</td><td>End Cap</td></tr><tr><td></td><td></td><td>Depth of cover</td></tr></table>	Dig Sites	Area:  Line: 	    		Low Pressure (LP) 21mbar – 75mbar	Line/Fire Valve		Medium Pressure (MP) 350mbar – 2bar	Governor Station		Intermediate Pressure (IP) 2bar – 7bar	Change of Diameter		High Pressure (HP) >7bar	End Cap			Depth of cover	 
Dig Sites	Area:  Line: 	    																			
	Low Pressure (LP) 21mbar – 75mbar		Line/Fire Valve																		
	Medium Pressure (MP) 350mbar – 2bar		Governor Station																		
	Intermediate Pressure (IP) 2bar – 7bar		Change of Diameter																		
	High Pressure (HP) >7bar		End Cap																		
		Depth of cover																			

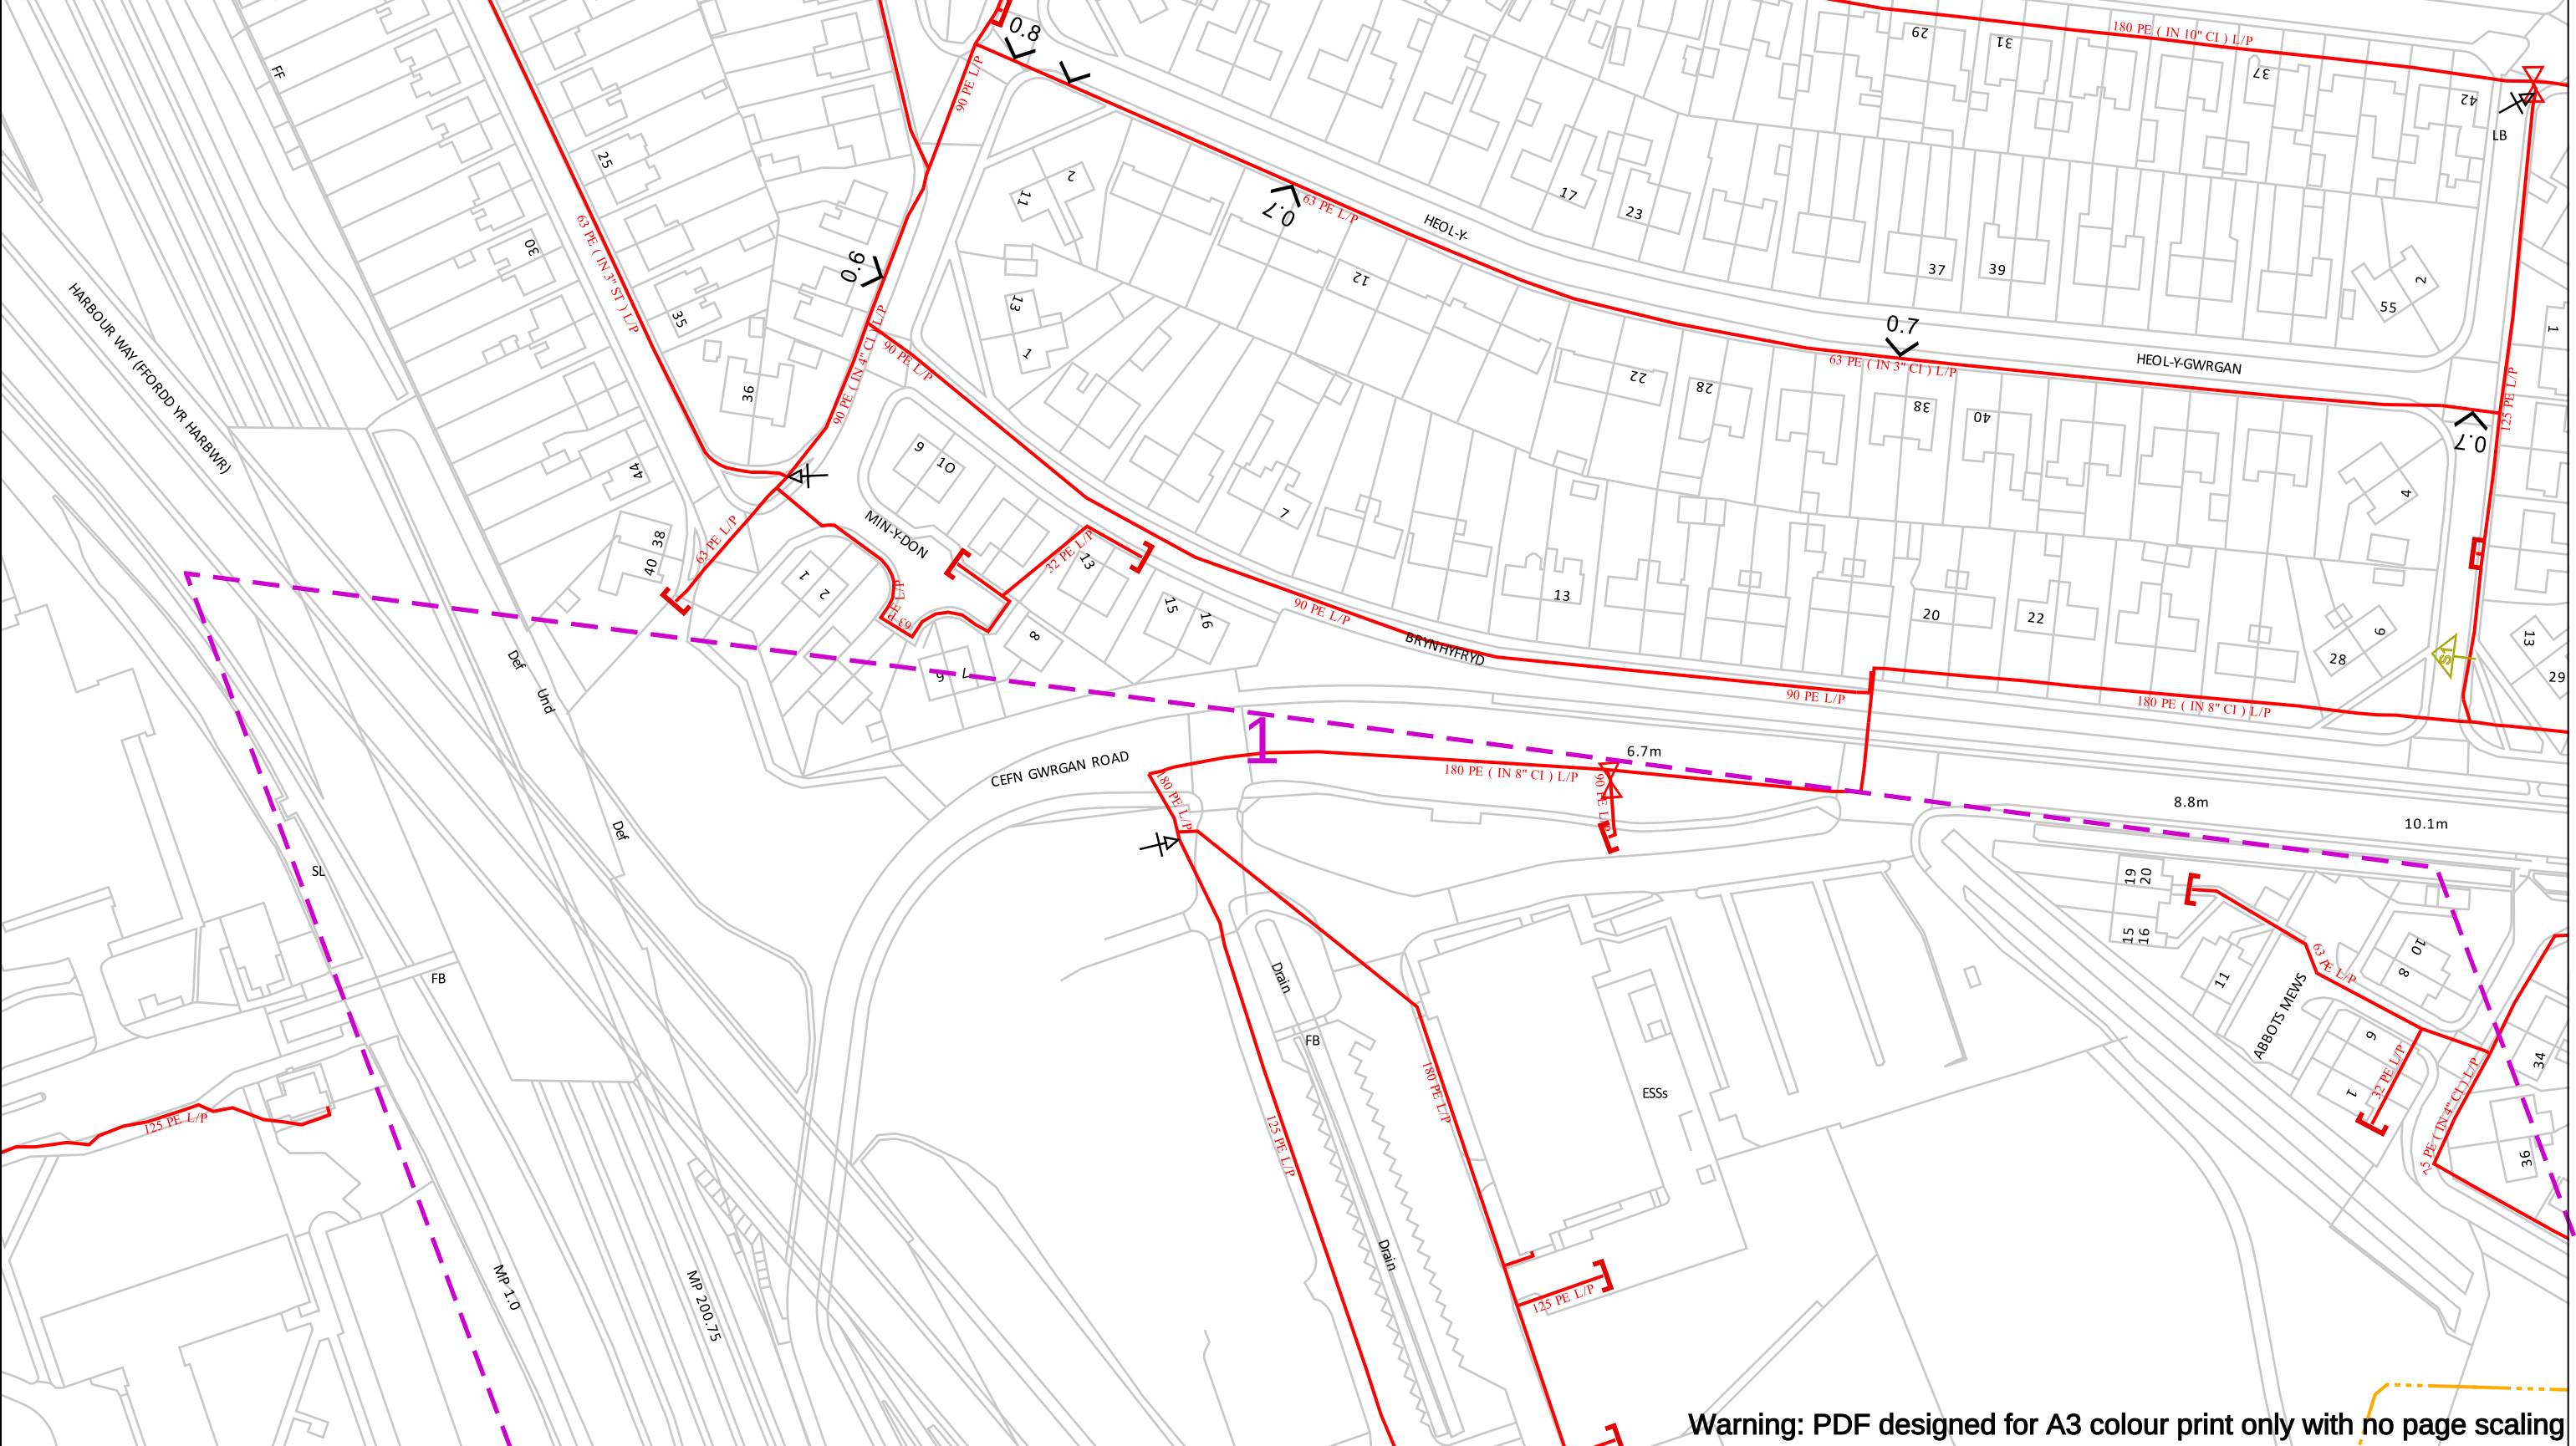

Warning: PDF designed for A3 colour print only with no page scaling

Contact Us
Mapping Enquiries: 02920 278 912
General Enquiries: 0800 912 2999

Date Requested: 24/11/2023
Job Reference: 31654782
Site Location: 278649 186231

Requested by:
Mr Farhan Aslam
Your Scheme/Reference: NG TATA
Steel Margam FEED

Scale: 1:1250 (When plotted at A3)

EXTREME CAUTION. Major Accident Hazard Pipeline in Vicinity
****RISK OF DEATH OR SERIOUS INJURY****
Prior to excavation starting you must contact the plant protection team on 02920 278912

IMPORTANT NOTICES

- This information is given as a guide only and its accuracy cannot be guaranteed
- The plan only shows those pipes owned by Wales & West Utilities (WWU) as its role as a licensed Gas Transporter
- Service pipes, valves, syphons, stub connections etc. may not be shown but their presence should be anticipated
- You must use safe digging practices in accordance with HS(G)47 to establish the actual position of mains, services and other apparatus before any mechanical excavation is used
- It is your responsibility to ensure this information is provided to all persons working near our plant
- If in doubt call the WWU dig team on 02920 278912


In case of an emergency call 0800 111 999

100m

Dig Sites	Area:	Line:
	Low Pressure (LP) 21mbar – 75mbar	
	Medium Pressure (MP) 350mbar – 2bar	
	Intermediate Pressure (IP) 2bar – 7bar	
	High Pressure (HP) >7bar	

	Line/Fire Valve
	Governor Station
	Change of Diameter
	End Cap
	Depth of cover



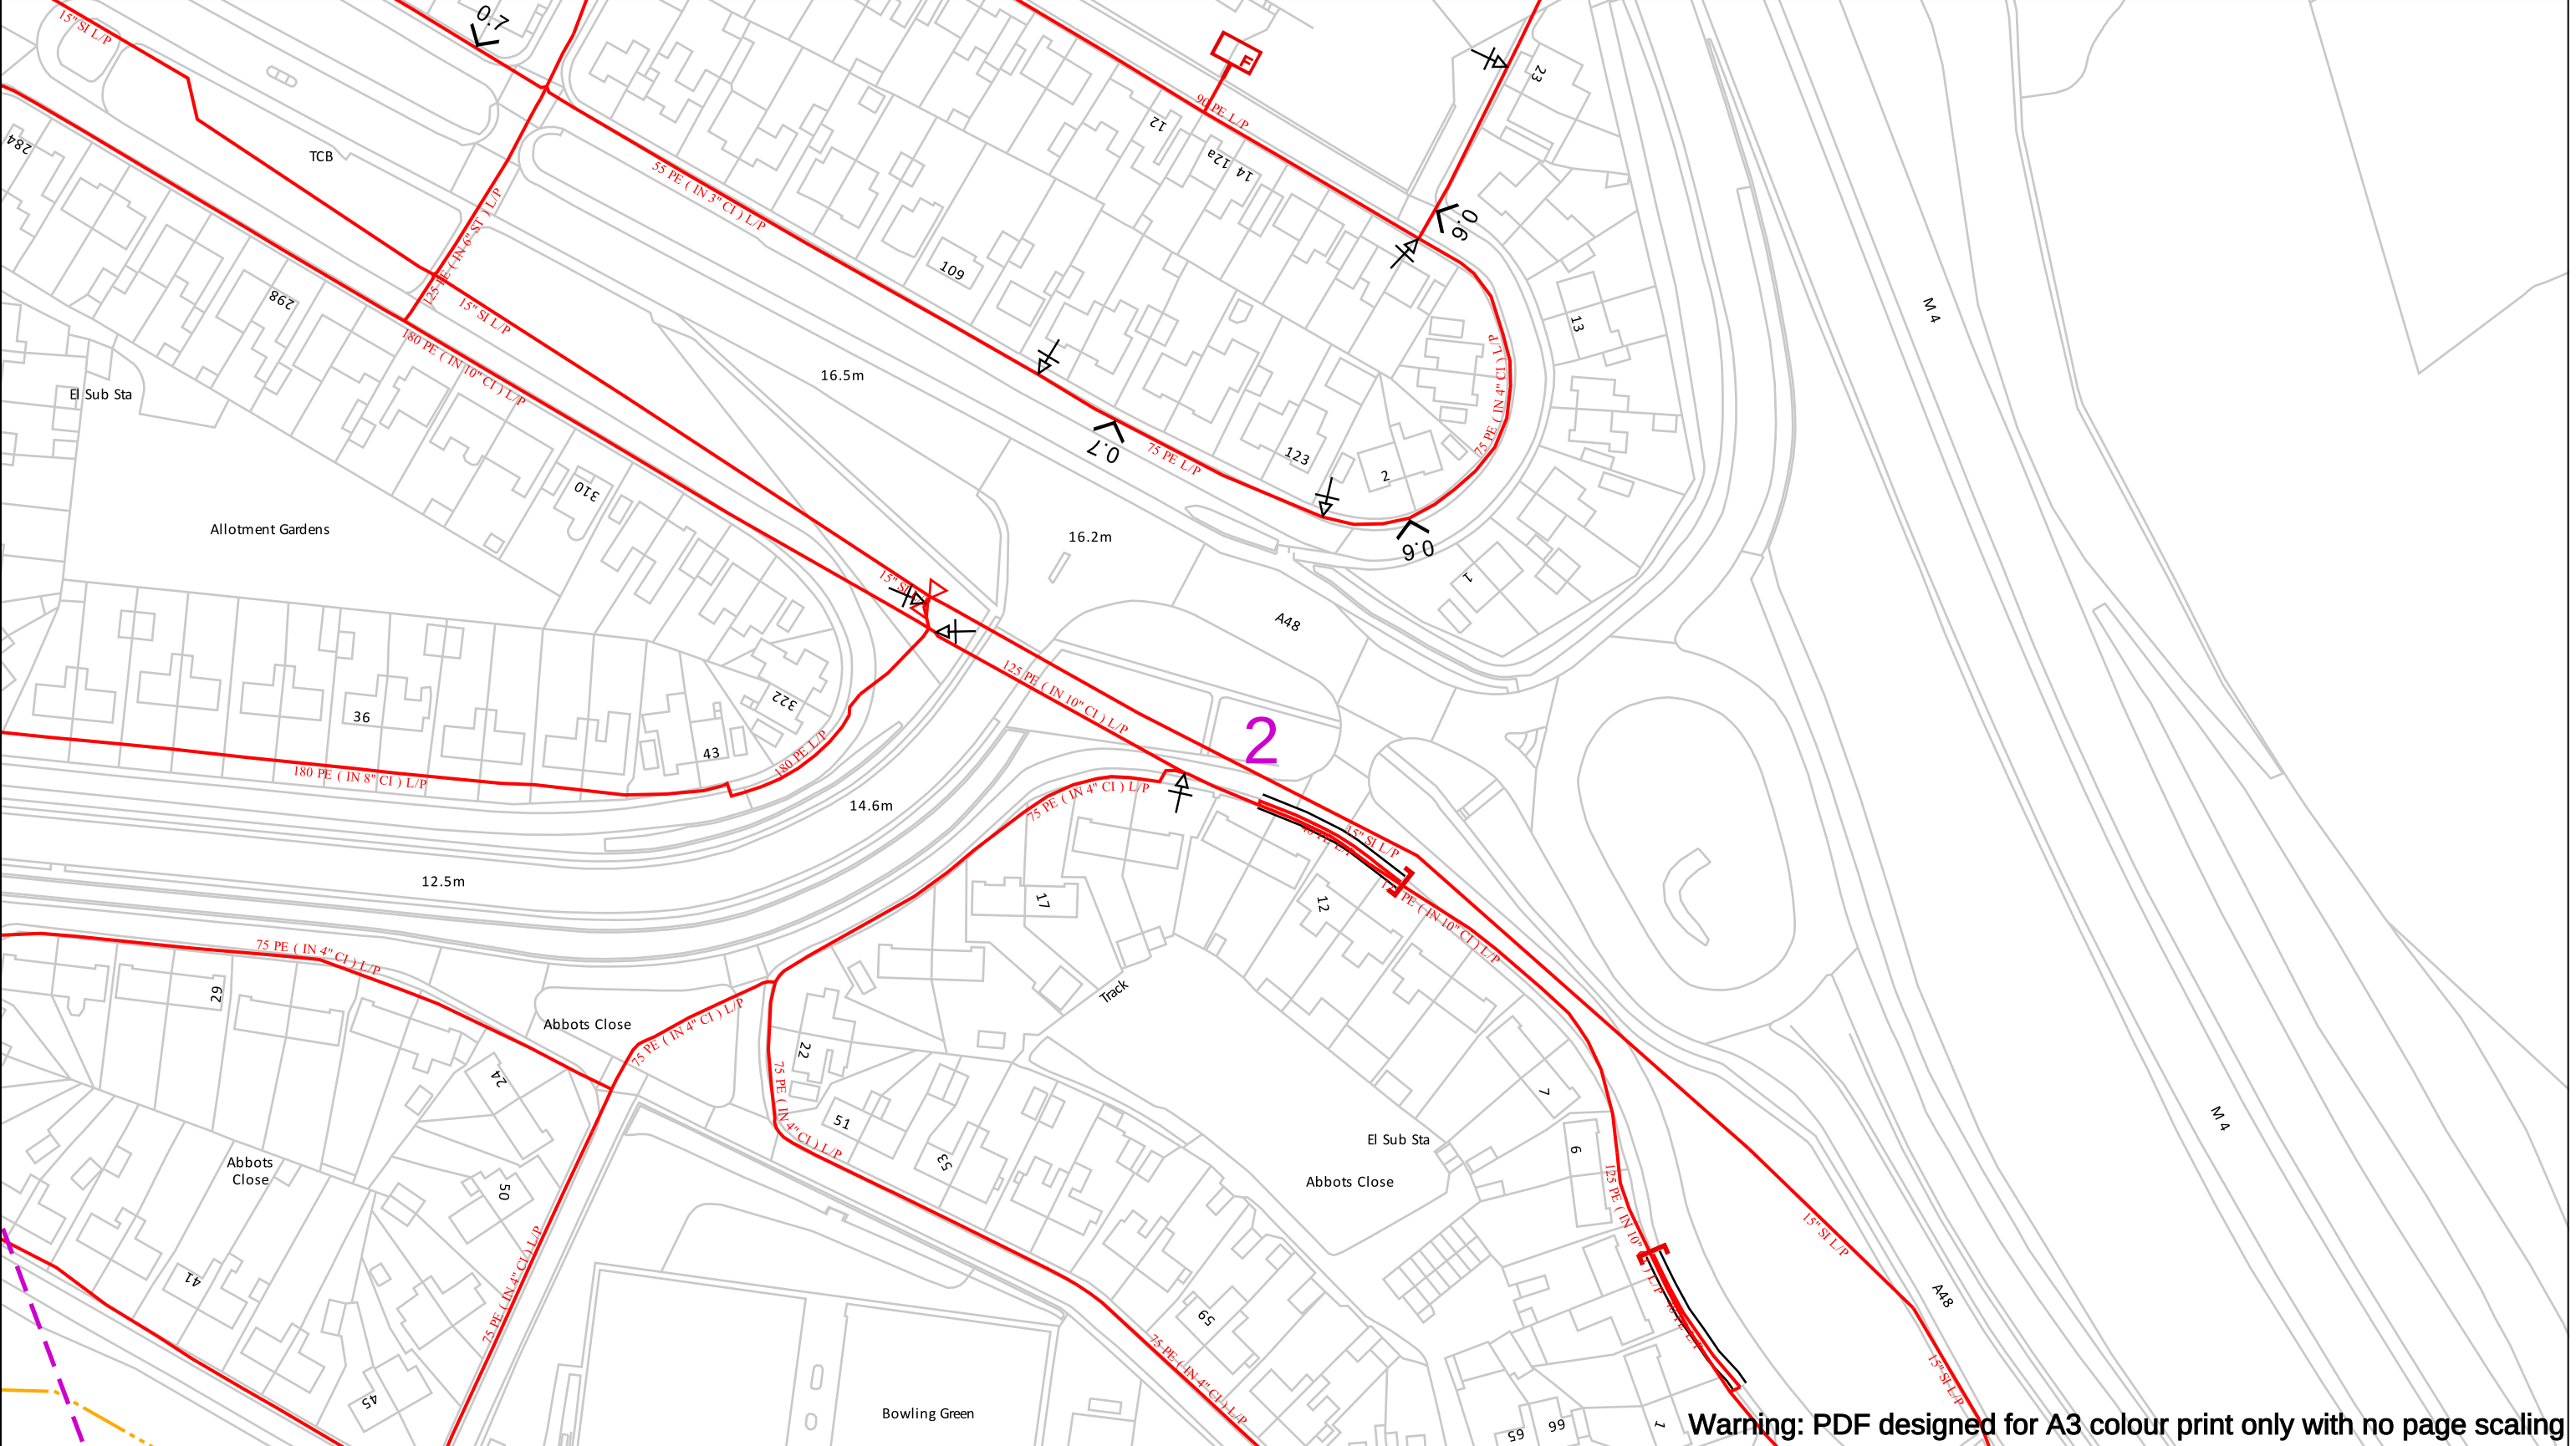

Warning: PDF designed for A3 colour print only with no page scaling

Contact Us
Mapping Enquiries: 02920 278 912
General Enquiries: 0800 912 2999

Date Requested: 24/11/2023
Job Reference: 31654782
Site Location: 278649 186231
Requested by:
Mr Farhan Aslam
Your Scheme/Reference: NG TATA
Steel Margam FEED

Scale: 1:1250 (When plotted at A3)

EXTREME CAUTION. Major Accident Hazard Pipeline in Vicinity
****RISK OF DEATH OR SERIOUS INJURY****
Prior to excavation starting you must contact the plant protection team on 02920 278912

IMPORTANT NOTICES

- This information is given as a guide only and its accuracy cannot be guaranteed
- The plan only shows those pipes owned by Wales & West Utilities (WWU) as its role as a licensed Gas Transporter
- Service pipes, valves, syphons, stub connections etc. may not be shown but their presence should be anticipated
- You must use safe digging practices in accordance with HS(G)47 to establish the actual position of mains, services and other apparatus before any mechanical excavation is used
- It is your responsibility to ensure this information is provided to all persons working near our plant
- If in doubt call the WWU dig team on 02920 278912

In case of an emergency call 0800 111 999

Dig Sites

Low Pressure (LP) 21mbar – 75mbar

Medium Pressure (MP) 350mbar – 2bar

Intermediate Pressure (IP) 2bar – 7bar

High Pressure (HP) >7bar

Area: Line:

Line/Fire Valve

Governor Station

Change of Diameter

End Cap

Depth of cover


Crown Copyright © - Reproduced by permission of Ordnance Survey on behalf of HMSO. And database right 2023. All rights reserved. Ordnance Survey Licence number 0100044308.



Scale: 1:1250 (When plotted at A3)


- This information is given as a guide only and its accuracy cannot be guaranteed
- The plan only shows those pipes owned by Wales & West Utilities (WWU) as its role as a licensed Gas Transporter
- Service pipes, valves, syphons, stub connections etc. may not be shown but their presence should be anticipated
- You must use safe digging practices in accordance with HS(G)47 to establish the actual position of mains, services and other apparatus before any mechanical excavation is used
- It is your responsibility to ensure this information is provided to all persons working near our plant
- If in doubt call the WWU dig team on 02920 278912

Depth of cover

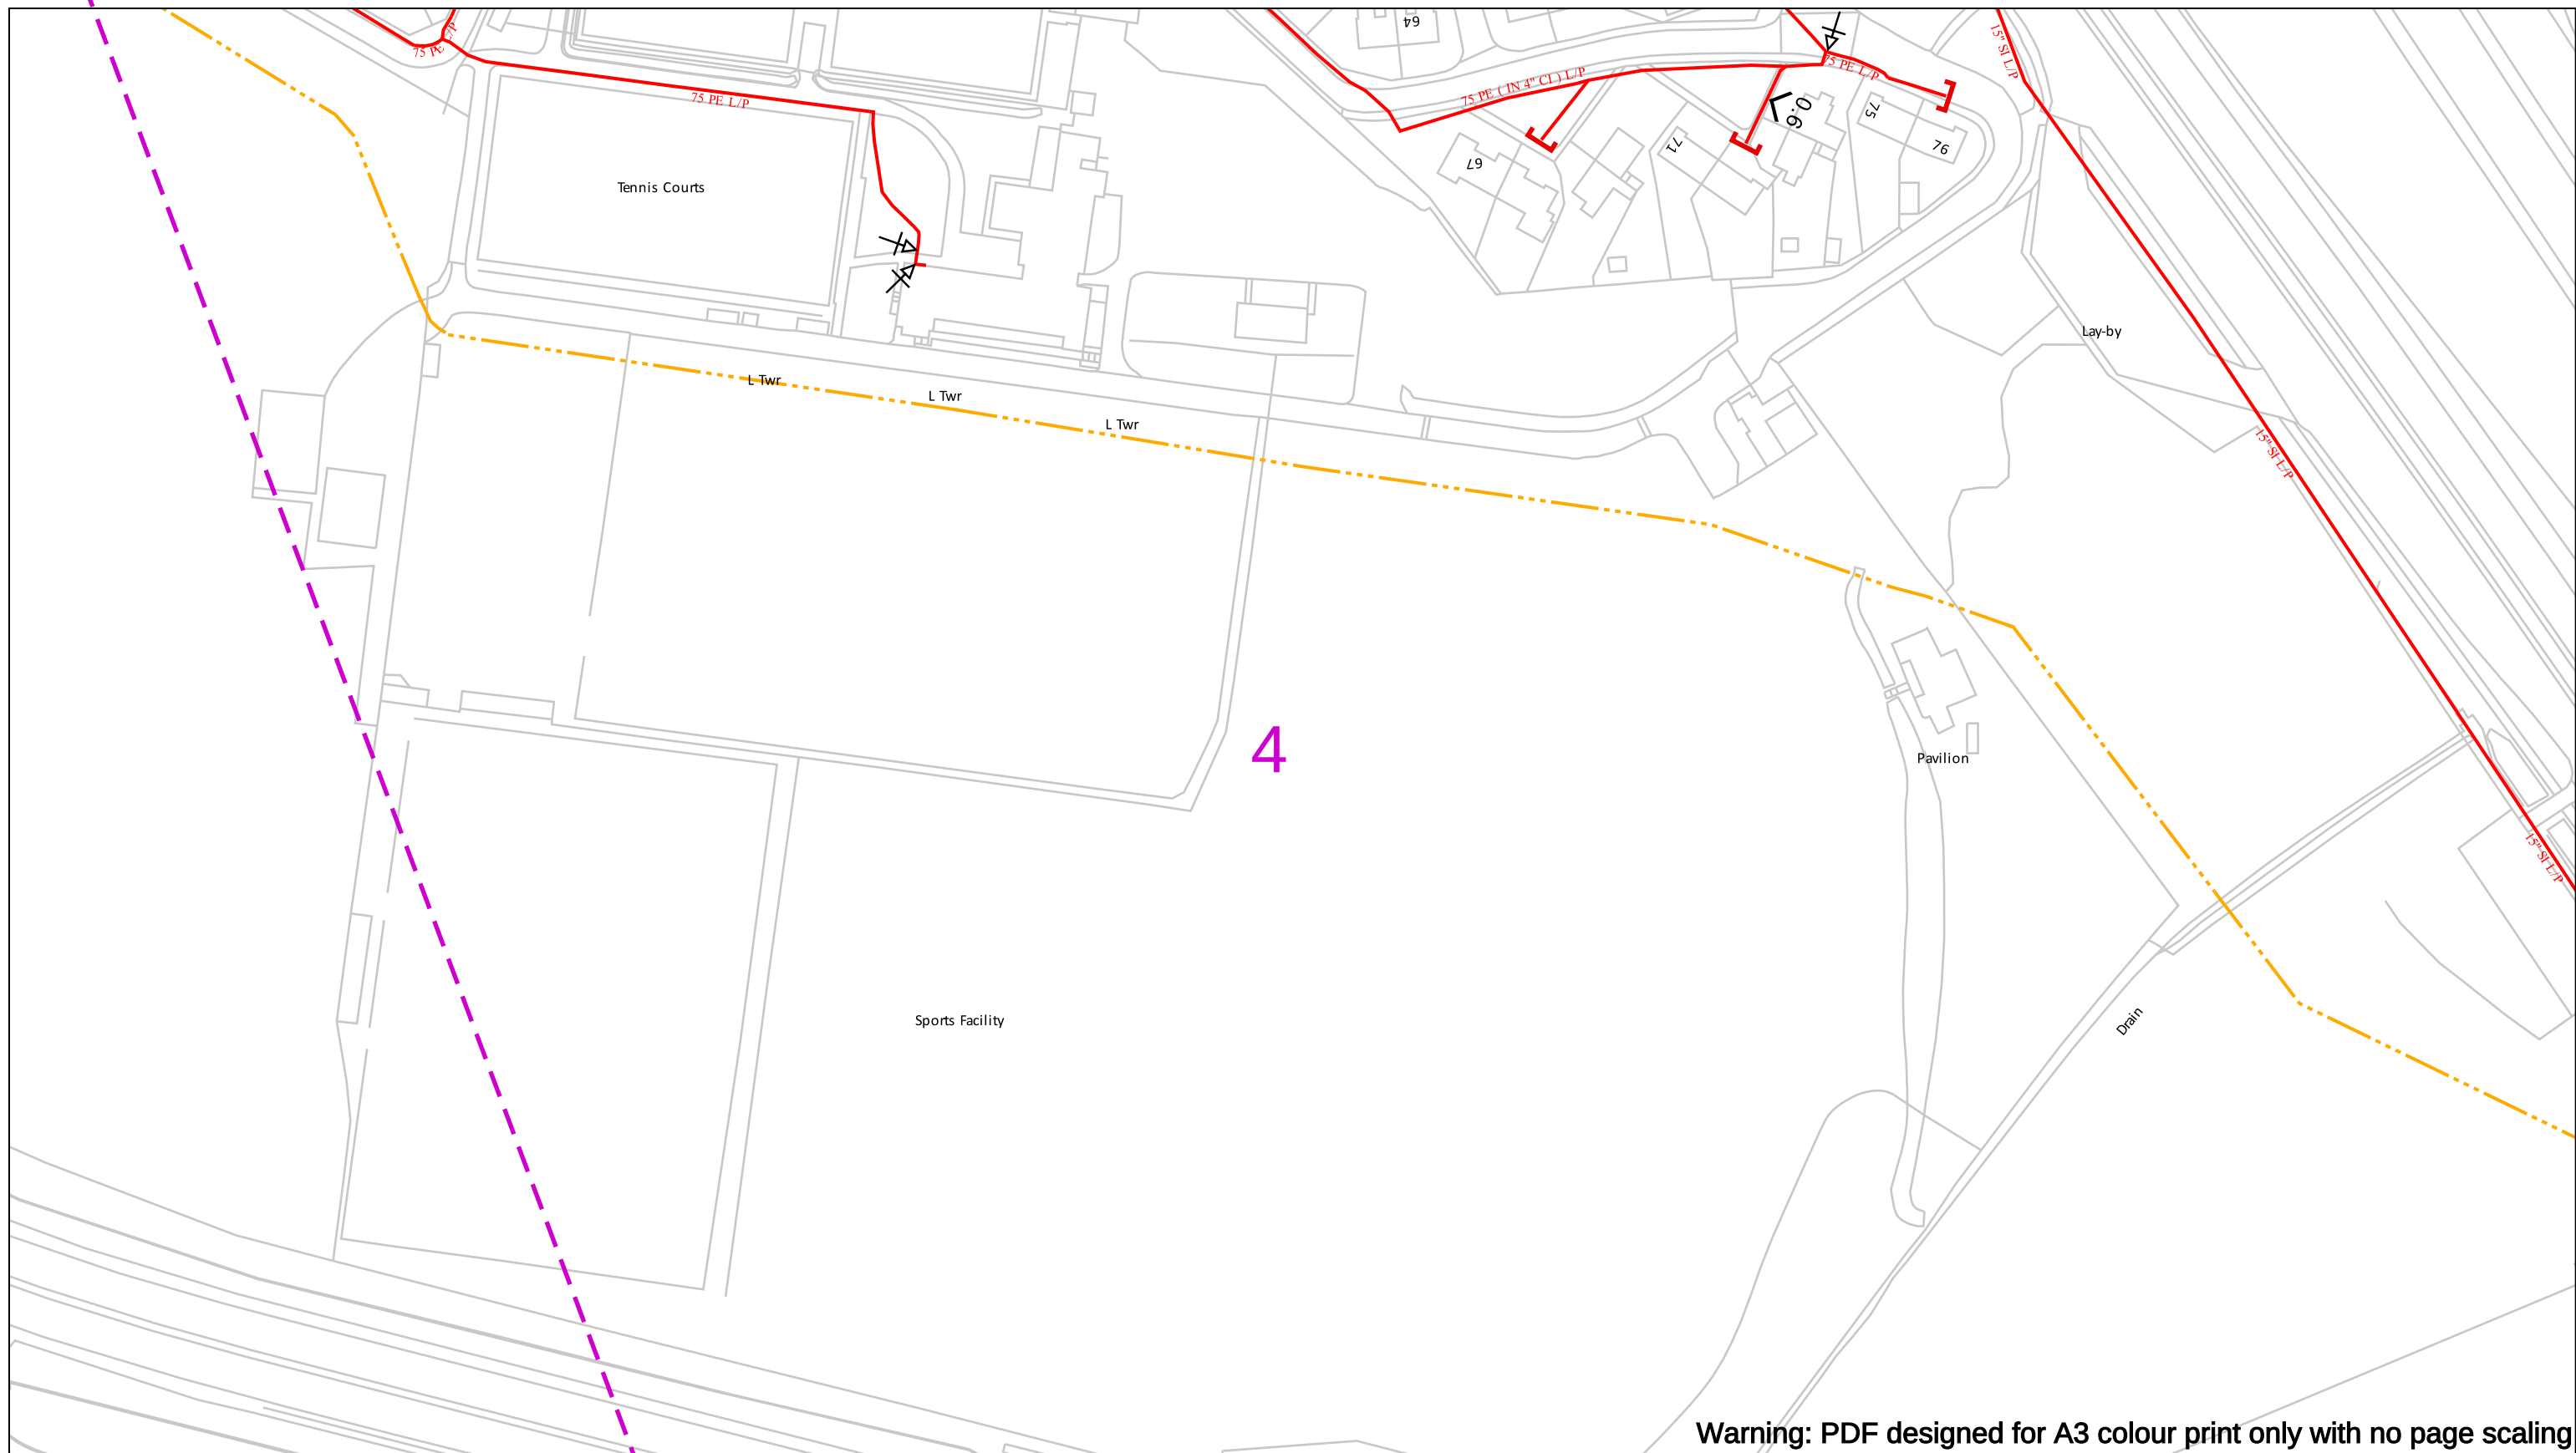


Warning: PDF designed for A3 colour print only with no page scaling

Contact Us Mapping Enquiries: 02920 278 912 General Enquiries: 0800 912 2999 Date Requested: 24/11/2023 Job Reference: 31654782 Site Location: 278649 186231 Requested by: Mr Farhan Aslam Your Scheme/Reference: NG TATA Steel Margam FEED Scale: 1:1250 (When plotted at A3)	EXTREME CAUTION. Major Accident Hazard Pipeline in Vicinity **RISK OF DEATH OR SERIOUS INJURY** Prior to excavation starting you must contact the plant protection team on 02920 278912 IMPORTANT NOTICES • This information is given as a guide only and its accuracy cannot be guaranteed • The plan only shows those pipes owned by Wales & West Utilities (WWU) as its role as a licensed Gas Transporter • Service pipes, valves, syphons, stub connections etc. may not be shown but their presence should be anticipated • You must use safe digging practices in accordance with HS(G)47 to establish the actual position of mains, services and other apparatus before any mechanical excavation is used • It is your responsibility to ensure this information is provided to all persons working near our plant • If in doubt call the WWU dig team on 02920 278912	In case of an emergency call 0800 111 999 100m Dig Sites Area: Line: Low Pressure (LP) 21mbar – 75mbar Medium Pressure (MP) 350mbar – 2bar Intermediate Pressure (IP) 2bar – 7bar High Pressure (HP) >7bar Line/Fire Valve Governor Station Change of Diameter End Cap Depth of cover	
Crown Copyright © - Reproduced by permission of Ordnance Survey on behalf of HMSO. And database right 2023. All rights reserved. Ordnance Survey Licence number 0100044308.			

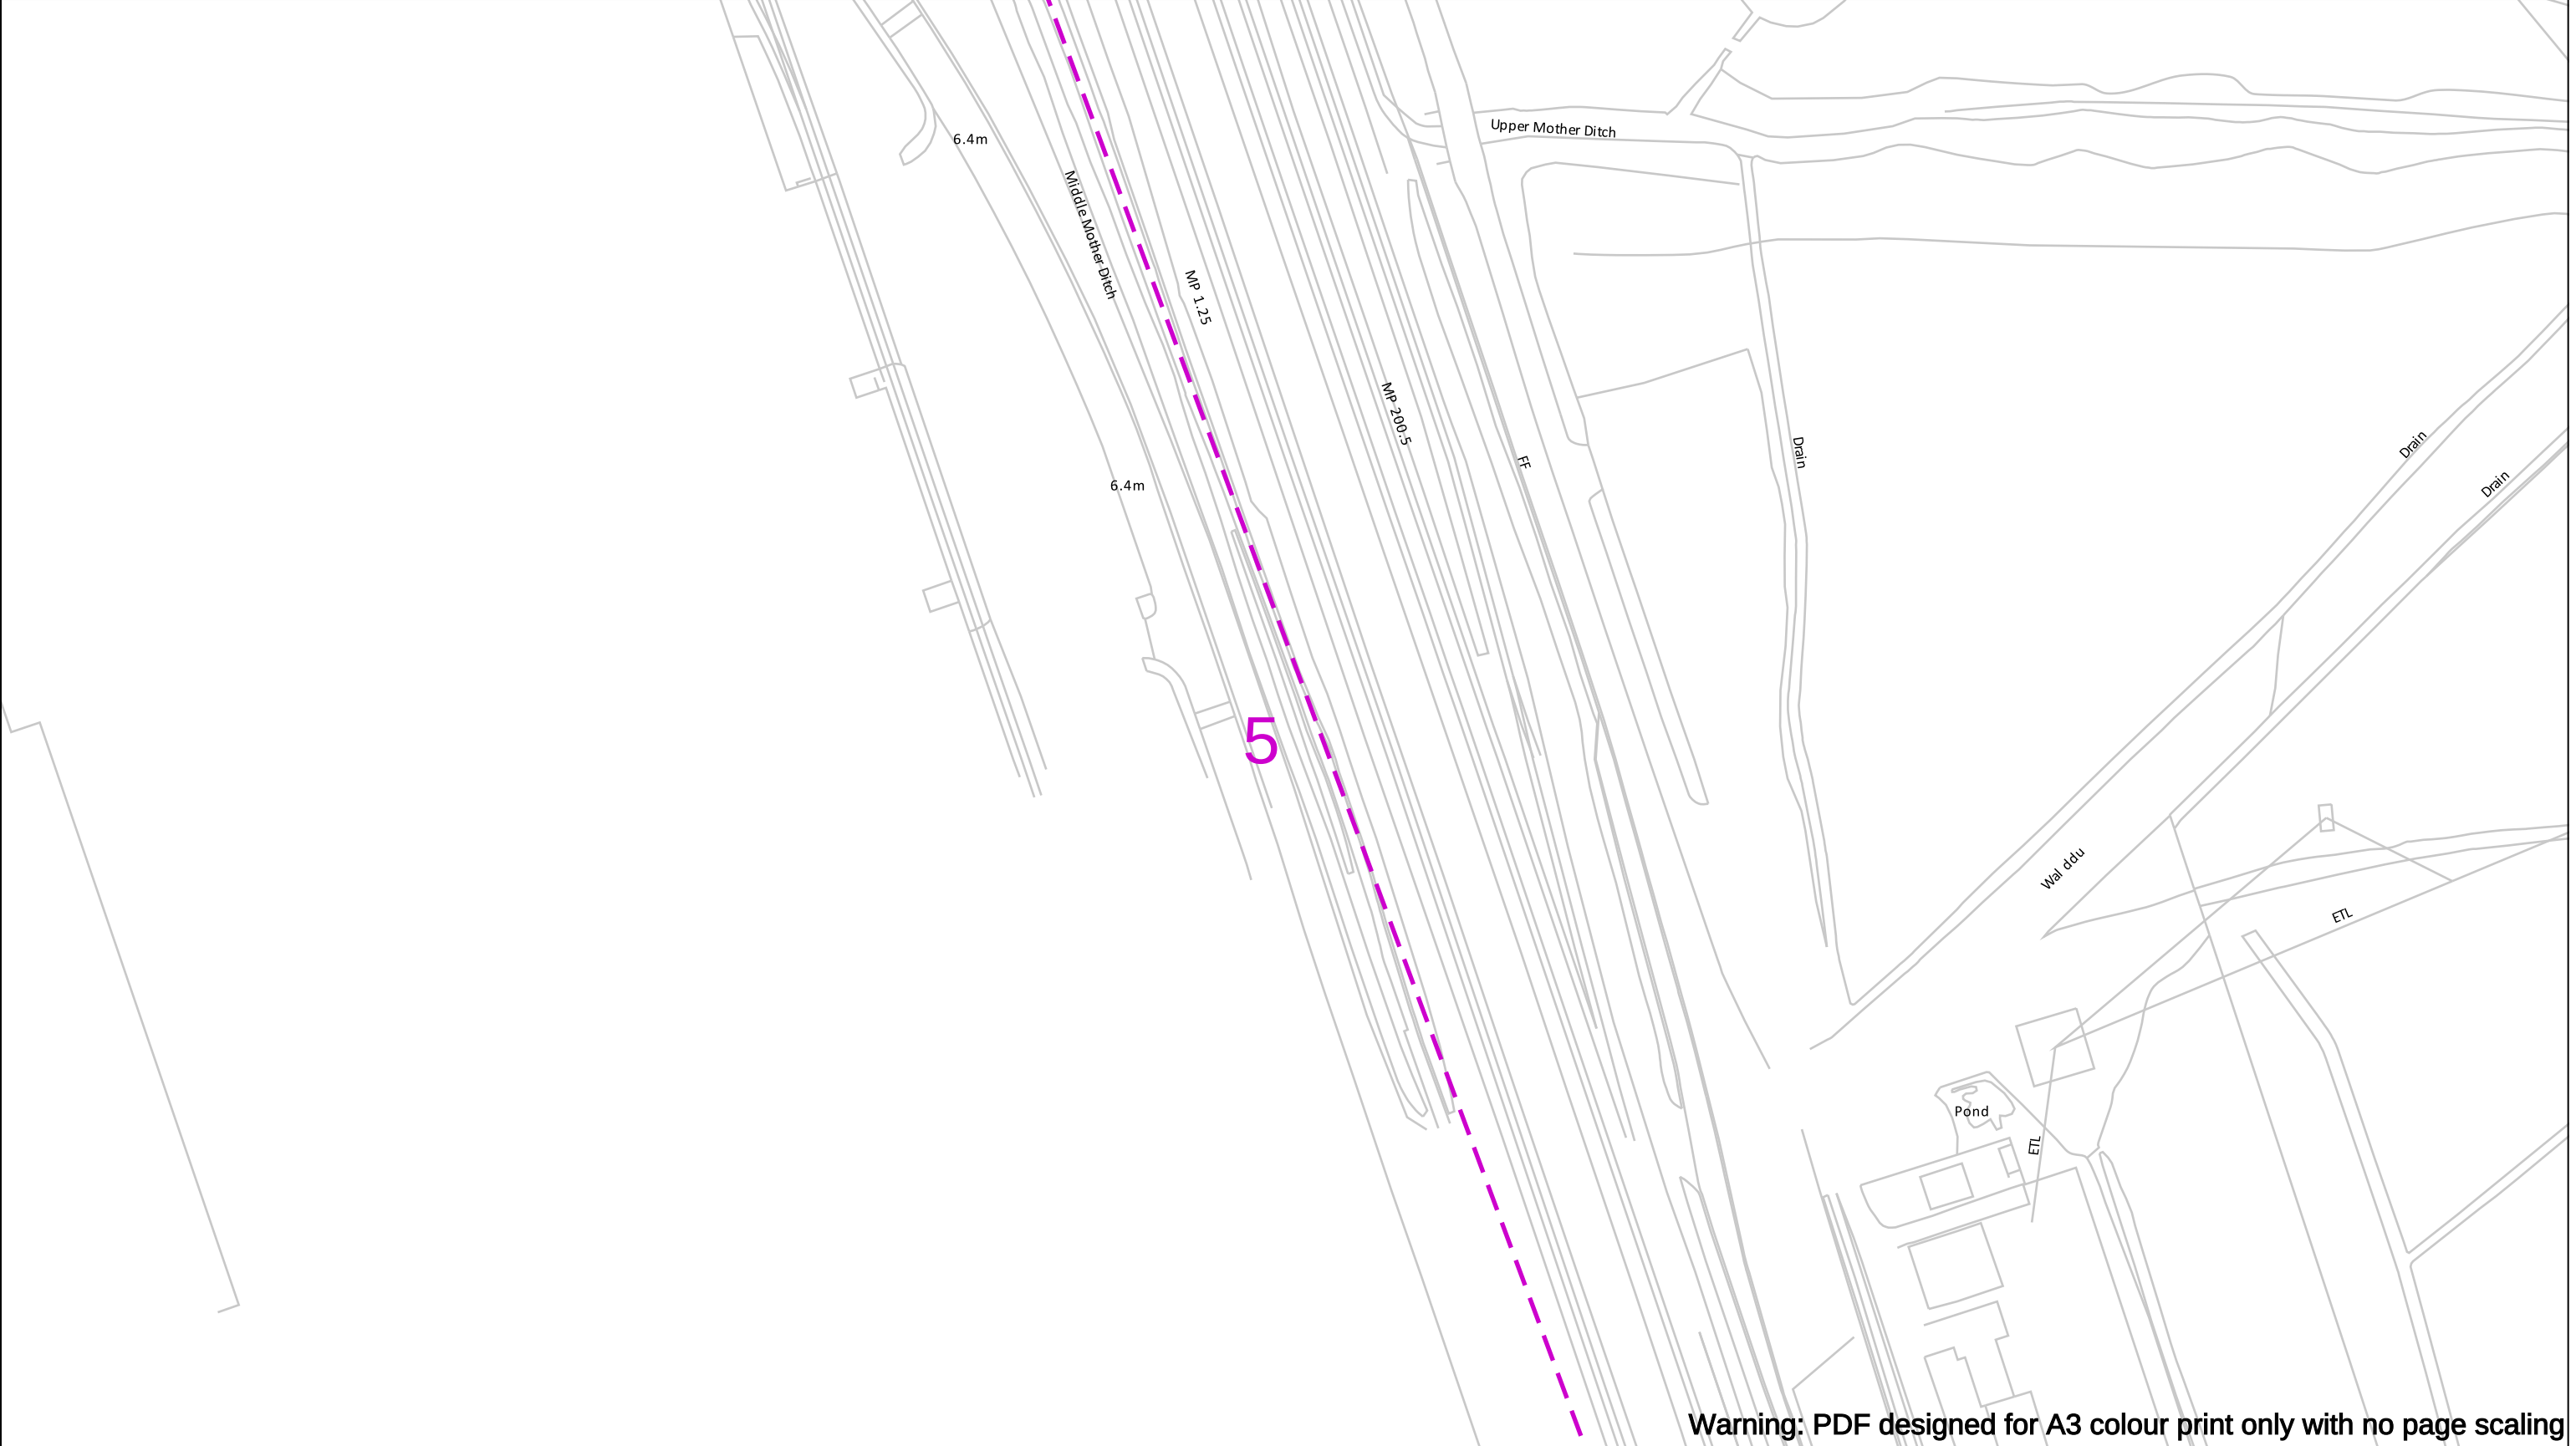

Warning: PDF designed for A3 colour print only with no page scaling

Contact Us Mapping Enquiries: 02920 278 912 General Enquiries: 0800 912 2999 Date Requested: 24/11/2023 Job Reference: 31654782 Site Location: 278649 186231 Requested by: Mr Farhan Aslam Your Scheme/Reference: NG TATA Steel Margam FEED Scale: 1:1250 (When plotted at A3)	EXTREME CAUTION. Major Accident Hazard Pipeline in Vicinity **RISK OF DEATH OR SERIOUS INJURY** Prior to excavation starting you must contact the plant protection team on 02920 278912 IMPORTANT NOTICES - This information is given as a guide only and its accuracy cannot be guaranteed - The plan only shows those pipes owned by Wales & West Utilities (WWU) as its role as a licensed Gas Transporter - Service pipes, valves, syphons, stub connections etc. may not be shown but their presence should be anticipated - You must use safe digging practices in accordance with HS(G)47 to establish the actual position of mains, services and other apparatus before any mechanical excavation is used - It is your responsibility to ensure this information is provided to all persons working near our plant - If in doubt call the WWU dig team on 02920 278912	In case of an emergency call 0800 111 999 Dig Sites Area: Line: Low Pressure (LP) 21mbar – 75mbar Medium Pressure (MP) 350mbar – 2bar Intermediate Pressure (IP) 2bar – 7bar High Pressure (HP) >7bar Line/Fire Valve Governor Station Change of Diameter End Cap Depth of cover	
---	---	--	-------------------------

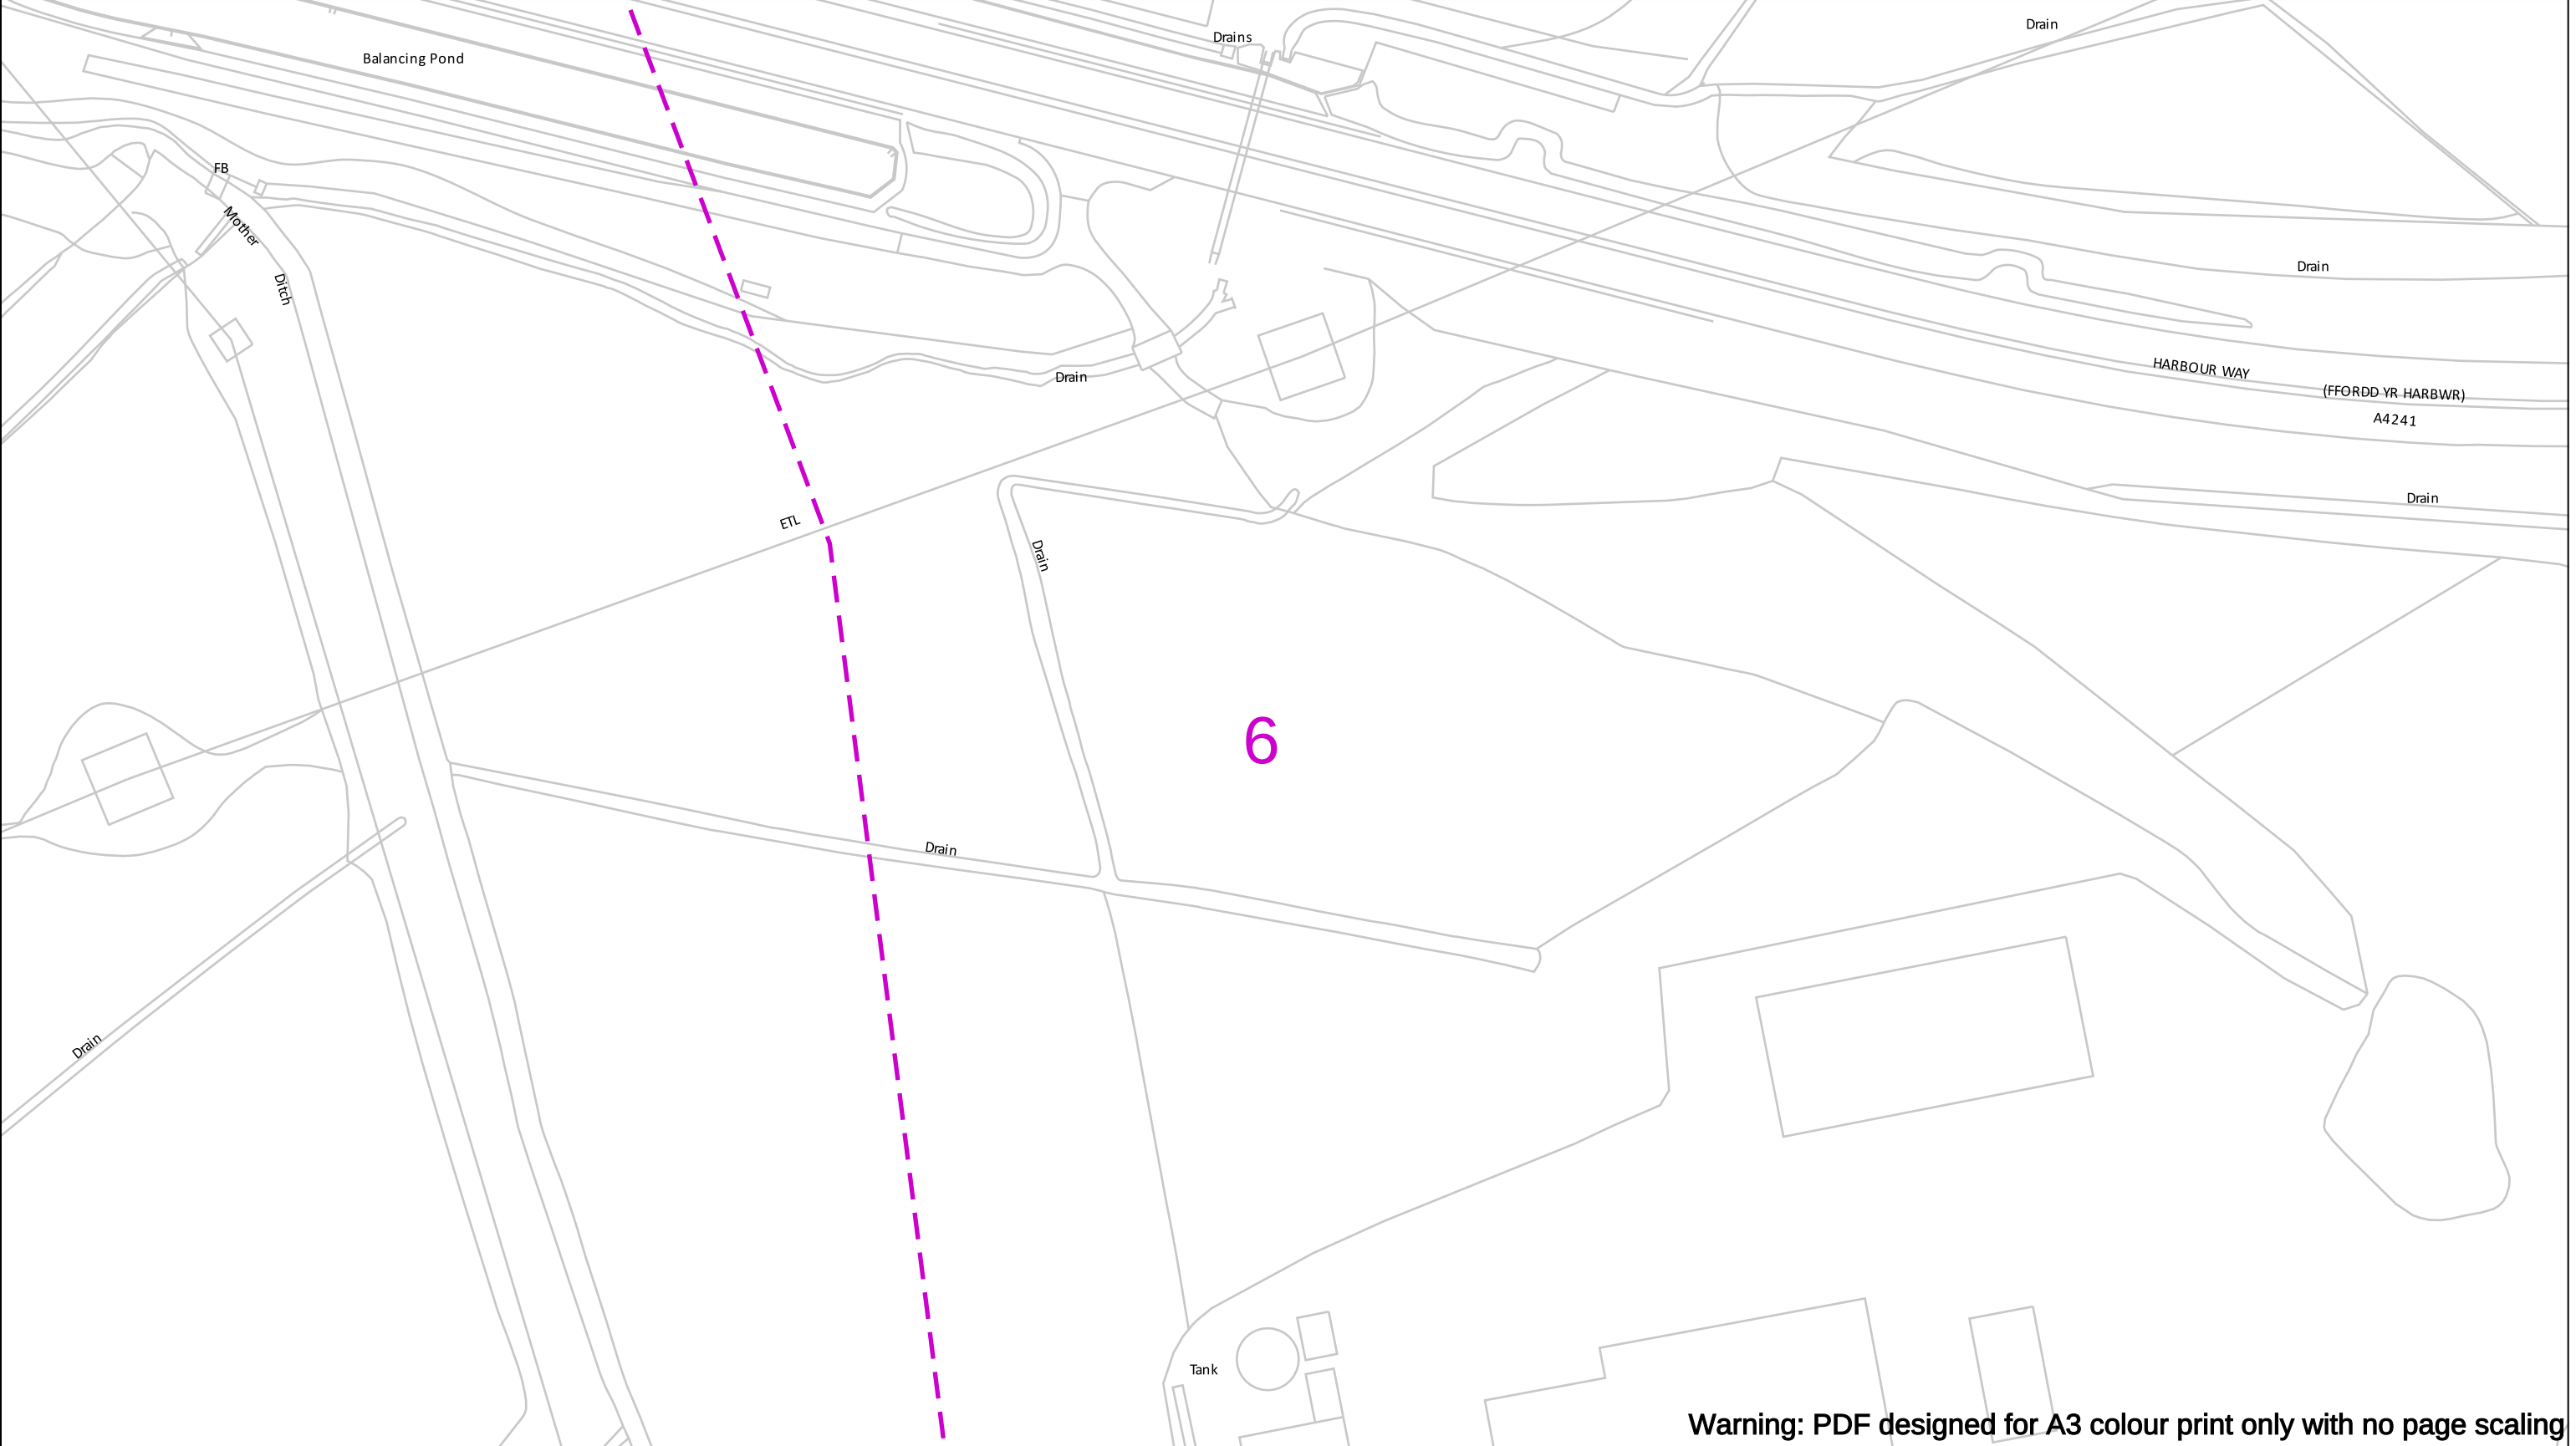

Warning: PDF designed for A3 colour print only with no page scaling


Contact Us Mapping Enquiries: 02920 278 912 General Enquiries: 0800 912 2999 Date Requested: 24/11/2023 Job Reference: 31654782 Site Location: 278649 186231 Requested by: Mr Farhan Aslam Your Scheme/Reference: NG TATA Steel Margam FEED Scale: 1:1250 (When plotted at A3)	EXTREME CAUTION. Major Accident Hazard Pipeline in Vicinity **RISK OF DEATH OR SERIOUS INJURY** Prior to excavation starting you must contact the plant protection team on 02920 278912 IMPORTANT NOTICES - This information is given as a guide only and its accuracy cannot be guaranteed - The plan only shows those pipes owned by Wales & West Utilities (WWU) as its role as a licensed Gas Transporter - Service pipes, valves, syphons, stub connections etc. may not be shown but their presence should be anticipated - You must use safe digging practices in accordance with HS(G)47 to establish the actual position of mains, services and other apparatus before any mechanical excavation is used - It is your responsibility to ensure this information is provided to all persons working near our plant - If in doubt call the WWU dig team on 02920 278912	In case of an emergency call 0800 111 999 Dig Sites Area: Line: Low Pressure (LP) 21mbar – 75mbar Medium Pressure (MP) 350mbar – 2bar Intermediate Pressure (IP) 2bar – 7bar High Pressure (HP) >7bar Line/Fire Valve Governor Station Change of Diameter End Cap Depth of cover	
---	---	--	-------------------------

Crown Copyright © - Reproduced by permission of Ordnance Survey on behalf of HMSO. And database right 2023. All rights reserved. Ordnance Survey Licence number 0100044308.




Warning: PDF designed for A3 colour print only with no page scaling

Contact Us Mapping Enquiries: 02920 278 912 General Enquiries: 0800 912 2999 Date Requested: 24/11/2023 Job Reference: 31654782 Site Location: 278649 186231 Requested by: Mr Farhan Aslam Your Scheme/Reference: NG TATA Steel Margam FEED Scale: 1:1250 (When plotted at A3)	EXTREME CAUTION. Major Accident Hazard Pipeline in Vicinity **RISK OF DEATH OR SERIOUS INJURY** Prior to excavation starting you must contact the plant protection team on 02920 278912 IMPORTANT NOTICES - This information is given as a guide only and its accuracy cannot be guaranteed - The plan only shows those pipes owned by Wales & West Utilities (WWU) as its role as a licensed Gas Transporter - Service pipes, valves, syphons, stub connections etc. may not be shown but their presence should be anticipated - You must use safe digging practices in accordance with HS(G)47 to establish the actual position of mains, services and other apparatus before any mechanical excavation is used - It is your responsibility to ensure this information is provided to all persons working near our plant - If in doubt call the WWU dig team on 02920 278912	In case of an emergency call 0800 111 999 Dig Sites Area: Line: Low Pressure (LP) 21mbar – 75mbar Medium Pressure (MP) 350mbar – 2bar Intermediate Pressure (IP) 2bar – 7bar High Pressure (HP) >7bar Line/Fire Valve Governor Station Change of Diameter End Cap Depth of cover
Crown Copyright © - Reproduced by permission of Ordnance Survey on behalf of HMSO. And database right 2023. All rights reserved. Ordnance Survey Licence number 0100044308.		

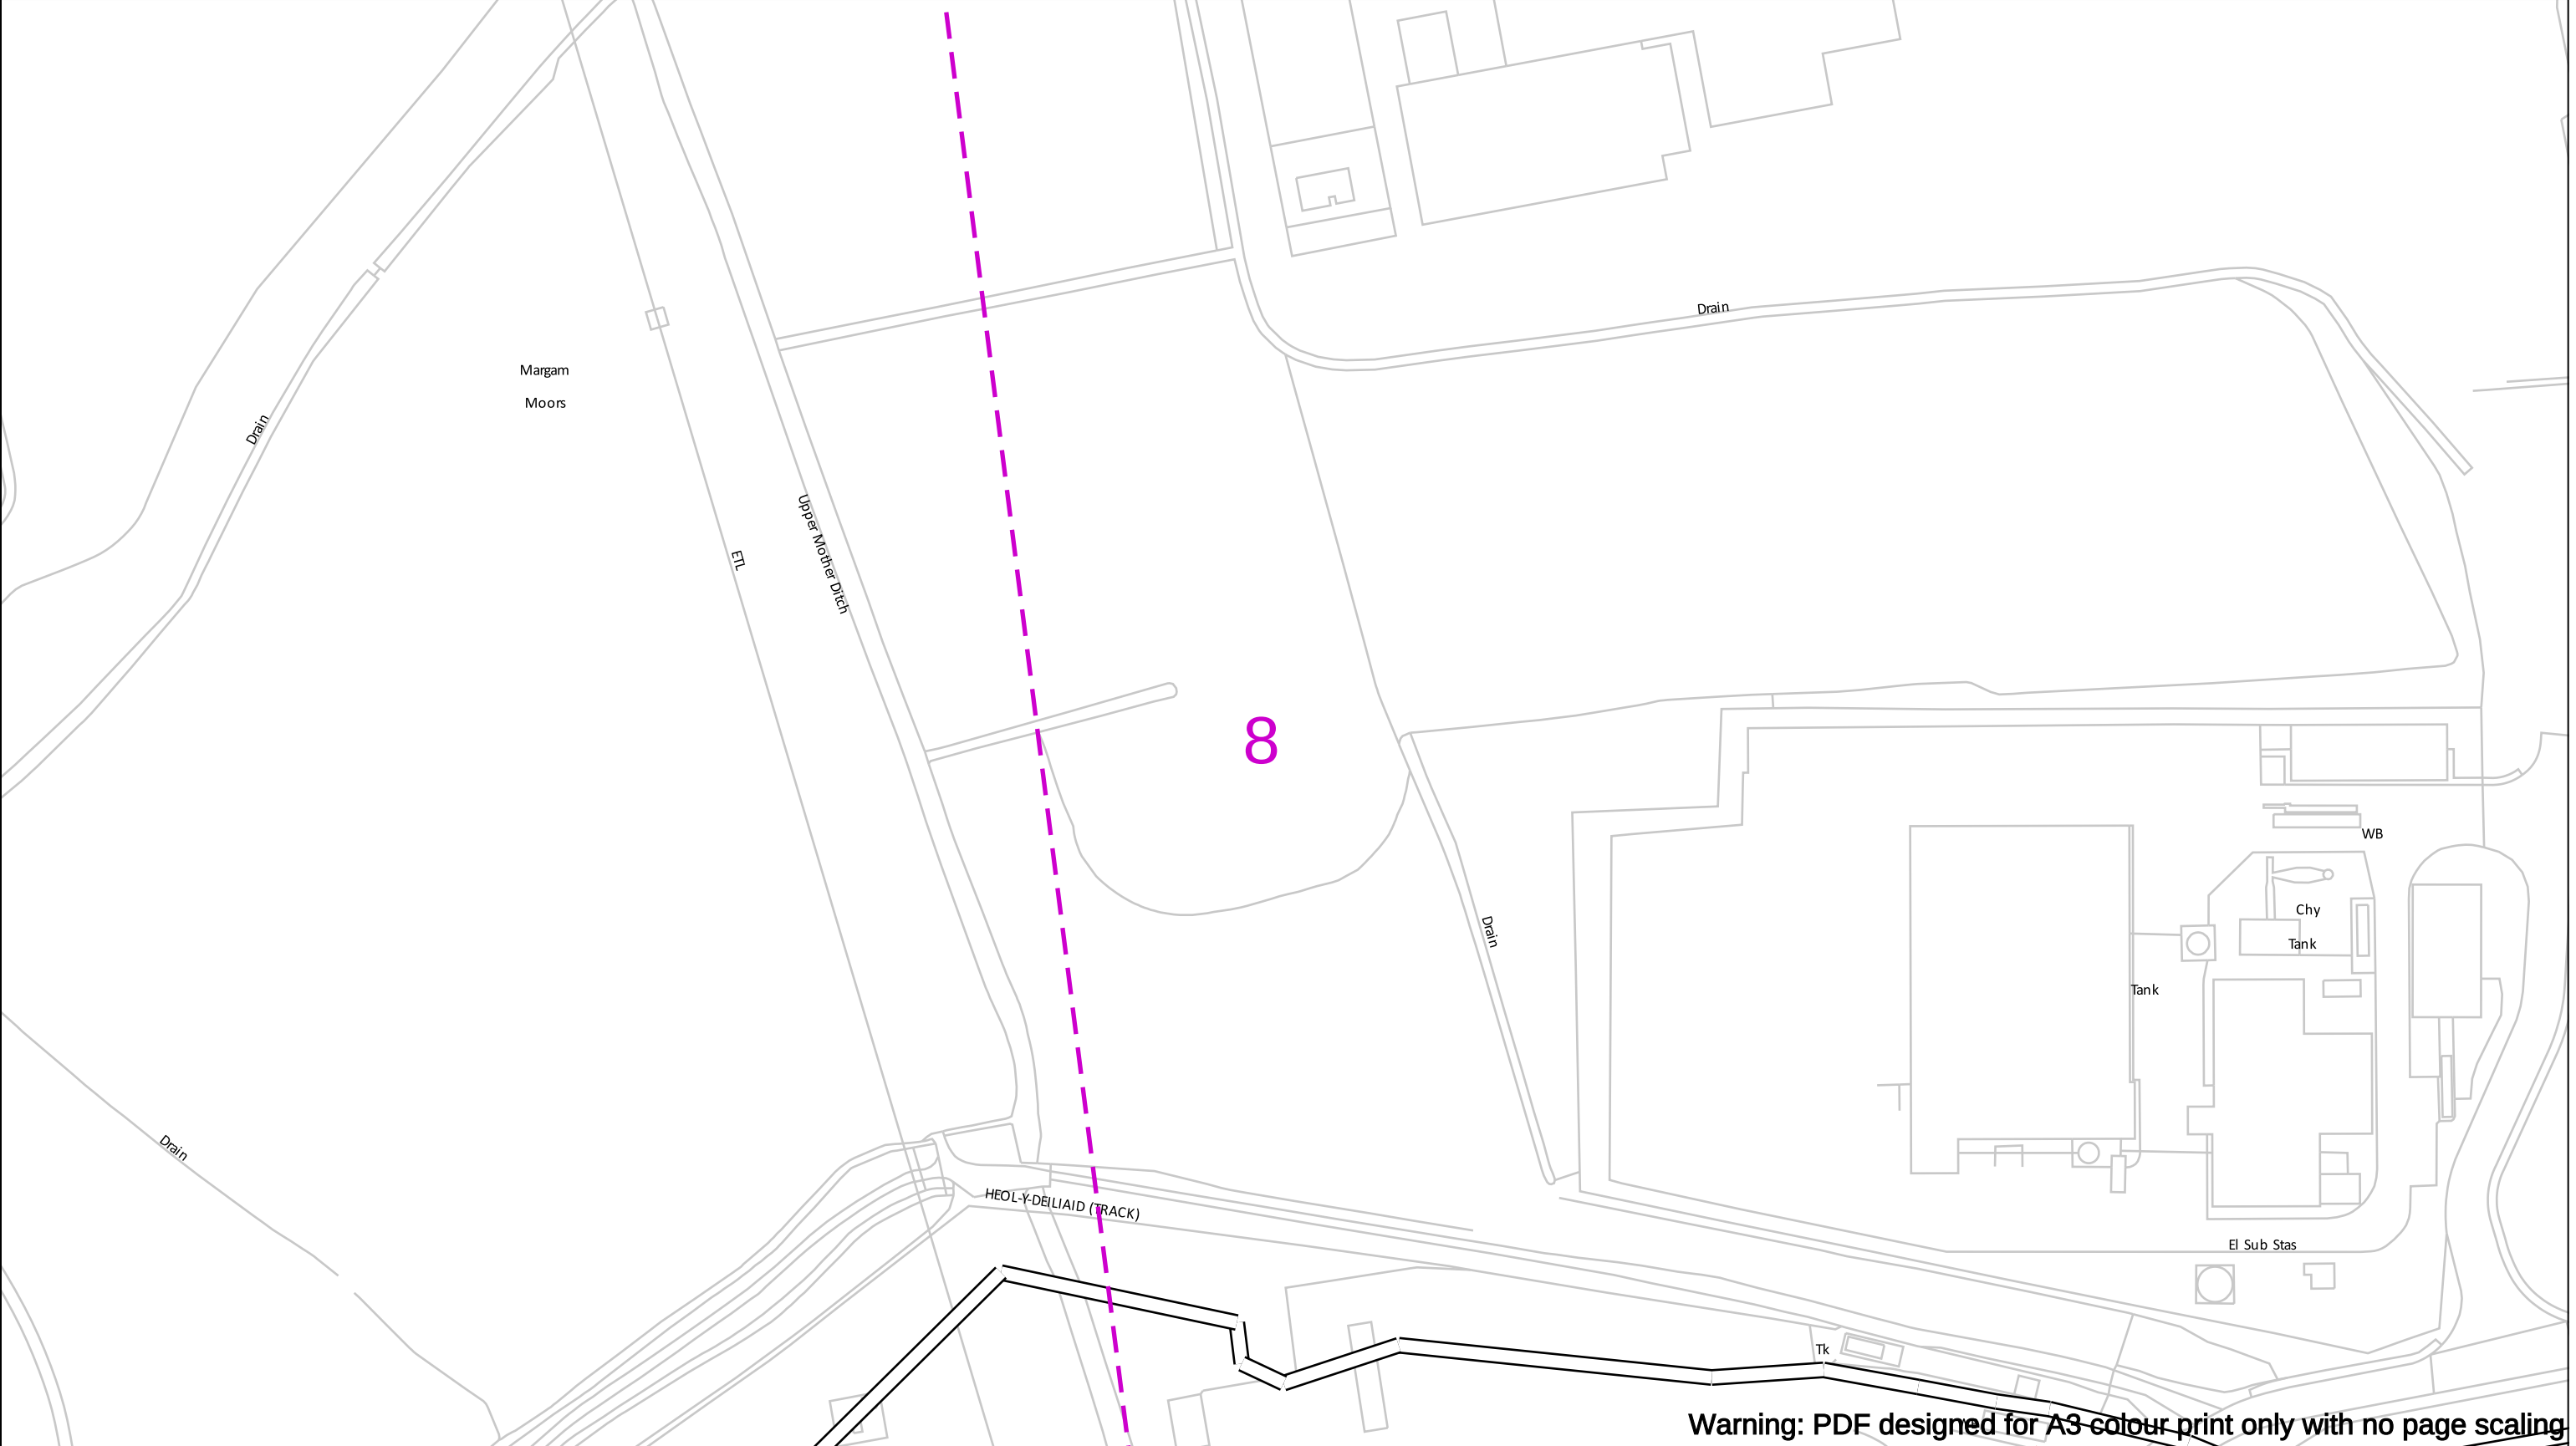

Warning: PDF designed for A3 colour print only with no page scaling


Contact Us Mapping Enquiries: 02920 278 912 General Enquiries: 0800 912 2999 Date Requested: 24/11/2023 Job Reference: 31654782 Site Location: 278649 186231 Requested by: Mr Farhan Aslam Your Scheme/Reference: NG TATA Steel Margam FEED Scale: 1:1250 (When plotted at A3)	EXTREME CAUTION. Major Accident Hazard Pipeline in Vicinity **RISK OF DEATH OR SERIOUS INJURY** Prior to excavation starting you must contact the plant protection team on 02920 278912 IMPORTANT NOTICES - This information is given as a guide only and its accuracy cannot be guaranteed - The plan only shows those pipes owned by Wales & West Utilities (WWU) as its role as a licensed Gas Transporter - Service pipes, valves, syphons, stub connections etc. may not be shown but their presence should be anticipated - You must use safe digging practices in accordance with HS(G)47 to establish the actual position of mains, services and other apparatus before any mechanical excavation is used - It is your responsibility to ensure this information is provided to all persons working near our plant - If in doubt call the WWU dig team on 02920 278912	In case of an emergency call 0800 111 999 Dig Sites Area: Line: Low Pressure (LP) 21mbar – 75mbar Medium Pressure (MP) 350mbar – 2bar Intermediate Pressure (IP) 2bar – 7bar High Pressure (HP) >7bar Line/Fire Valve Governor Station Change of Diameter End Cap Depth of cover	
---	---	--	-------------------------

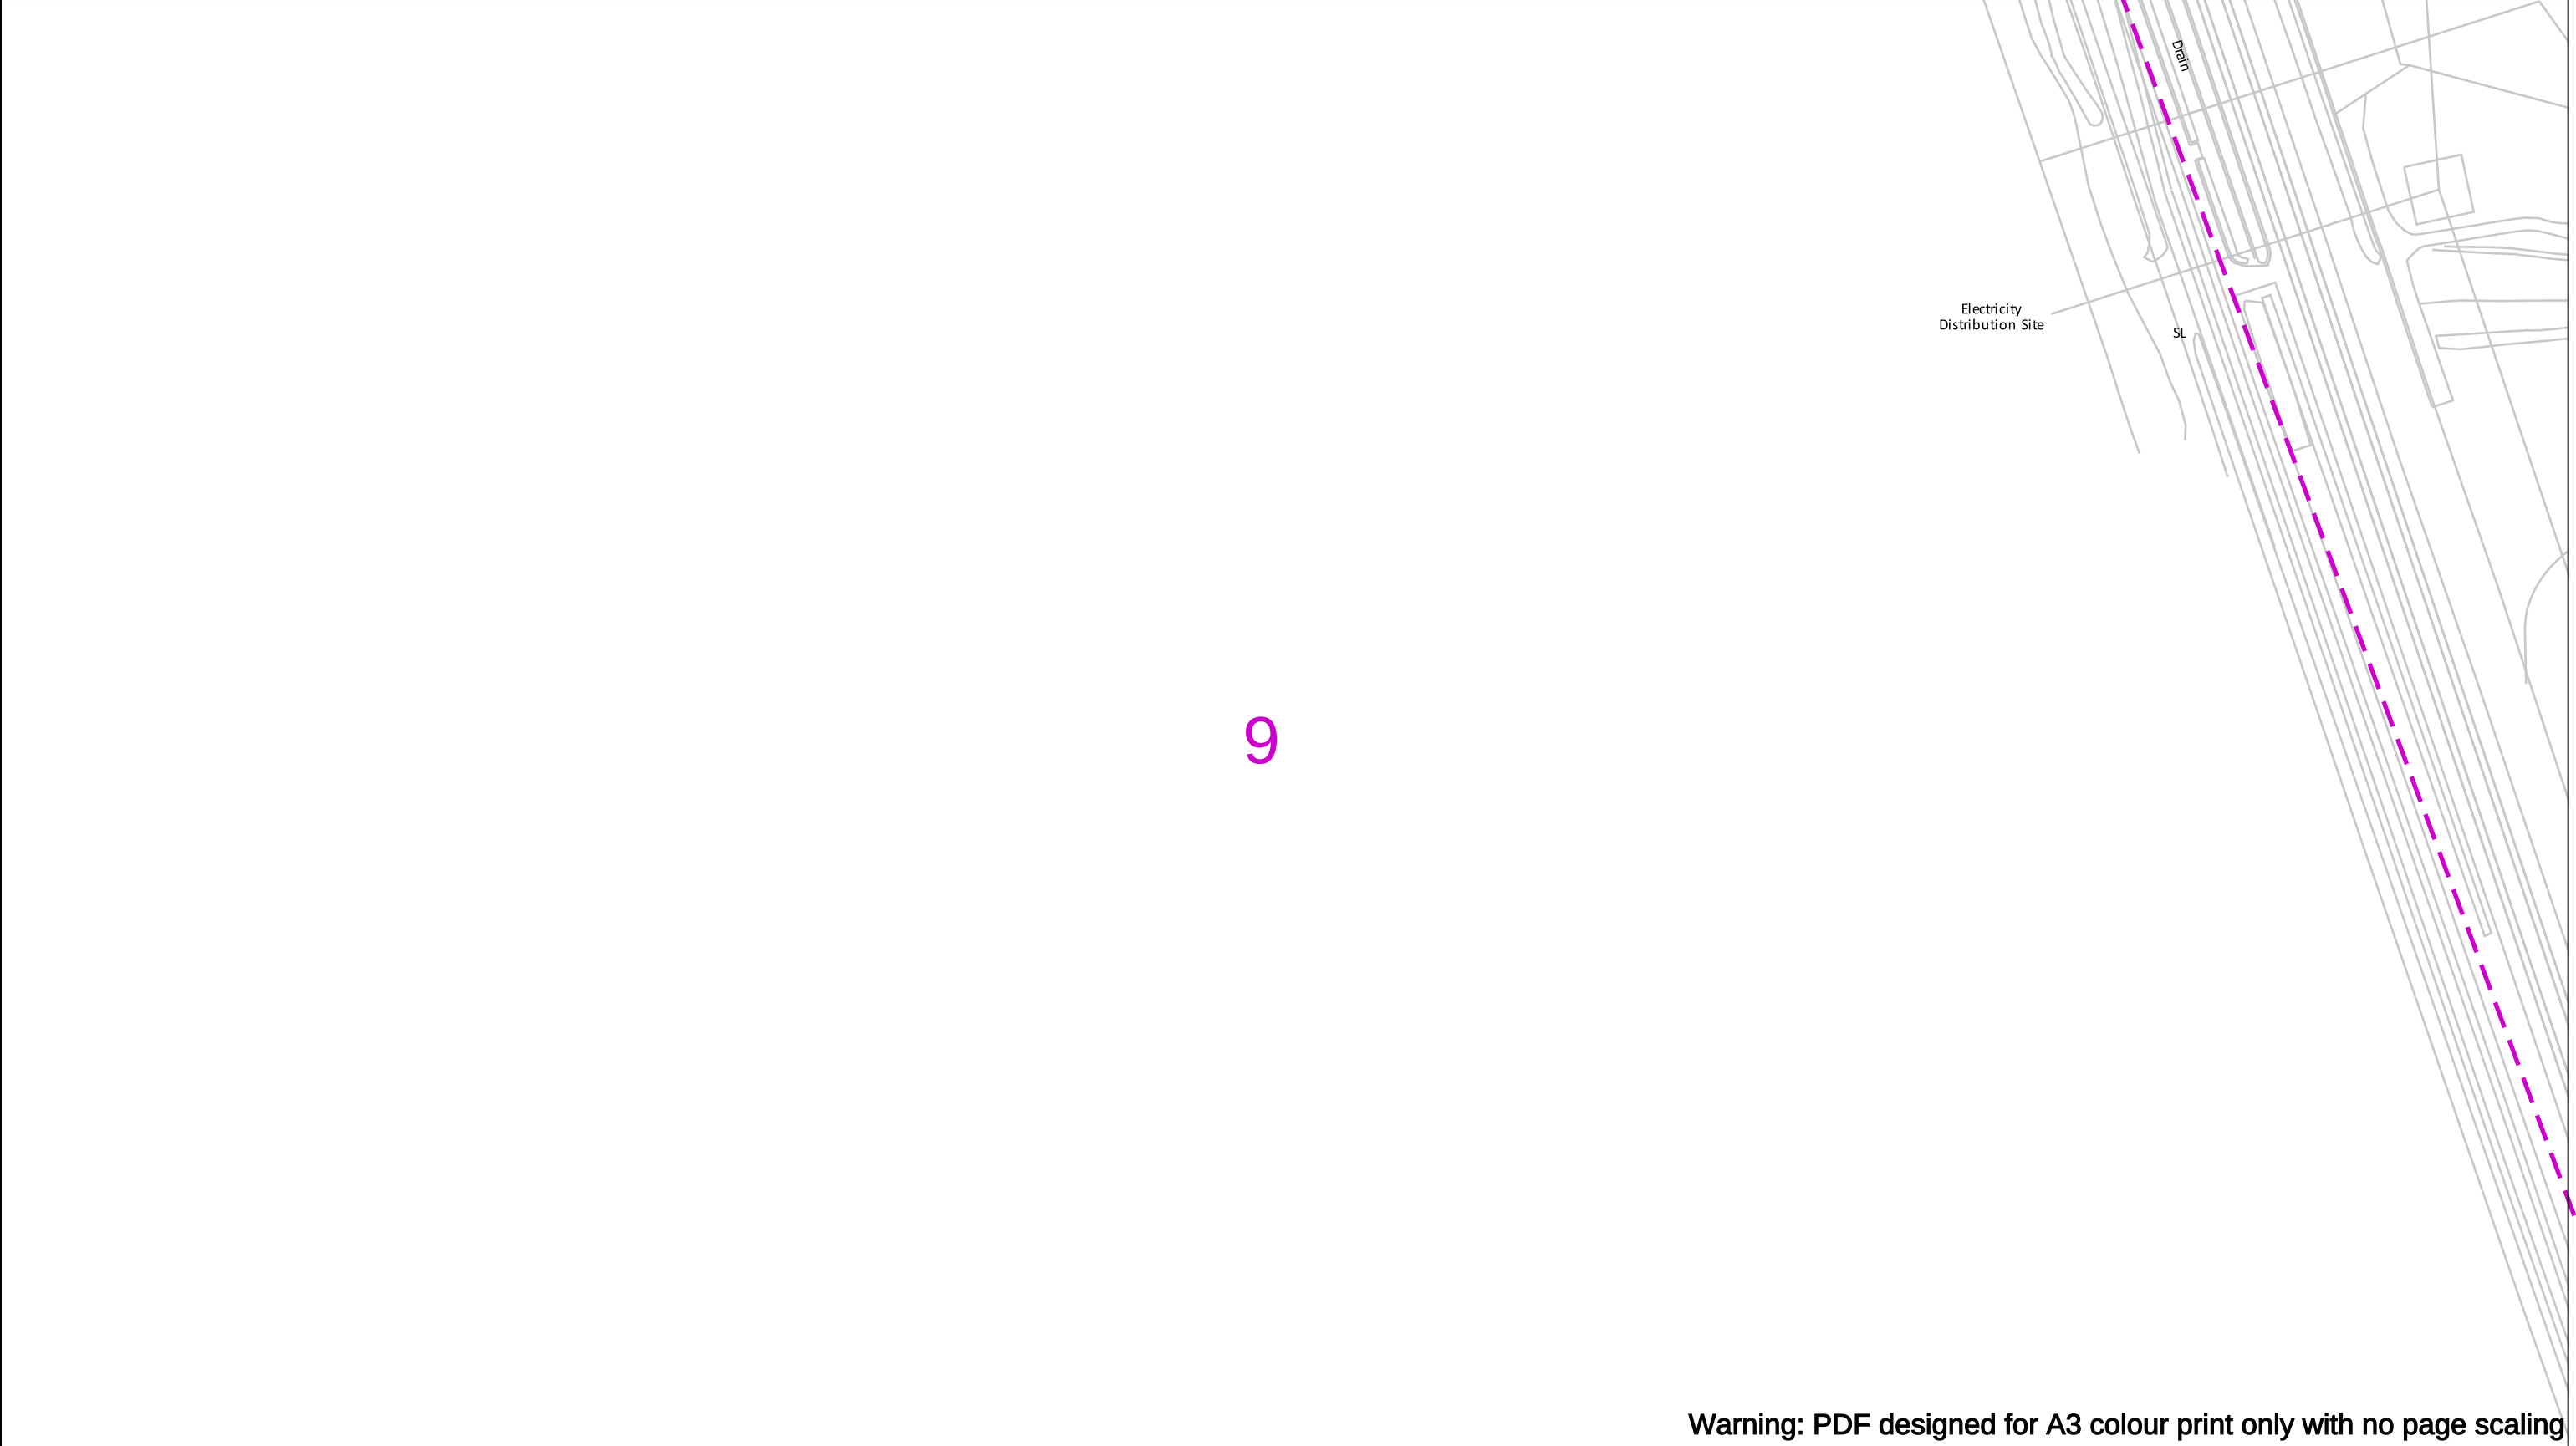

Warning: PDF designed for A3 colour print only with no page scaling

Contact Us Mapping Enquiries: 02920 278 912 General Enquiries: 0800 912 2999 Date Requested: 24/11/2023 Job Reference: 31654782 Site Location: 278649 186231 Requested by: Mr Farhan Aslam Your Scheme/Reference: NG TATA Steel Margam FEED Scale: 1:1250 (When plotted at A3)	EXTREME CAUTION. Major Accident Hazard Pipeline in Vicinity **RISK OF DEATH OR SERIOUS INJURY** Prior to excavation starting you must contact the plant protection team on 02920 278912 IMPORTANT NOTICES - This information is given as a guide only and its accuracy cannot be guaranteed - The plan only shows those pipes owned by Wales & West Utilities (WWU) as its role as a licensed Gas Transporter - Service pipes, valves, syphons, stub connections etc. may not be shown but their presence should be anticipated - You must use safe digging practices in accordance with HS(G)47 to establish the actual position of mains, services and other apparatus before any mechanical excavation is used - It is your responsibility to ensure this information is provided to all persons working near our plant - If in doubt call the WWU dig team on 02920 278912	In case of an emergency call 0800 111 999 Dig Sites Area: Line: Low Pressure (LP) 21mbar – 75mbar Medium Pressure (MP) 350mbar – 2bar Intermediate Pressure (IP) 2bar – 7bar High Pressure (HP) >7bar Line/Fire Valve Governor Station Change of Diameter End Cap Depth of cover
---	---	--

Crown Copyright © - Reproduced by permission of Ordnance Survey on behalf of HMSO. And database right 2023. All rights reserved. Ordnance Survey Licence number 0100044308.

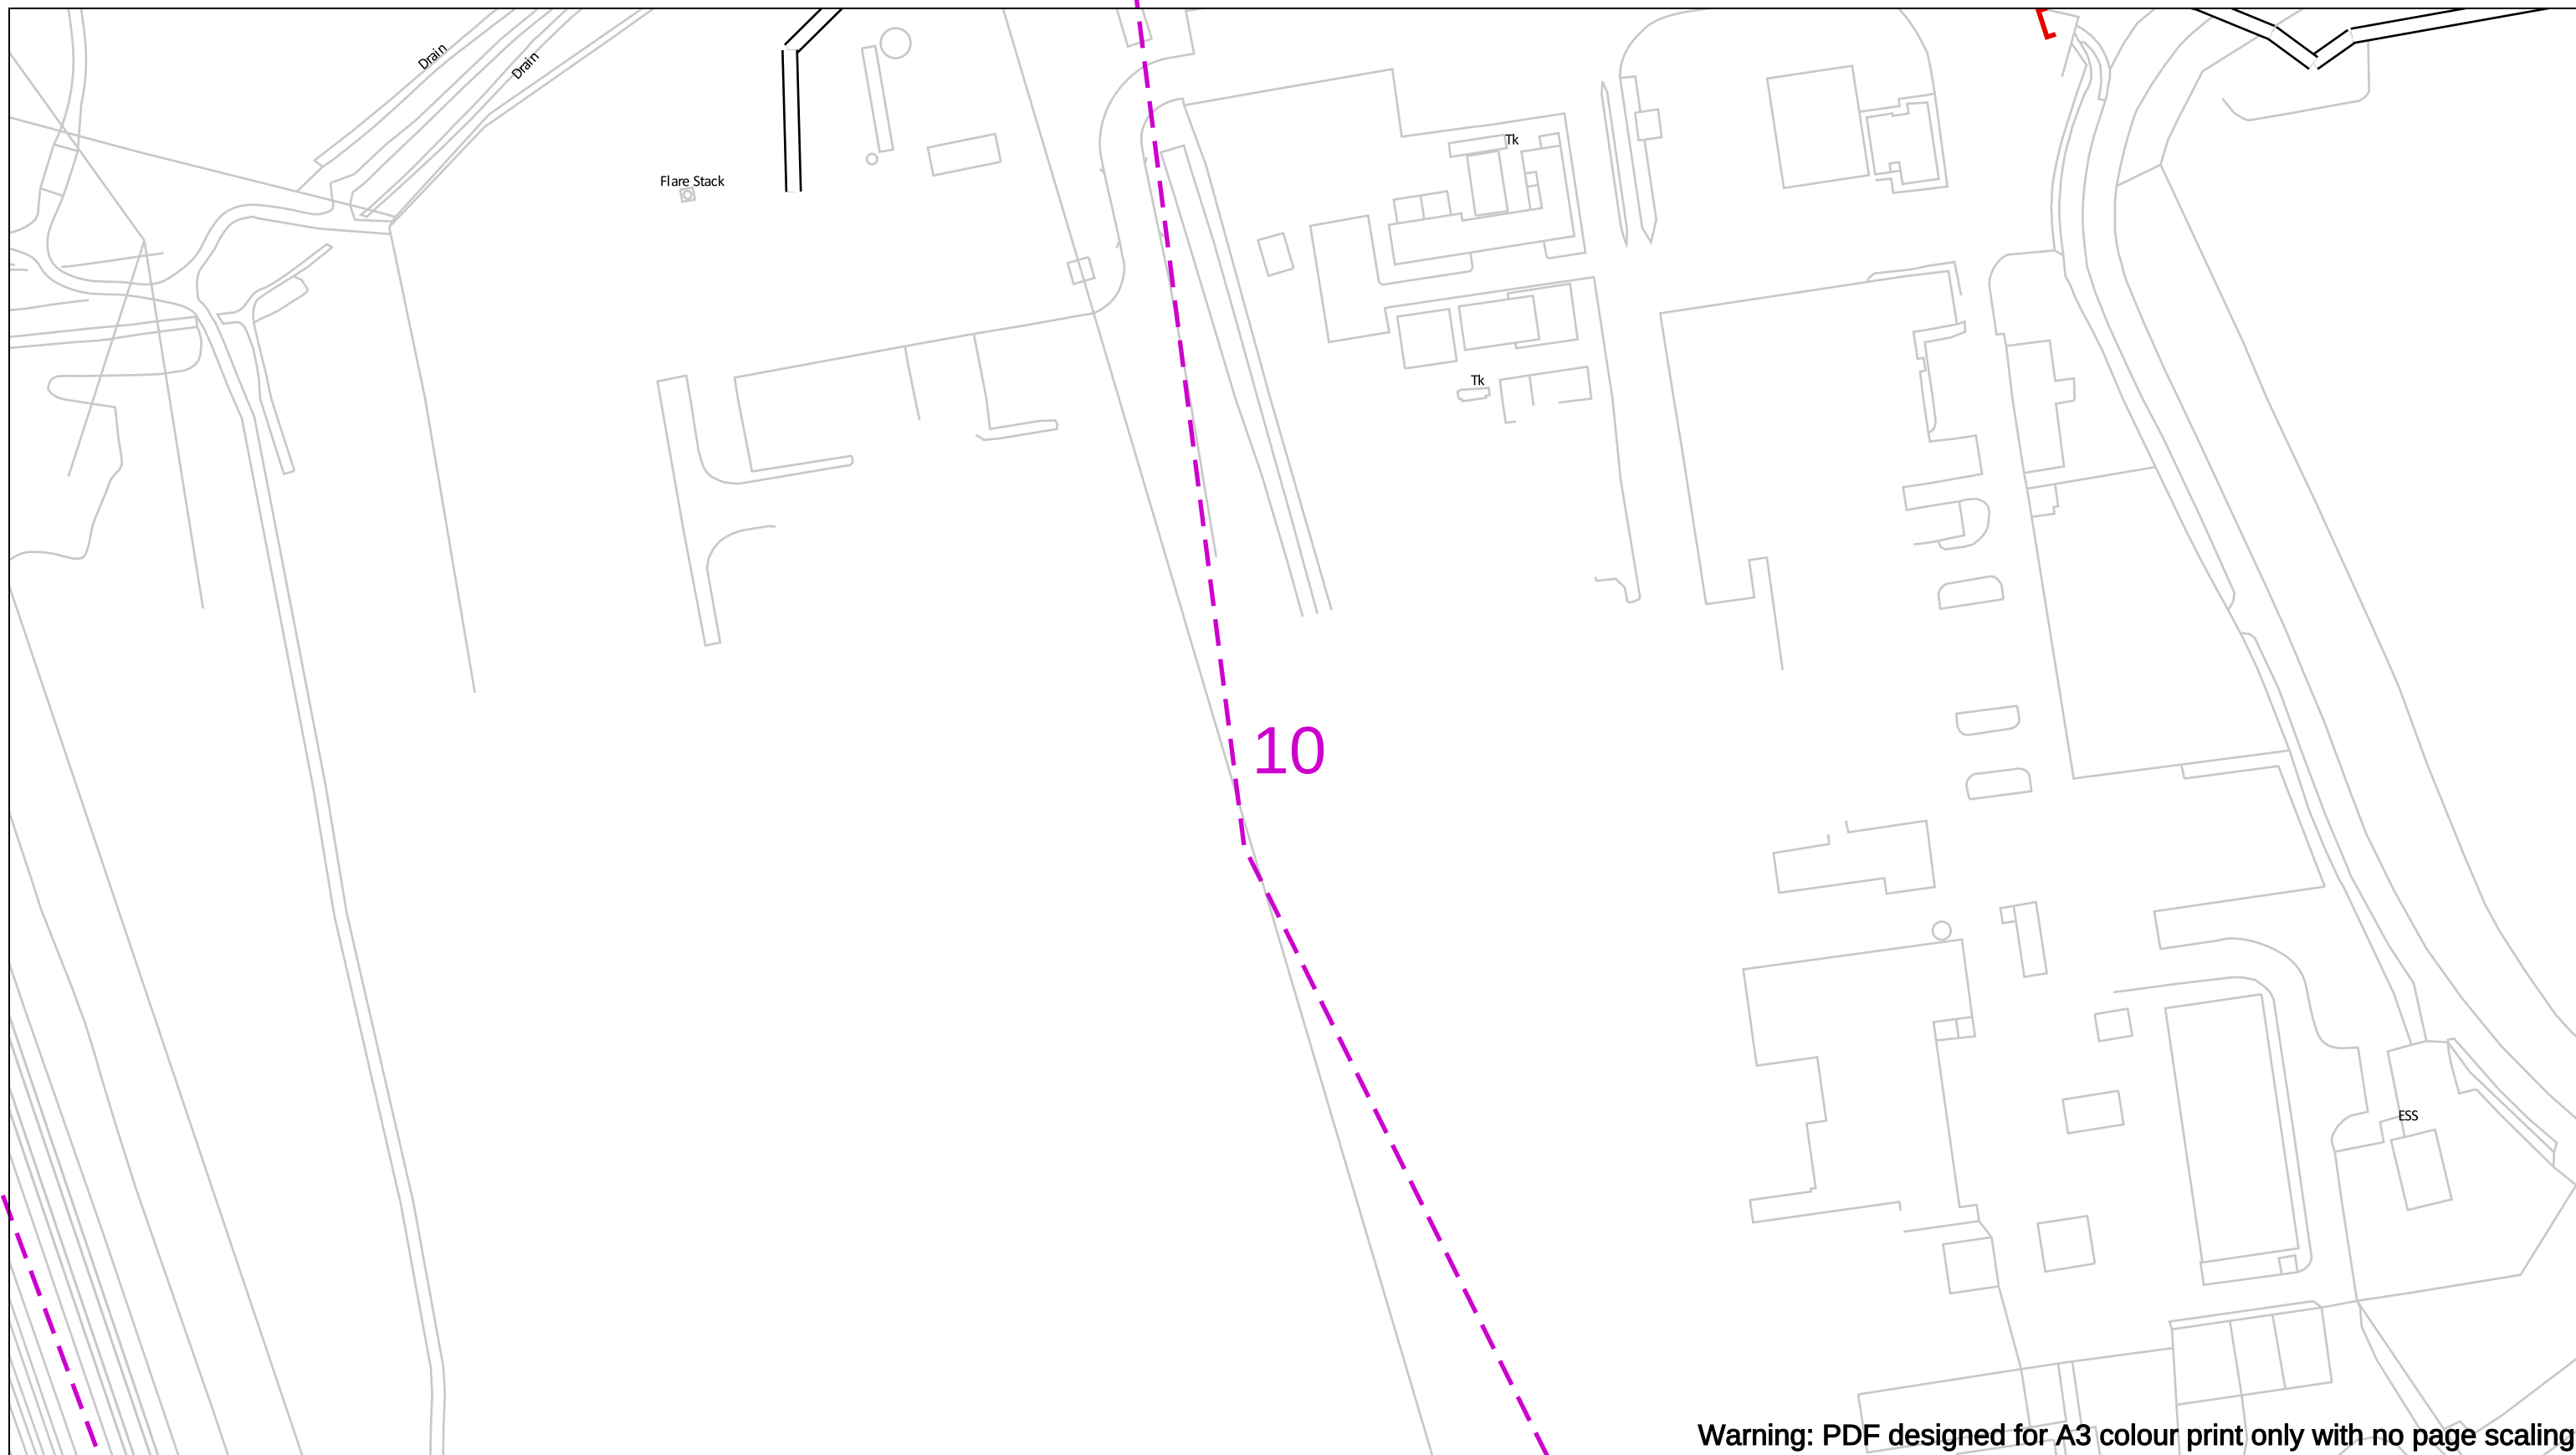

Warning: PDF designed for A3 colour print only with no page scaling

Contact Us
Mapping Enquiries: 02920 278 912
General Enquiries: 0800 912 2999

Date Requested: 24/11/2023
Job Reference: 31654782
Site Location: 278649 186231
Requested by:
Mr Farhan Aslam
Your Scheme/Reference: NG TATA
Steel Margam FEED


Scale: 1:1250 (When plotted at A3)

EXTREME CAUTION. Major Accident Hazard Pipeline in Vicinity
****RISK OF DEATH OR SERIOUS INJURY****
 Prior to excavation starting you must contact the plant
 protection team on 02920 278912

IMPORTANT NOTICES


- This information is given as a guide only and its accuracy cannot be guaranteed
- The plan only shows those pipes owned by Wales & West Utilities (WWU) as its role as a licensed Gas Transporter
- Service pipes, valves, syphons, stub connections etc. may not be shown but their presence should be anticipated
- You must use safe digging practices in accordance with HS(G)47 to establish the actual position of mains, services and other apparatus before any mechanical excavation is used
- It is your responsibility to ensure this information is provided to all persons working near our plant
- If in doubt call the WWU dig team on 02920 278912

In case of an emergency call 0800 111 999

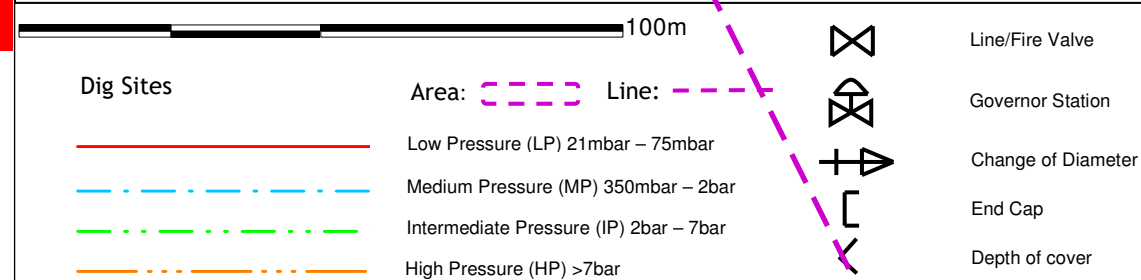

Warning: PDF designed for A3 colour print only with no page scaling

Contact Us Mapping Enquiries: 02920 278 912 General Enquiries: 0800 912 2999 Date Requested: 24/11/2023 Job Reference: 31654782 Site Location: 278649 186231 Requested by: Mr Farhan Aslam Your Scheme/Reference: NG TATA Steel Margam FEED Scale: 1:1250 (When plotted at A3)	EXTREME CAUTION. Major Accident Hazard Pipeline in Vicinity **RISK OF DEATH OR SERIOUS INJURY** Prior to excavation starting you must contact the plant protection team on 02920 278912 IMPORTANT NOTICES - This information is given as a guide only and its accuracy cannot be guaranteed - The plan only shows those pipes owned by Wales & West Utilities (WWU) as its role as a licensed Gas Transporter - Service pipes, valves, syphons, stub connections etc. may not be shown but their presence should be anticipated - You must use safe digging practices in accordance with HS(G)47 to establish the actual position of mains, services and other apparatus before any mechanical excavation is used - It is your responsibility to ensure this information is provided to all persons working near our plant - If in doubt call the WWU dig team on 02920 278912	In case of an emergency call 0800 111 999 Dig Sites Low Pressure (LP) 21mbar – 75mbar Medium Pressure (MP) 350mbar – 2bar Intermediate Pressure (IP) 2bar – 7bar High Pressure (HP) >7bar Area: Line: Line/Fire Valve Governor Station Change of Diameter End Cap Depth of cover	
---	---	---	-------------------------

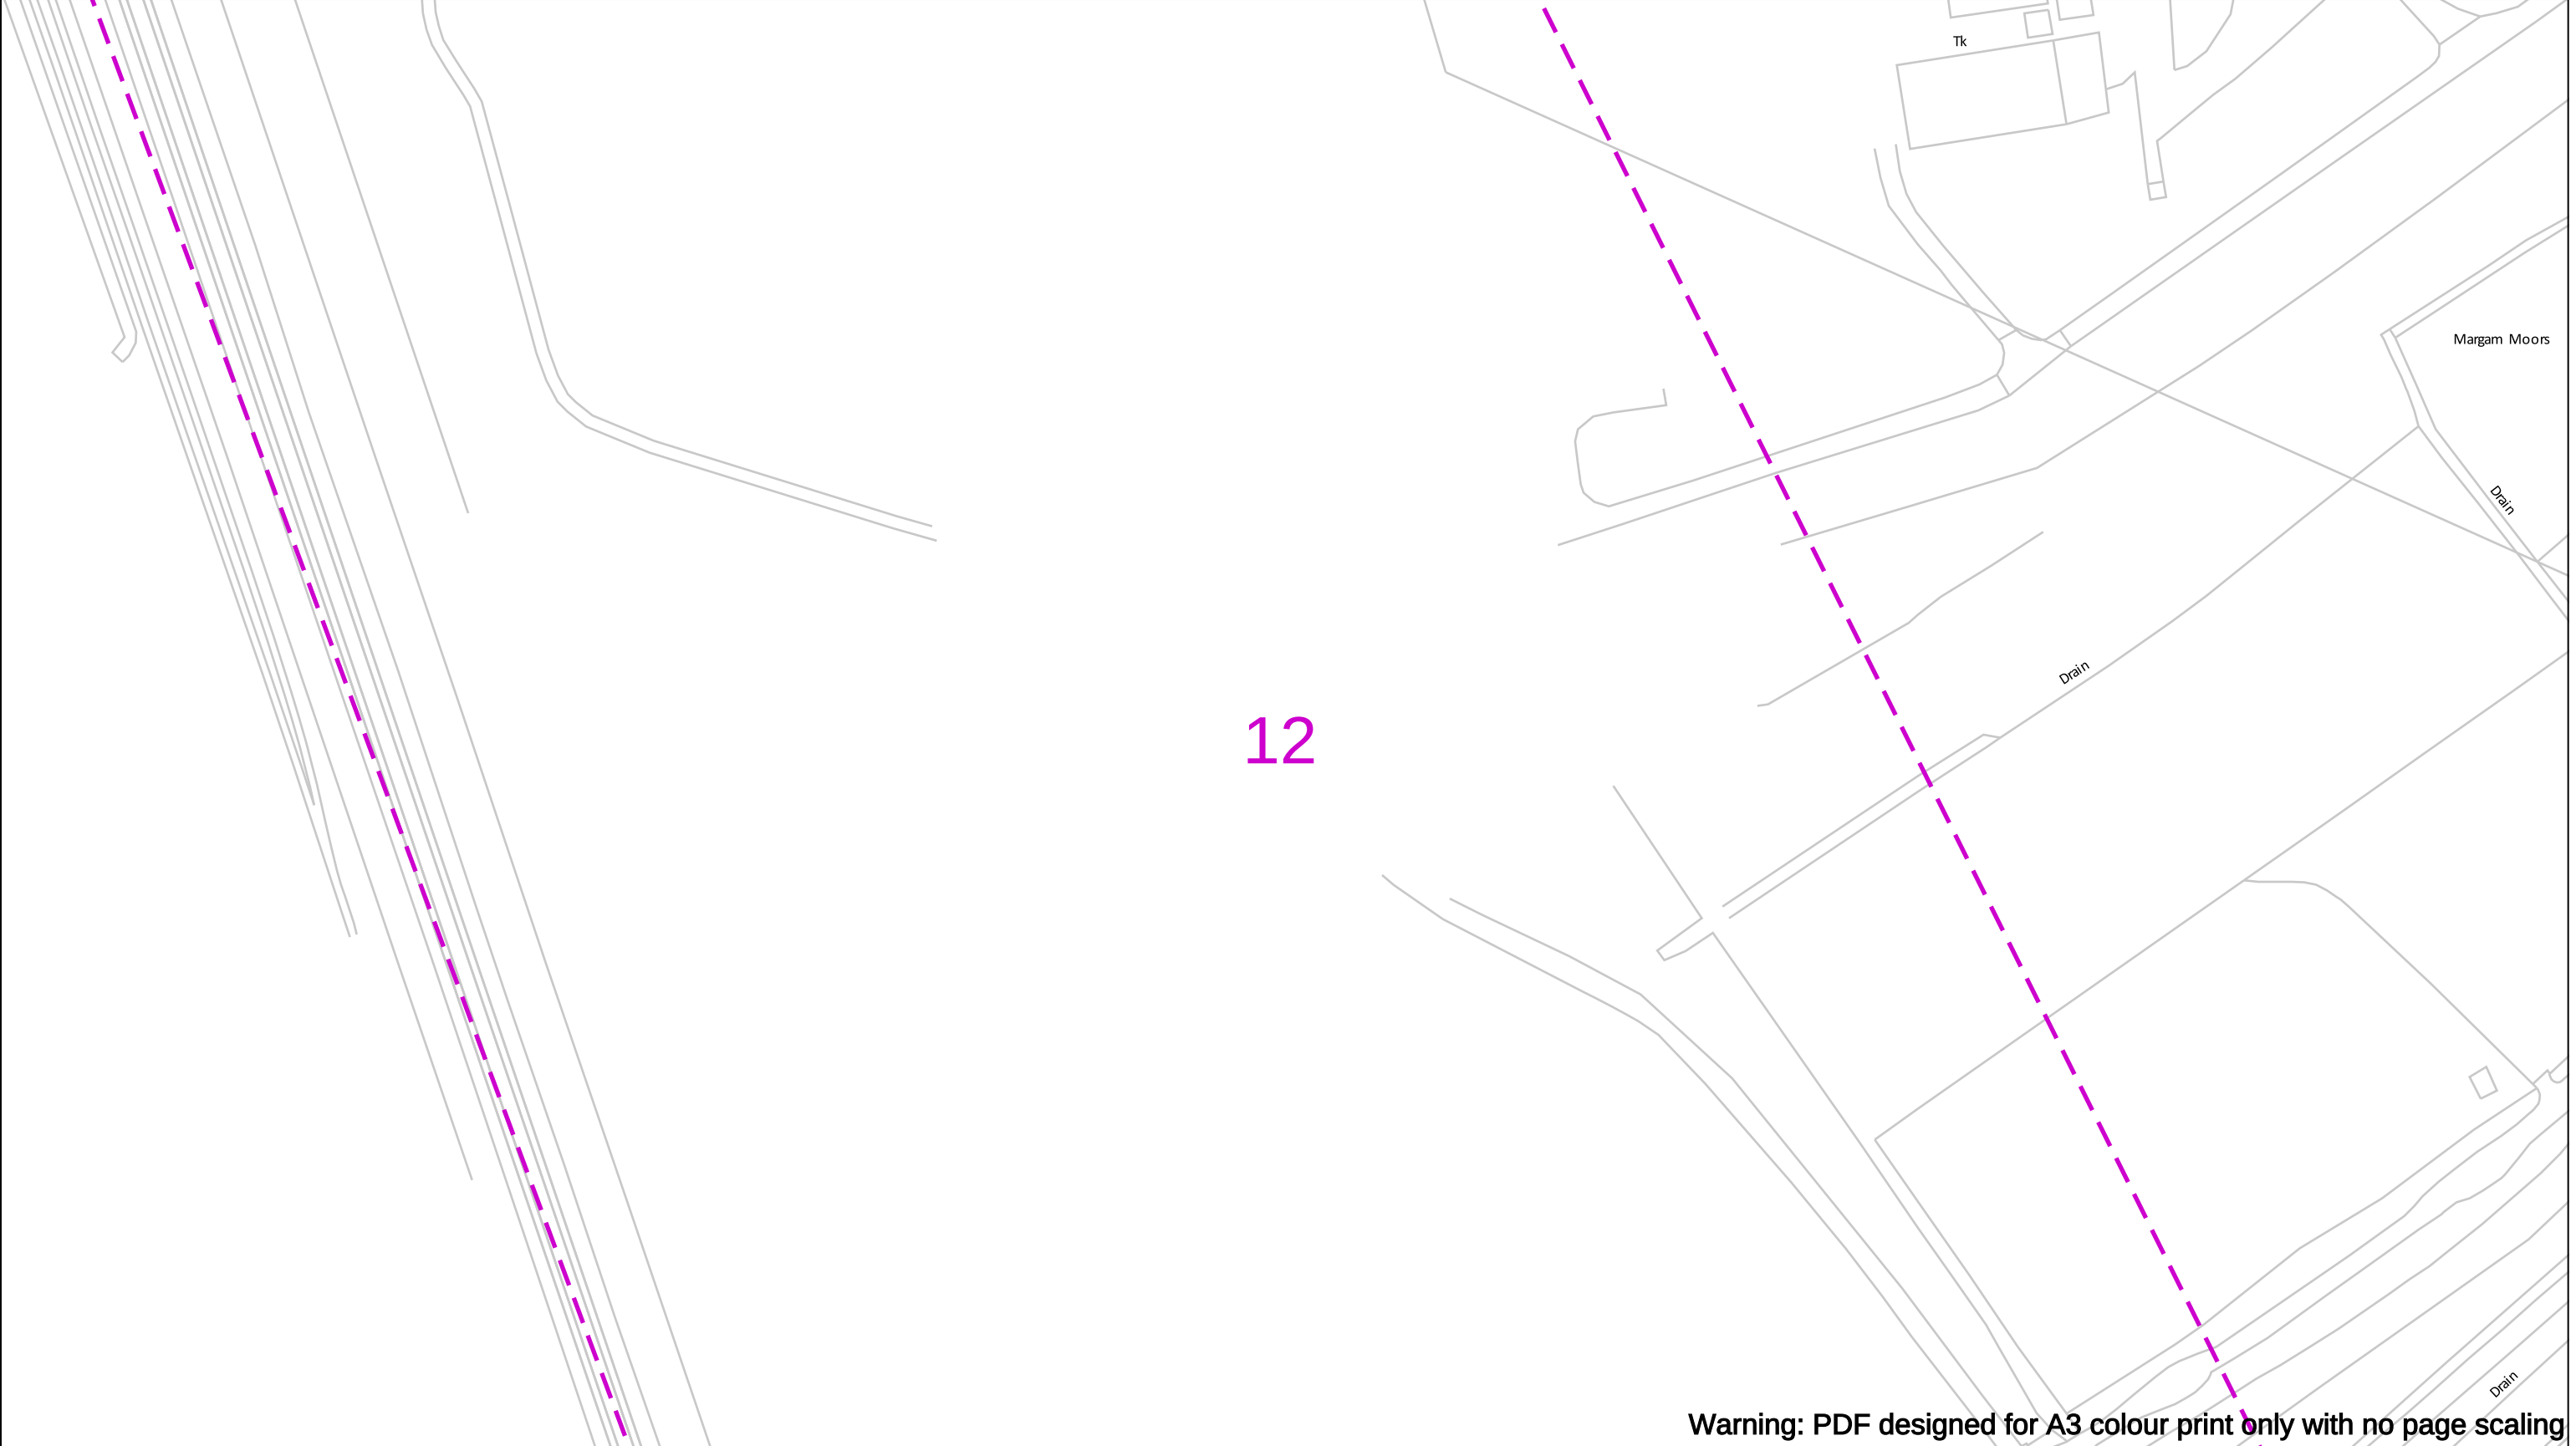

Warning: PDF designed for A3 colour print only with no page scaling

Contact Us
Mapping Enquiries: 02920 278 912
General Enquiries: 0800 912 2999

Date Requested: 24/11/2023
Job Reference: 31654782
Site Location: 278649 186231
Requested by:
Mr Farhan Aslam
Your Scheme/Reference: NG TATA Steel Margam FEED

Scale: 1:1250 (When plotted at A3)

EXTREME CAUTION. Major Accident Hazard Pipeline in Vicinity
****RISK OF DEATH OR SERIOUS INJURY****
Prior to excavation starting you must contact the plant protection team on 02920 278912

IMPORTANT NOTICES

- This information is given as a guide only and its accuracy cannot be guaranteed
- The plan only shows those pipes owned by Wales & West Utilities (WWU) as its role as a licensed Gas Transporter
- Service pipes, valves, syphons, stub connections etc. may not be shown but their presence should be anticipated
- You must use safe digging practices in accordance with HS(G)47 to establish the actual position of mains, services and other apparatus before any mechanical excavation is used
- It is your responsibility to ensure this information is provided to all persons working near our plant
- If in doubt call the WWU dig team on 02920 278912


In case of an emergency call 0800 111 999

100m

Dig Sites	Area:	Line:
	Low Pressure (LP) 21mbar – 75mbar	
	Medium Pressure (MP) 350mbar – 2bar	
	Intermediate Pressure (IP) 2bar – 7bar	
	High Pressure (HP) >7bar	


	Line/Fire Valve
	Governor Station
	Change of Diameter
	End Cap
	Depth of cover

Crown Copyright © - Reproduced by permission of Ordnance Survey on behalf of HMSO. And database right 2023. All rights reserved. Ordnance Survey Licence number 0100044308.

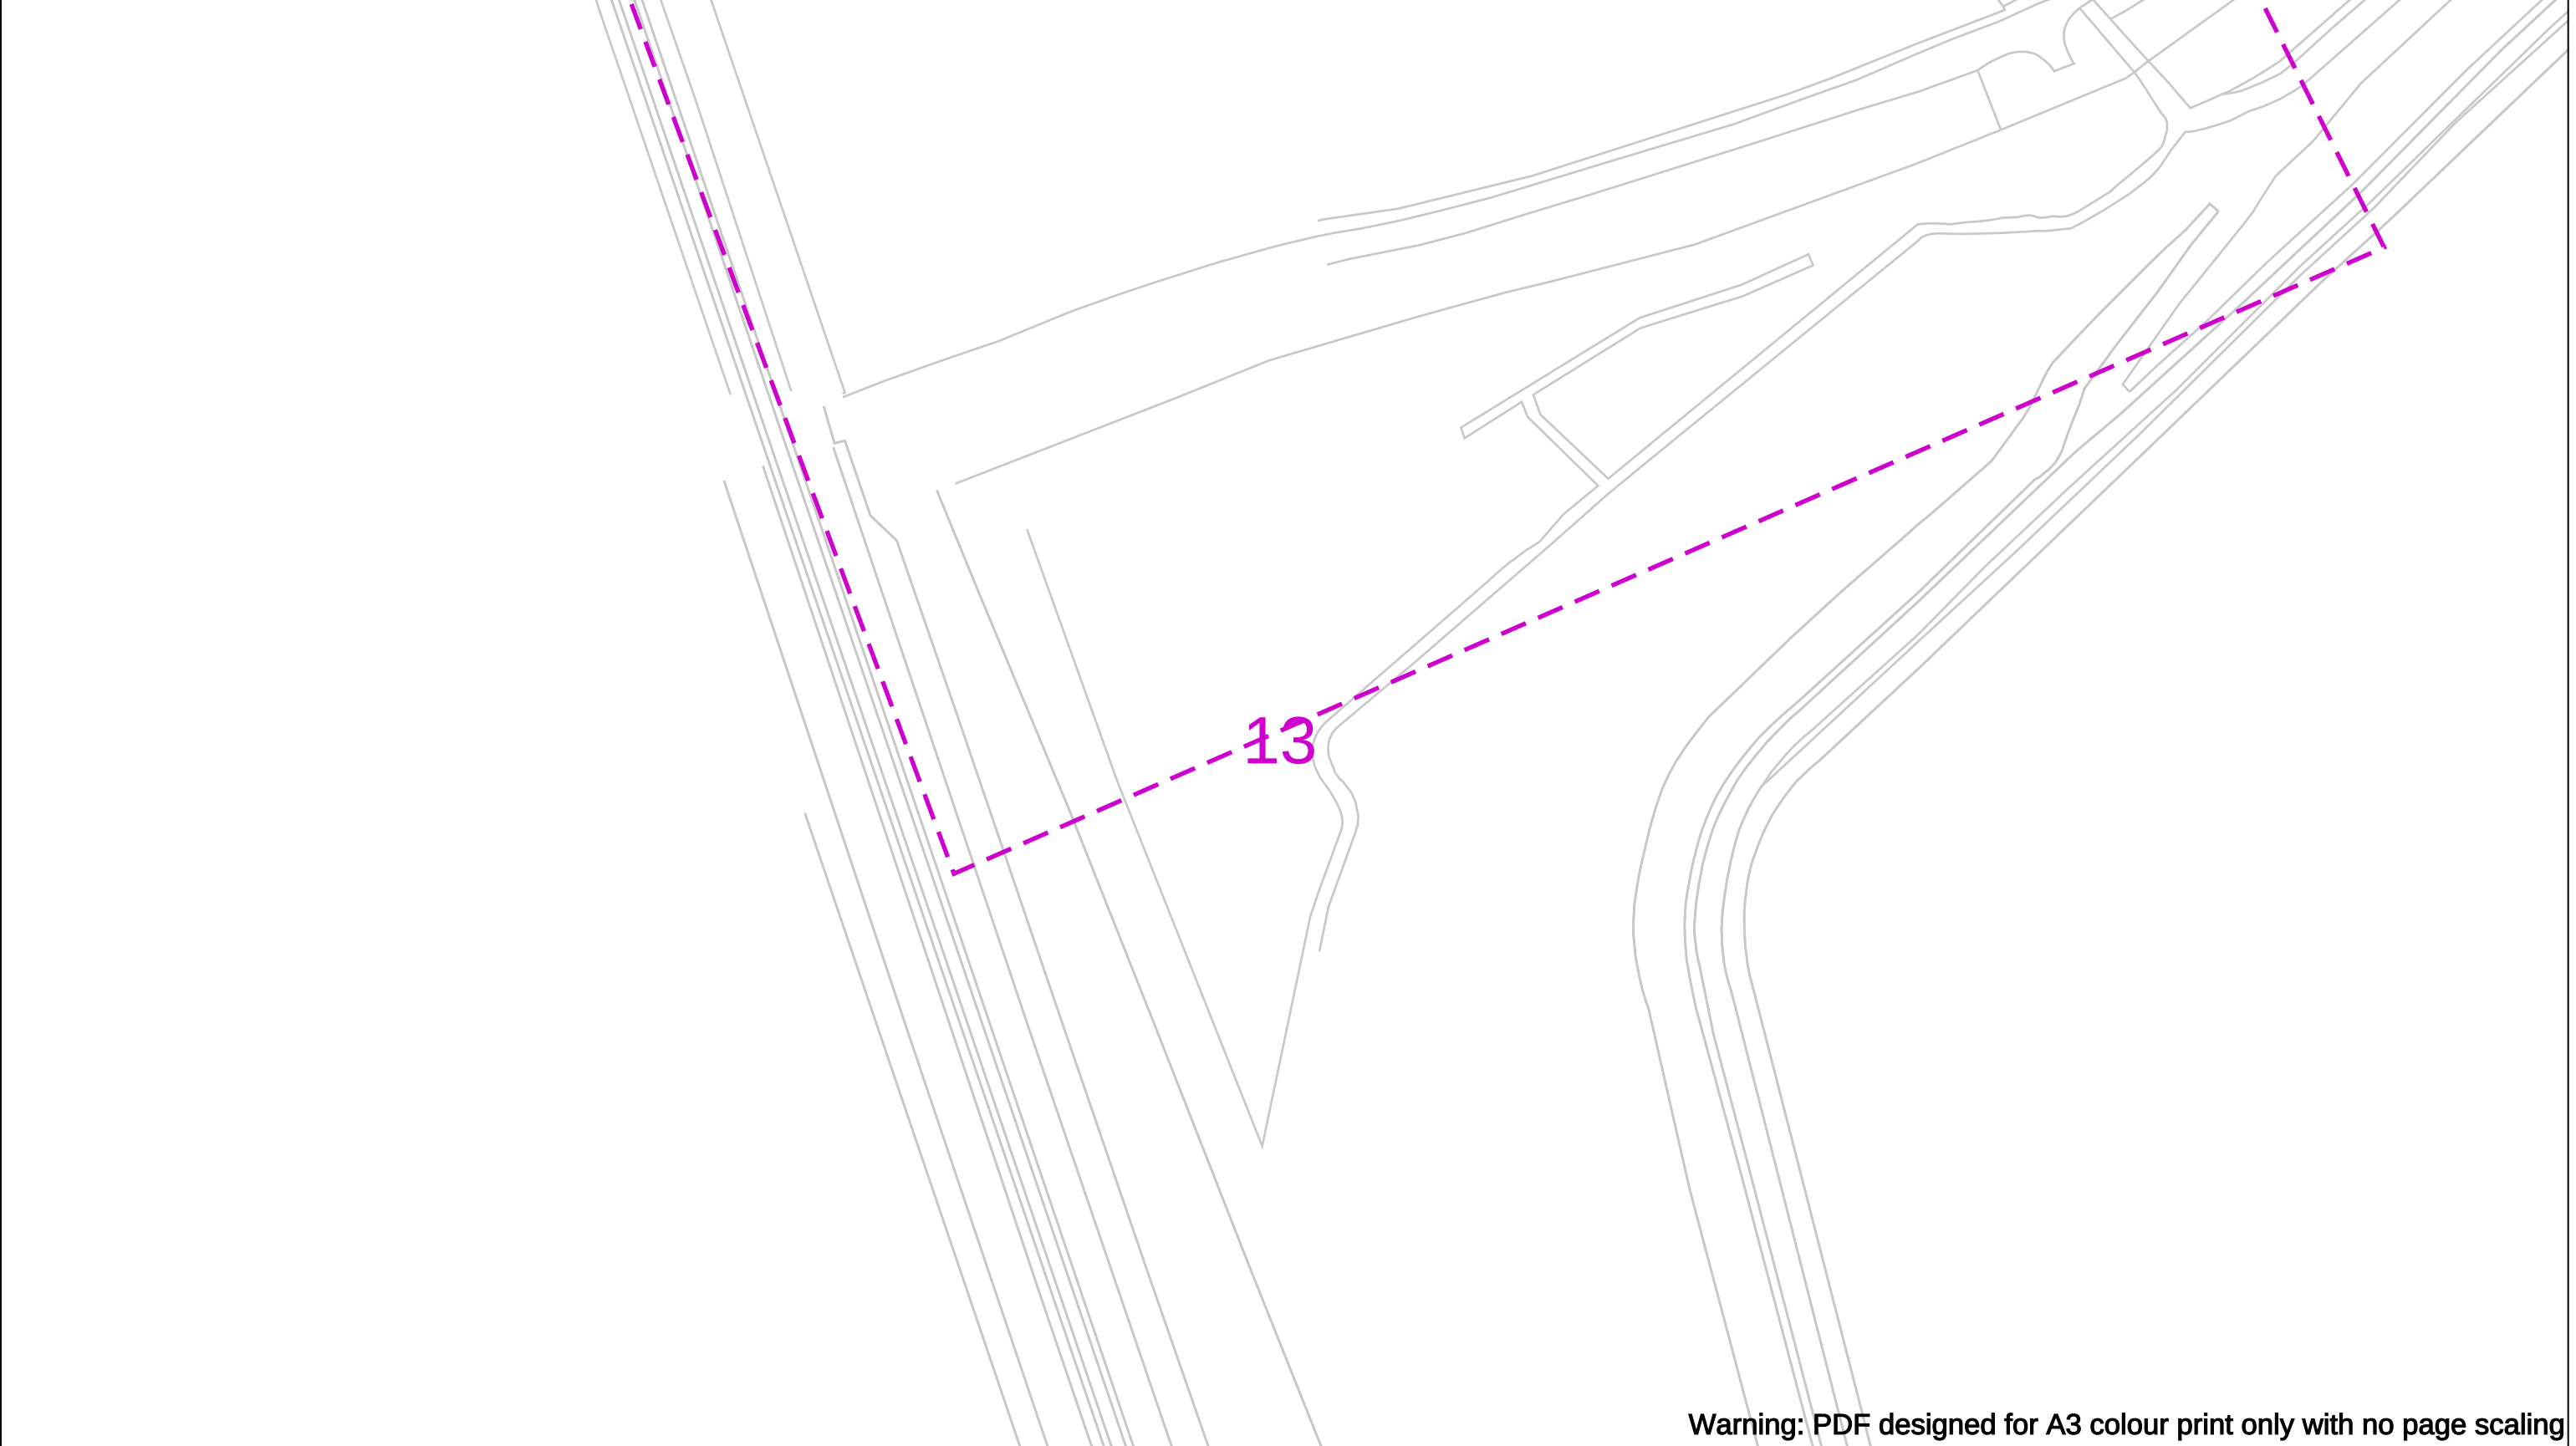

Warning: PDF designed for A3 colour print only with no page scaling


Contact Us Mapping Enquiries: 02920 278 912 General Enquiries: 0800 912 2999 Date Requested: 24/11/2023 Job Reference: 31654782 Site Location: 278649 186231 Requested by: Mr Farhan Aslam Your Scheme/Reference: NG TATA Steel Margam FEED Scale: 1:1250 (When plotted at A3)	EXTREME CAUTION. Major Accident Hazard Pipeline in Vicinity **RISK OF DEATH OR SERIOUS INJURY** Prior to excavation starting you must contact the plant protection team on 02920 278912 IMPORTANT NOTICES - This information is given as a guide only and its accuracy cannot be guaranteed - The plan only shows those pipes owned by Wales & West Utilities (WWU) as its role as a licensed Gas Transporter - Service pipes, valves, syphons, stub connections etc. may not be shown but their presence should be anticipated - You must use safe digging practices in accordance with HS(G)47 to establish the actual position of mains, services and other apparatus before any mechanical excavation is used - It is your responsibility to ensure this information is provided to all persons working near our plant - If in doubt call the WWU dig team on 02920 278912	In case of an emergency call 0800 111 999 Dig Sites Area: Line: Low Pressure (LP) 21mbar – 75mbar Medium Pressure (MP) 350mbar – 2bar Intermediate Pressure (IP) 2bar – 7bar High Pressure (HP) >7bar Line/Fire Valve Governor Station Change of Diameter End Cap Depth of cover	
---	---	---	-----------------------------------

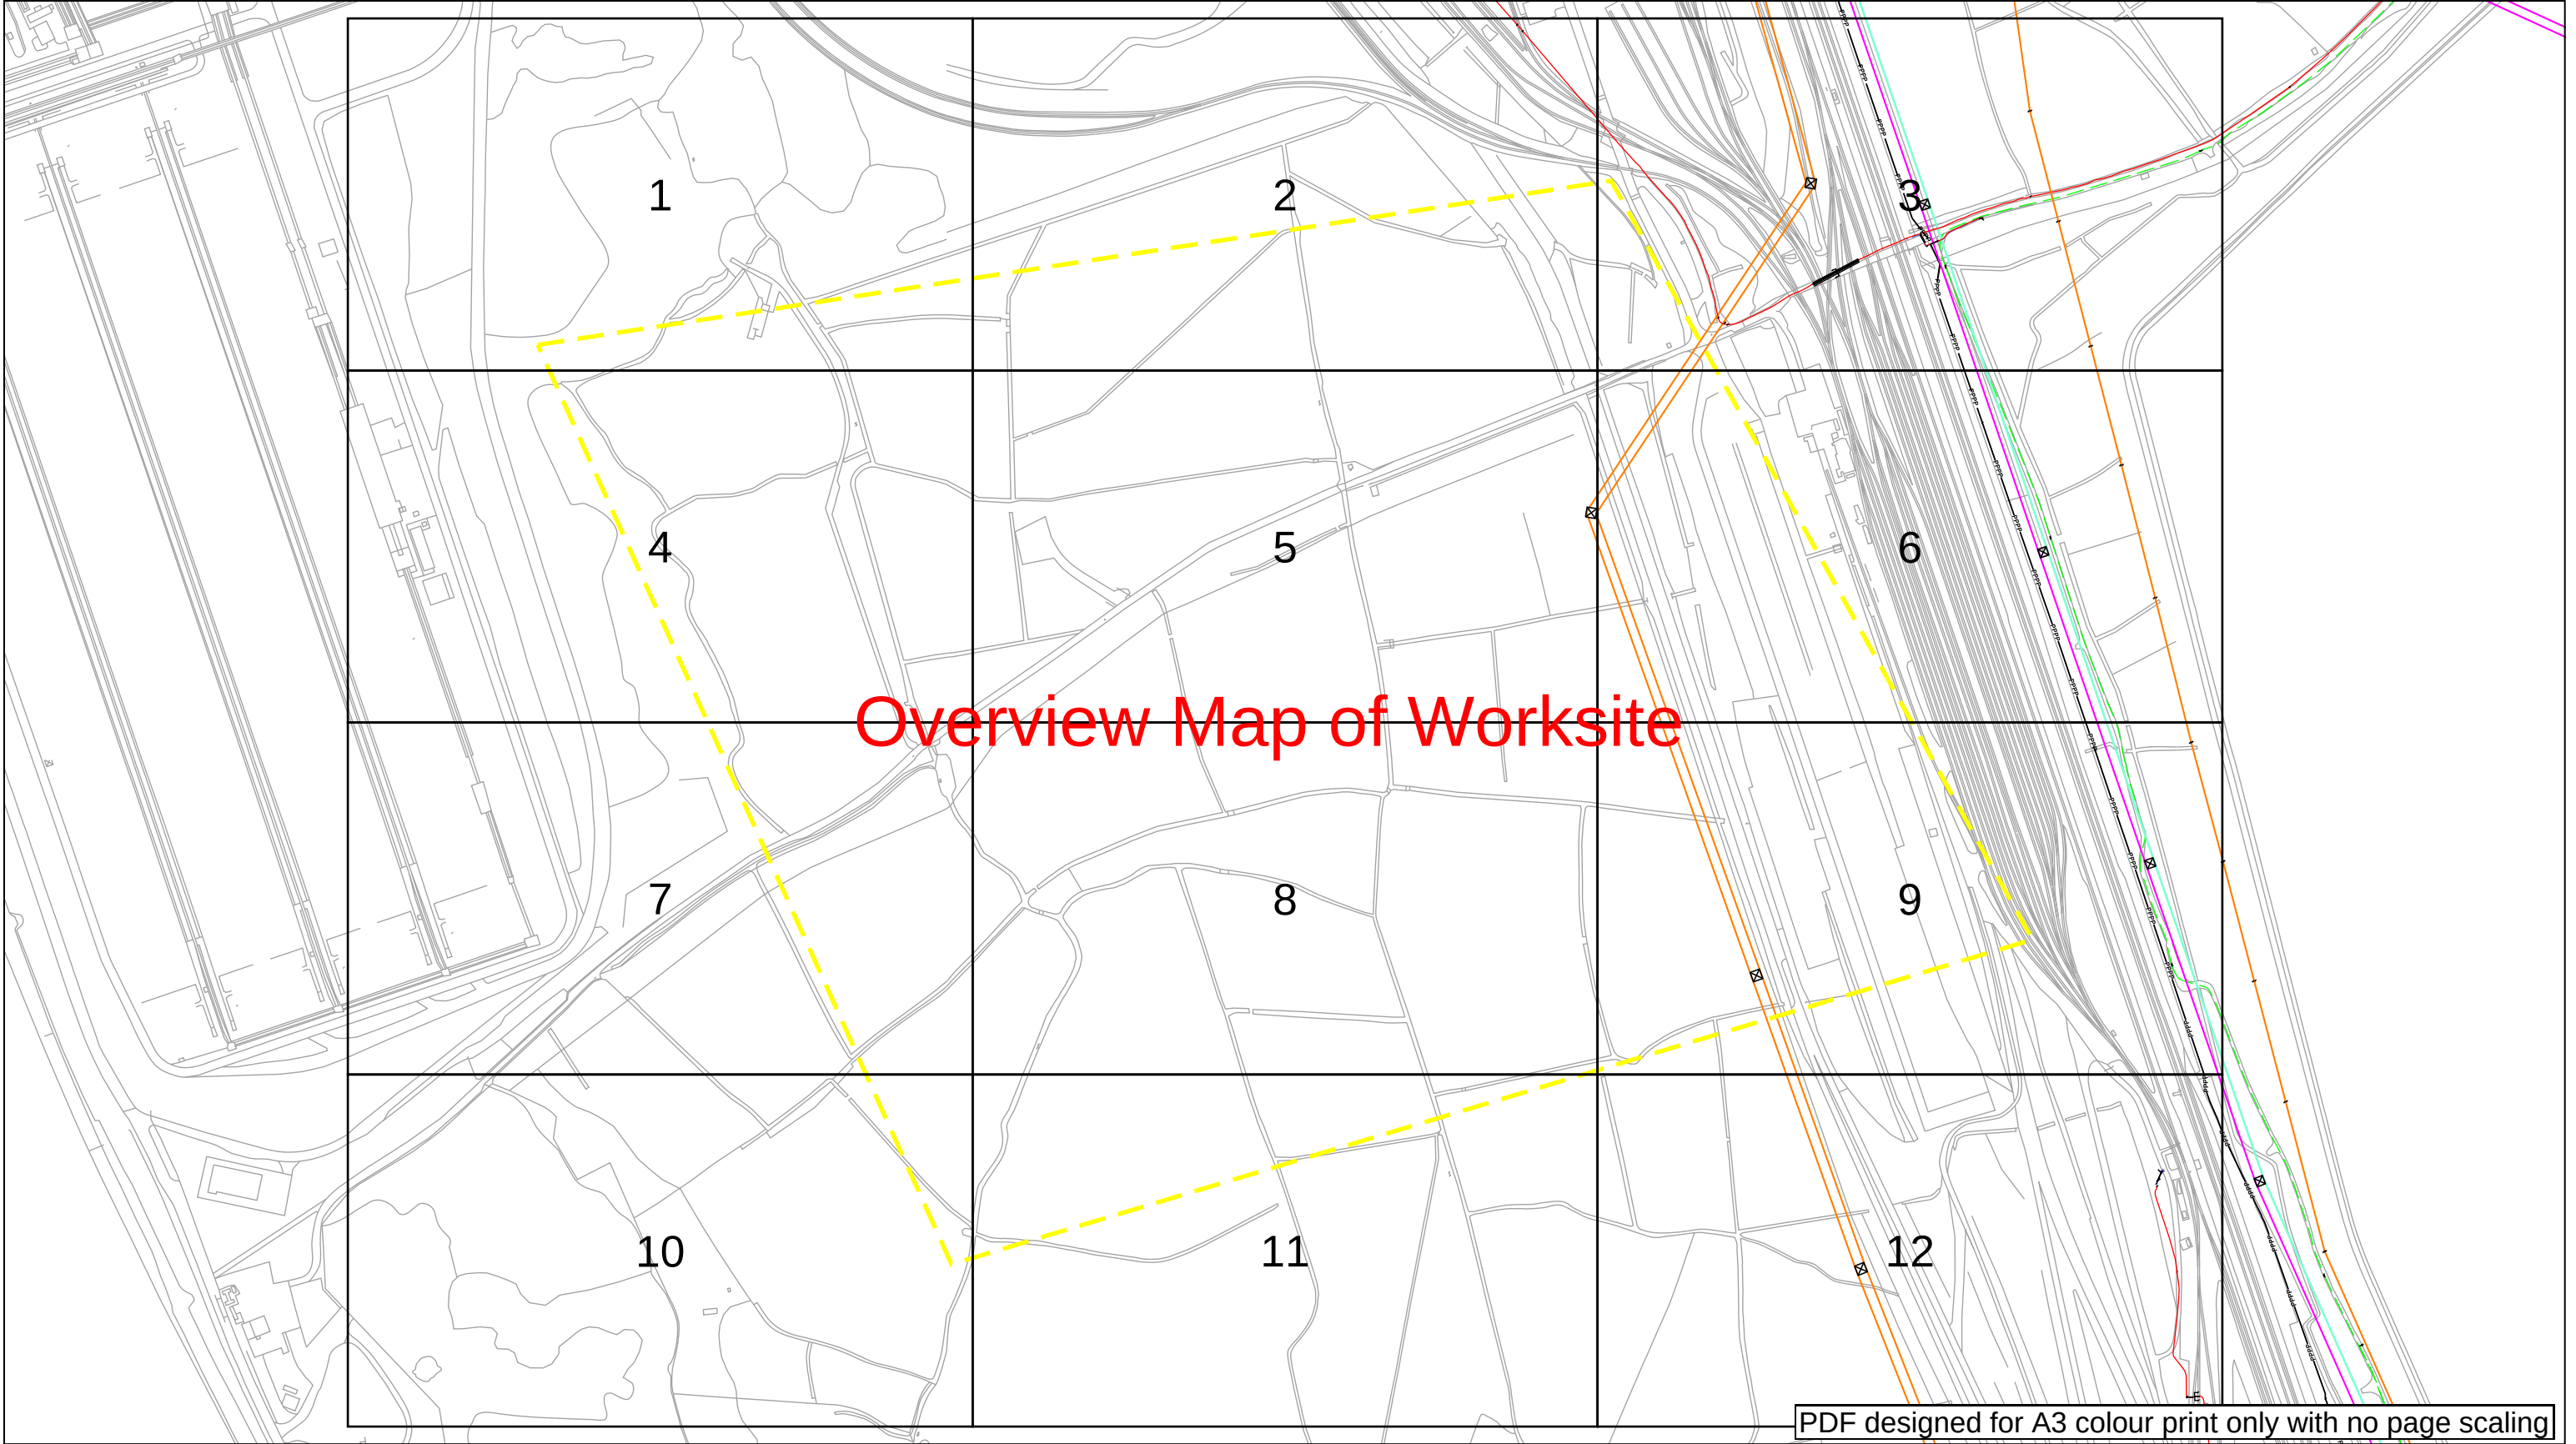

PDF designed for A3 colour print only with no page scaling


Contact Us Mapping Enquiries: 0121 623 9780 General Enquiries: 0800 096 3080 Date Requested: 24/11/2023 Job Reference: 31655152 Site Location: 278263 185096 Requested by: Mr Farhan Aslam Your Scheme/Reference: National Grid Steel Margam FEED Scale: 1:5125 (When plotted at A3)	IMPORTANT NOTICES • This information is given as a guide only and its accuracy cannot be guaranteed. Services or recent additions to the network may not be shown. • Cables, overhead lines & substations owned by other electricity network owners or private companies may be present and may not be shown. • You should always verify exact locations of cables using a cable locator and by careful use of hand tools in accordance with HSE guidance note HSG47. • When working within 10m of any overhead electric line you should follow the requirements of HSE Guidance Note GS6. • For further advice on working near our electricity cables or lines, call our Contact Centre on 0800 096 3080. • Advice should be sought from the National Grid Electricity Distribution Contact Centre for any work that is to take place in proximity to 66kV or 132kV underground cables and 66kV 132kV overhead lines – 0800 096 3080	Link Box Site Location Line/Area Overhead Line LV 11kV 33kV 66kV 132kV Underground Cable LV 11kV 33kV 66kV 132kV National Grid Telecommunications Private Cables PME Earth Underground Earth Pilot Cables Pole Mounted Transformer Ground Mounted Transformer Report damage immediately KEEP EVERYONE AWAY FROM THE AREA 0800 6783 105	Email: NGED.MapResponse@NationalGrid.co.uk
--	---	---	--

Crown Copyright © All Rights Reserved. Ordnance Survey Licence numbers: 100022432. NGED Copyright: This copy has been made by or with the authority of National Grid Electricity Distribution (NGED) pursuant to Section 47 of the Copyright Designs and Patents Act 1988 unless that Act provides a relevant exception to copyright the copy must not be copied without the prior permission of the copyright owner.

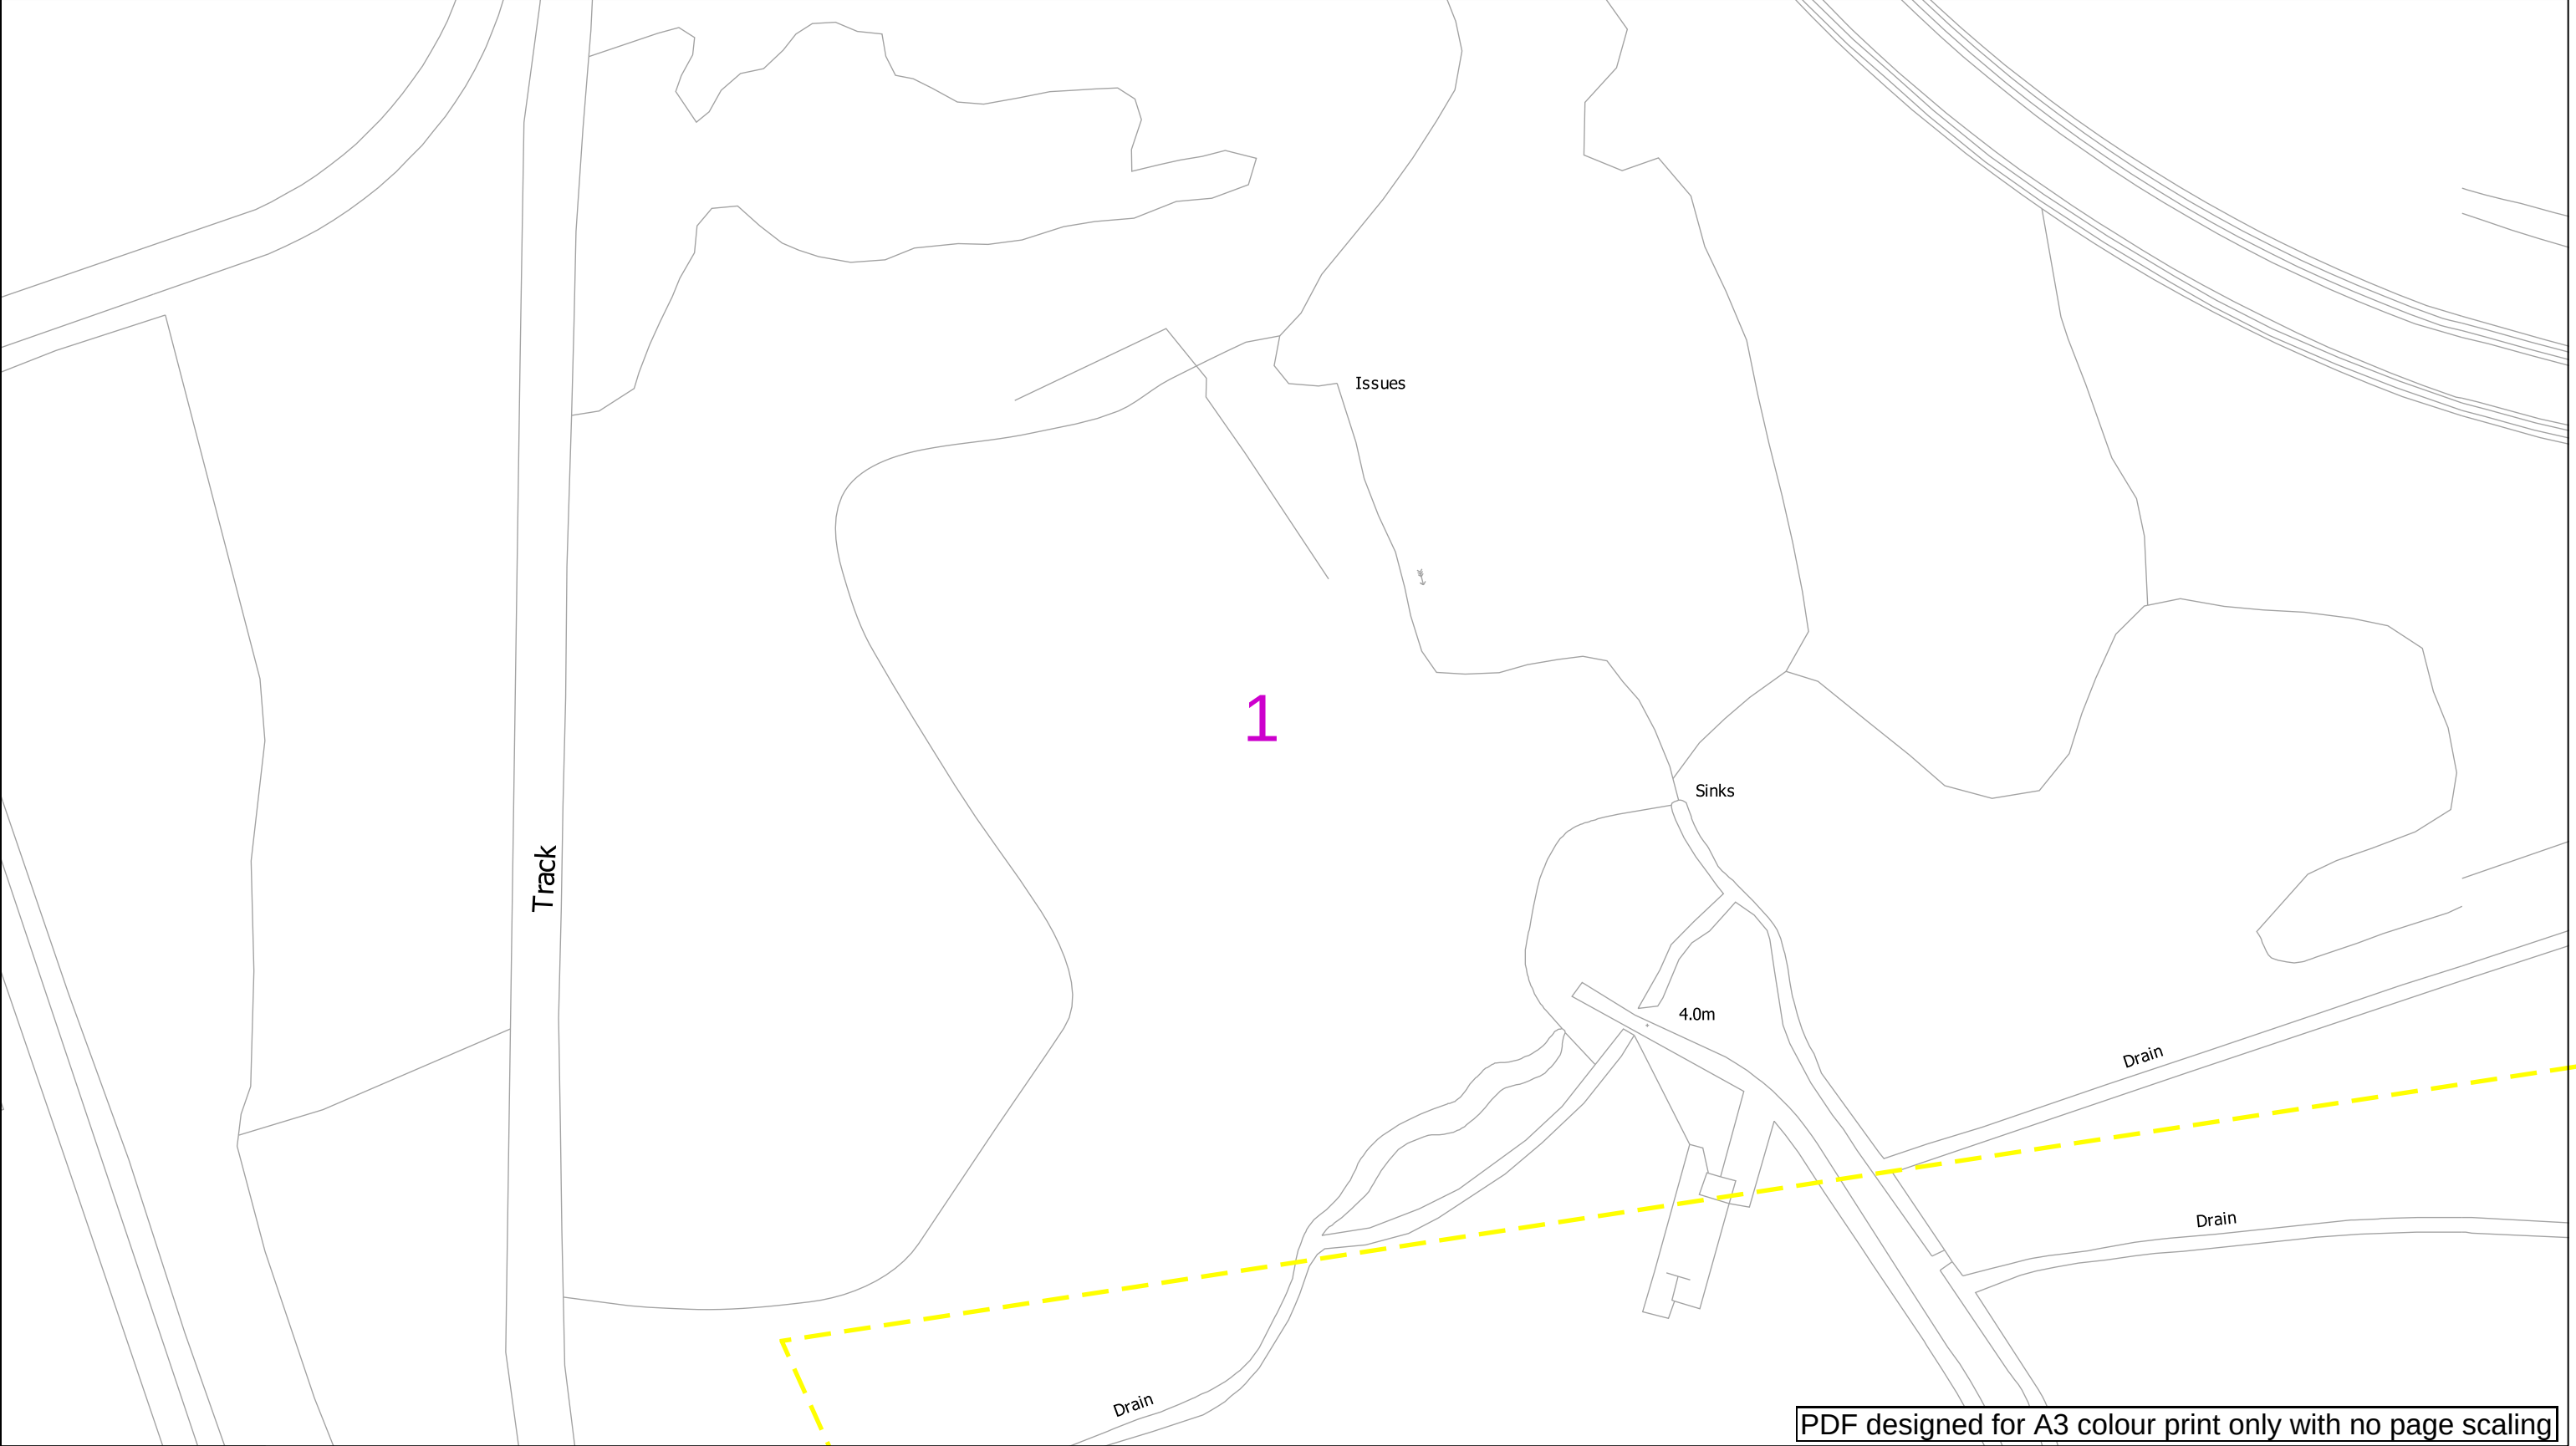

PDF designed for A3 colour print only with no page scaling


Contact Us Mapping Enquiries: 0121 623 9780 General Enquiries: 0800 096 3080 Date Requested: 24/11/2023 Job Reference: 31655152 Site Location: 278263 185096 Requested by: Mr Farhan Aslam Your Scheme/Reference: National Grid Steel Margam FEED Scale: 1:1250 (When plotted at A3)	IMPORTANT NOTICES - This information is given as a guide only and its accuracy cannot be guaranteed. Services or recent additions to the network may not be shown. - Cables, overhead lines & substations owned by other electricity network owners or private companies may be present and may not be shown. - You should always verify exact locations of cables using a cable locator and by careful use of hand tools in accordance with HSE guidance note HSG47. - When working within 10m of any overhead electric line you should follow the requirements of HSE Guidance Note GS6. - For further advice on working near our electricity cables or lines, call our Contact Centre on 0800 096 3080. - Advice should be sought from the National Grid Electricity Distribution Contact Centre for any work that is to take place in proximity to 66kV or 132kV underground cables and 66kV 132kV overhead lines – 0800 096 3080	0100m Link Box Site Location Line/Area Overhead Line PL Service LV HV (11kV) HV (33kV) HV (66kV) HV (132kV) Underground Cable PL Service LV HV (11kV) HV (33kV) HV (66kV) HV (132kV) National Grid Telecoms Private Cables PME Earth Underground Earth Pilot Cables Pole Mounted Transformer Ground Mounted Transformer Report damage immediately KEEP EVERYONE AWAY FROM THE AREA 0800 6783 105	Email: NGED.MapResponse@NationalGrid.co.uk
--	---	--	---

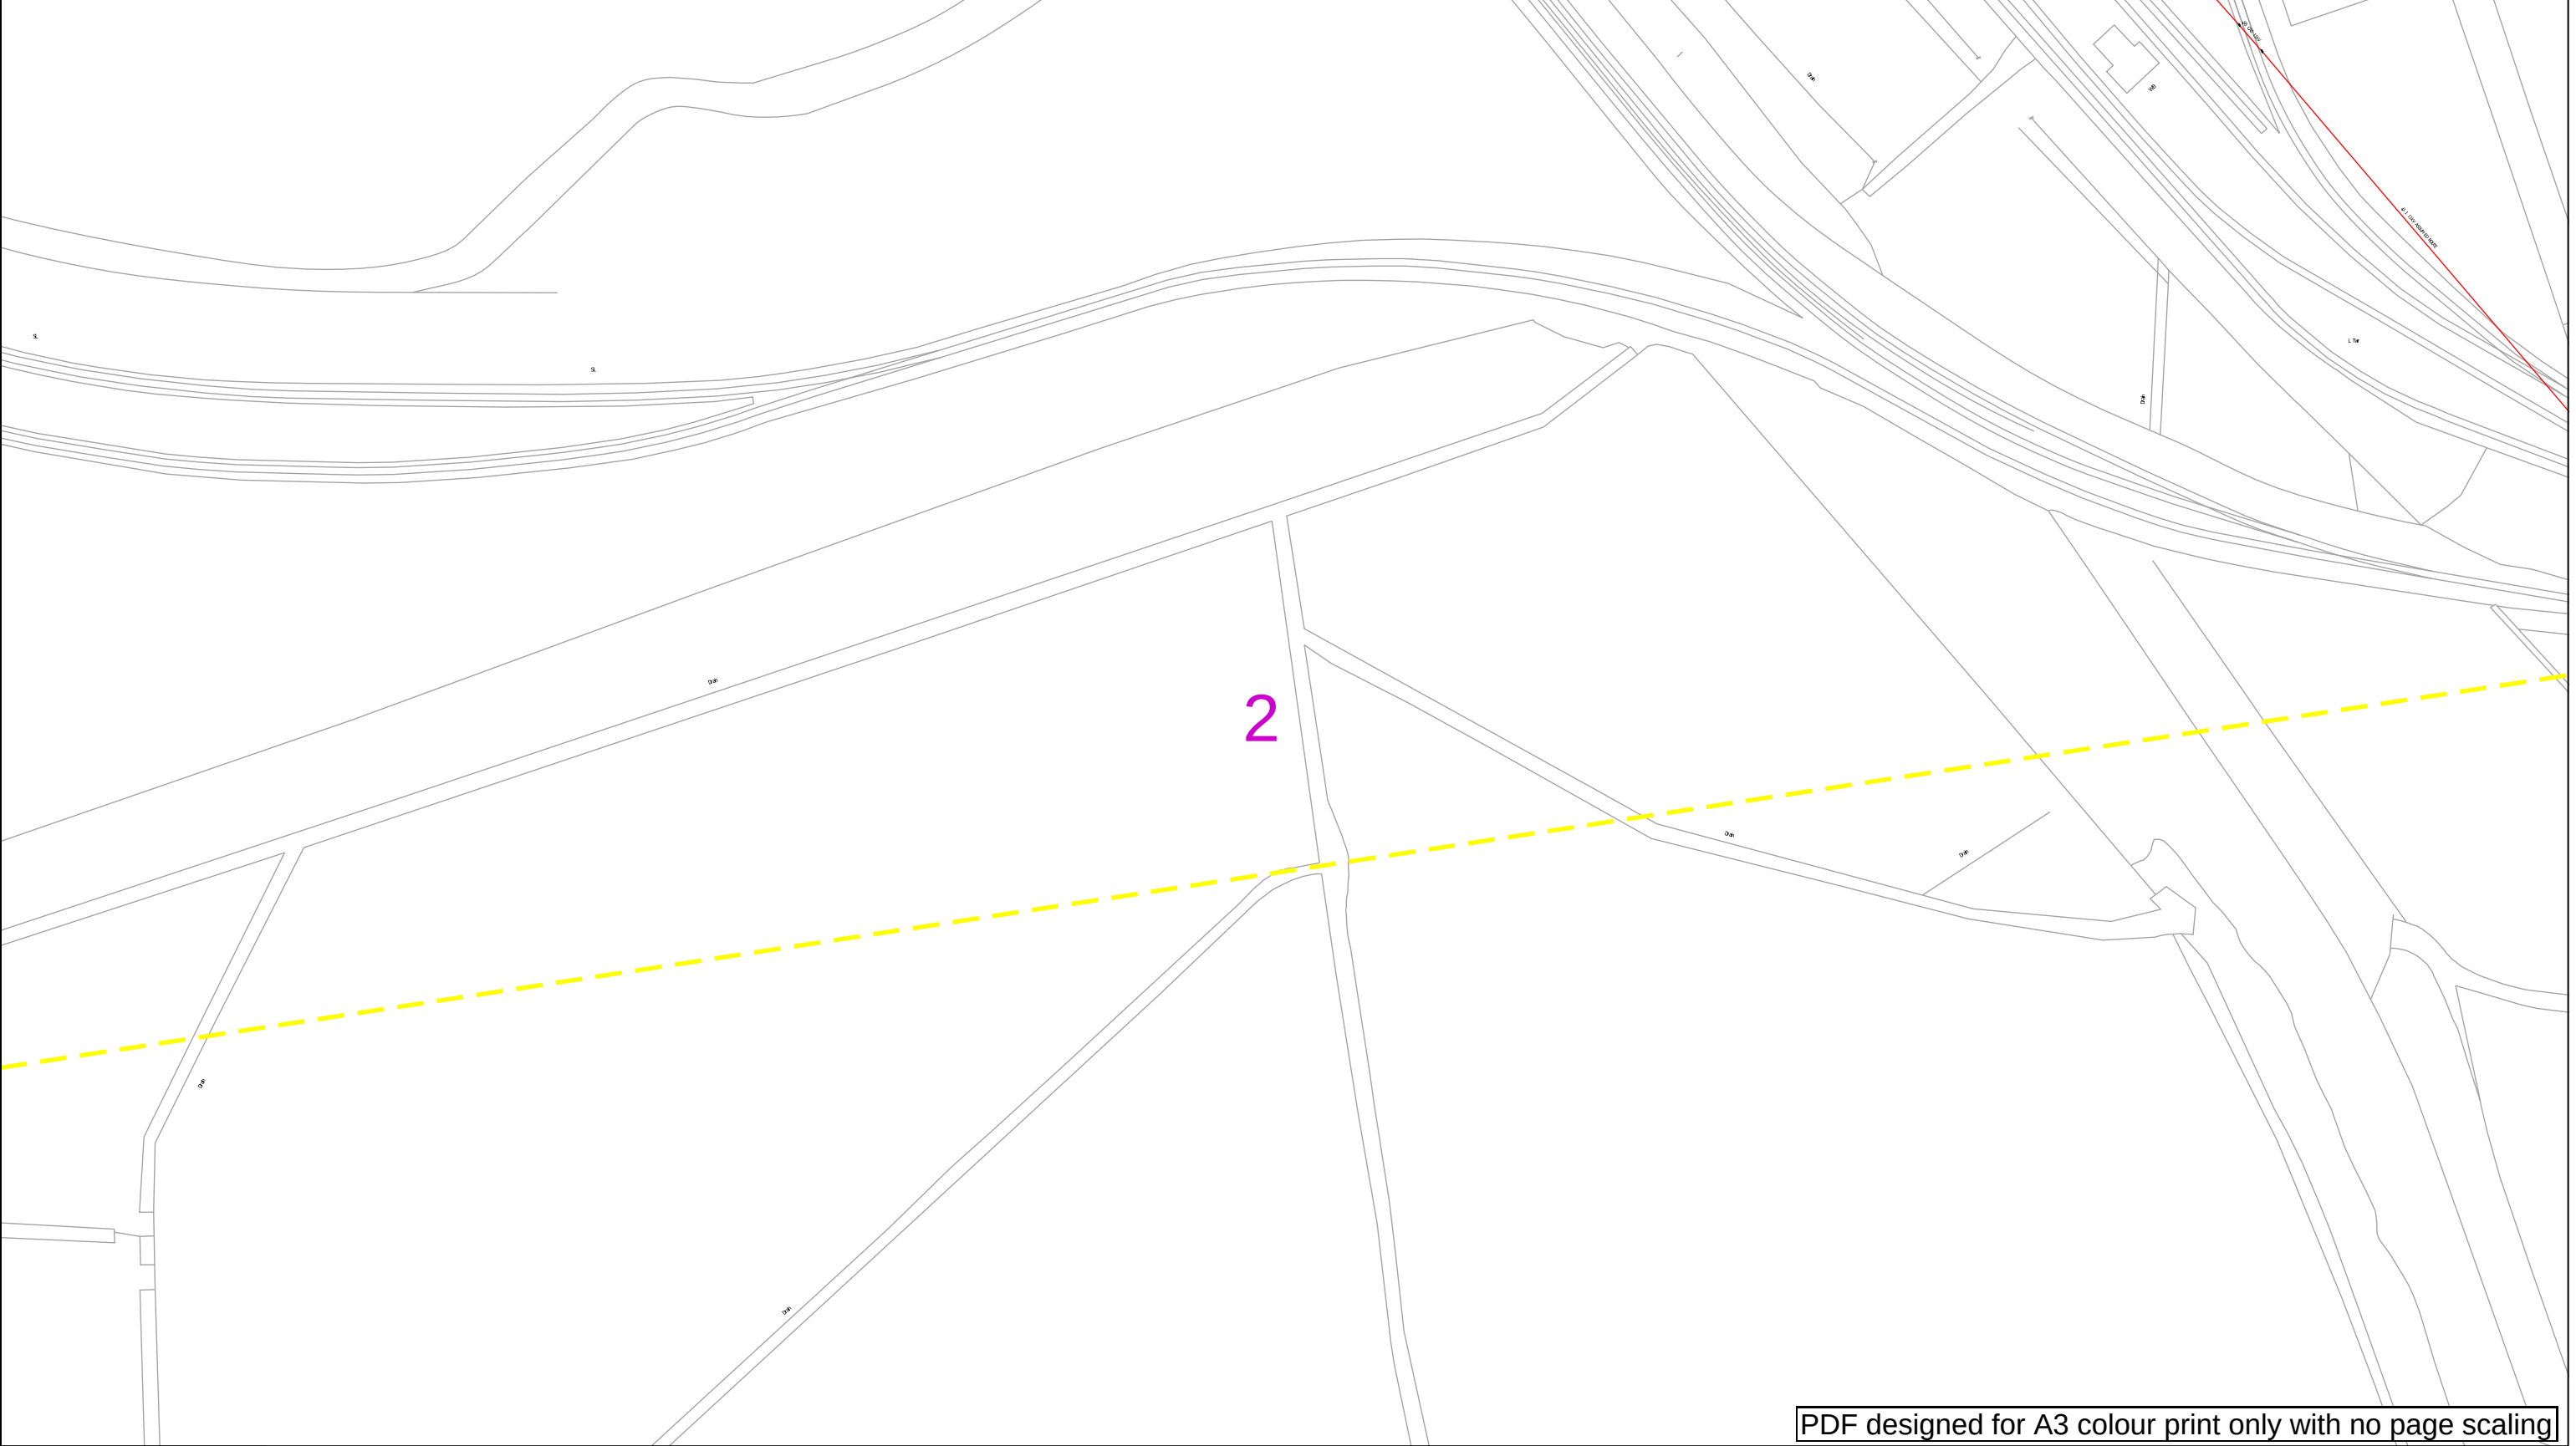

PDF designed for A3 colour print only with no page scaling

Contact Us Mapping Enquiries: 0121 623 9780 General Enquiries: 0800 096 3080 Date Requested: 24/11/2023 Job Reference: 31655152 Site Location: 278263 185096 Requested by: Mr Farhan Aslam Your Scheme/Reference: National Grid Steel Margam FEED Scale: 1:1250 (When plotted at A3)	IMPORTANT NOTICES - This information is given as a guide only and its accuracy cannot be guaranteed. Services or recent additions to the network may not be shown. - Cables, overhead lines & substations owned by other electricity network owners or private companies may be present and may not be shown. - You should always verify exact locations of cables using a cable locator and by careful use of hand tools in accordance with HSE guidance note HSG47. - When working within 10m of any overhead electric line you should follow the requirements of HSE Guidance Note GS6. - For further advice on working near our electricity cables or lines, call our Contact Centre on 0800 096 3080. - Advice should be sought from the National Grid Electricity Distribution Contact Centre for any work that is to take place in proximity to 66kV or 132kV underground cables and 66kV 132kV overhead lines – 0800 096 3080	0100m Link Box Site Location Line/Area Overhead Line - PL - Service - LV - HV (11kV) - HV (33kV) - HV (66kV) - HV (132kV) Underground Cable - PL - Service - LV - HV (11kV) - HV (33kV) - HV (66kV) - HV (132kV) National Grid Telecoms Private Cables PME Earth Underground Earth Pilot Cables Pole Mounted Transformer Ground Mounted Transformer Report damage immediately KEEP EVERYONE AWAY FROM THE AREA 0800 6783 105	Email: NGED.MapResponse@NationalGrid.co.uk
--	---	---	---

Crown Copyright © All Rights Reserved. Ordnance Survey Licence numbers: 100022432. NGED Copyright: This copy has been made by or with the authority of National Grid Electricity Distribution (NGED) pursuant to Section 47 of the Copyright Designs and Patents Act 1988 unless that Act provides a relevant exception to copyright the copy must not be copied without the prior permission of the copyright owner.

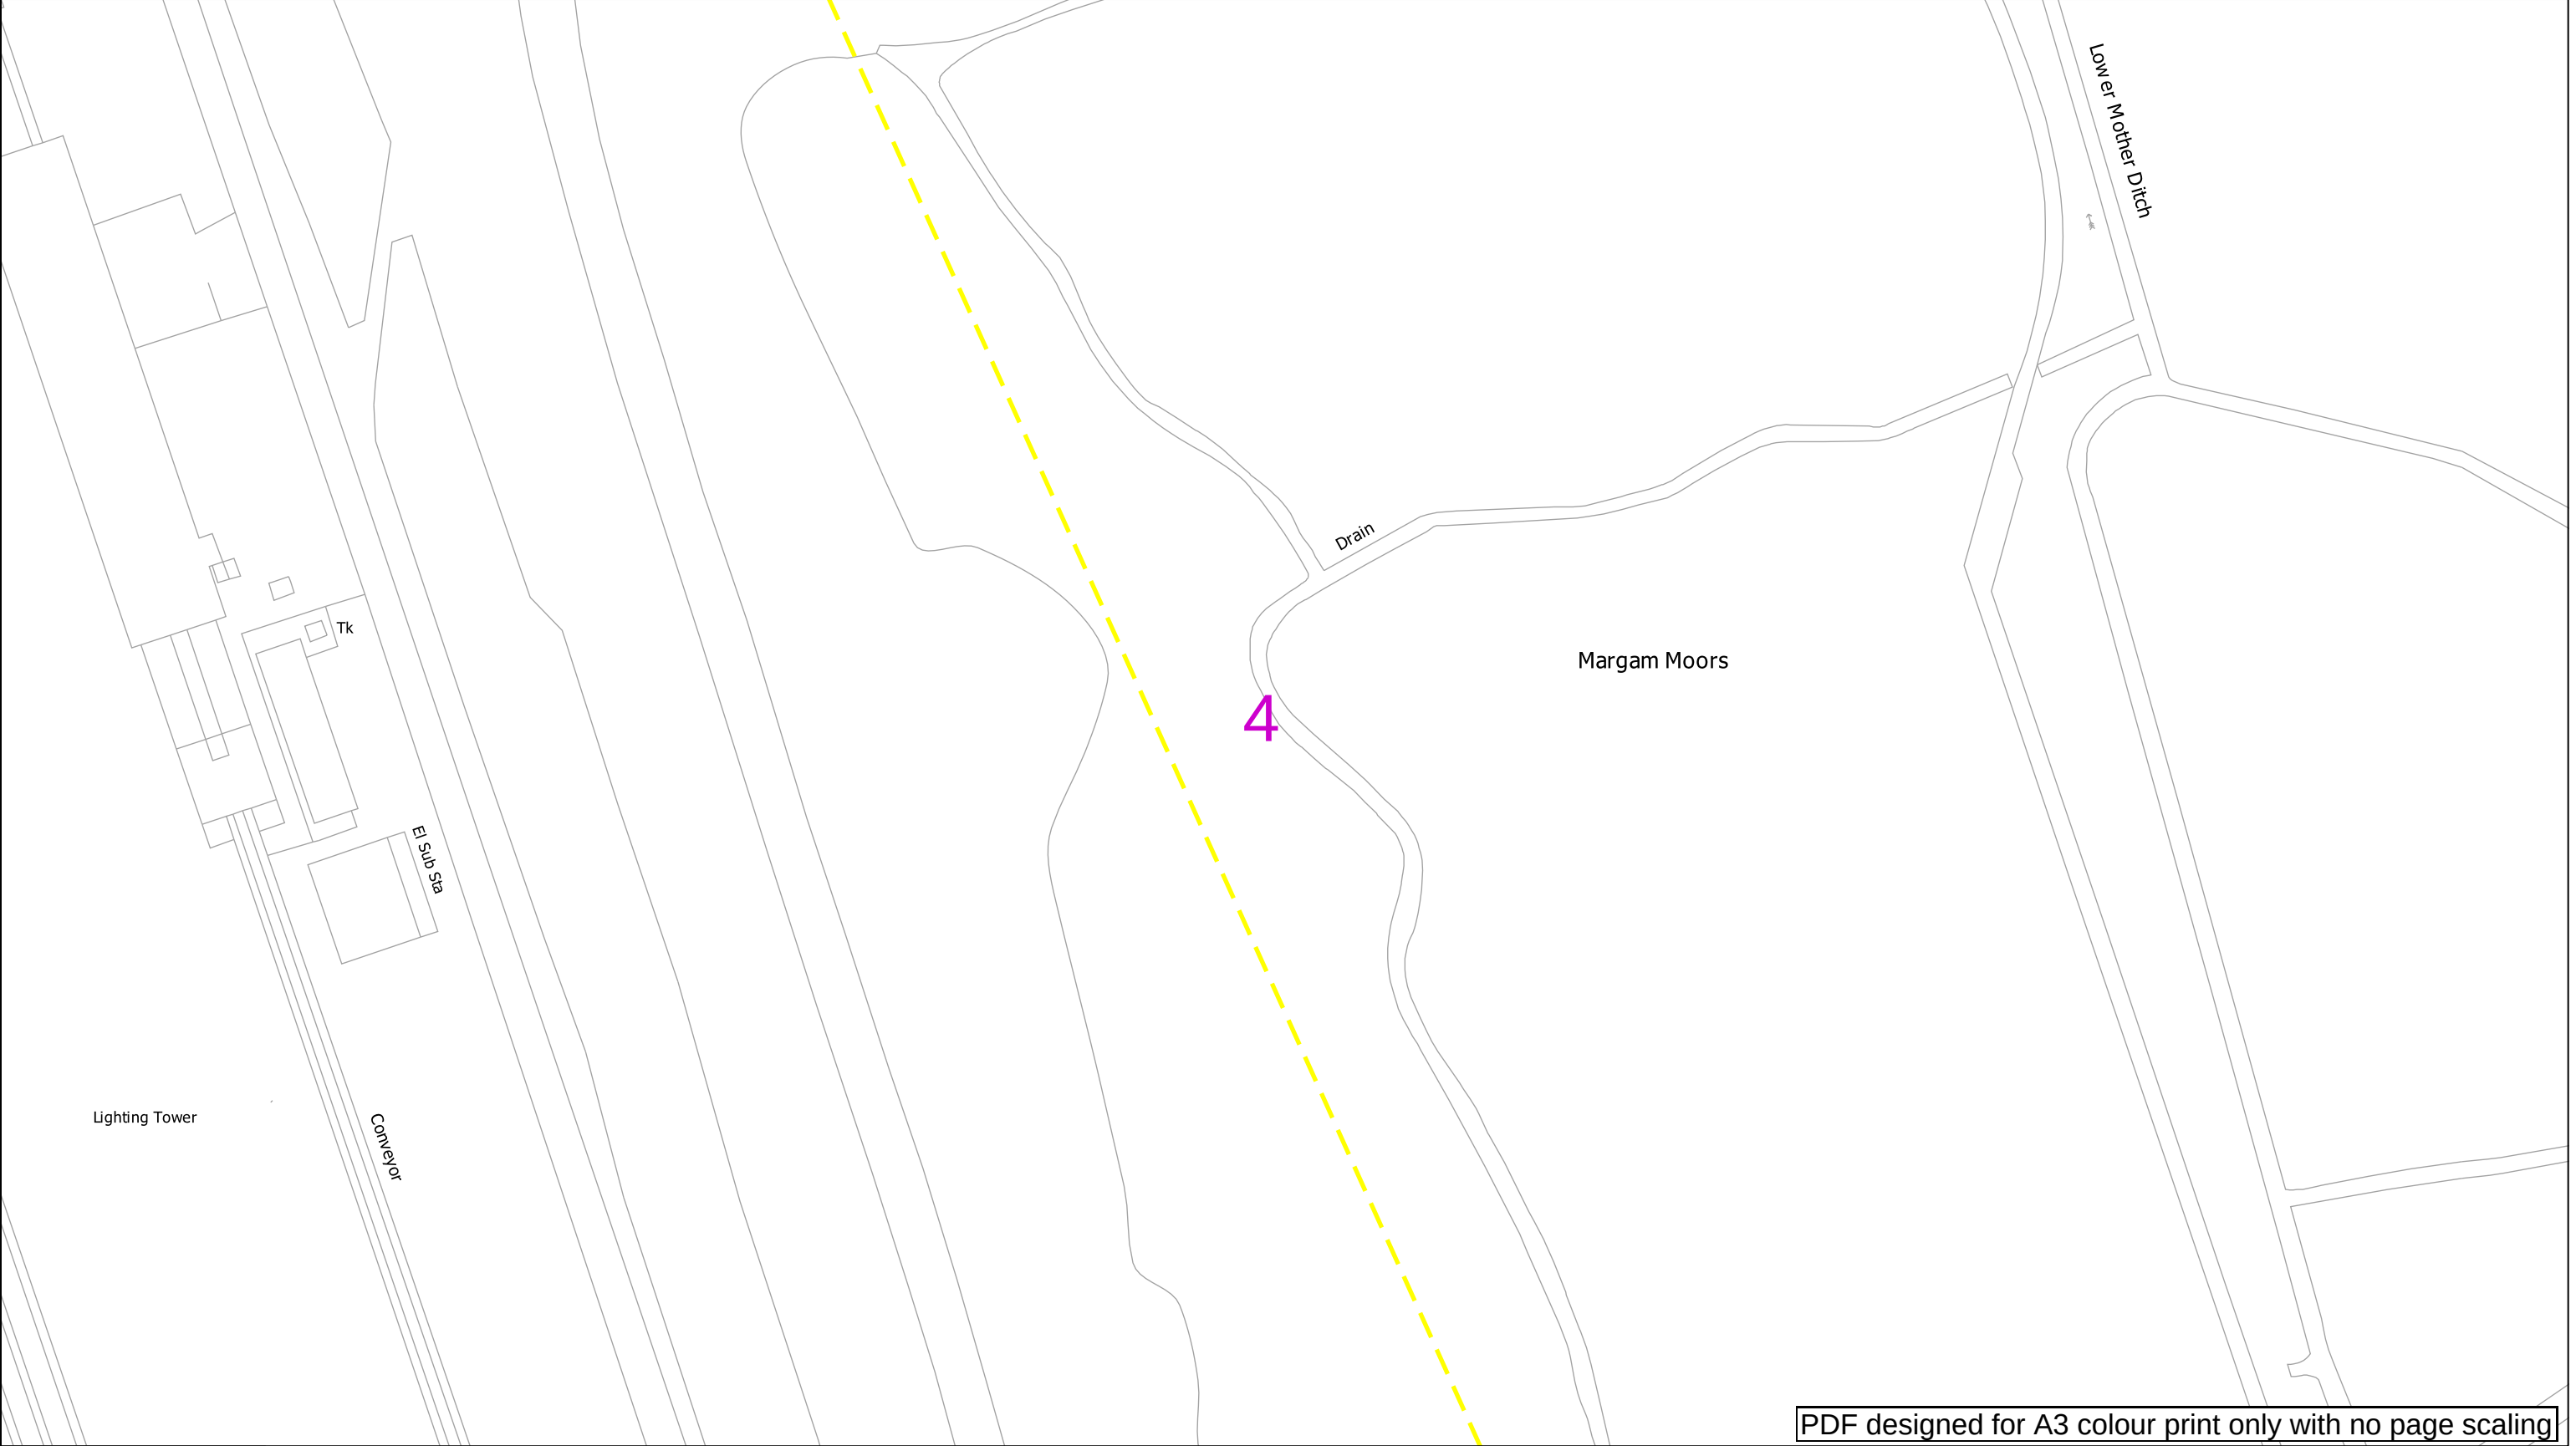

PDF designed for A3 colour print only with no page scaling

Contact Us

Mapping Enquiries: 0121 623 9780

General Enquiries: 0800 096 3080

Date Requested: 24/11/2023

Job Reference: 31655152

Site Location: 278263 185096

Requested by:

Mr Farhan Aslam

Your Scheme/Reference: National Grid Steel Margam FEED

Scale: 1:1250 (When plotted at A3)

IMPORTANT NOTICES

- This information is given as a guide only and its accuracy cannot be guaranteed. Services or recent additions to the network may not be shown.
- Cables, overhead lines & substations owned by other electricity network owners or private companies may be present and may not be shown.
- You should always verify exact locations of cables using a cable locator and by careful use of hand tools in accordance with HSE guidance note HSG47.
- When working within 10m of any overhead electric line you should follow the requirements of HSE Guidance Note GS6.
- For further advice on working near our electricity cables or lines, call our Contact Centre on 0800 096 3080.
- Advice should be sought from the National Grid Electricity Distribution Contact Centre for any work that is to take place in proximity to 66kV or 132kV underground cables and 66kV 132kV overhead lines – 0800 096 3080


0 100m

Link Box	Overhead Line	Underground Cable	National Grid Telecoms	Pilot Cables
●	—○— PL	—○—	—S—S—	—P—P—
	—○— Service	—○—		
Site Location	—○— LV	—○—	Private Cables	Pole Mounted Transformer
Line/Area	—○— HV (11kV)	—○—		
— — — —	—○— HV (33kV)	—○—	PME Earth	Ground Mounted Transformer
	—○— HV (66kV)	—○—	—E—	
	—○— HV (132kV)	—○—	Underground Earth	

Report damage immediately KEEP EVERYONE AWAY FROM THE AREA

0800 6783 105


Email: NGED.MapResponse@NationalGrid.co.uk

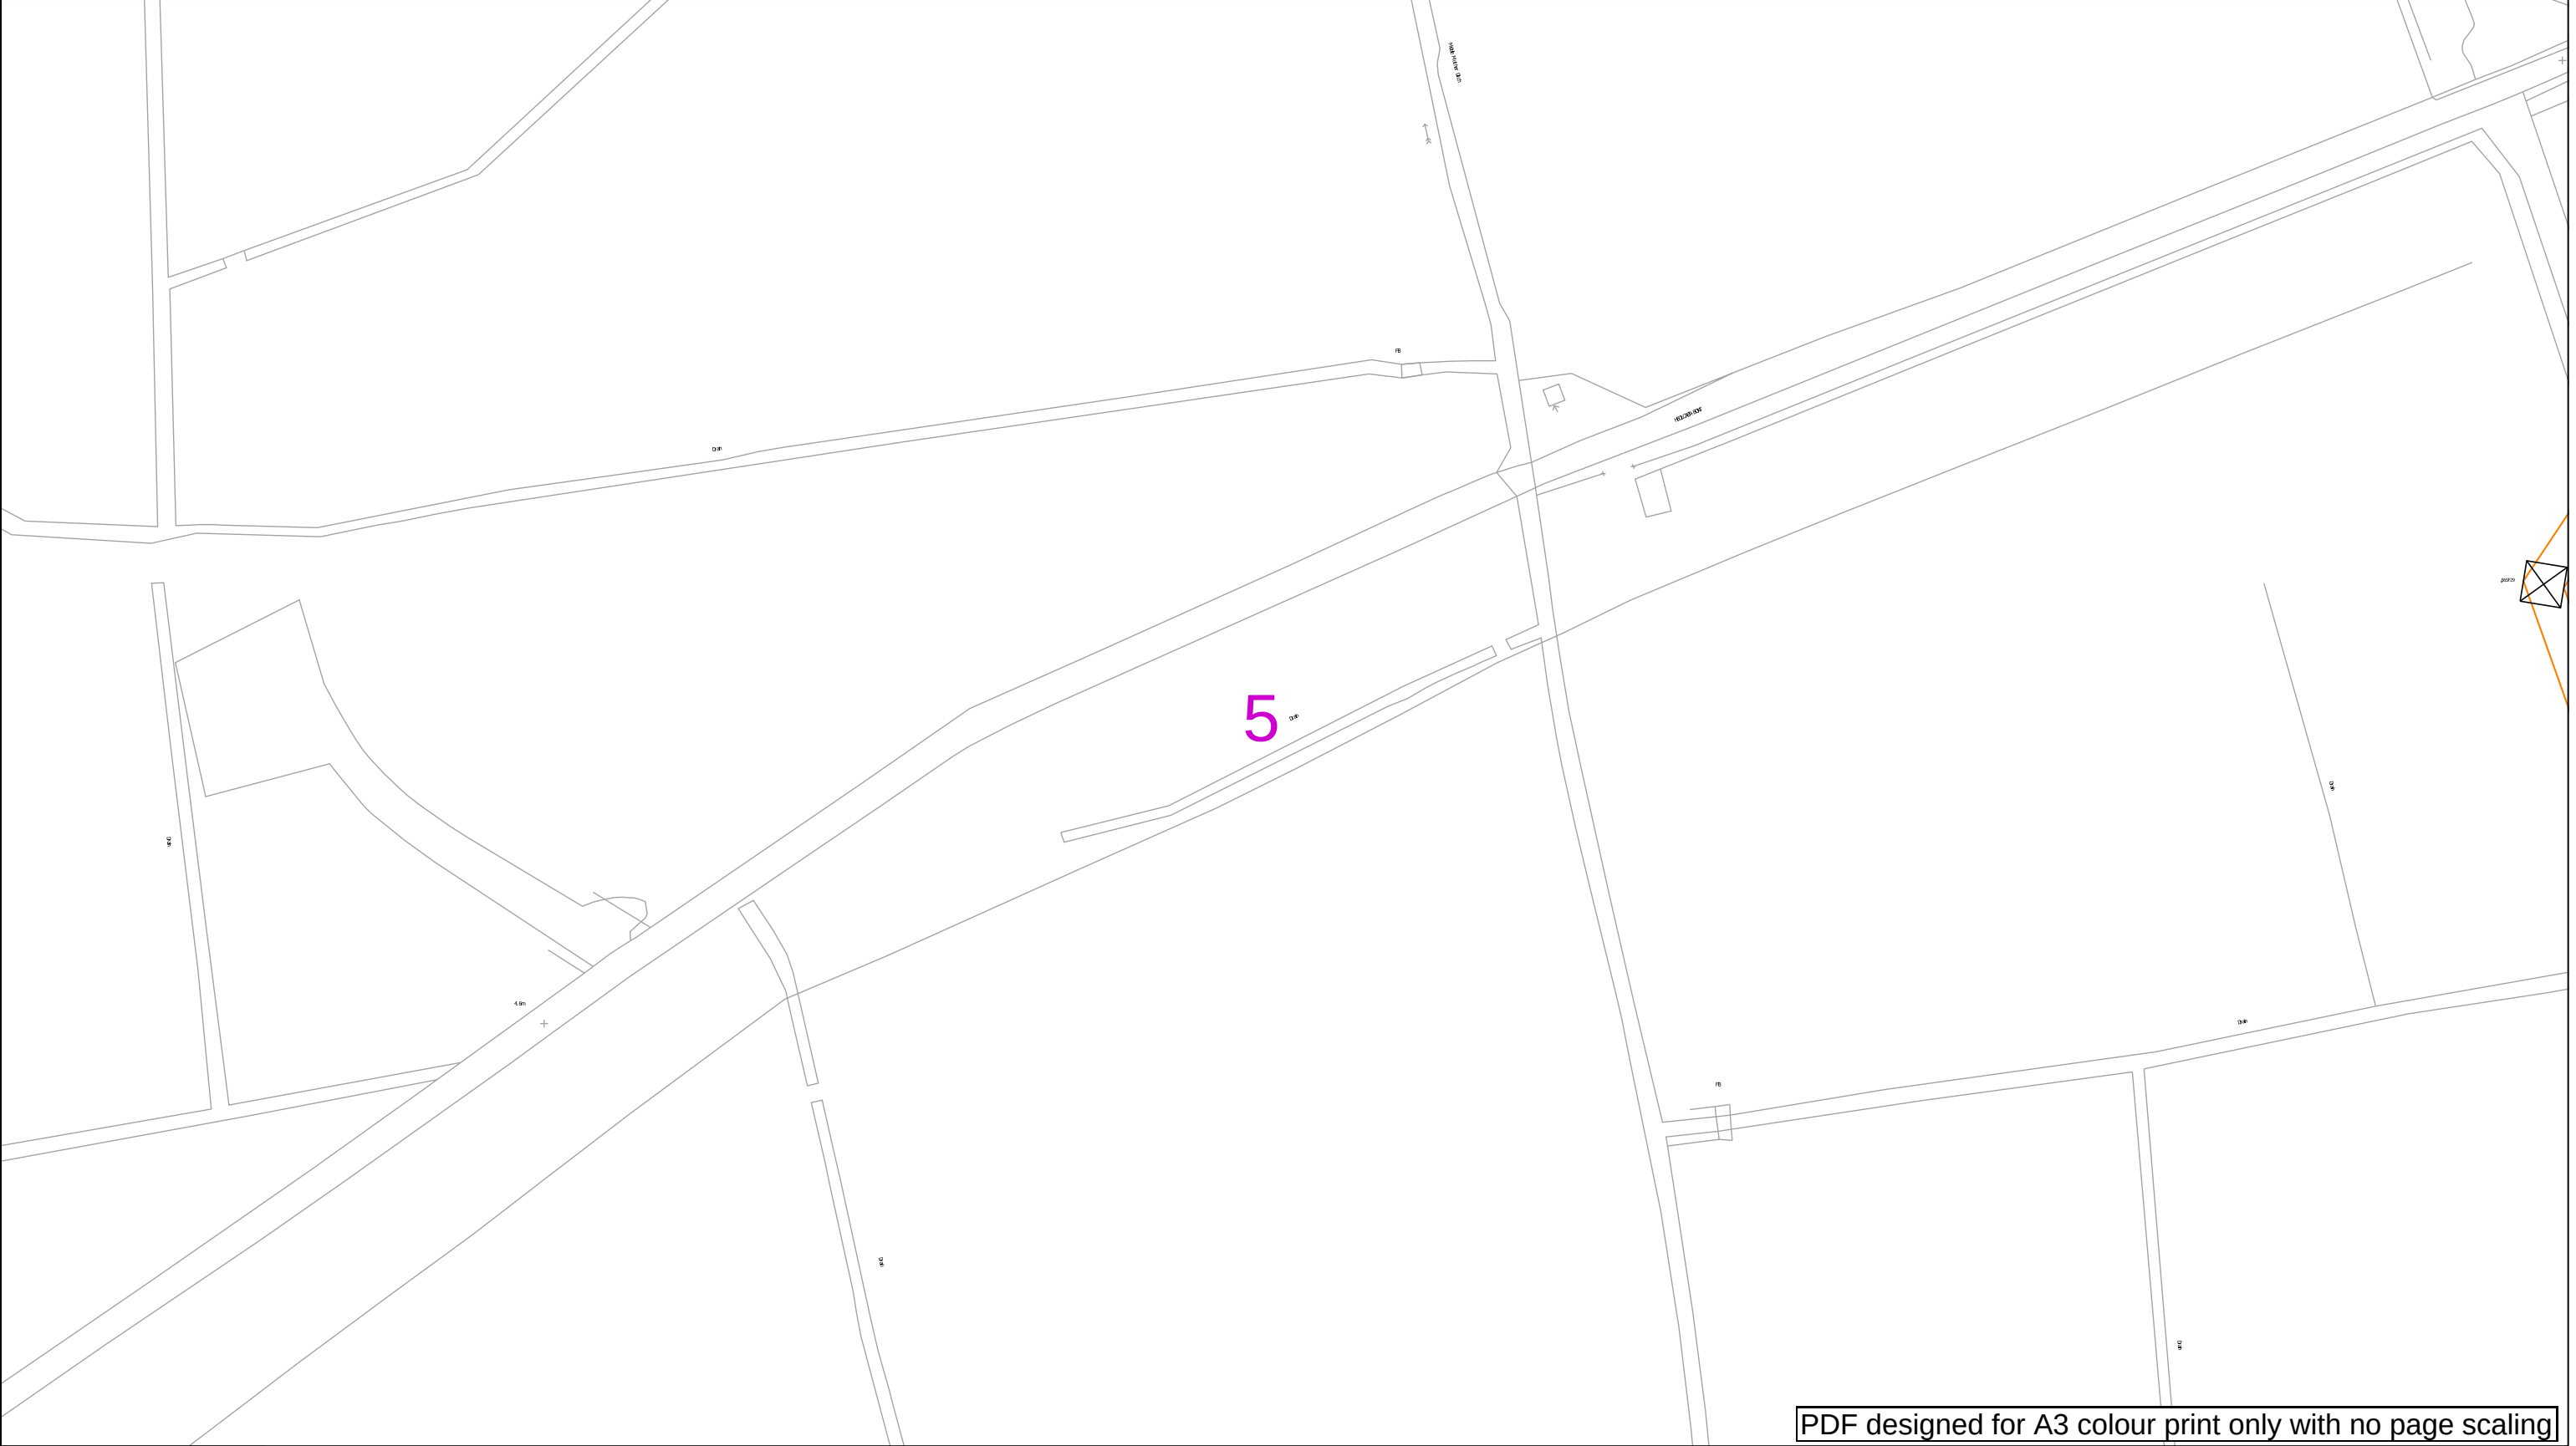

PDF designed for A3 colour print only with no page scaling

Contact Us Mapping Enquiries: 0121 623 9780 General Enquiries: 0800 096 3080 Date Requested: 24/11/2023 Job Reference: 31655152 Site Location: 278263 185096 Requested by: Mr Farhan Aslam Your Scheme/Reference: National Grid Steel Margam FEED Scale: 1:1250 (When plotted at A3)	IMPORTANT NOTICES - This information is given as a guide only and its accuracy cannot be guaranteed. Services or recent additions to the network may not be shown. - Cables, overhead lines & substations owned by other electricity network owners or private companies may be present and may not be shown. - You should always verify exact locations of cables using a cable locator and by careful use of hand tools in accordance with HSE guidance note HSG47. - When working within 10m of any overhead electric line you should follow the requirements of HSE Guidance Note GS6. - For further advice on working near our electricity cables or lines, call our Contact Centre on 0800 096 3080. - Advice should be sought from the National Grid Electricity Distribution Contact Centre for any work that is to take place in proximity to 66kV or 132kV underground cables and 66kV 132kV overhead lines – 0800 096 3080	0100m Link Box Site Location Line/Area Overhead Line PL Service LV HV (11kV) HV (33kV) HV (66kV) HV (132kV) Underground Cable National Grid Telecoms Private Cables PME Earth Underground Earth Pilot Cables Pole Mounted Transformer Ground Mounted Transformer Report damage immediately KEEP EVERYONE AWAY FROM THE AREA 0800 6783 105	Email: NGED.MapResponse@NationalGrid.co.uk
--	---	--	---

Crown Copyright © All Rights Reserved. Ordnance Survey Licence numbers: 100022432. NGED Copyright: This copy has been made by or with the authority of National Grid Electricity Distribution (NGED) pursuant to Section 47 of the Copyright Designs and Patents Act 1988 unless that Act provides a relevant exception to copyright the copy must not be copied without the prior permission of the copyright owner.

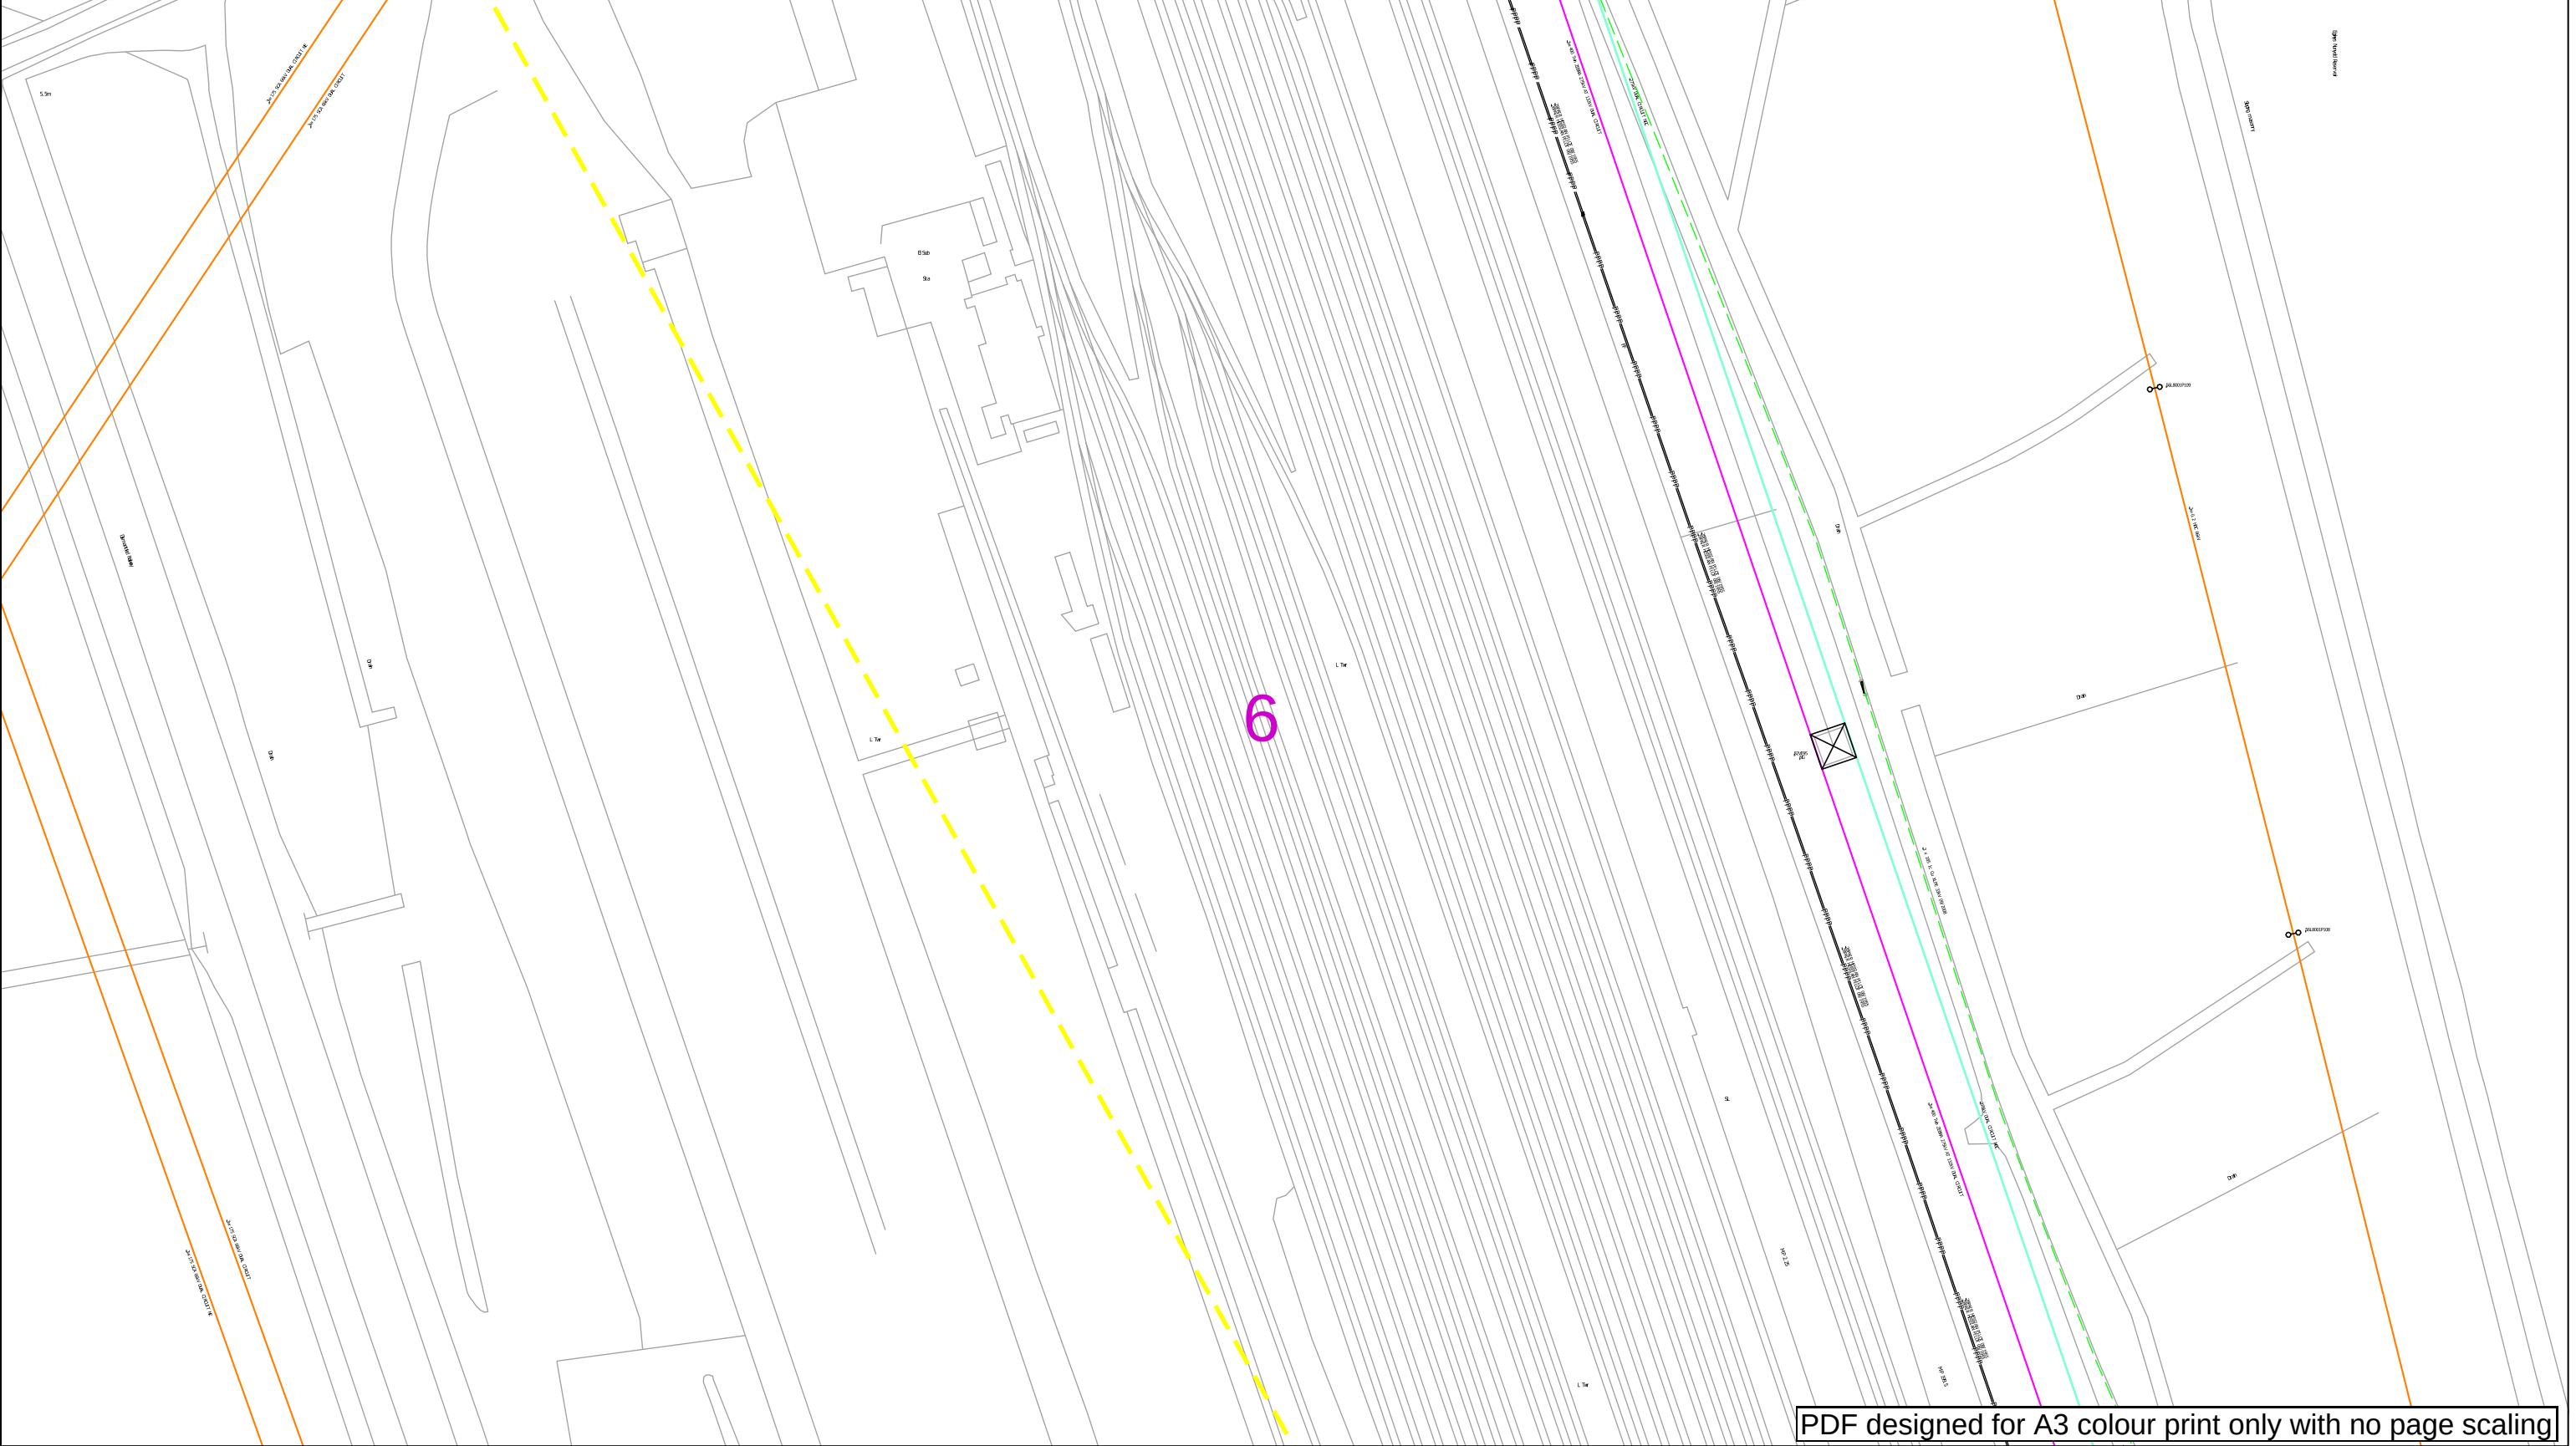

Contact Us

Mapping Enquiries: 0121 623 9780

General Enquiries: 0800 096 3080

Date Requested: 24/11/2023

Job Reference: 31655152

Site Location: 278263 185096

Requested by:

Mr Farhan Aslam

Your Scheme/Reference: National Grid Steel Margam FEED

Scale: 1:1250 (When plotted at A3)

IMPORTANT NOTICES

- This information is given as a guide only and its accuracy cannot be guaranteed. Services or recent additions to the network may not be shown.
- Cables, overhead lines & substations owned by other electricity network owners or private companies may be present and may not be shown.
- You should always verify exact locations of cables using a cable locator and by careful use of hand tools in accordance with HSE guidance note HSG47.
- When working within 10m of any overhead electric line you should follow the requirements of HSE Guidance Note GS6.
- For further advice on working near our electricity cables or lines, call our Contact Centre on 0800 096 3080.
- Advice should be sought from the National Grid Electricity Distribution Contact Centre for any work that is to take place in proximity to 66kV or 132kV underground cables and 66kV 132kV overhead lines – 0800 096 3080


0 100m

Link Box	Overhead Line	Underground Cable	National Grid Telecoms	Pilot Cables
●	—○— PL	— — — — —	—S—S—	—P—P—
	—○— Service	— — — — —		
Site Location	—○— LV		Private Cables	Pole Mounted Transformer
Line/Area	—○— HV (11kV)	— — — — —	—E—E—	—○—
— — — —	—○— HV (33kV)	— — — — —		
	—○— HV (66kV)	— — — — —	PME Earth	Ground Mounted Transformer
	—□— HV (132kV)	— — — — —	—E—E—	—□—
			Underground Earth	

Report damage immediately KEEP EVERYONE AWAY FROM THE AREA

0800 6783 105

Email: NGED.MapResponse@NationalGrid.co.uk

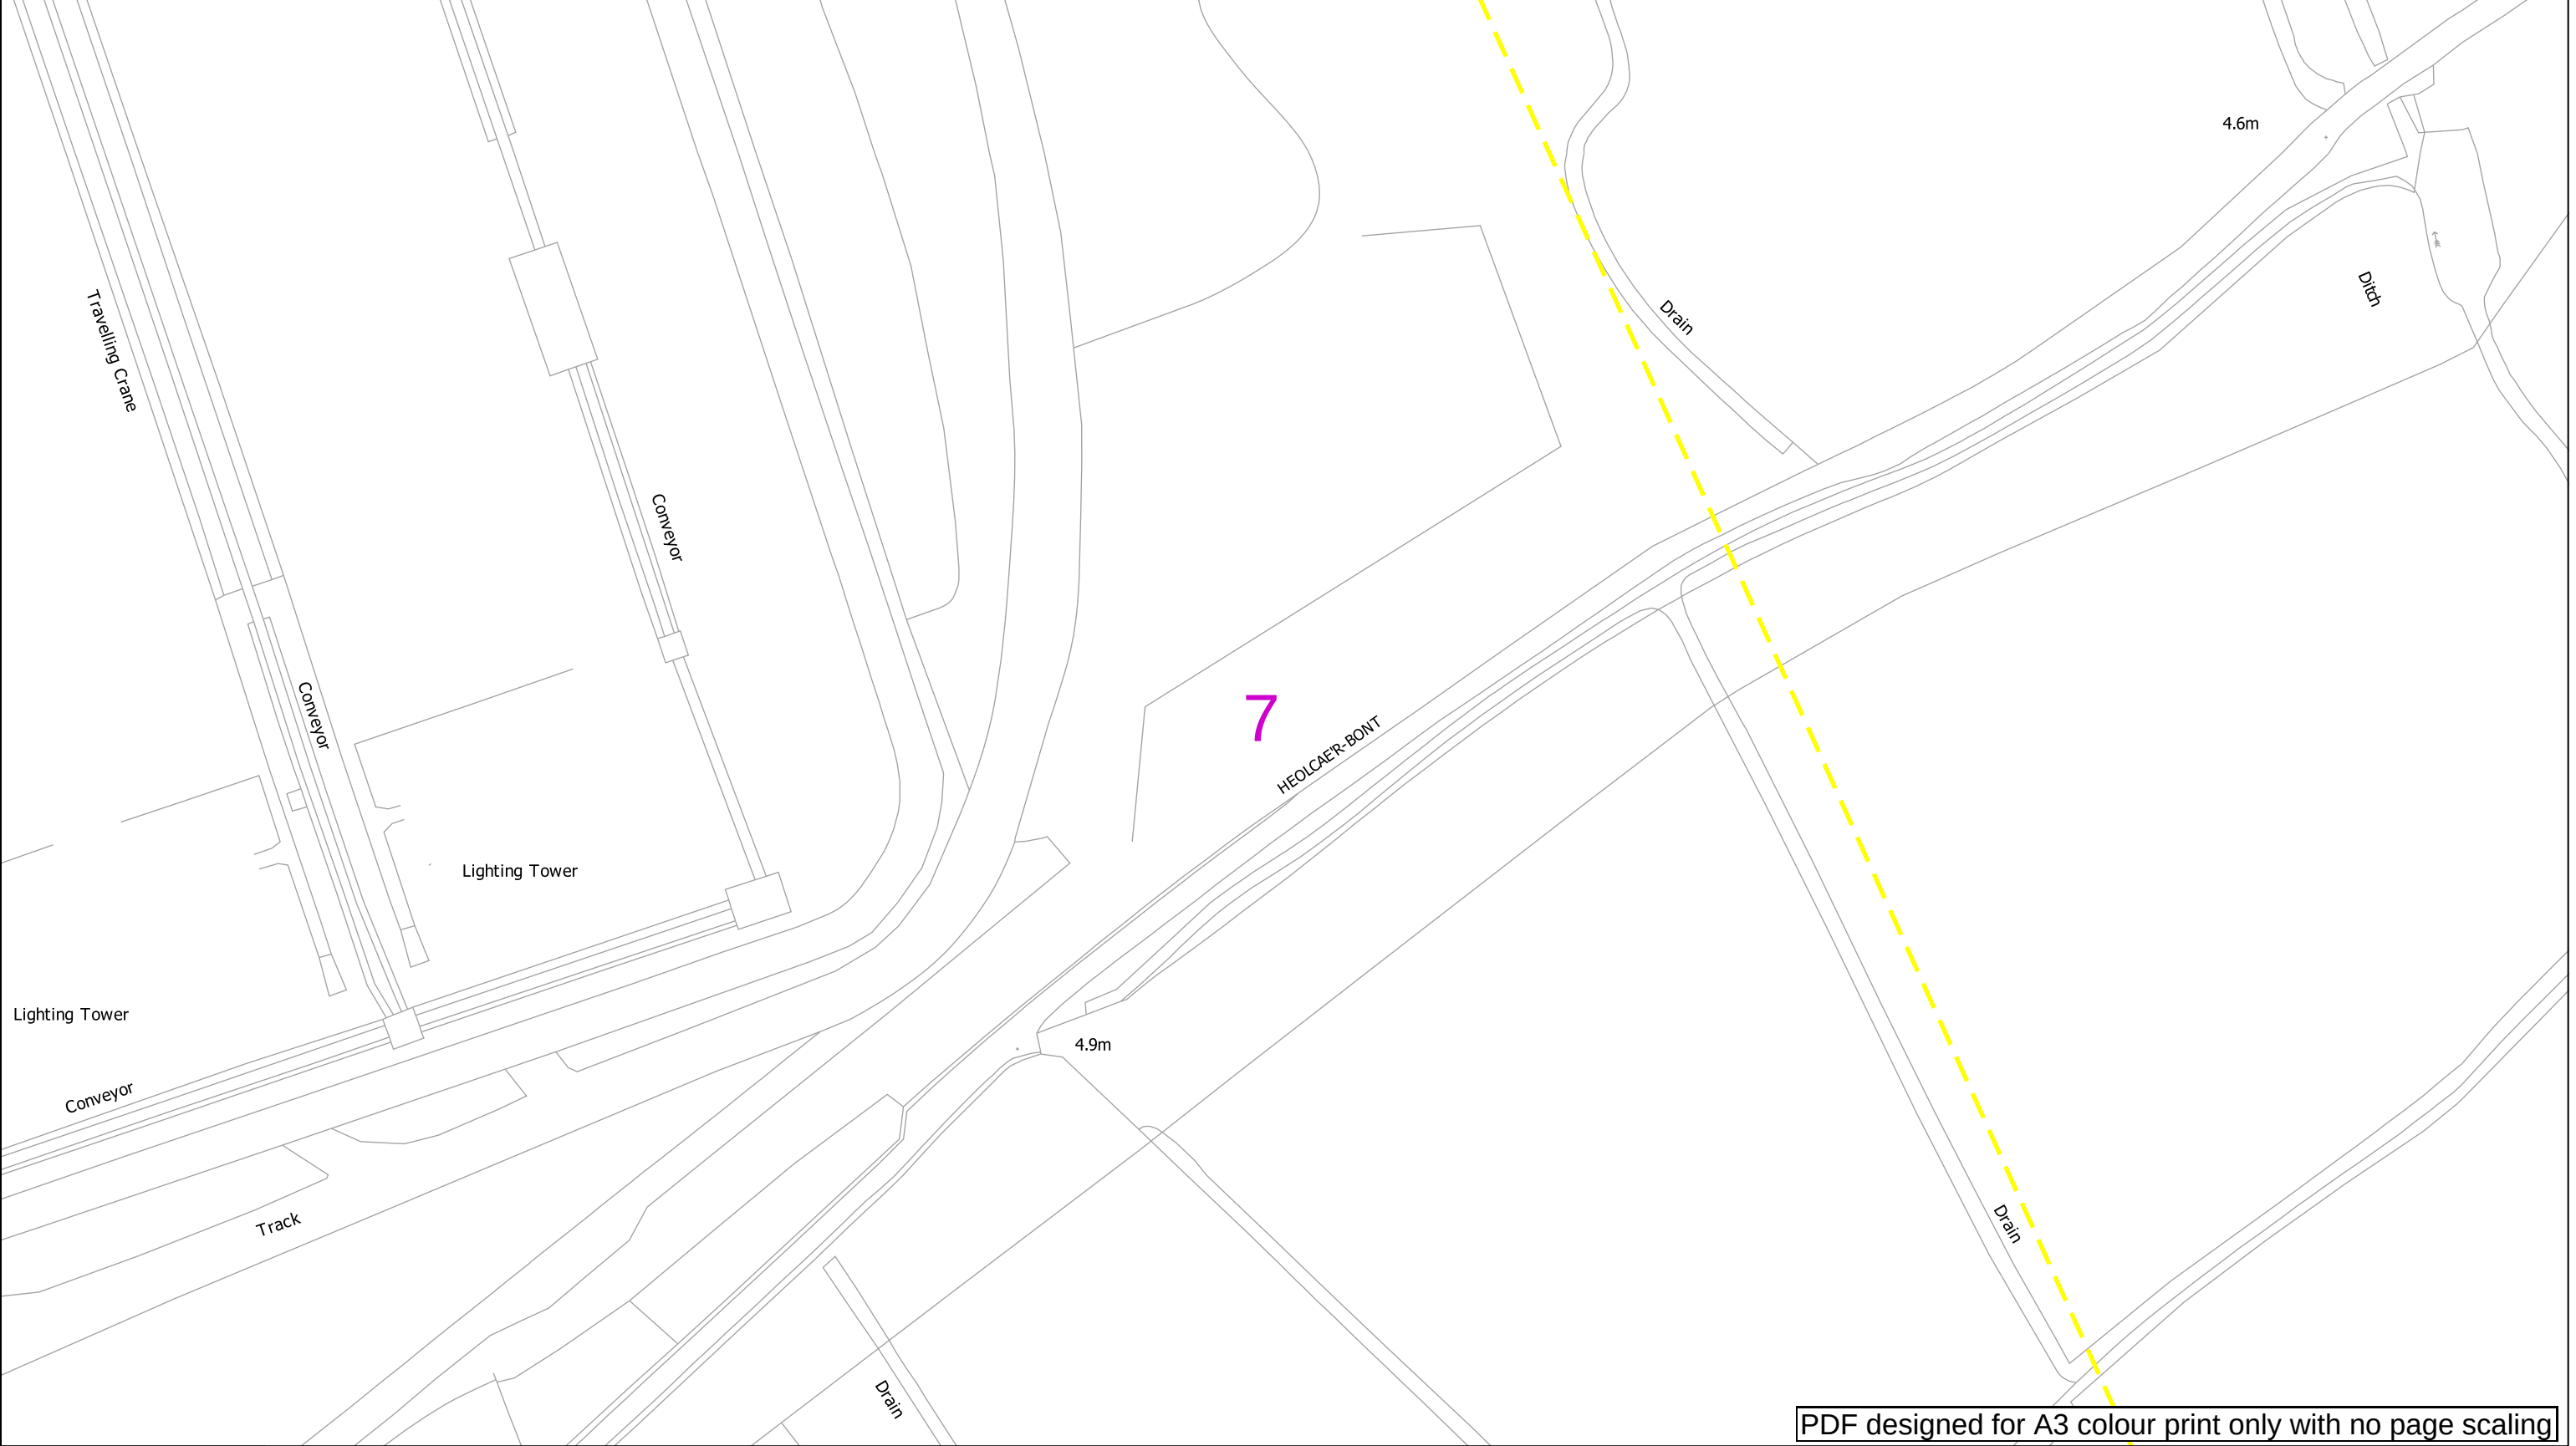

PDF designed for A3 colour print only with no page scaling

Contact Us

Mapping Enquiries: 0121 623 9780

General Enquiries: 0800 096 3080

Date Requested: 24/11/2023

Job Reference: 31655152

Site Location: 278263 185096

Requested by:
Mr Farhan Aslam

Your Scheme/Reference: National Grid Steel Margam FEED

Scale: 1:1250 (When plotted at A3)

IMPORTANT NOTICES

- This information is given as a guide only and its accuracy cannot be guaranteed. Services or recent additions to the network may not be shown.
- Cables, overhead lines & substations owned by other electricity network owners or private companies may be present and may not be shown.
- You should always verify exact locations of cables using a cable locator and by careful use of hand tools in accordance with HSE guidance note HSG47.
- When working within 10m of any overhead electric line you should follow the requirements of HSE Guidance Note GS6.
- For further advice on working near our electricity cables or lines, call our Contact Centre on 0800 096 3080.
- Advice should be sought from the National Grid Electricity Distribution Contact Centre for any work that is to take place in proximity to 66kV or 132kV underground cables and 66kV 132kV overhead lines – 0800 096 3080

Link Box

●

Site Location

Line/Area

Overhead Line

- PL
- Service
- LV
- HV (11kV)
- HV (33kV)
- HV (66kV)
- HV (132kV)

Underground Cable

- PL
- Service
- LV
- HV (11kV)
- HV (33kV)
- HV (66kV)
- HV (132kV)

National Grid Telecoms

Private Cables

PME Earth

Underground Earth

Pilot Cables

Pole Mounted Transformer

Ground Mounted Transformer

Report damage immediately KEEP EVERYONE AWAY FROM THE AREA

0800 6783 105


Email: NGED.MapResponse@NationalGrid.co.uk

Crown Copyright © All Rights Reserved. Ordnance Survey Licence numbers: 100022432. NGED Copyright: This copy has been made by or with the authority of National Grid Electricity Distribution (NGED) pursuant to Section 47 of the Copyright Designs and Patents Act 1988 unless that Act provides a relevant exception to copyright the copy must not be copied without the prior permission of the copyright owner.




PDF designed for A3 colour print only with no page scaling

Contact Us Mapping Enquiries: 0121 623 9780 General Enquiries: 0800 096 3080 Date Requested: 24/11/2023 Job Reference: 31655152 Site Location: 278263 185096 Requested by: Mr Farhan Aslam Your Scheme/Reference: National Grid Steel Margam FEED Scale: 1:1250 (When plotted at A3)	IMPORTANT NOTICES • This information is given as a guide only and its accuracy cannot be guaranteed. Services or recent additions to the network may not be shown. • Cables, overhead lines & substations owned by other electricity network owners or private companies may be present and may not be shown. • You should always verify exact locations of cables using a cable locator and by careful use of hand tools in accordance with HSE guidance note HSG47. • When working within 10m of any overhead electric line you should follow the requirements of HSE Guidance Note GS6. • For further advice on working near our electricity cables or lines, call our Contact Centre on 0800 096 3080. • Advice should be sought from the National Grid Electricity Distribution Contact Centre for any work that is to take place in proximity to 66kV or 132kV underground cables and 66kV 132kV overhead lines – 0800 096 3080	0100m Link Box Site Location Line/Area Overhead Line PL Service LV HV (11kV) HV (33kV) HV (66kV) HV (132kV) Underground Cable National Grid Telecoms Private Cables PME Earth Underground Earth Pilot Cables Pole Mounted Transformer Ground Mounted Transformer Report damage immediately KEEP EVERYONE AWAY FROM THE AREA 0800 6783 105	Email: NGED.MapResponse@NationalGrid.co.uk
Crown Copyright © All Rights Reserved. Ordnance Survey Licence numbers: 100022432. NGED Copyright: This copy has been made by or with the authority of National Grid Electricity Distribution (NGED) pursuant to Section 47 of the Copyright Designs and Patents Act 1988 unless that Act provides a relevant exception to copyright the copy must not be copied without the prior permission of the copyright owner.			

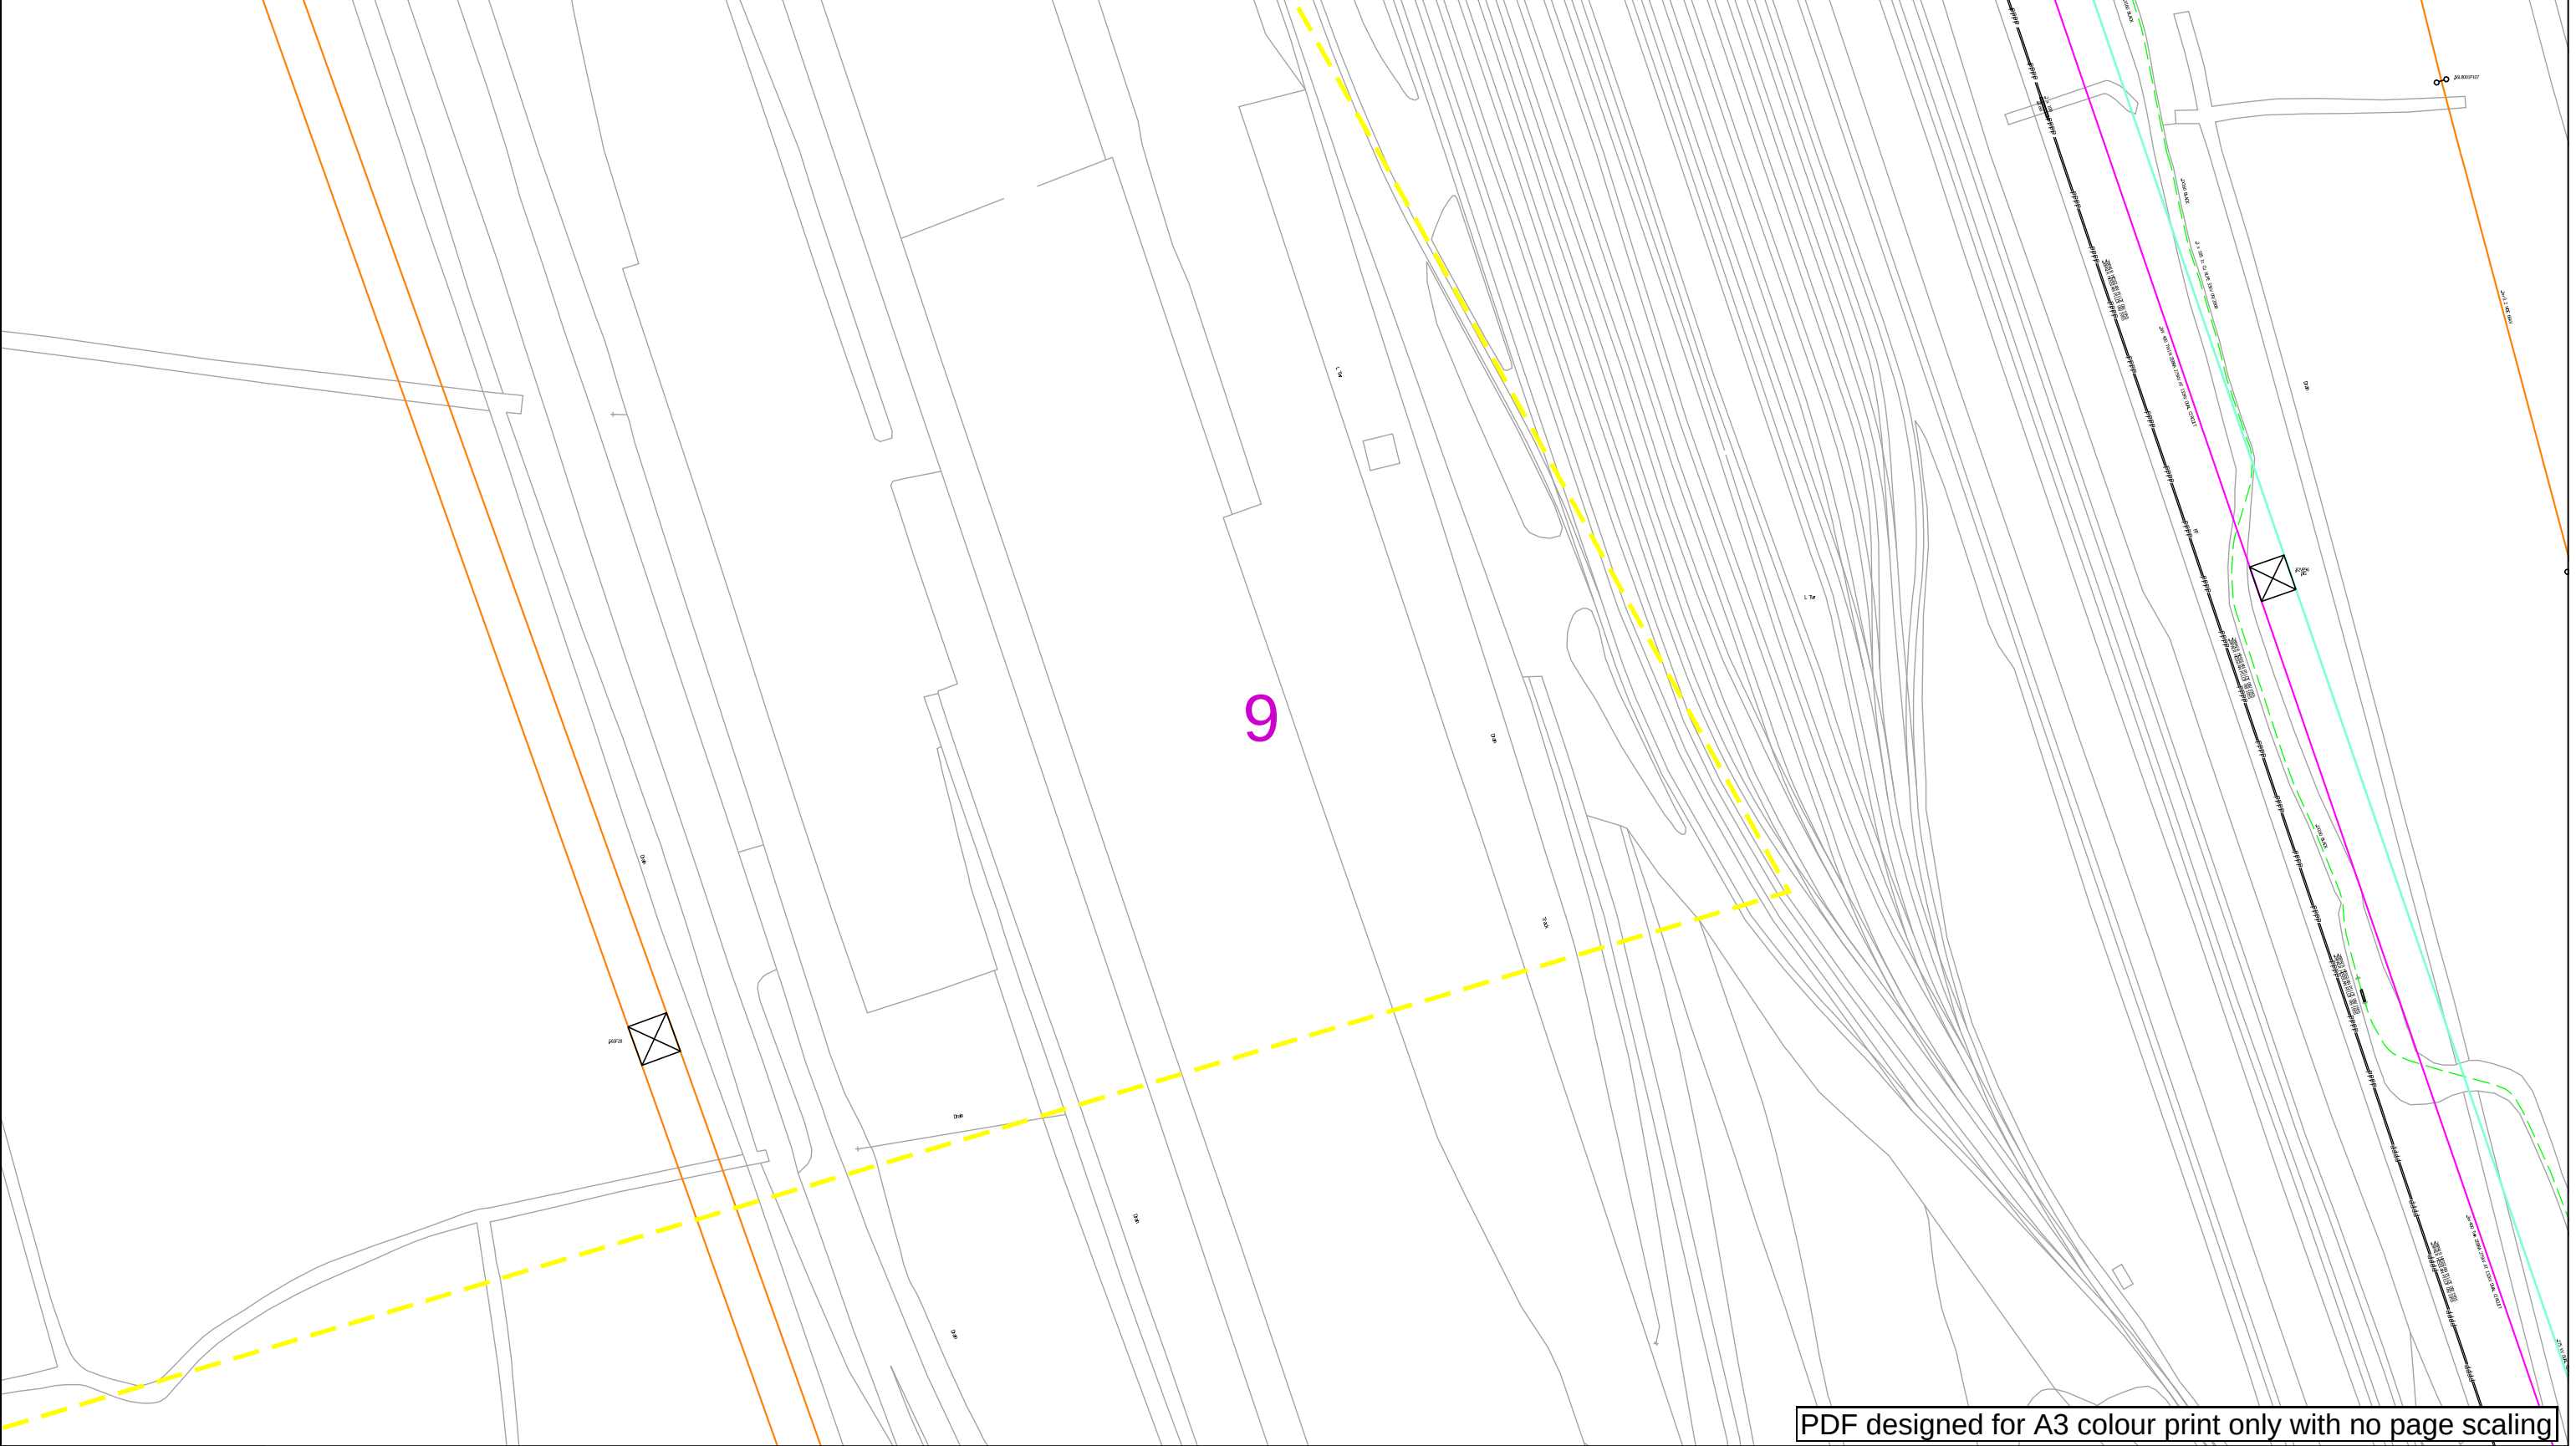

PDF designed for A3 colour print only with no page scaling

Contact Us Mapping Enquiries: 0121 623 9780 General Enquiries: 0800 096 3080 Date Requested: 24/11/2023 Job Reference: 31655152 Site Location: 278263 185096 Requested by: Mr Farhan Aslam Your Scheme/Reference: National Grid Steel Margam FEED Scale: 1:1250 (When plotted at A3)	IMPORTANT NOTICES - This information is given as a guide only and its accuracy cannot be guaranteed. Services or recent additions to the network may not be shown. - Cables, overhead lines & substations owned by other electricity network owners or private companies may be present and may not be shown. - You should always verify exact locations of cables using a cable locator and by careful use of hand tools in accordance with HSE guidance note HSG47. - When working within 10m of any overhead electric line you should follow the requirements of HSE Guidance Note GS6. - For further advice on working near our electricity cables or lines, call our Contact Centre on 0800 096 3080. - Advice should be sought from the National Grid Electricity Distribution Contact Centre for any work that is to take place in proximity to 66kV or 132kV underground cables and 66kV 132kV overhead lines – 0800 096 3080	0100m Link Box Site Location Line/Area Overhead Line PL Service LV HV (11kV) HV (33kV) HV (66kV) HV (132kV) Underground Cable National Grid Telecoms Private Cables PME Earth Underground Earth Pilot Cables Pole Mounted Transformer Ground Mounted Transformer Report damage immediately KEEP EVERYONE AWAY FROM THE AREA 0800 6783 105	Email: NGED.MapResponse@NationalGrid.co.uk
---	---	--	---

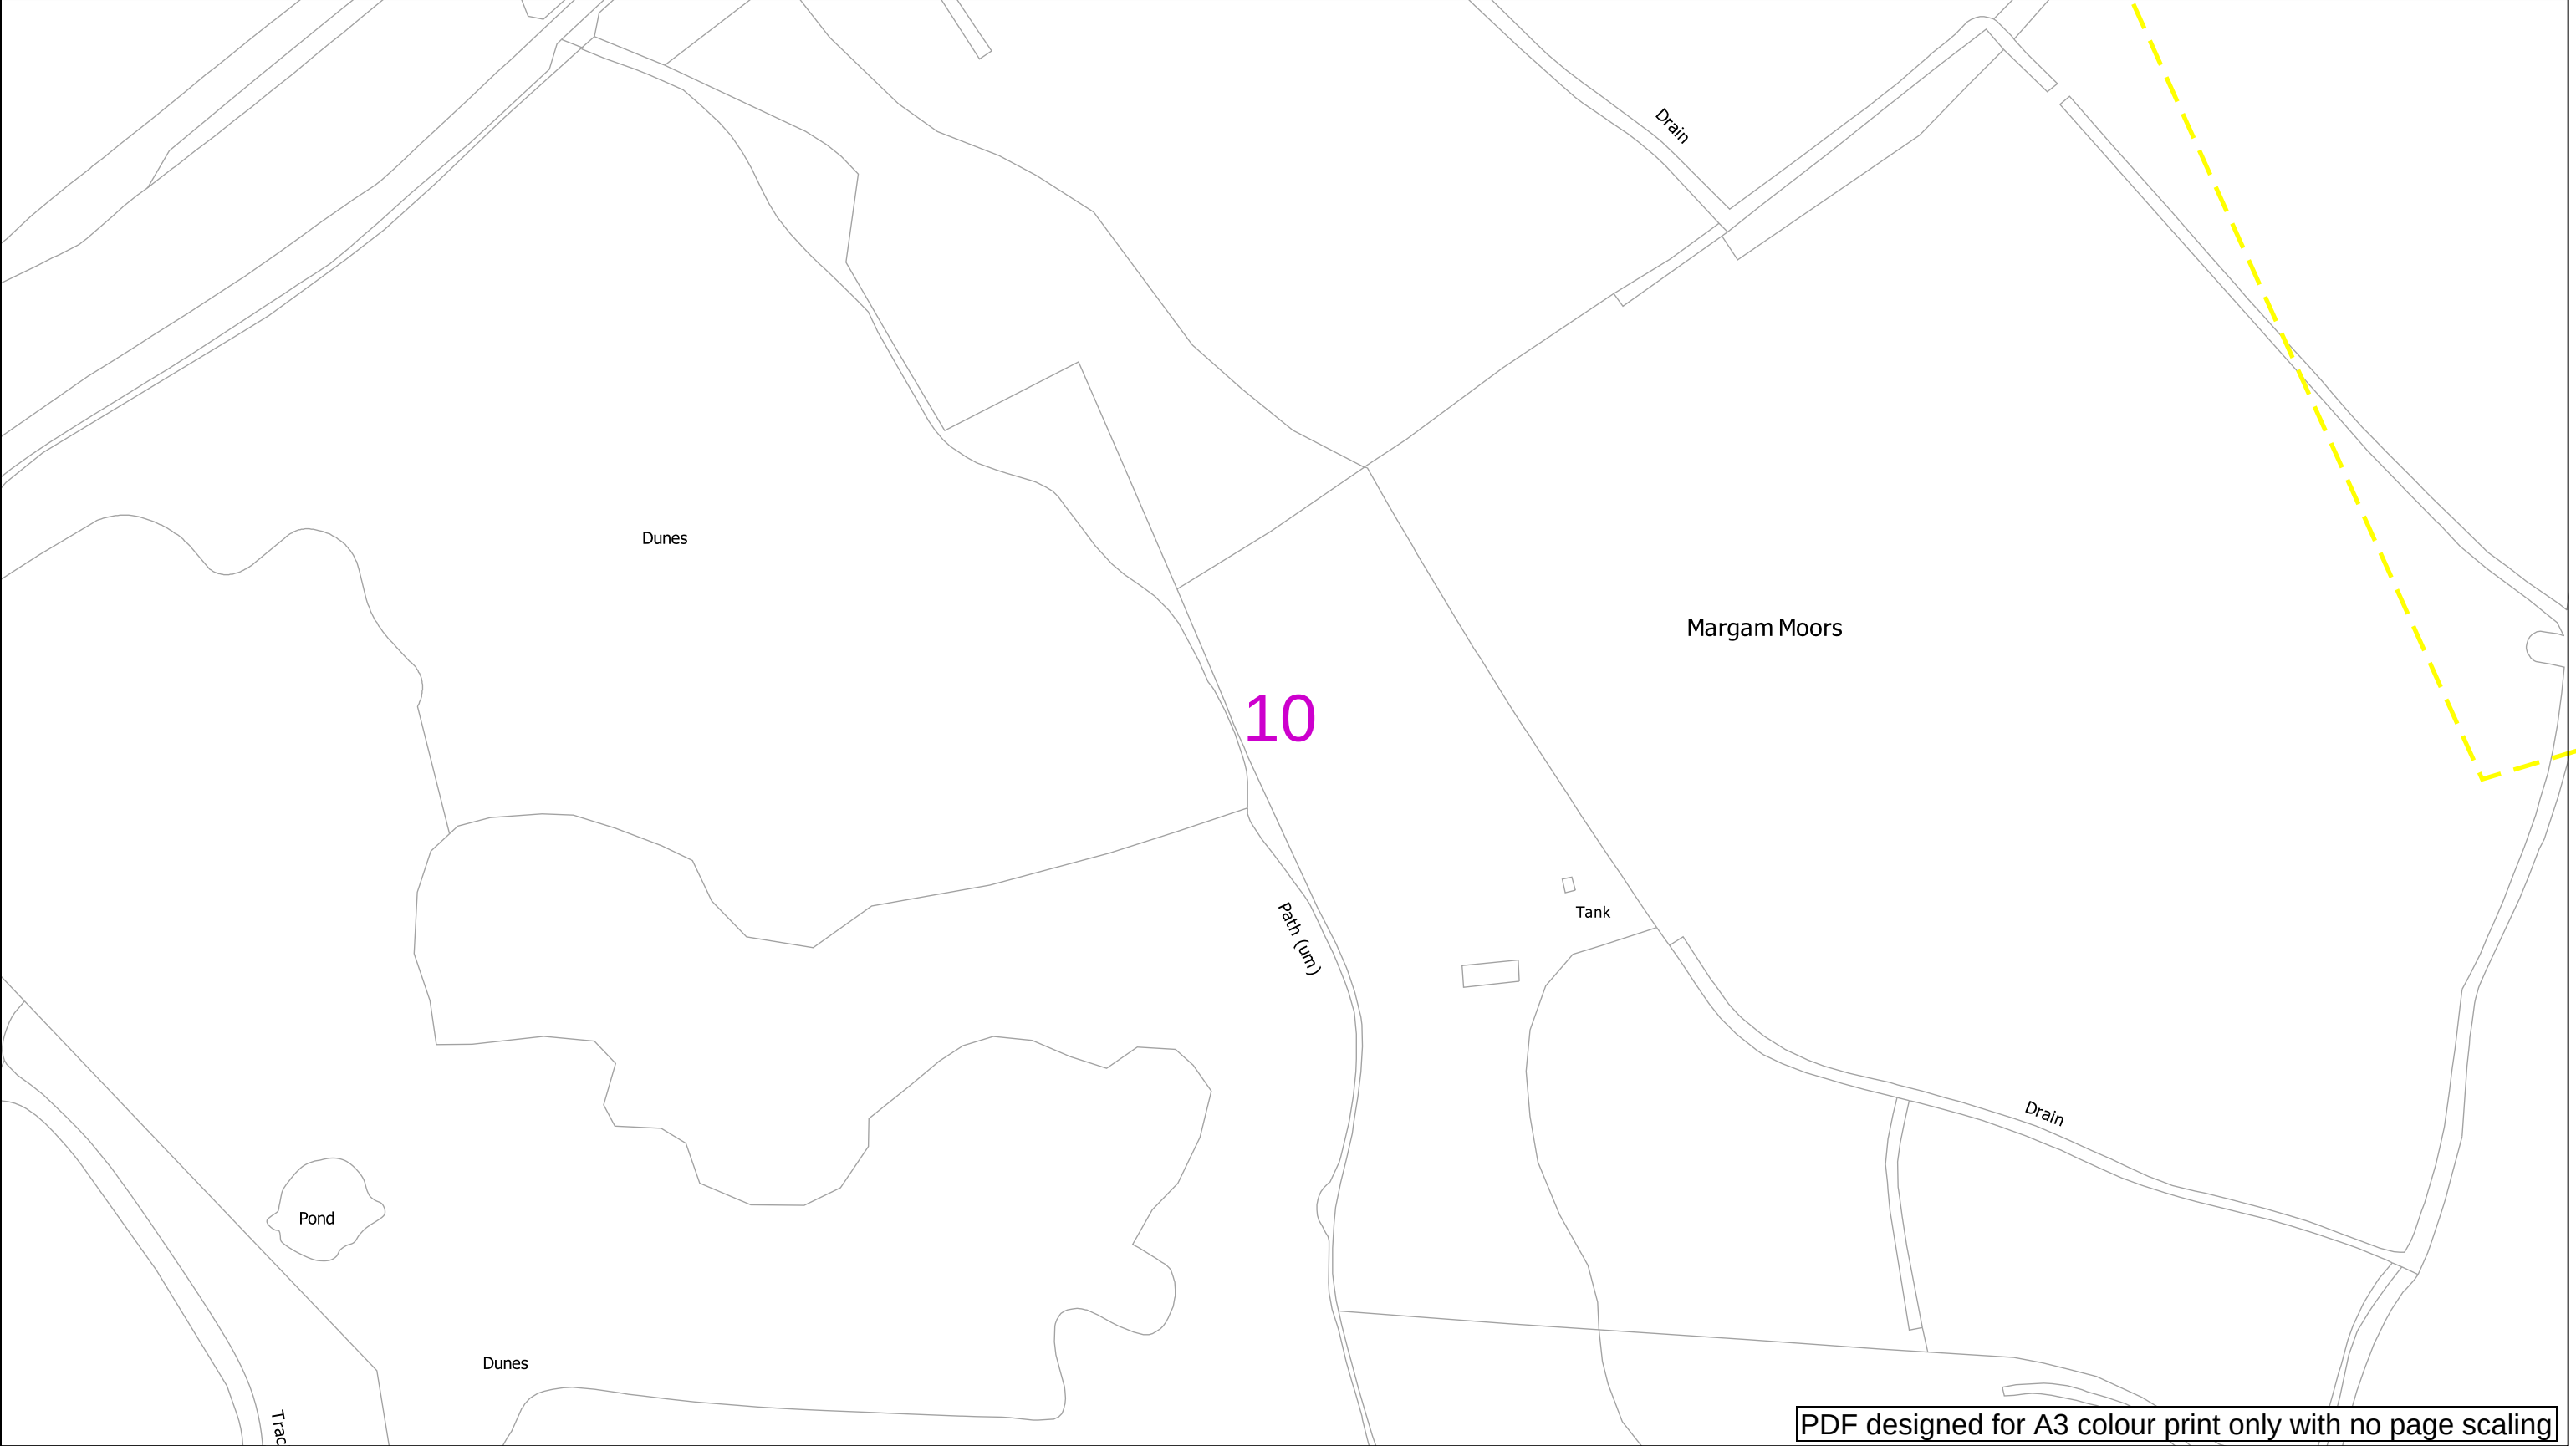

PDF designed for A3 colour print only with no page scaling

Contact Us

Mapping Enquiries: 0121 623 9780

General Enquiries: 0800 096 3080

Date Requested: 24/11/2023

Job Reference: 31655152

Site Location: 278263 185096

Requested by:
Mr Farhan Aslam

Your Scheme/Reference: National Grid Steel Margam FEED

Scale: 1:1250 (When plotted at A3)

IMPORTANT NOTICES

- This information is given as a guide only and its accuracy cannot be guaranteed. Services or recent additions to the network may not be shown.
- Cables, overhead lines & substations owned by other electricity network owners or private companies may be present and may not be shown.
- You should always verify exact locations of cables using a cable locator and by careful use of hand tools in accordance with HSE guidance note HSG47.
- When working within 10m of any overhead electric line you should follow the requirements of HSE Guidance Note GS6.
- For further advice on working near our electricity cables or lines, call our Contact Centre on 0800 096 3080.
- Advice should be sought from the National Grid Electricity Distribution Contact Centre for any work that is to take place in proximity to 66kV or 132kV underground cables and 66kV 132kV overhead lines – 0800 096 3080

0100m

Link Box

●

Site Location

Line/Area

—|—|—|

Overhead Line

—○—

—○—

—○—

—○—

—○—

—○—

PL

Service

LV

HV (11kV)

HV (33kV)

HV (66kV)

HV (132kV)

Underground Cable

— — —

— — —

— — —

— — —

— — —

— — —

PL

Service

LV

HV (11kV)

HV (33kV)

HV (66kV)

HV (132kV)

National Grid Telecoms

—S—S—

Private Cables

—|—|—|

PME Earth

—E—|—|—|

Underground Earth

Pilot Cables

—P—P—

○

□

Pole Mounted Transformer


Ground Mounted Transformer

Report damage immediately KEEP EVERYONE AWAY FROM THE AREA

0800 6783 105

Email: NGED.MapResponse@NationalGrid.co.uk


Crown Copyright © All Rights Reserved. Ordnance Survey Licence numbers: 100022432. NGED Copyright: This copy has been made by or with the authority of National Grid Electricity Distribution (NGED) pursuant to Section 47 of the Copyright Designs and Patents Act 1988 unless that Act provides a relevant exception to copyright the copy must not be copied without the prior permission of the copyright owner.

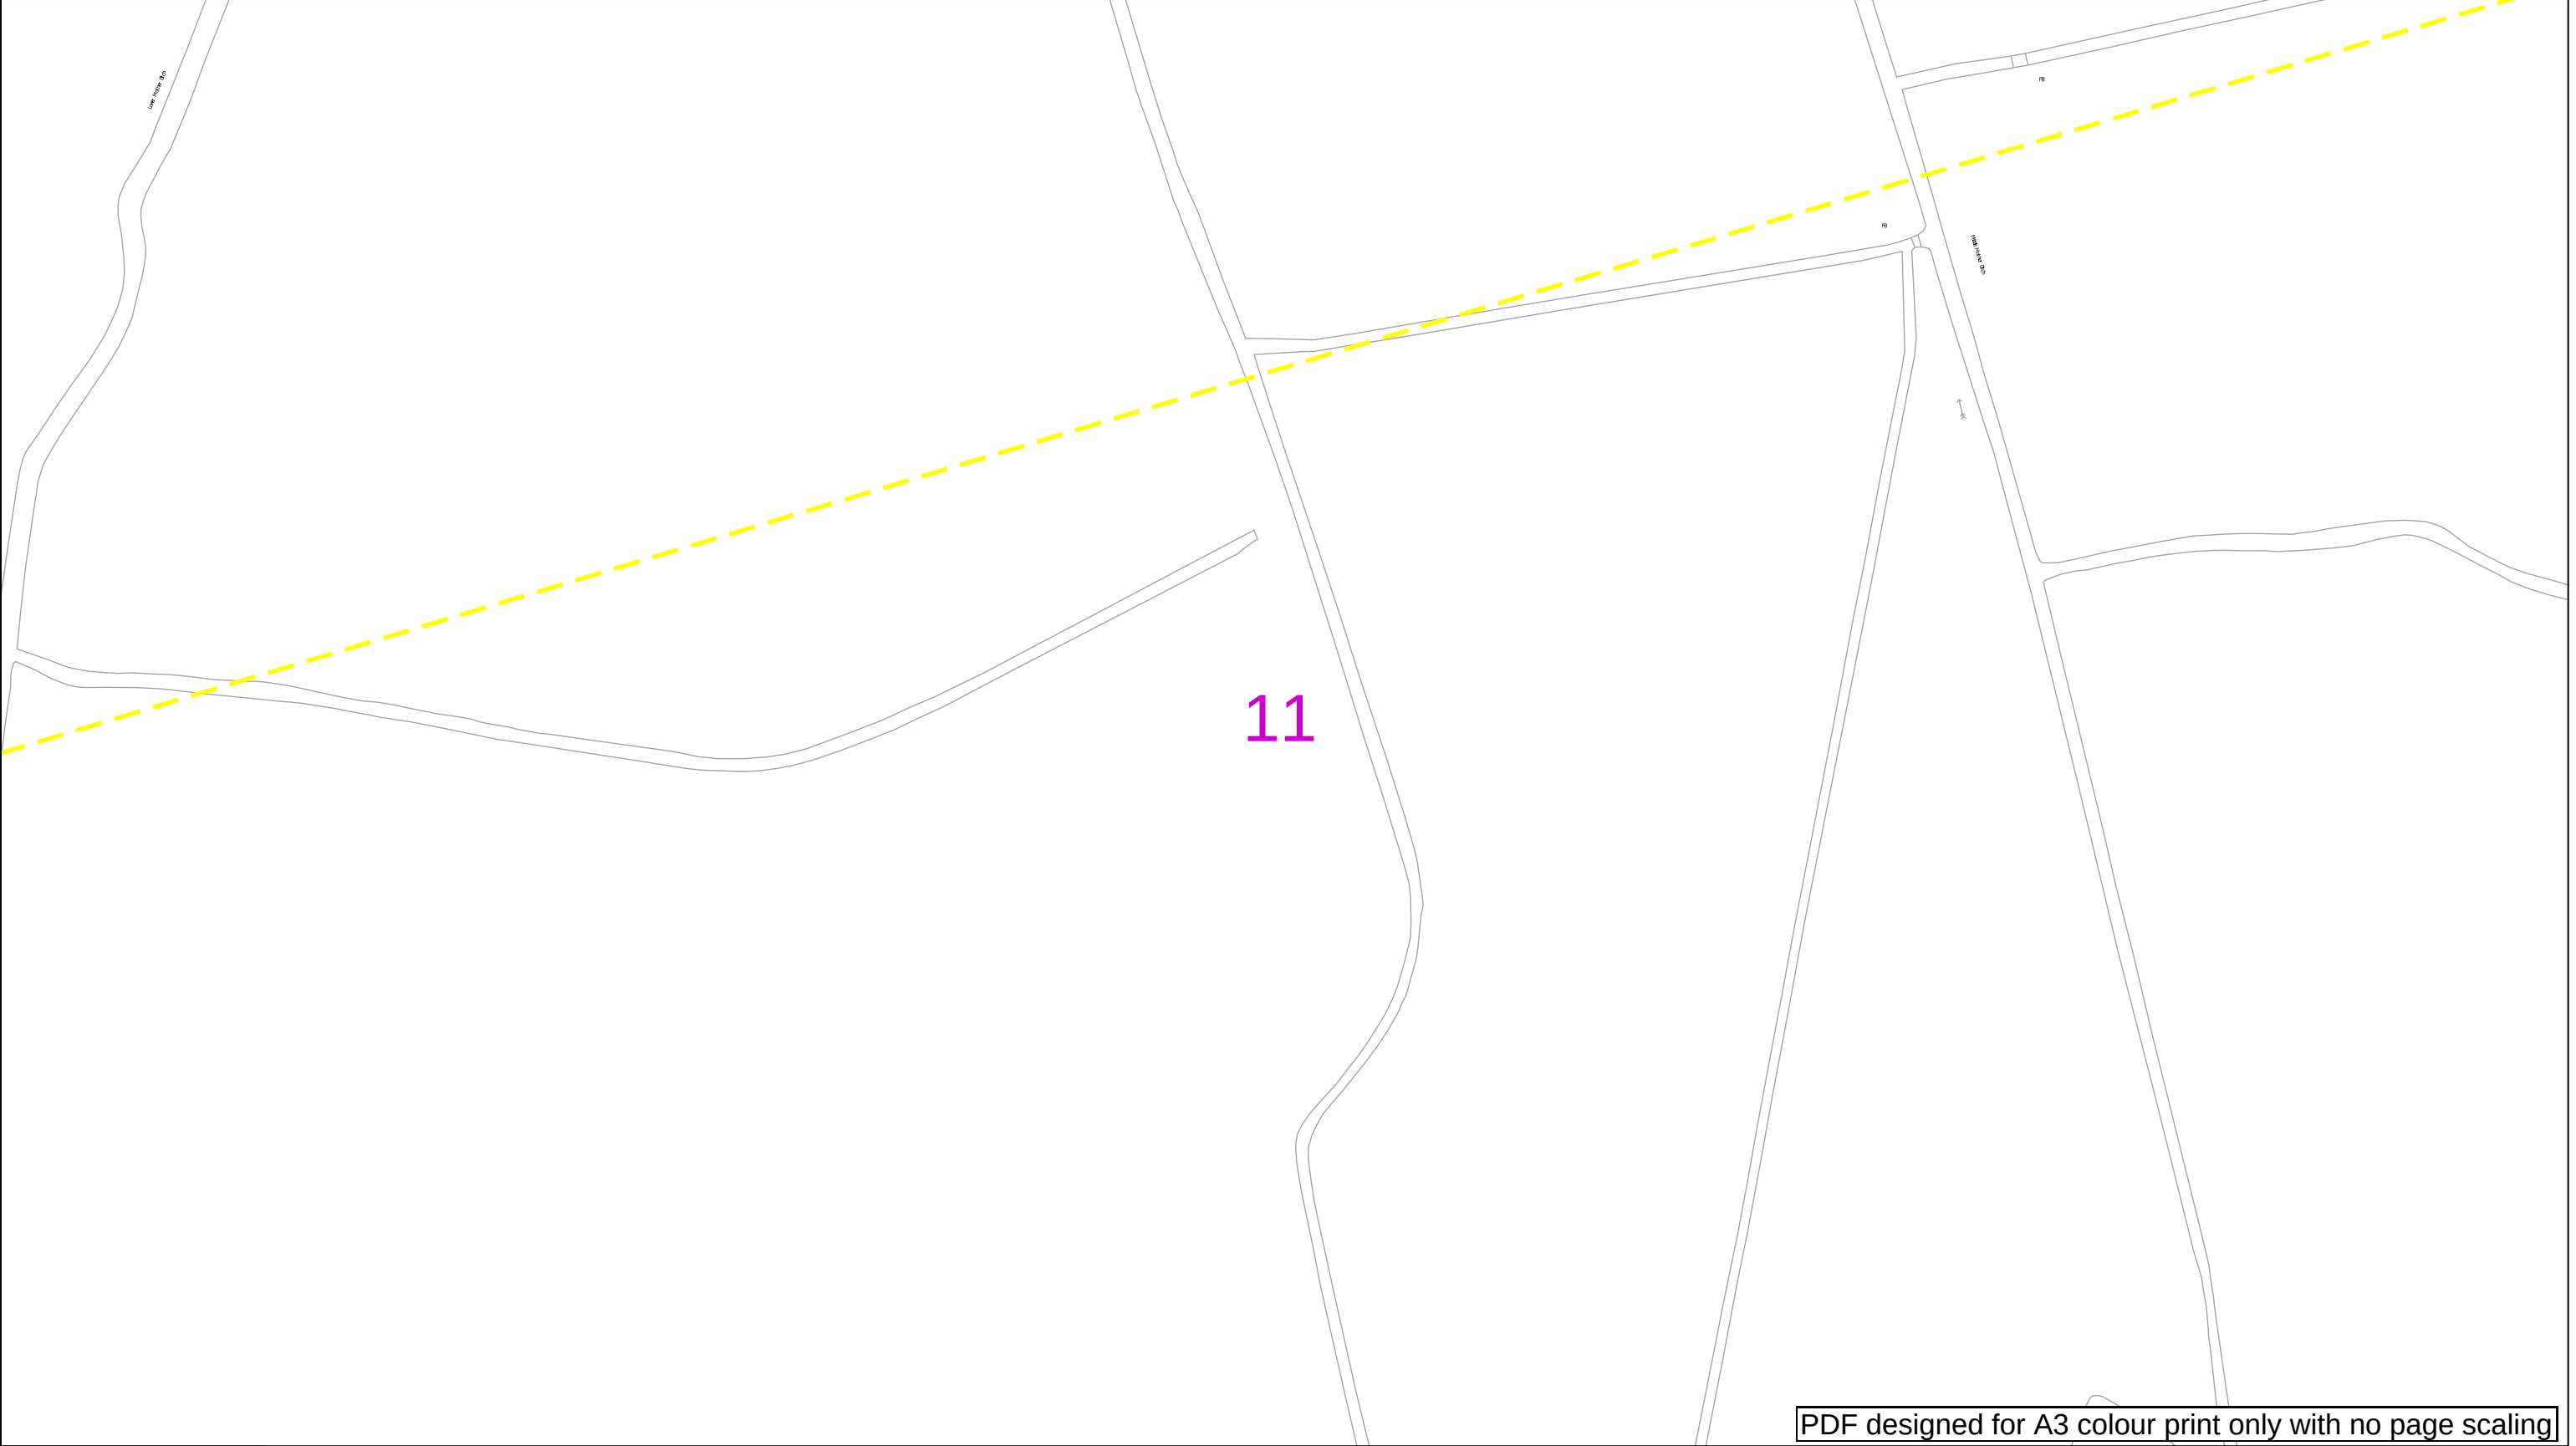

PDF designed for A3 colour print only with no page scaling


Contact Us Mapping Enquiries: 0121 623 9780 General Enquiries: 0800 096 3080 Date Requested: 24/11/2023 Job Reference: 31655152 Site Location: 278263 185096 Requested by: Mr Farhan Aslam Your Scheme/Reference: National Grid Steel Margam FEED Scale: 1:1250 (When plotted at A3)	IMPORTANT NOTICES - This information is given as a guide only and its accuracy cannot be guaranteed. Services or recent additions to the network may not be shown. - Cables, overhead lines & substations owned by other electricity network owners or private companies may be present and may not be shown. - You should always verify exact locations of cables using a cable locator and by careful use of hand tools in accordance with HSE guidance note HSG47. - When working within 10m of any overhead electric line you should follow the requirements of HSE Guidance Note GS6. - For further advice on working near our electricity cables or lines, call our Contact Centre on 0800 096 3080. - Advice should be sought from the National Grid Electricity Distribution Contact Centre for any work that is to take place in proximity to 66kV or 132kV underground cables and 66kV 132kV overhead lines – 0800 096 3080	0100m Link Box Site Location Line/Area Overhead Line PL Service LV HV (11kV) HV (33kV) HV (66kV) HV (132kV) Underground Cable National Grid Telecoms Private Cables PME Earth Underground Earth Pilot Cables Pole Mounted Transformer Ground Mounted Transformer Report damage immediately KEEP EVERYONE AWAY FROM THE AREA 0800 6783 105	Email: NGED.MapResponse@NationalGrid.co.uk
--	---	--	---

Crown Copyright © All Rights Reserved. Ordnance Survey Licence numbers: 100022432. NGED Copyright: This copy has been made by or with the authority of National Grid Electricity Distribution (NGED) pursuant to Section 47 of the Copyright Designs and Patents Act 1988 unless that Act provides a relevant exception to copyright the copy must not be copied without the prior permission of the copyright owner.

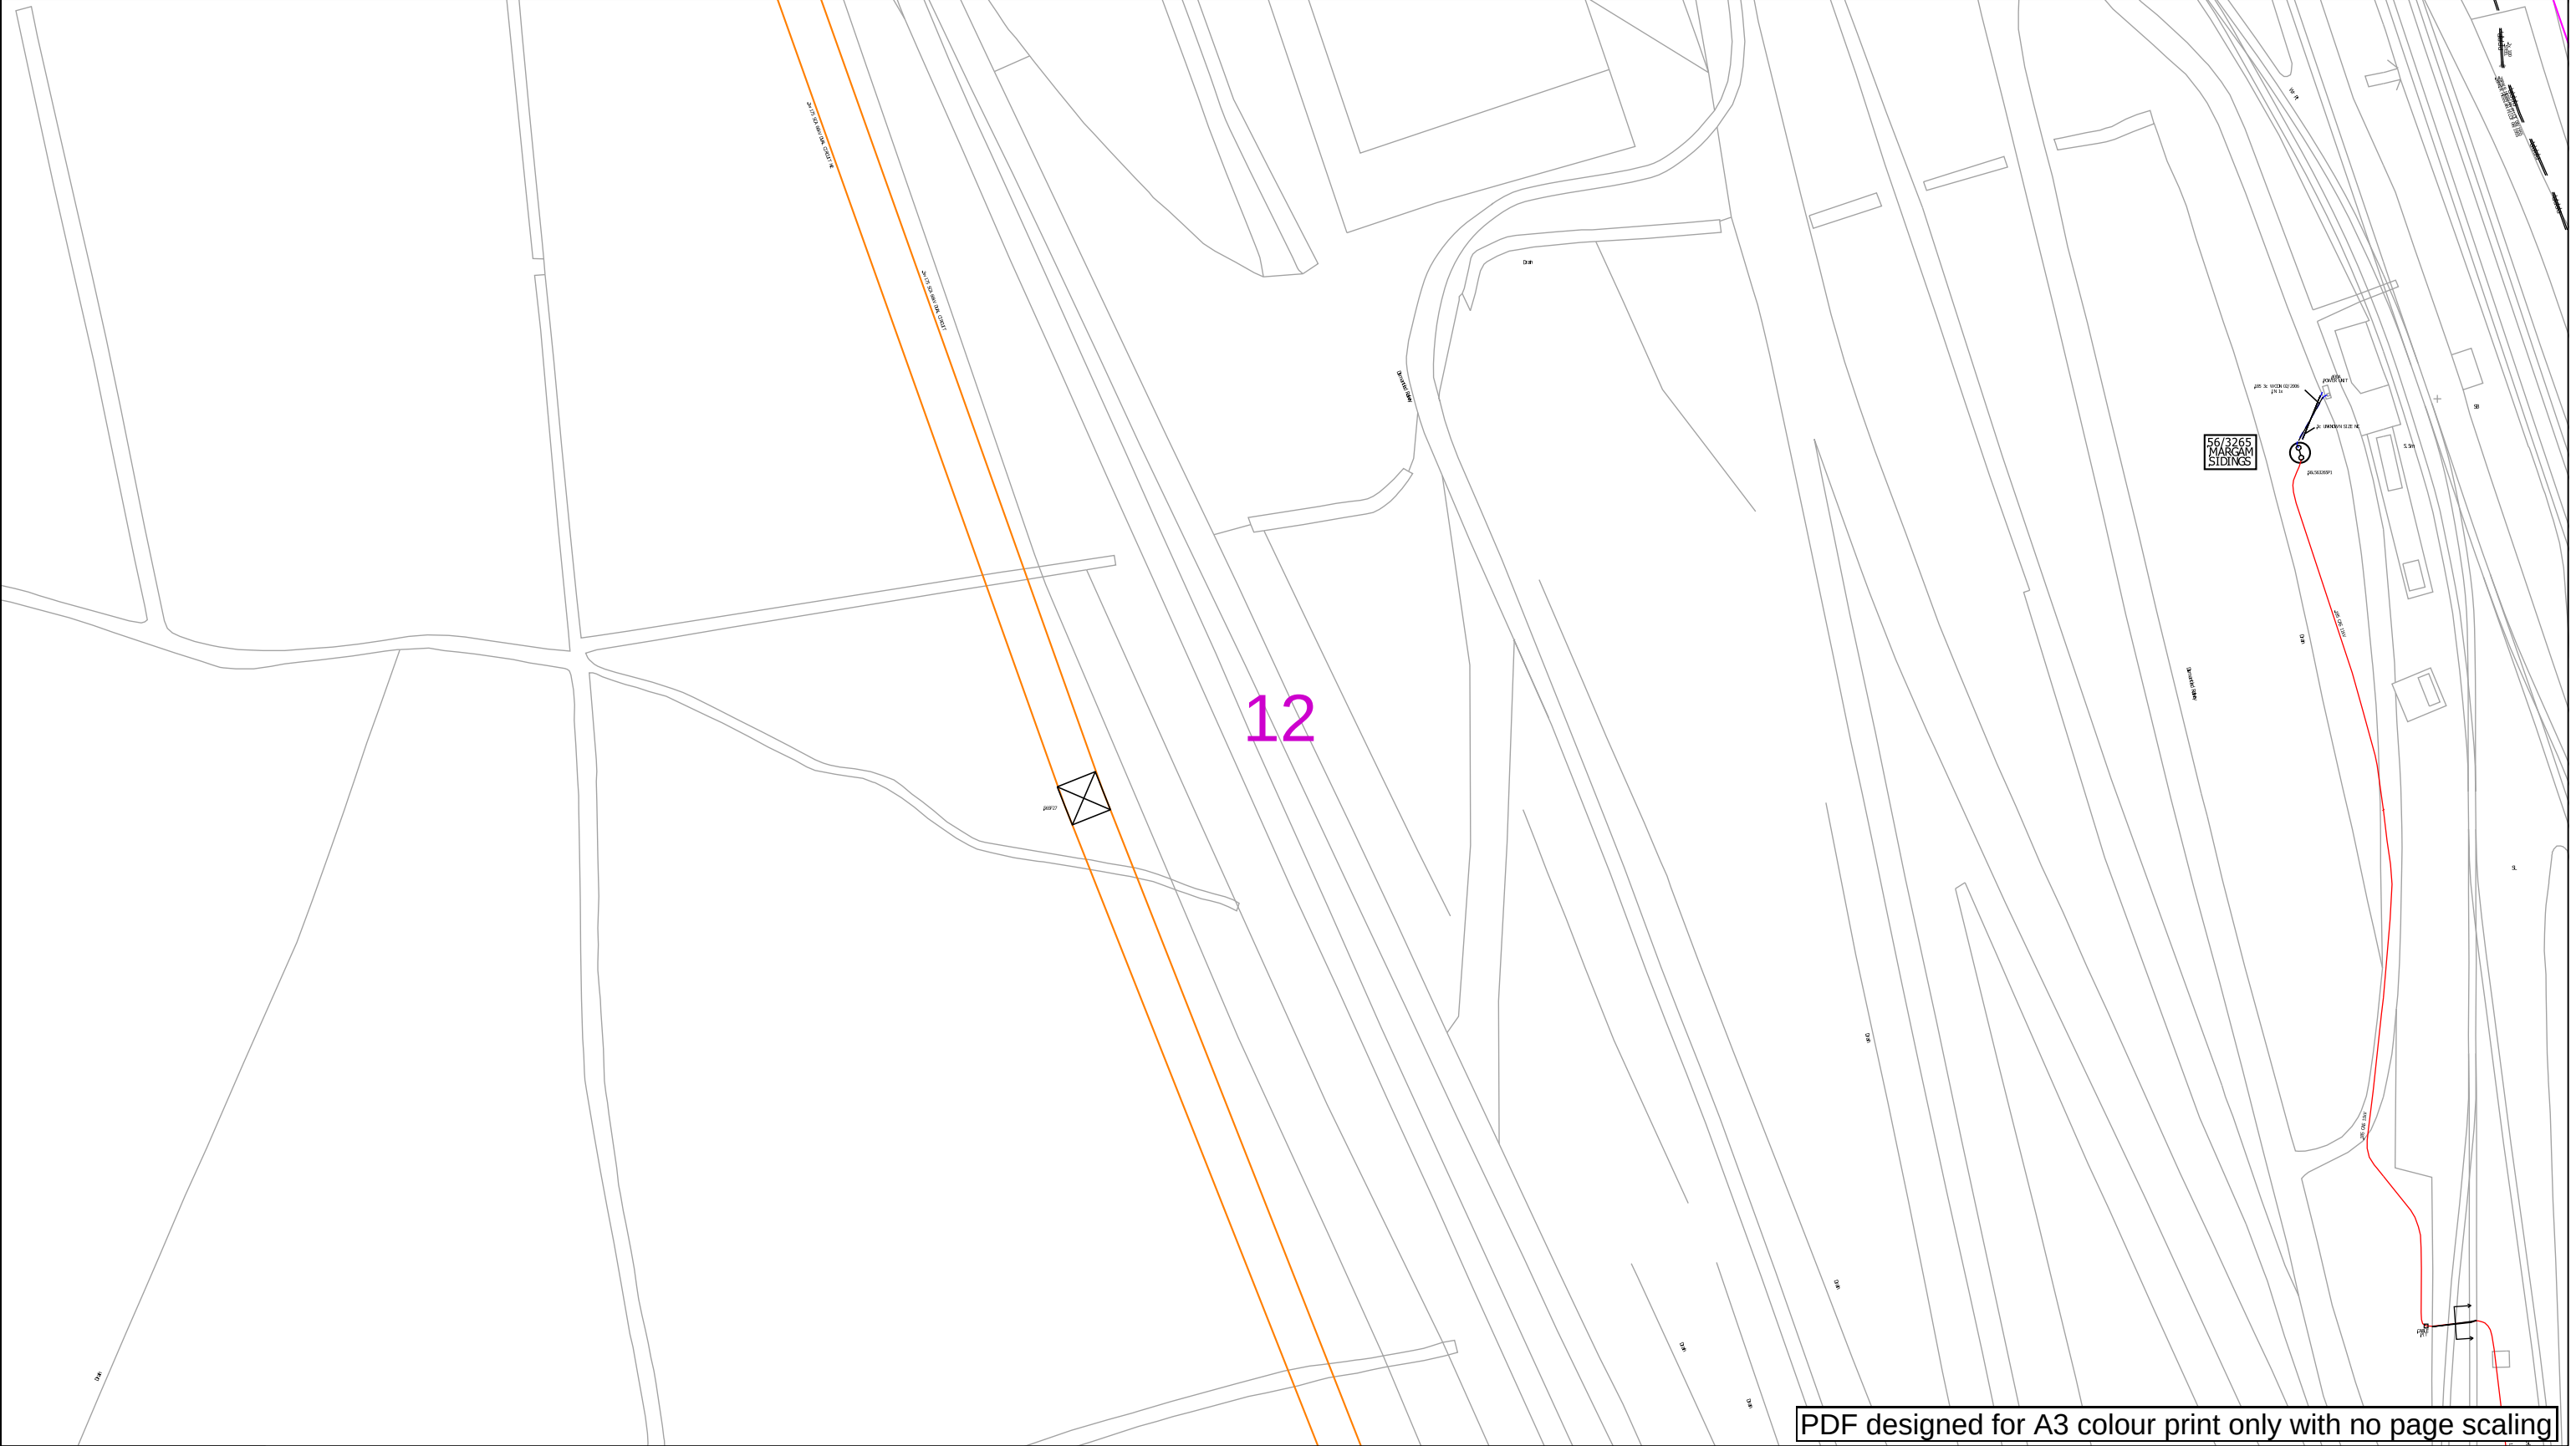

PDF designed for A3 colour print only with no page scaling

Contact Us Mapping Enquiries: 0121 623 9780 General Enquiries: 0800 096 3080 Date Requested: 24/11/2023 Job Reference: 31655152 Site Location: 278263 185096 Requested by: Mr Farhan Aslam Your Scheme/Reference: National Grid Steel Margam FEED Scale: 1:1250 (When plotted at A3)	IMPORTANT NOTICES - This information is given as a guide only and its accuracy cannot be guaranteed. Services or recent additions to the network may not be shown. - Cables, overhead lines & substations owned by other electricity network owners or private companies may be present and may not be shown. - You should always verify exact locations of cables using a cable locator and by careful use of hand tools in accordance with HSE guidance note HSG47. - When working within 10m of any overhead electric line you should follow the requirements of HSE Guidance Note GS6. - For further advice on working near our electricity cables or lines, call our Contact Centre on 0800 096 3080. - Advice should be sought from the National Grid Electricity Distribution Contact Centre for any work that is to take place in proximity to 66kV or 132kV underground cables and 66kV 132kV overhead lines – 0800 096 3080	0100m Link Box Site Location Line/Area Overhead Line PL Service LV HV (11kV) HV (33kV) HV (66kV) HV (132kV) Underground Cable PL Service LV HV (11kV) HV (33kV) HV (66kV) HV (132kV) National Grid Telecoms Private Cables PME Earth Underground Earth Pilot Cables Pole Mounted Transformer Ground Mounted Transformer Report damage immediately KEEP EVERYONE AWAY FROM THE AREA 0800 6783 105	Email: NGED.MapResponse@NationalGrid.co.uk
---	---	--	---

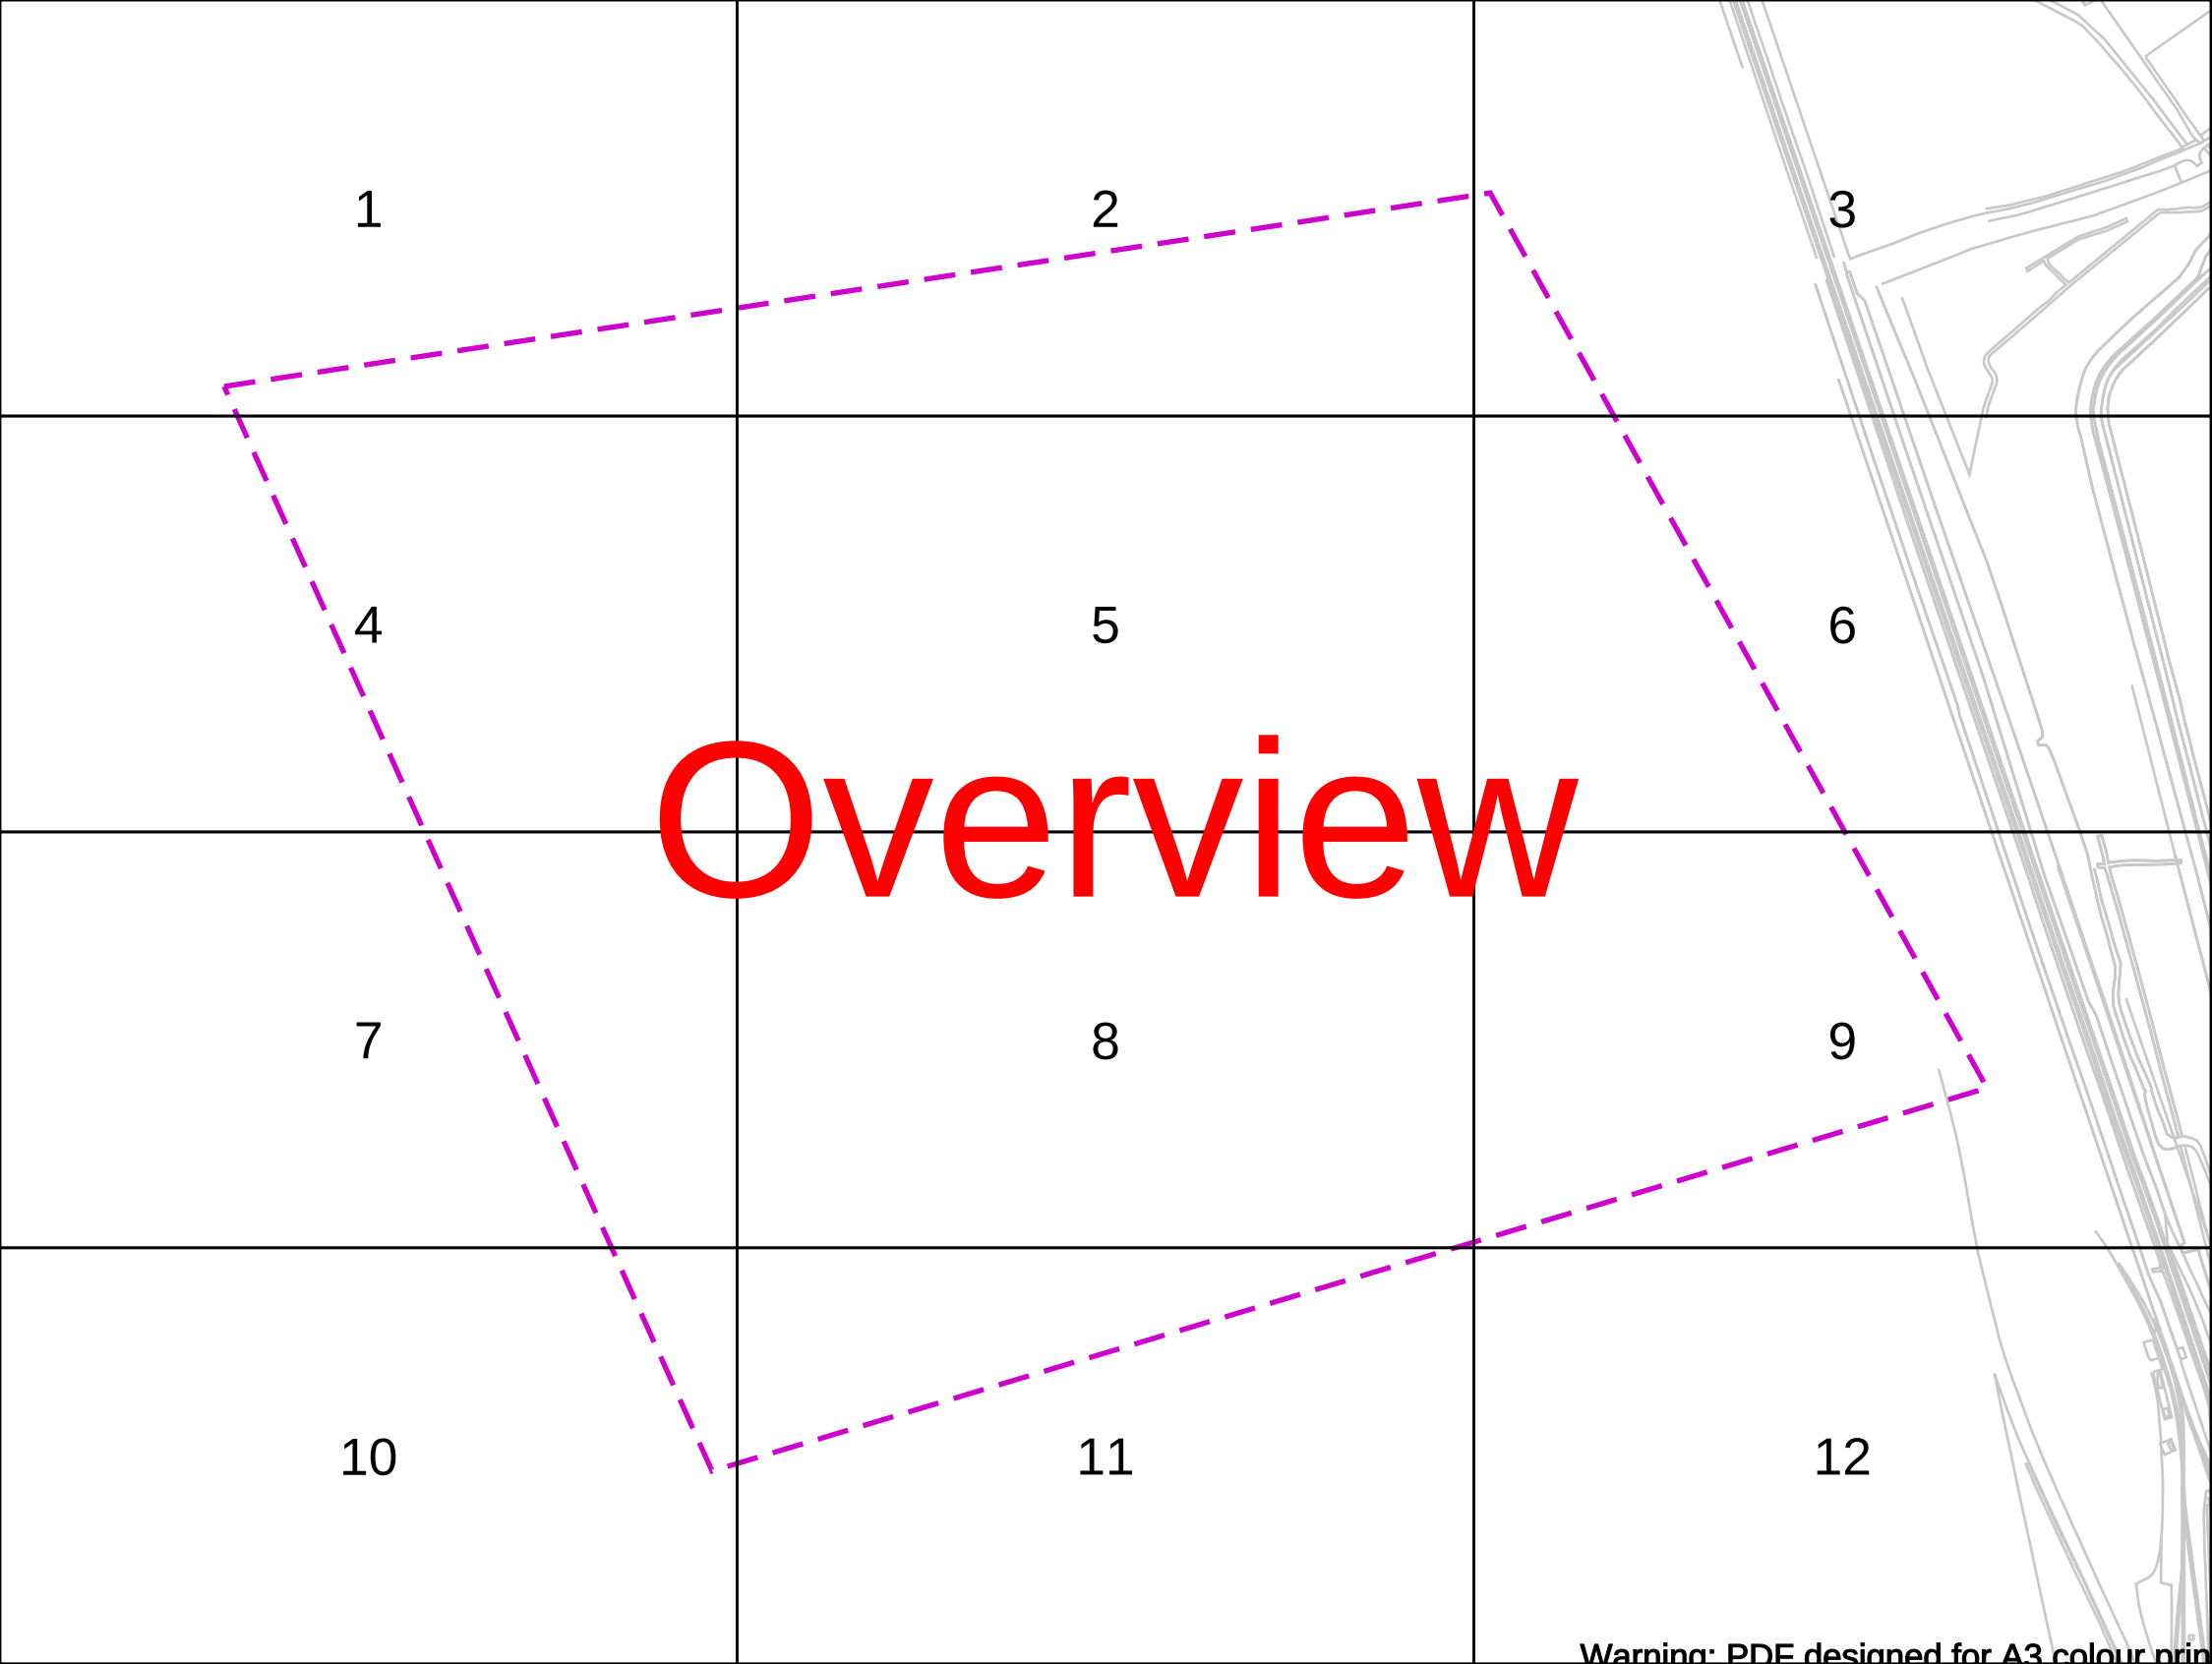

Warning: PDF designed for A3 colour print only with no page scaling

Contact Us
Mapping Enquiries: 02920 278 912
General Enquiries: 0800 912 2999

Date Requested: 24/11/2023
Job Reference: 31655152
Site Location: 278263 185096

Requested by:
Mr Farhan Aslam
Your Scheme/Reference:
National Grid Steel Margam
FEED

Scale: 1:5125 (When plotted at A3)

- IMPORTANT NOTICES
- This information is given as a guide only and its accuracy cannot be guaranteed
 - The plan only shows those pipes owned by Wales & West Utilities (WWU) as its role as a licensed Gas Transporter
 - Service pipes, valves, syphons, stub connections etc. may not be shown but their presence should be anticipated
 - You must use safe digging practices in accordance with HS(G)47 to establish the actual position of mains, services and other apparatus before any mechanical excavation is used
 - It is your responsibility to ensure this information is provided to all persons working near our plant
 - If in doubt call the WWU dig team on 02920 278912

In case of an emergency call 0800 111 999

Dig Sites

— Low Pressure (LP) 21mbar – 75mbar

- - - Medium Pressure (MP) 350mbar – 2bar

- . - . Intermediate Pressure (IP) 2bar – 7bar

- . . . High Pressure (HP) >7bar

Area:  Line: 

Low Pressure (LP) 21mbar – 75mbar

Medium Pressure (MP) 350mbar – 2bar

Intermediate Pressure (IP) 2bar – 7bar

High Pressure (HP) >7bar

 Line/Fire Valve

 Governor Station

 Change of Diameter


 End Cap

 Depth of cover



Warning: PDF designed for A3 colour print only with no page scaling




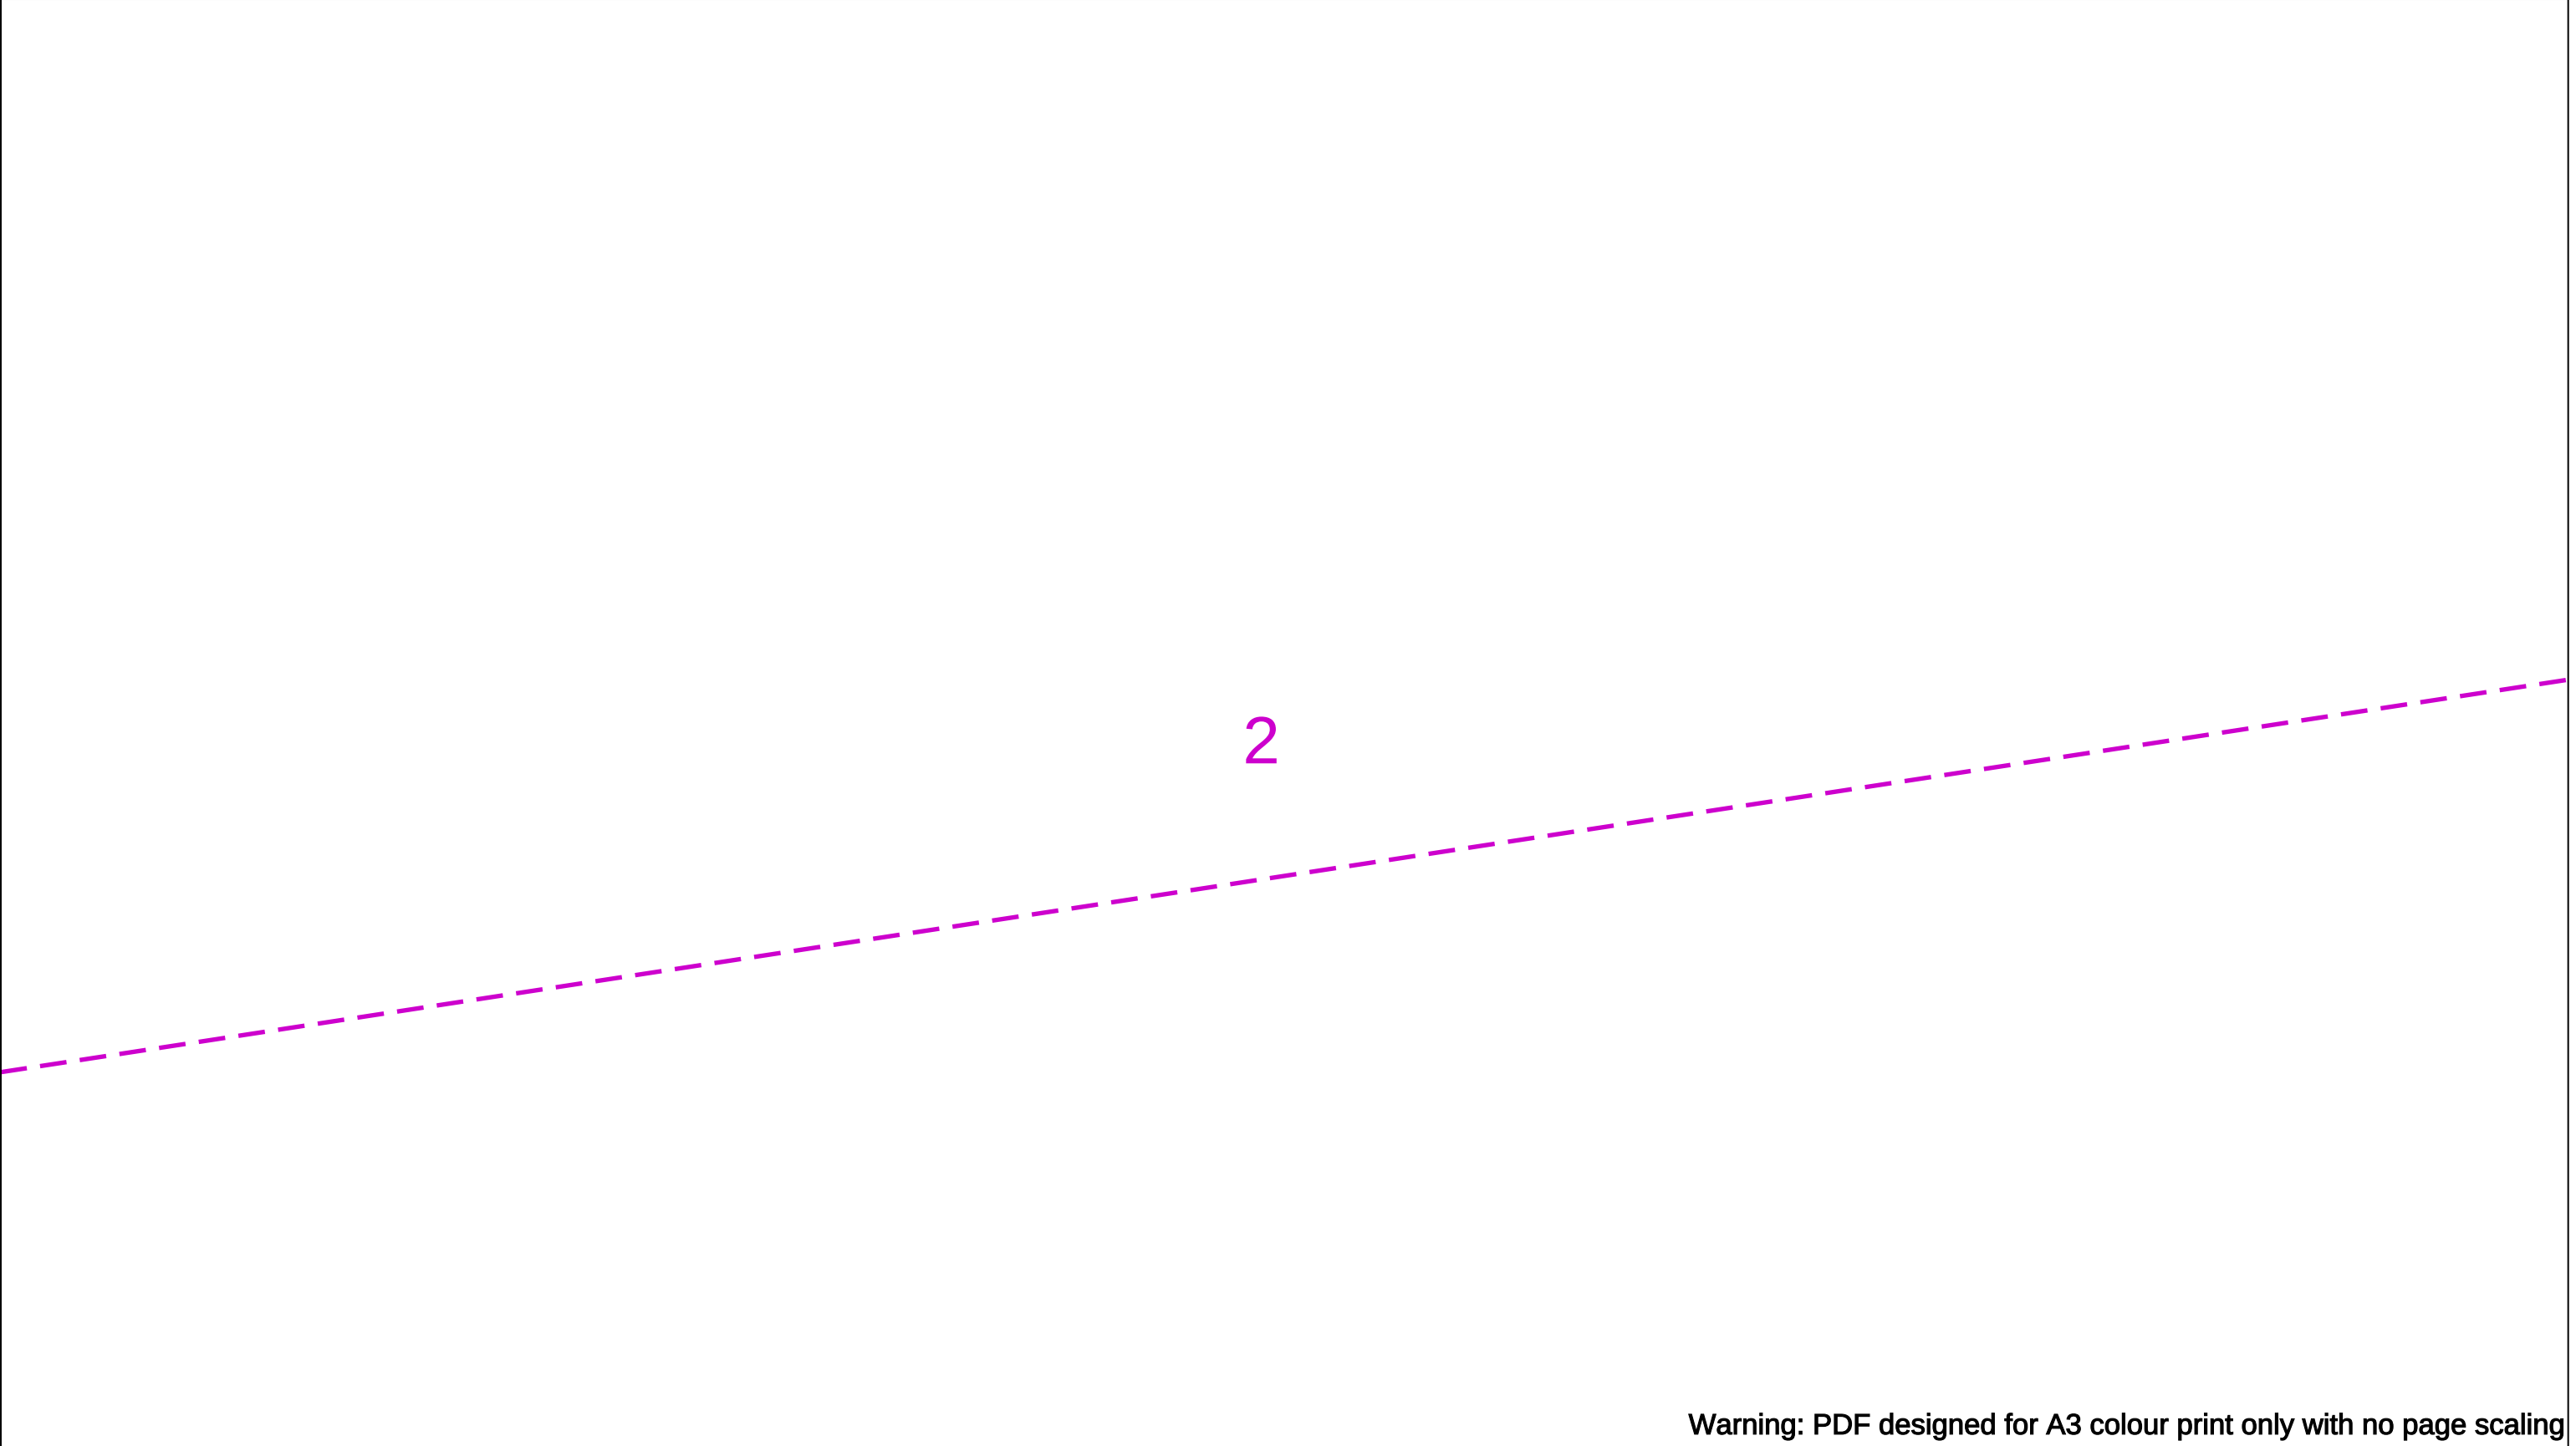

Warning: PDF designed for A3 colour print only with no page scaling

Contact Us Mapping Enquiries: 02920 278 912 General Enquiries: 0800 912 2999 Date Requested: 24/11/2023 Job Reference: 31655152 Site Location: 278263 185096 Requested by: Mr Farhan Aslam Your Scheme/Reference: National Grid Steel Margam FEED Scale: 1:1250 (When plotted at A3)	IMPORTANT NOTICES • This information is given as a guide only and its accuracy cannot be guaranteed • The plan only shows those pipes owned by Wales & West Utilities (WWU) as its role as a licensed Gas Transporter • Service pipes, valves, syphons, stub connections etc. may not be shown but their presence should be anticipated • You must use safe digging practices in accordance with HS(G)47 to establish the actual position of mains, services and other apparatus before any mechanical excavation is used • It is your responsibility to ensure this information is provided to all persons working near our plant • If in doubt call the WWU dig team on 02920 278912	In case of an emergency call 0800 111 999 Dig Sites Area: Line: Low Pressure (LP) 21mbar – 75mbar Medium Pressure (MP) 350mbar – 2bar Intermediate Pressure (IP) 2bar – 7bar High Pressure (HP) >7bar 100m Line/Fire Valve Governor Station Change of Diameter End Cap Depth of cover	
---	---	--	-------------------------------------


Crown Copyright © - Reproduced by permission of Ordnance Survey on behalf of HMSO. And database right 2023. All rights reserved. Ordnance Survey Licence number 0100044308.

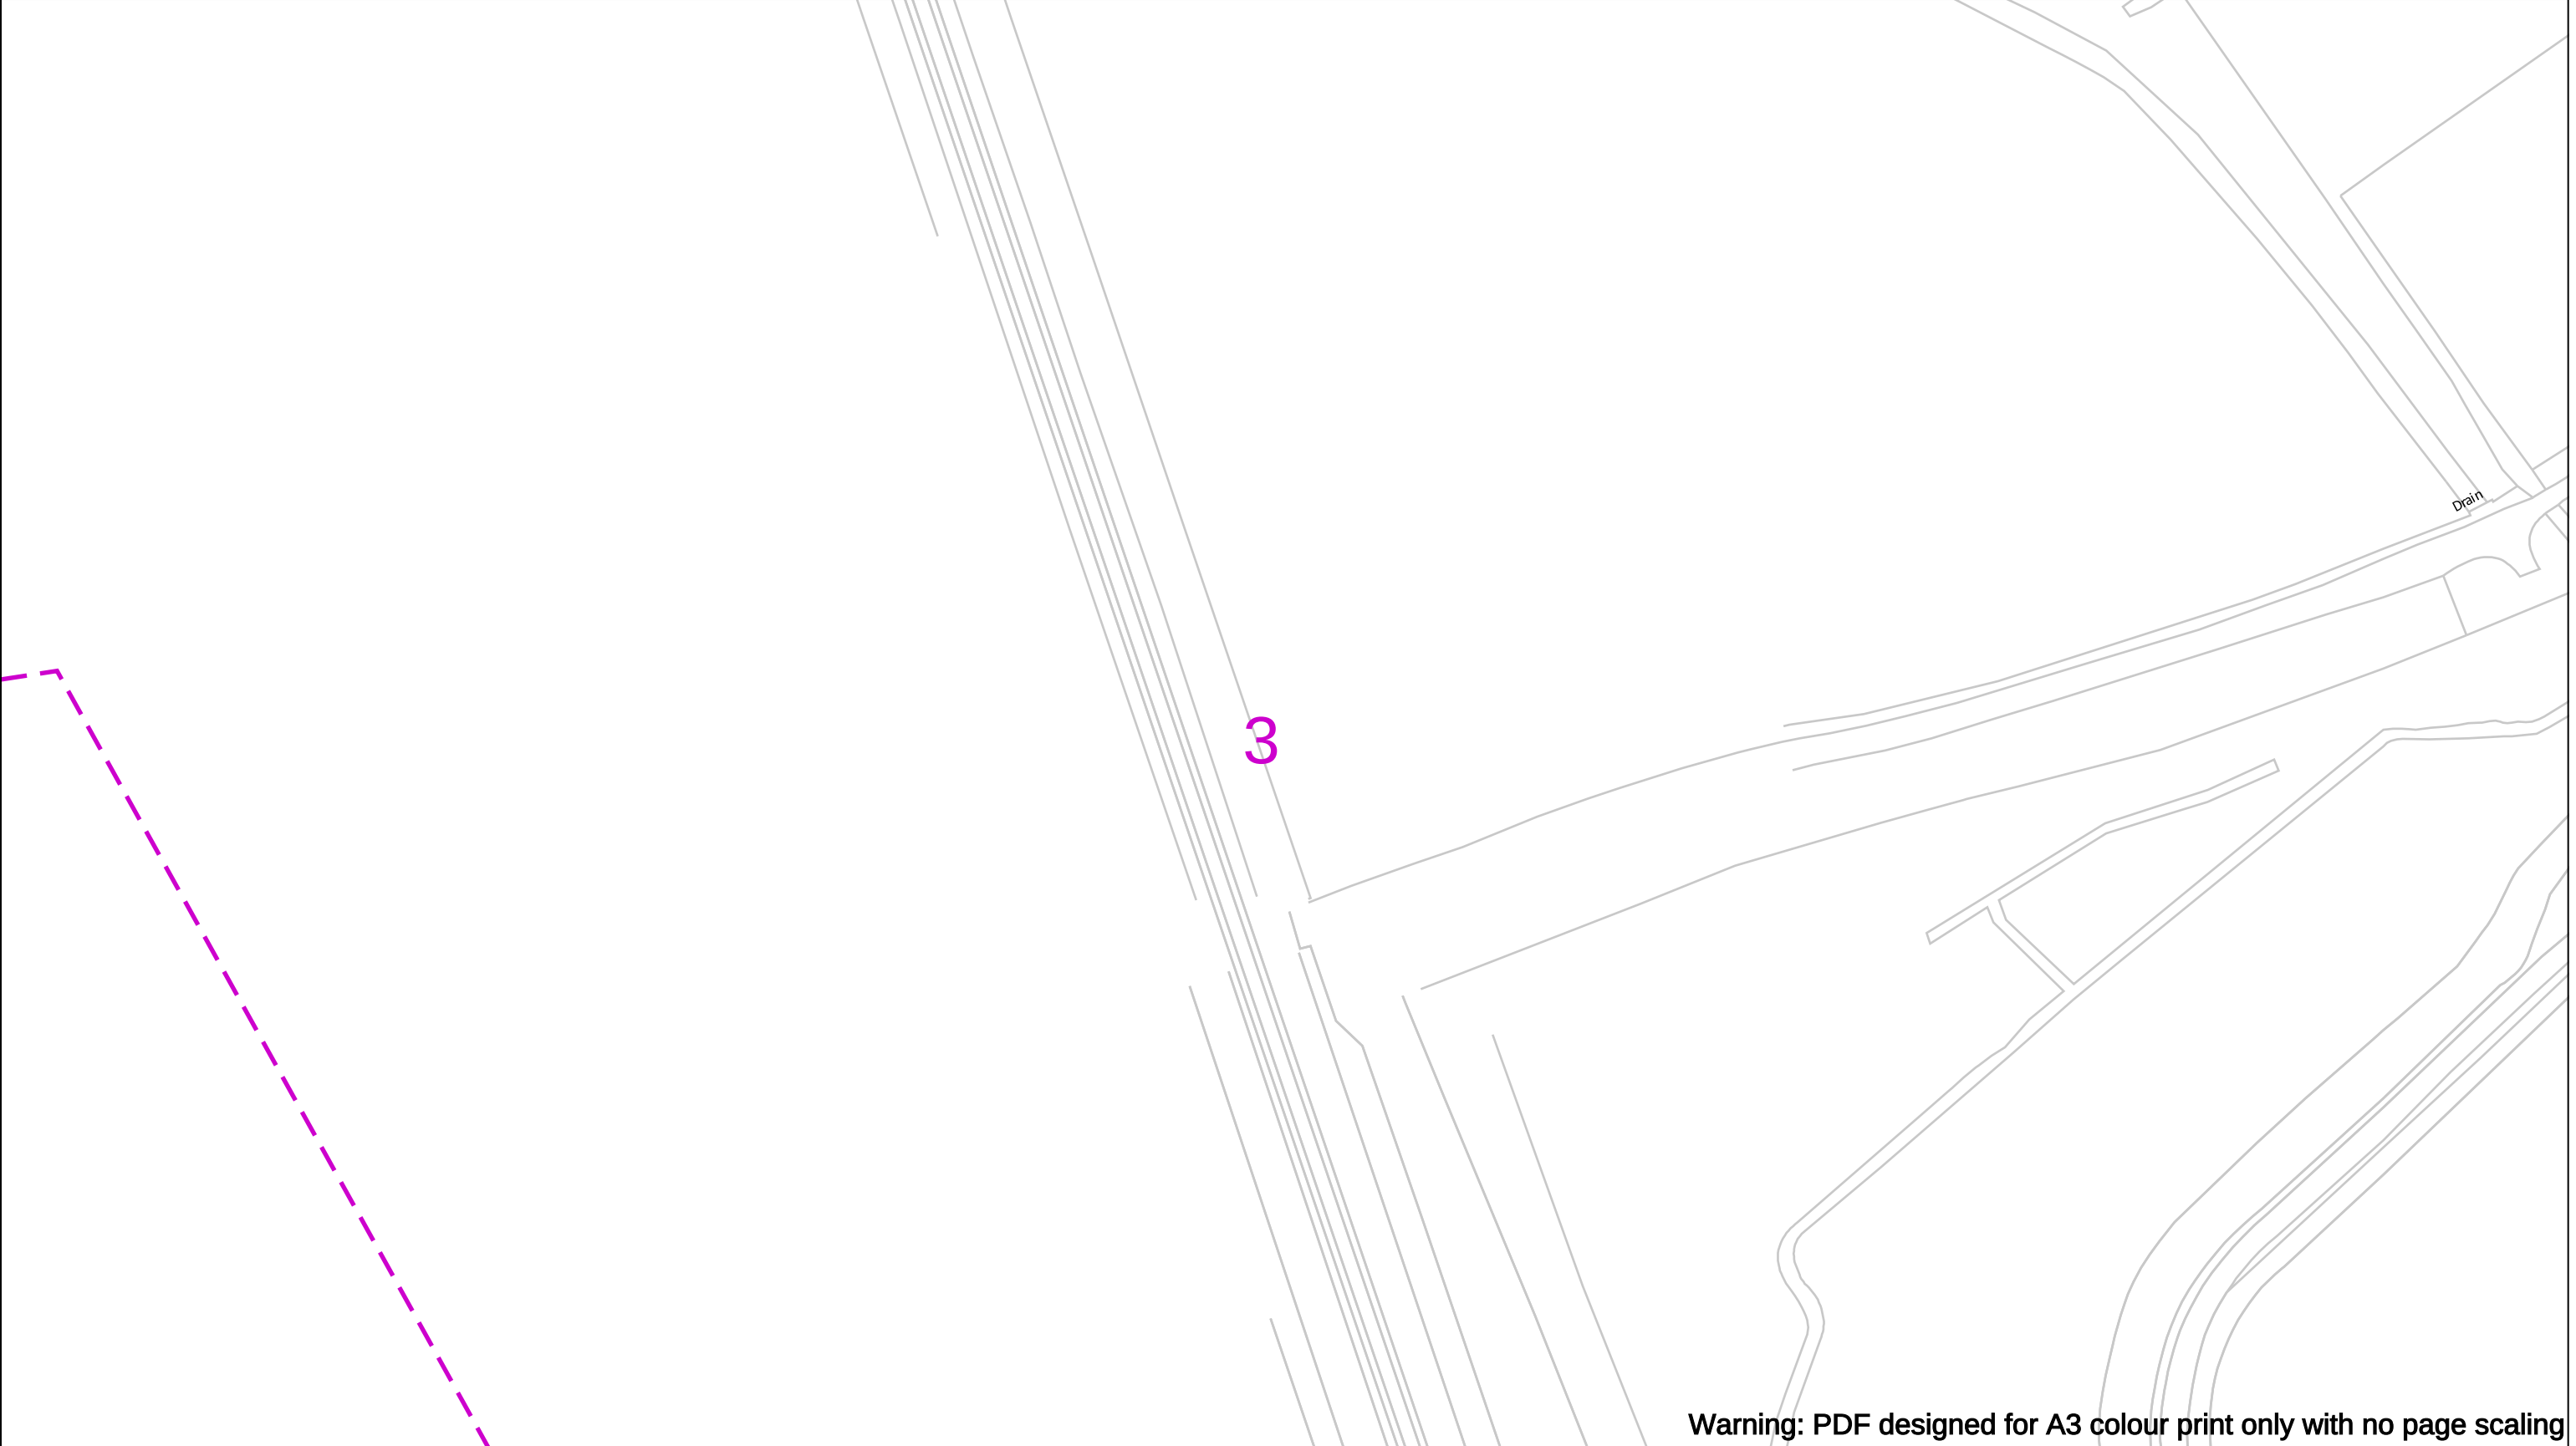

Warning: PDF designed for A3 colour print only with no page scaling

Contact Us Mapping Enquiries: 02920 278 912 General Enquiries: 0800 912 2999 Date Requested: 24/11/2023 Job Reference: 31655152 Site Location: 278263 185096 Requested by: Mr Farhan Aslam Your Scheme/Reference: National Grid Steel Margam FEED Scale: 1:1250 (When plotted at A3)	IMPORTANT NOTICES • This information is given as a guide only and its accuracy cannot be guaranteed • The plan only shows those pipes owned by Wales & West Utilities (WWU) as its role as a licensed Gas Transporter • Service pipes, valves, syphons, stub connections etc. may not be shown but their presence should be anticipated • You must use safe digging practices in accordance with HS(G)47 to establish the actual position of mains, services and other apparatus before any mechanical excavation is used • It is your responsibility to ensure this information is provided to all persons working near our plant • If in doubt call the WWU dig team on 02920 278912	In case of an emergency call 0800 111 999 Dig Sites Area: Line: Low Pressure (LP) 21mbar – 75mbar Medium Pressure (MP) 350mbar – 2bar Intermediate Pressure (IP) 2bar – 7bar High Pressure (HP) >7bar Line/Fire Valve Governor Station Change of Diameter End Cap Depth of cover	
---	---	---	-------------------------

Crown Copyright © - Reproduced by permission of Ordnance Survey on behalf of HMSO. And database right 2023. All rights reserved. Ordnance Survey Licence number 0100044308.

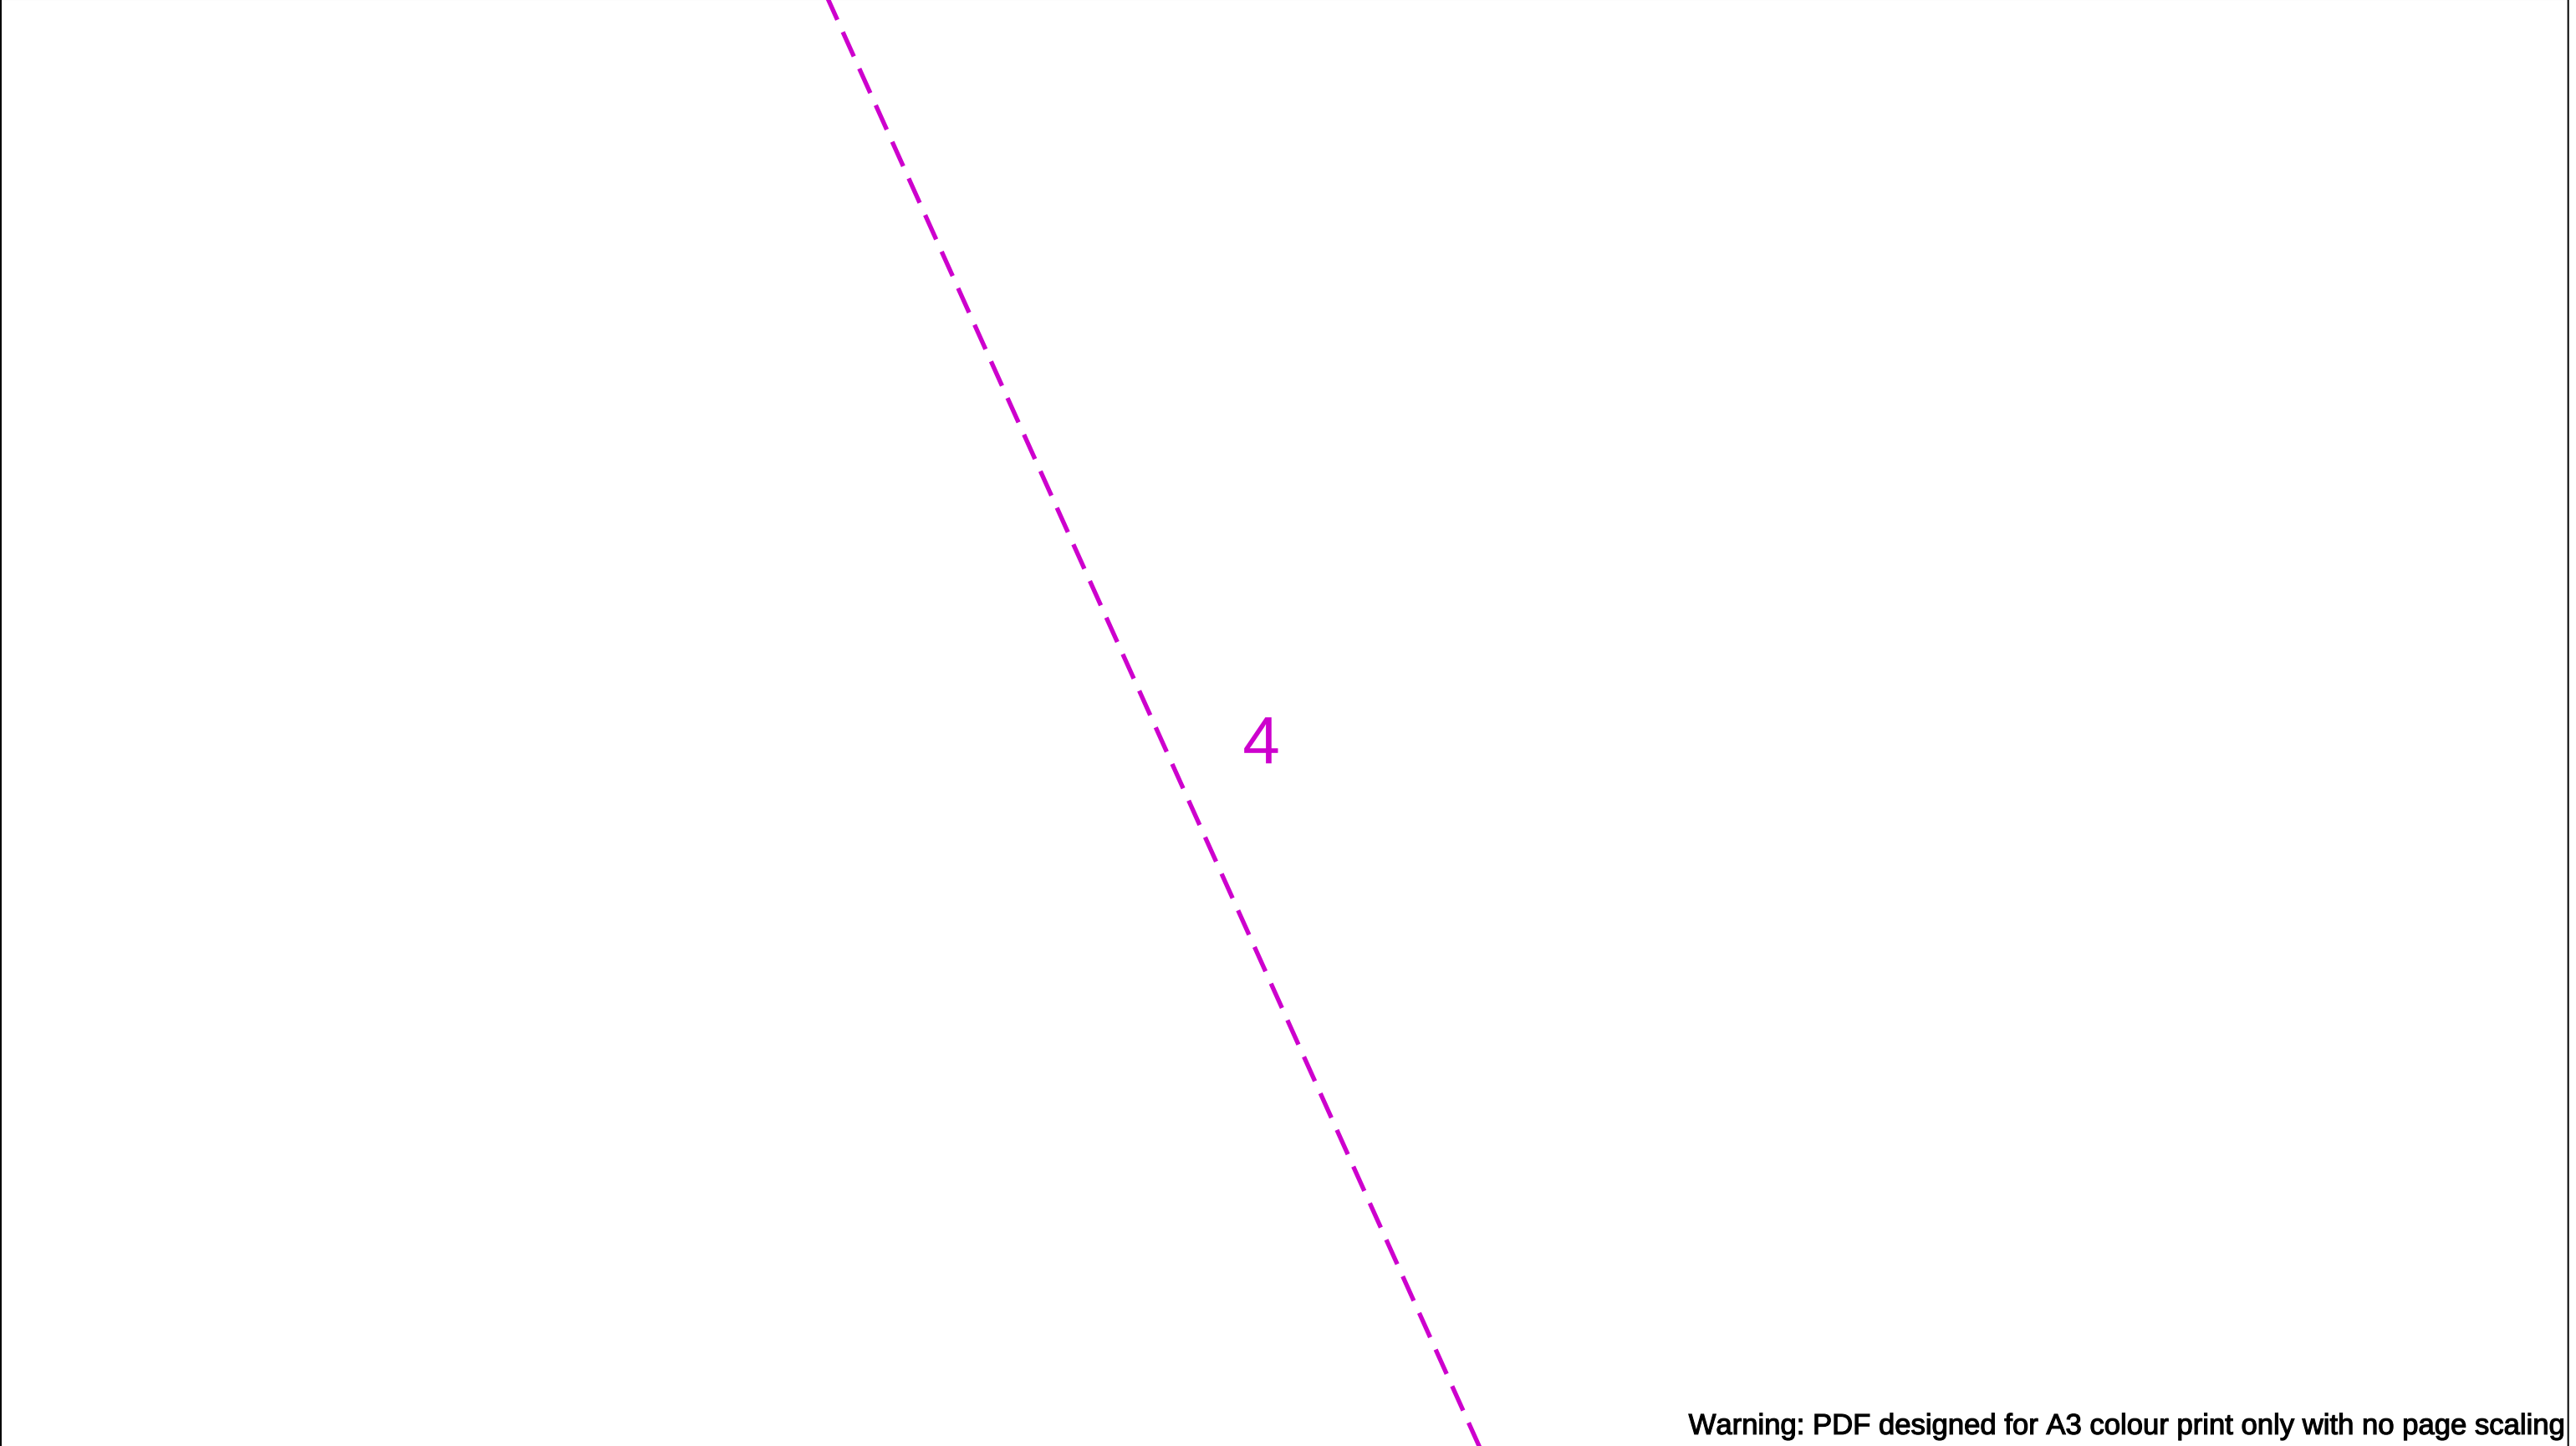

Warning: PDF designed for A3 colour print only with no page scaling


Contact Us Mapping Enquiries: 02920 278 912 General Enquiries: 0800 912 2999 Date Requested: 24/11/2023 Job Reference: 31655152 Site Location: 278263 185096 Requested by: Mr Farhan Aslam Your Scheme/Reference: National Grid Steel Margam FEED Scale: 1:1250 (When plotted at A3)	IMPORTANT NOTICES • This information is given as a guide only and its accuracy cannot be guaranteed • The plan only shows those pipes owned by Wales & West Utilities (WWU) as its role as a licensed Gas Transporter • Service pipes, valves, syphons, stub connections etc. may not be shown but their presence should be anticipated • You must use safe digging practices in accordance with HS(G)47 to establish the actual position of mains, services and other apparatus before any mechanical excavation is used • It is your responsibility to ensure this information is provided to all persons working near our plant • If in doubt call the WWU dig team on 02920 278912	In case of an emergency call 0800 111 999 Dig Sites Area: Line: Low Pressure (LP) 21mbar – 75mbar Medium Pressure (MP) 350mbar – 2bar Intermediate Pressure (IP) 2bar – 7bar High Pressure (HP) >7bar Line/Fire Valve Governor Station Change of Diameter End Cap Depth of cover
Crown Copyright © - Reproduced by permission of Ordnance Survey on behalf of HMSO. And database right 2023. All rights reserved. Ordnance Survey Licence number 0100044308.		

Scale: 1:1250 (When plotted at A3)

- This information is given as a guide only and its accuracy cannot be guaranteed
- The plan only shows those pipes owned by Wales & West Utilities (WWU) as its role as a licensed Gas Transporter
- Service pipes, valves, syphons, stub connections etc. may not be shown but their presence should be anticipated
- You must use safe digging practices in accordance with HS(G)47 to establish the actual position of mains, services and other apparatus before any mechanical excavation is used
- It is your responsibility to ensure this information is provided to all persons working near our plant
- If in doubt call the WWU dig team on 02920 278912

A scale bar consisting of a horizontal line with a central segment highlighted in light blue. The text "100m" is positioned to the right of the bar.

Low Pressure (LP) 21mbar – 75mbar
Medium Pressure (MP) 350mbar – 2bar
Intermediate Pressure (IP) 2bar – 7bar
High Pressure (HP) >7bar

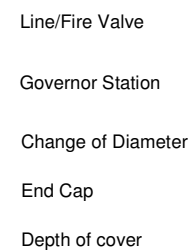

Warning: PDF designed for A3 colour print only with no page scaling

Contact Us
Mapping Enquiries: 02920 278 912
General Enquiries: 0800 912 2999

Date Requested: 24/11/2023
Job Reference: 31655152
Site Location: 278263 185096
Requested by:
Mr Farhan Aslam
Your Scheme/Reference: National
Grid Steel Margam FEED

Scale: 1:1250 (When plotted at A3)

IMPORTANT NOTICES

- This information is given as a guide only and its accuracy cannot be guaranteed
- The plan only shows those pipes owned by Wales & West Utilities (WWU) as its role as a licensed Gas Transporter
- Service pipes, valves, syphons, stub connections etc. may not be shown but their presence should be anticipated
- You must use safe digging practices in accordance with HS(G)47 to establish the actual position of mains, services and other apparatus before any mechanical excavation is used
- It is your responsibility to ensure this information is provided to all persons working near our plant
- If in doubt call the WWU dig team on 02920 278912

In case of an emergency call 0800 111 999

 100m

Dig Sites

Area: 

Line: — — — —

1P) 350mbar – 2bar

Intermediate Pressure (IP) 2bar – 7bar

High Pressure (HP) $>7\text{bar}$

High Pressure (HP) >7bar

 $\propto$

Line/Fire Valve

Governor Station

+

Change of Diameter

[

End Cap

<



Depth of cover

Scale: 1:1250 (When plotted at A3)

- This information is given as a guide only and its accuracy cannot be guaranteed
- The plan only shows those pipes owned by Wales & West Utilities (WUU) as its role as a licensed Gas Transporter
- Service pipes, valves, syphons, stub connections etc. may not be shown but their presence should be anticipated
- You must use safe digging practices in accordance with HS(G)47 to establish the actual position of mains, services and other apparatus before any mechanical excavation is used
- It is your responsibility to ensure this information is provided to all persons working near our plant
- If in doubt call the WUU dig team on 02920 278912

A scale bar consisting of a horizontal line with alternating black and white segments. The total length is labeled as 100m at the right end.

Low Pressure (LP) 21mbar – 75mbar
Medium Pressure (MP) 350mbar – 2bar
Intermediate Pressure (IP) 2bar – 7bar
High Pressure (HP) >7bar

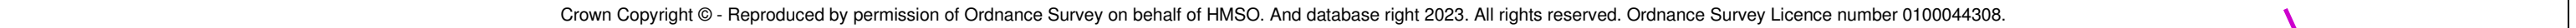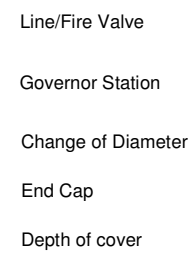

Contact Us
Mapping Enquiries: 02920 278 912
General Enquiries: 0800 912 2999

Date Requested: 24/11/2023
Job Reference: 31655152
Site Location: 278263 185096
Requested by:
Mr Farhan Aslam
Your Scheme/Reference: National
Grid Steel Margam FEED

Scale: 1:1250 (When plotted at A3)

In case of an emergency call 0800 111 999

Dig Sites

Area: Line:

Low Pressure (LP) 21mbar – 75mbar

Medium Pressure (MP) 350mbar – 2bar

Intermediate Pressure (IP) 2bar – 7bar

High Pressure (HP) >7bar

Line/Fire Valve

Governor Station

+

Change of Diameter

[

End Cap


<

Depth of cover

IMPORTANT NOTICES

- This information is given as a guide only and its accuracy cannot be guaranteed
- The plan only shows those pipes owned by Wales & West Utilities (WWU) as its role as a licensed Gas Transporter
- Service pipes, valves, syphons, stub connections etc. may not be shown but their presence should be anticipated
- You must use safe digging practices in accordance with H5(G)47 to establish the actual position of mains, services and other apparatus before any mechanical excavation is used
- It is your responsibility to ensure this information is provided to all persons working near our plant
- If in doubt call the WWU dig team on 02920 278912

Crown Copyright © - Reproduced by permission of Ordnance Survey on behalf of HMSO. And database right 2023. All rights reserved. Ordnance Survey Licence number 0100044308.

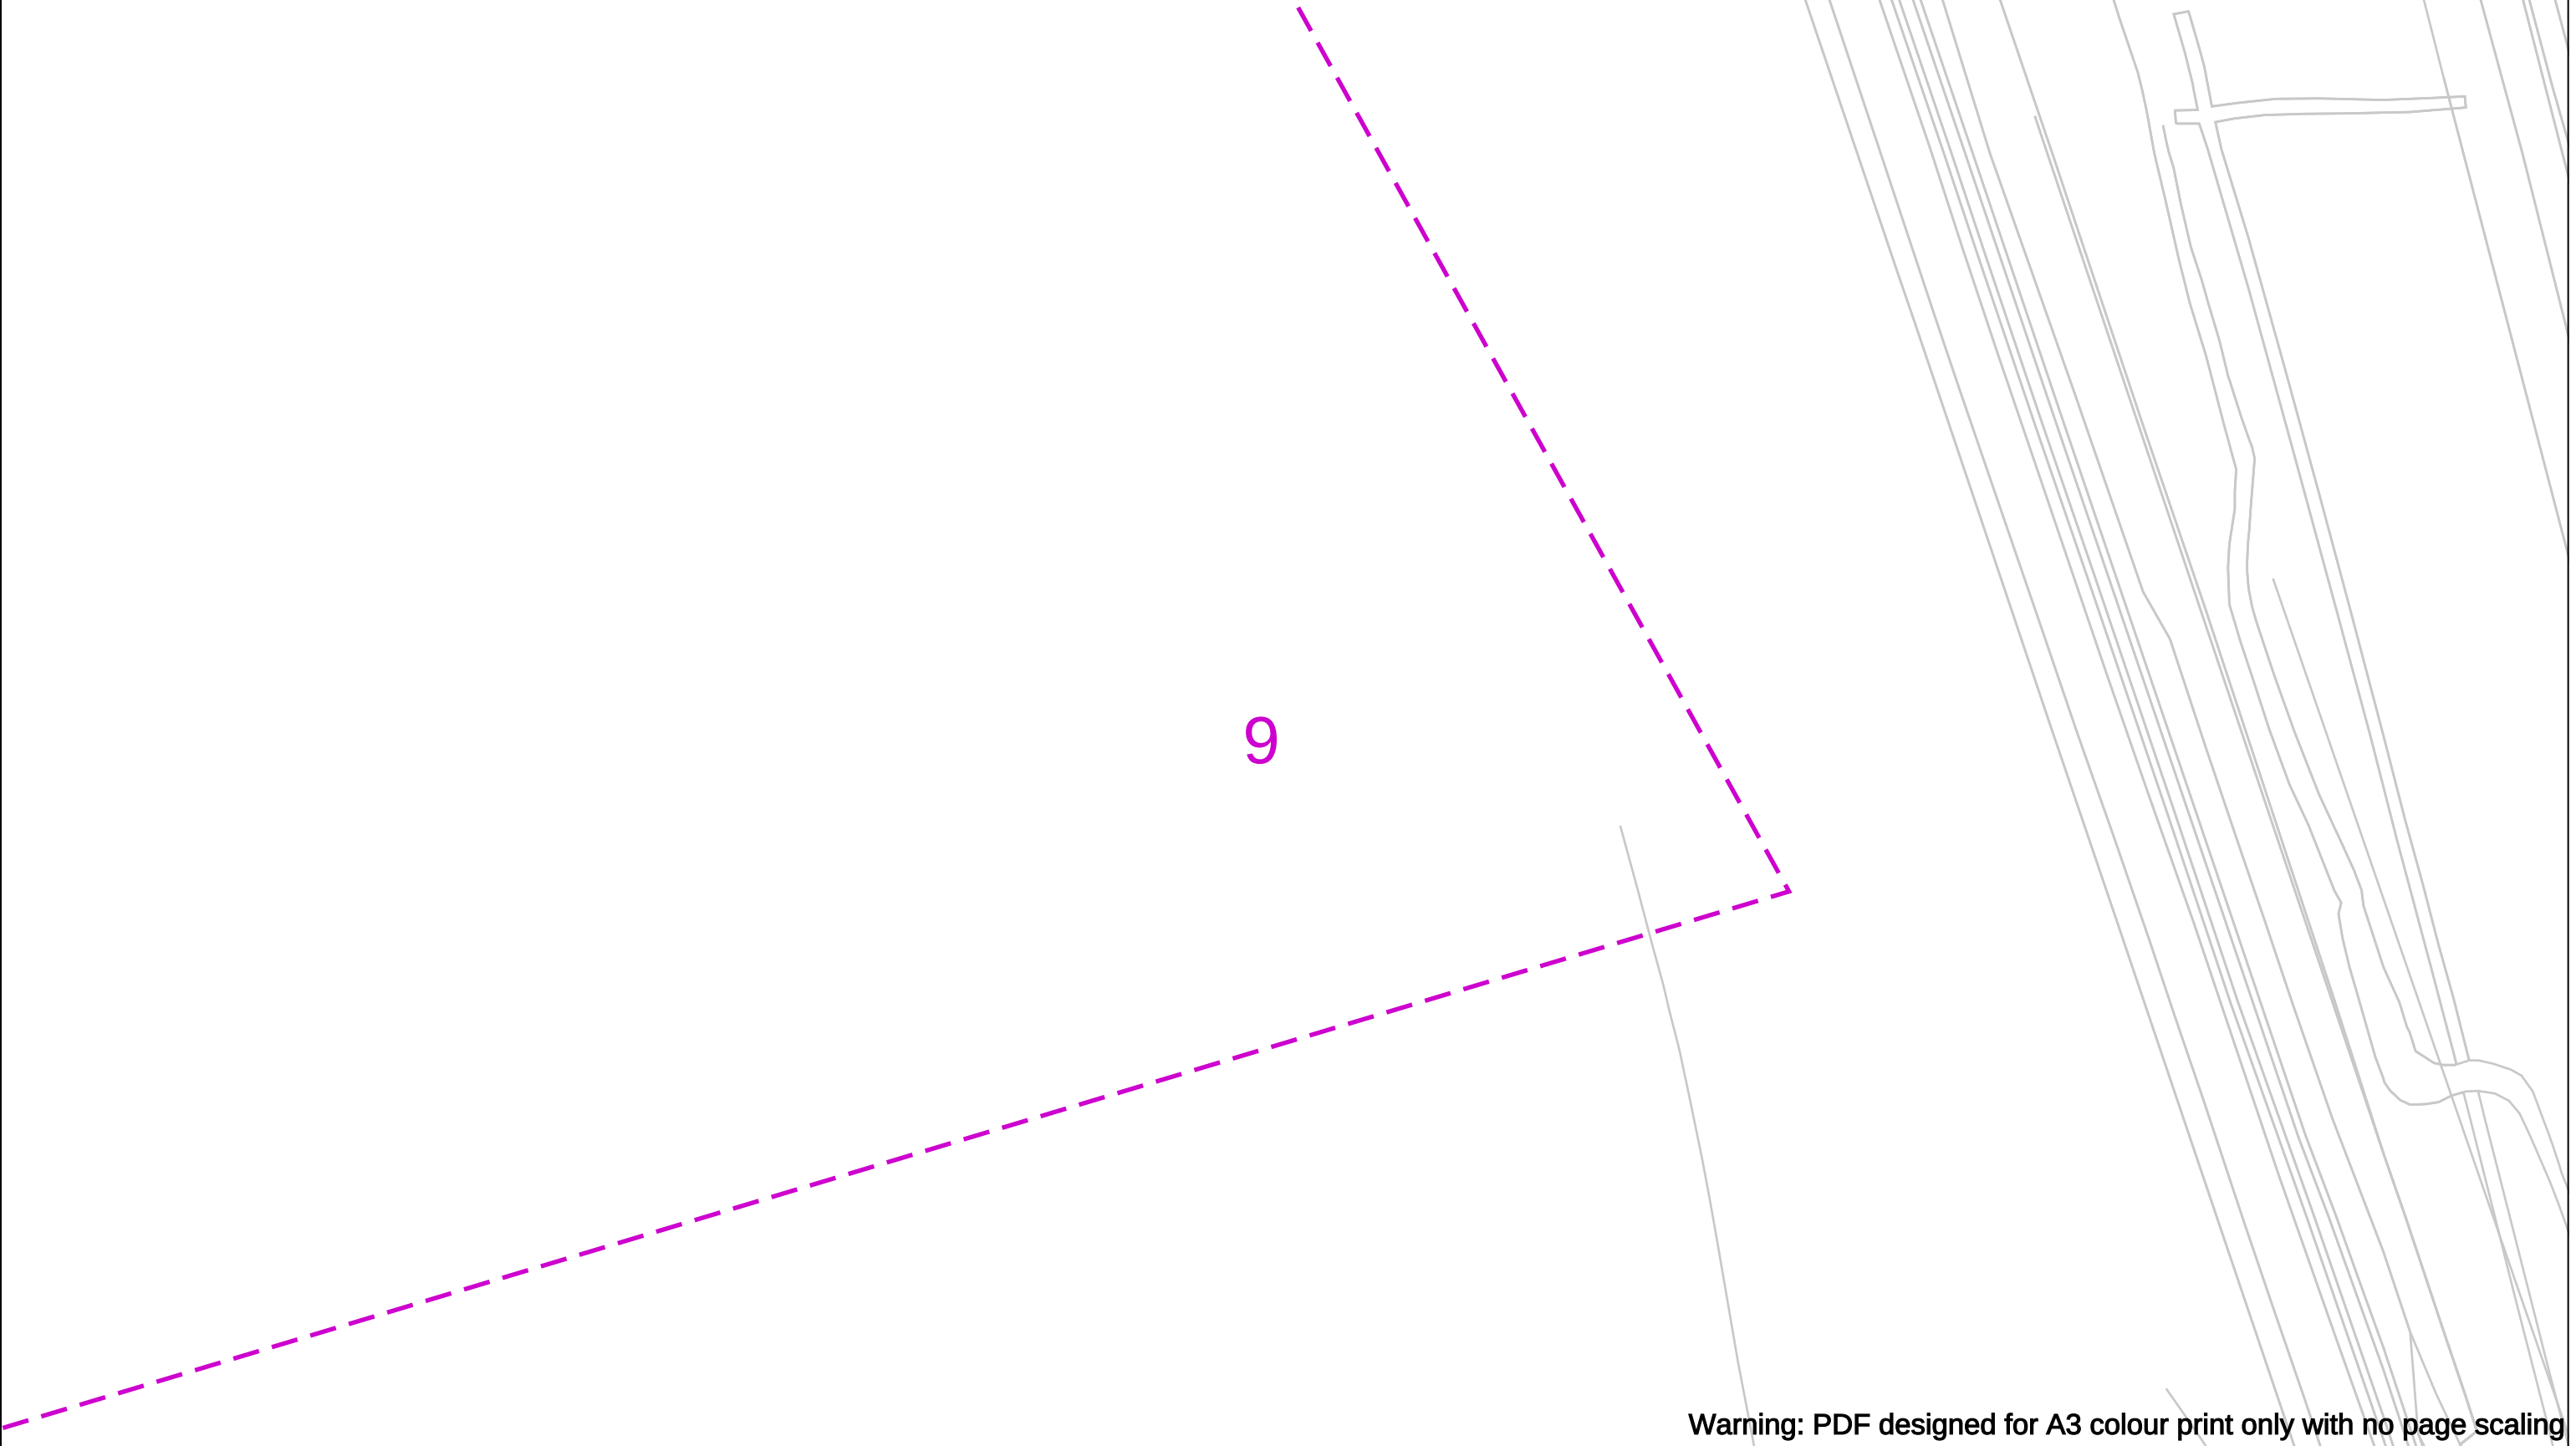

Warning: PDF designed for A3 colour print only with no page scaling


Contact Us Mapping Enquiries: 02920 278 912 General Enquiries: 0800 912 2999 Date Requested: 24/11/2023 Job Reference: 31655152 Site Location: 278263 185096 Requested by: Mr Farhan Aslam Your Scheme/Reference: National Grid Steel Margam FEED Scale: 1:1250 (When plotted at A3)	IMPORTANT NOTICES • This information is given as a guide only and its accuracy cannot be guaranteed • The plan only shows those pipes owned by Wales & West Utilities (WWU) as its role as a licensed Gas Transporter • Service pipes, valves, syphons, stub connections etc. may not be shown but their presence should be anticipated • You must use safe digging practices in accordance with HS(G)47 to establish the actual position of mains, services and other apparatus before any mechanical excavation is used • It is your responsibility to ensure this information is provided to all persons working near our plant • If in doubt call the WWU dig team on 02920 278912	In case of an emergency call 0800 111 999 Dig Sites Area: Line: Low Pressure (LP) 21mbar – 75mbar Medium Pressure (MP) 350mbar – 2bar Intermediate Pressure (IP) 2bar – 7bar High Pressure (HP) >7bar Line/Fire Valve Governor Station Change of Diameter End Cap Depth of cover
Crown Copyright © - Reproduced by permission of Ordnance Survey on behalf of HMSO. And database right 2023. All rights reserved. Ordnance Survey Licence number 0100044308.		



Warning: PDF designed for A3 colour print only with no page scaling

Contact Us Mapping Enquiries: 02920 278 912 General Enquiries: 0800 912 2999 Date Requested: 24/11/2023 Job Reference: 31655152 Site Location: 278263 185096 Requested by: Mr Farhan Aslam Your Scheme/Reference: National Grid Steel Margam FEED Scale: 1:1250 (When plotted at A3)	IMPORTANT NOTICES • This information is given as a guide only and its accuracy cannot be guaranteed • The plan only shows those pipes owned by Wales & West Utilities (WWU) as its role as a licensed Gas Transporter • Service pipes, valves, syphons, stub connections etc. may not be shown but their presence should be anticipated • You must use safe digging practices in accordance with HS(G)47 to establish the actual position of mains, services and other apparatus before any mechanical excavation is used • It is your responsibility to ensure this information is provided to all persons working near our plant • If in doubt call the WWU dig team on 02920 278912	In case of an emergency call 0800 111 999 Dig Sites Area: Line: Low Pressure (LP) 21mbar – 75mbar Medium Pressure (MP) 350mbar – 2bar Intermediate Pressure (IP) 2bar – 7bar High Pressure (HP) >7bar Line/Fire Valve Governor Station Change of Diameter End Cap Depth of cover	
---	---	--	-------------------------------------


Crown Copyright © - Reproduced by permission of Ordnance Survey on behalf of HMSO. And database right 2023. All rights reserved. Ordnance Survey Licence number 0100044308.

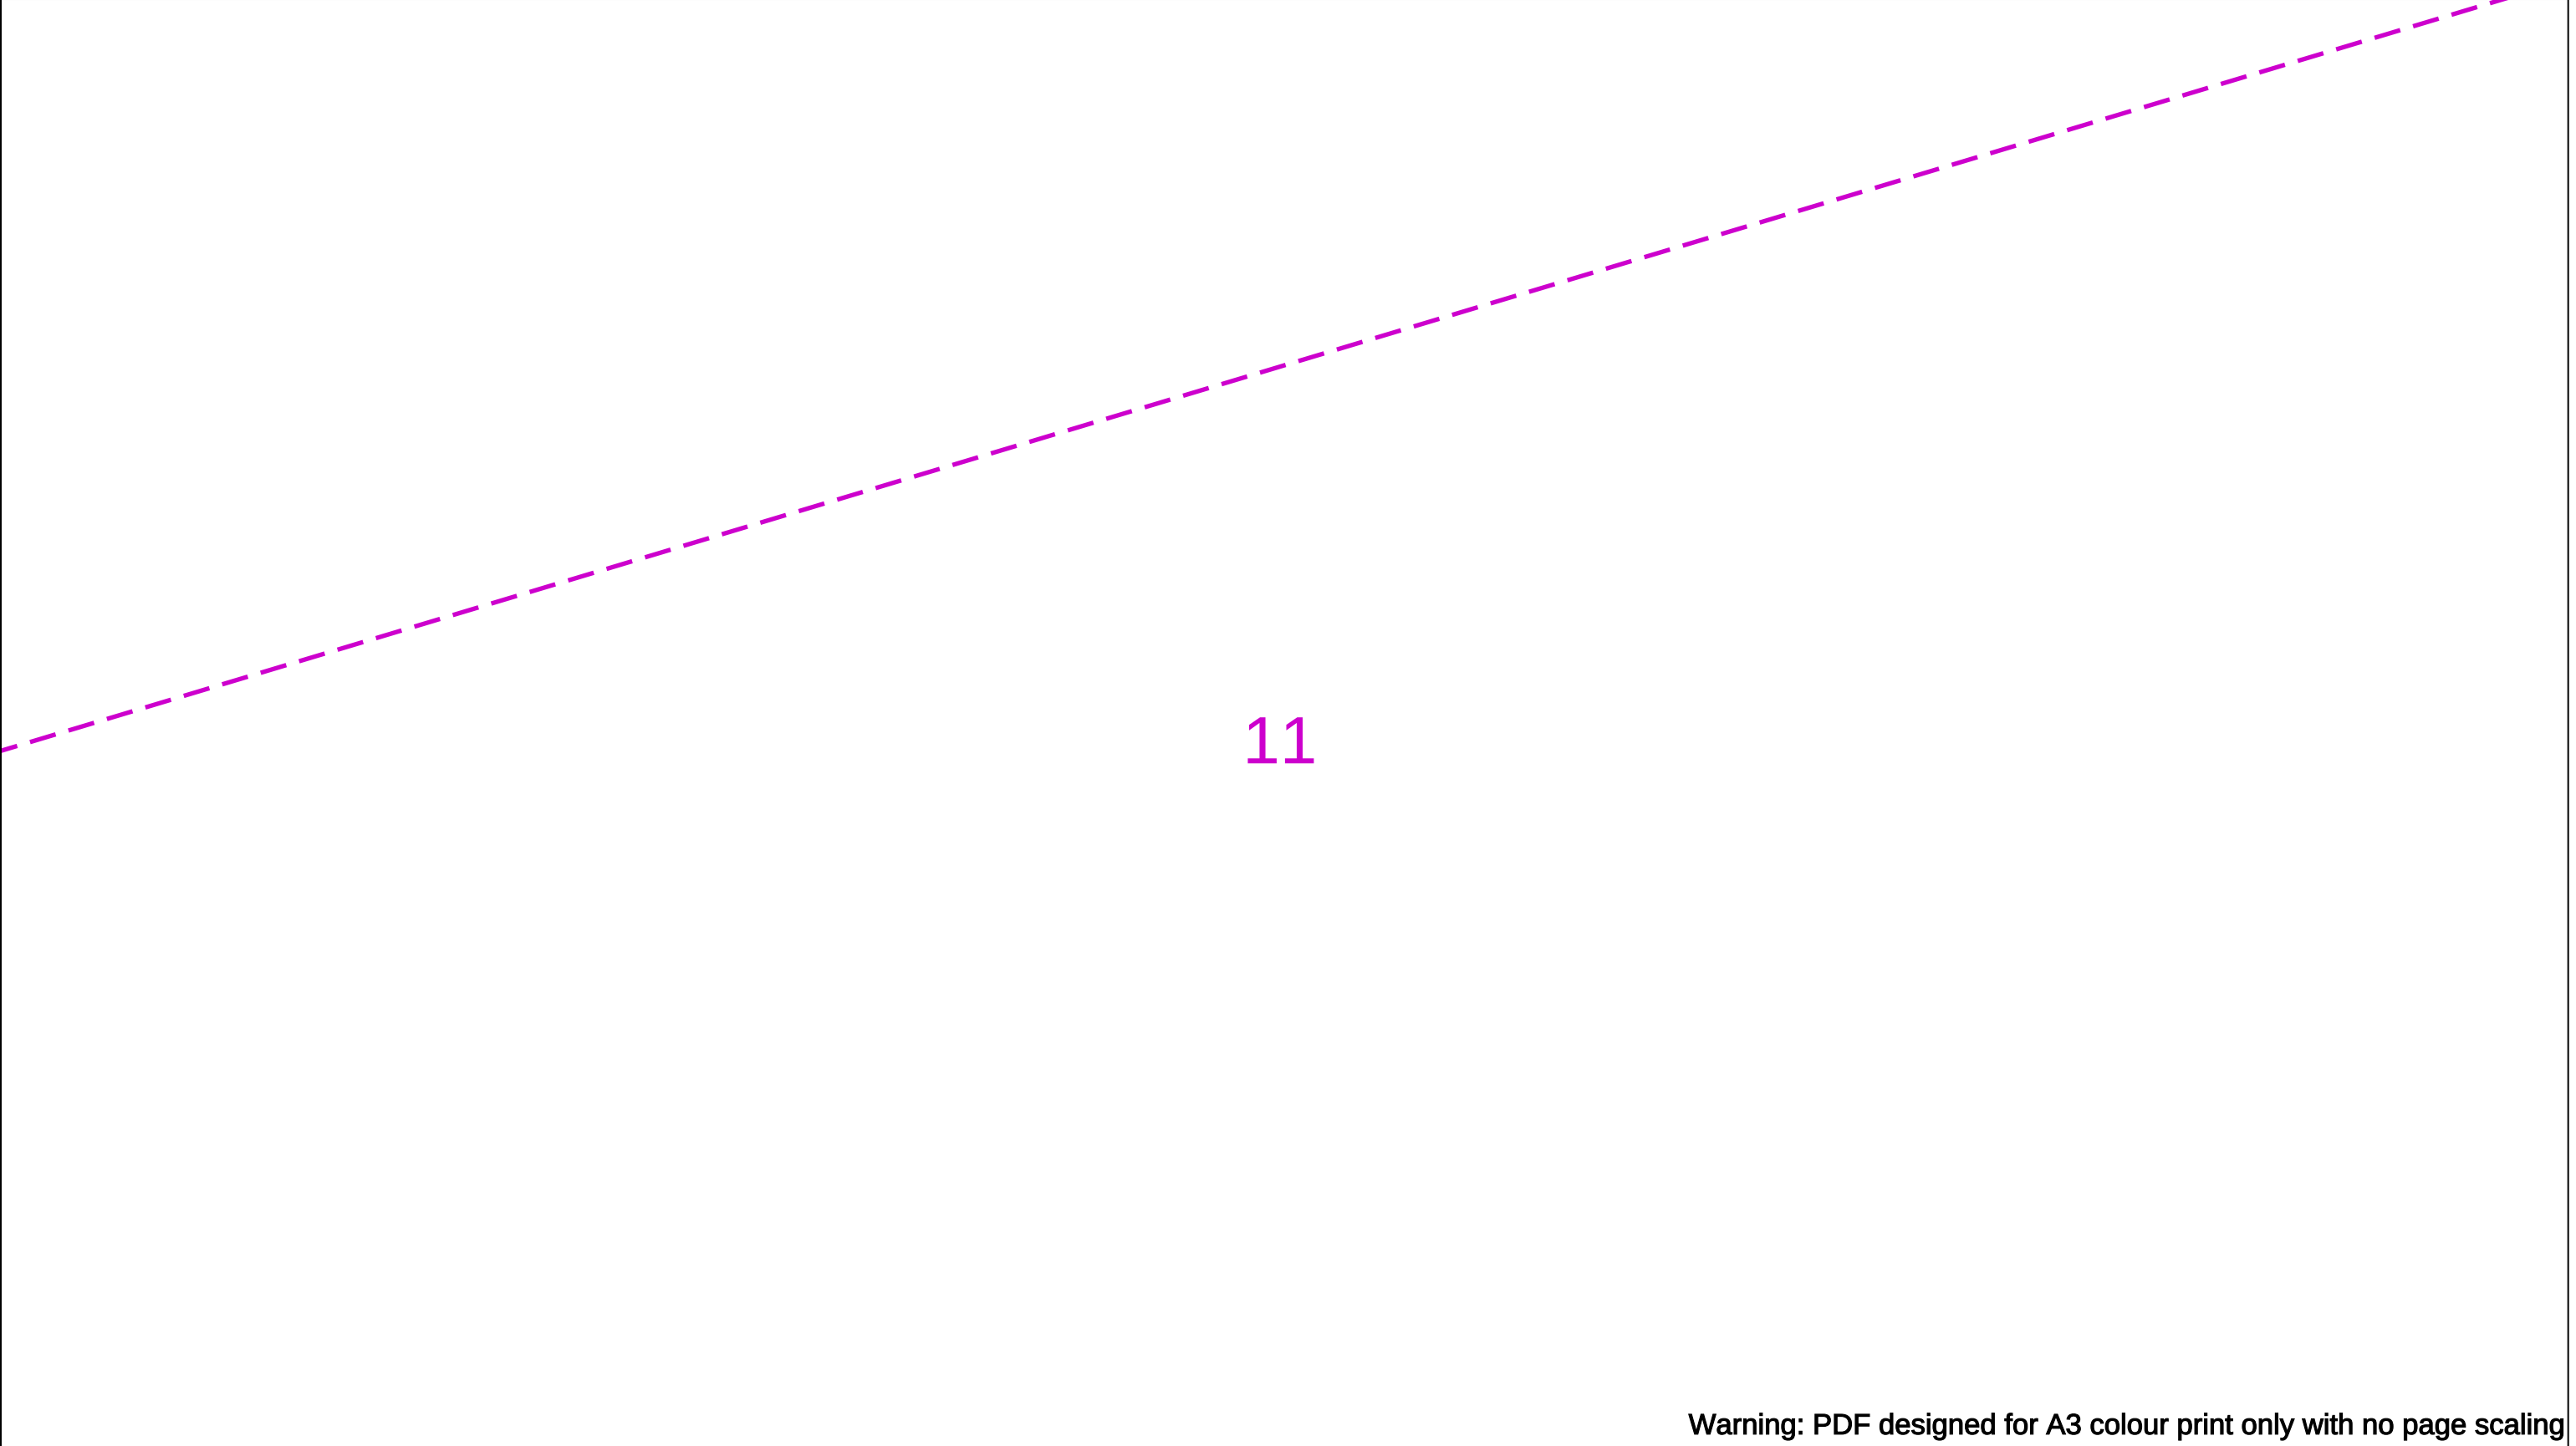

Warning: PDF designed for A3 colour print only with no page scaling

Contact Us Mapping Enquiries: 02920 278 912 General Enquiries: 0800 912 2999 Date Requested: 24/11/2023 Job Reference: 31655152 Site Location: 278263 185096 Requested by: Mr Farhan Aslam Your Scheme/Reference: National Grid Steel Margam FEED Scale: 1:1250 (When plotted at A3)	IMPORTANT NOTICES • This information is given as a guide only and its accuracy cannot be guaranteed • The plan only shows those pipes owned by Wales & West Utilities (WWU) as its role as a licensed Gas Transporter • Service pipes, valves, syphons, stub connections etc. may not be shown but their presence should be anticipated • You must use safe digging practices in accordance with HS(G)47 to establish the actual position of mains, services and other apparatus before any mechanical excavation is used • It is your responsibility to ensure this information is provided to all persons working near our plant • If in doubt call the WWU dig team on 02920 278912	In case of an emergency call 0800 111 999 Dig Sites Area: Line: Low Pressure (LP) 21mbar – 75mbar Medium Pressure (MP) 350mbar – 2bar Intermediate Pressure (IP) 2bar – 7bar High Pressure (HP) >7bar Line/Fire Valve Governor Station Change of Diameter End Cap Depth of cover	
---	---	--	-------------------------------------

Crown Copyright © - Reproduced by permission of Ordnance Survey on behalf of HMSO. And database right 2023. All rights reserved. Ordnance Survey Licence number 0100044308.

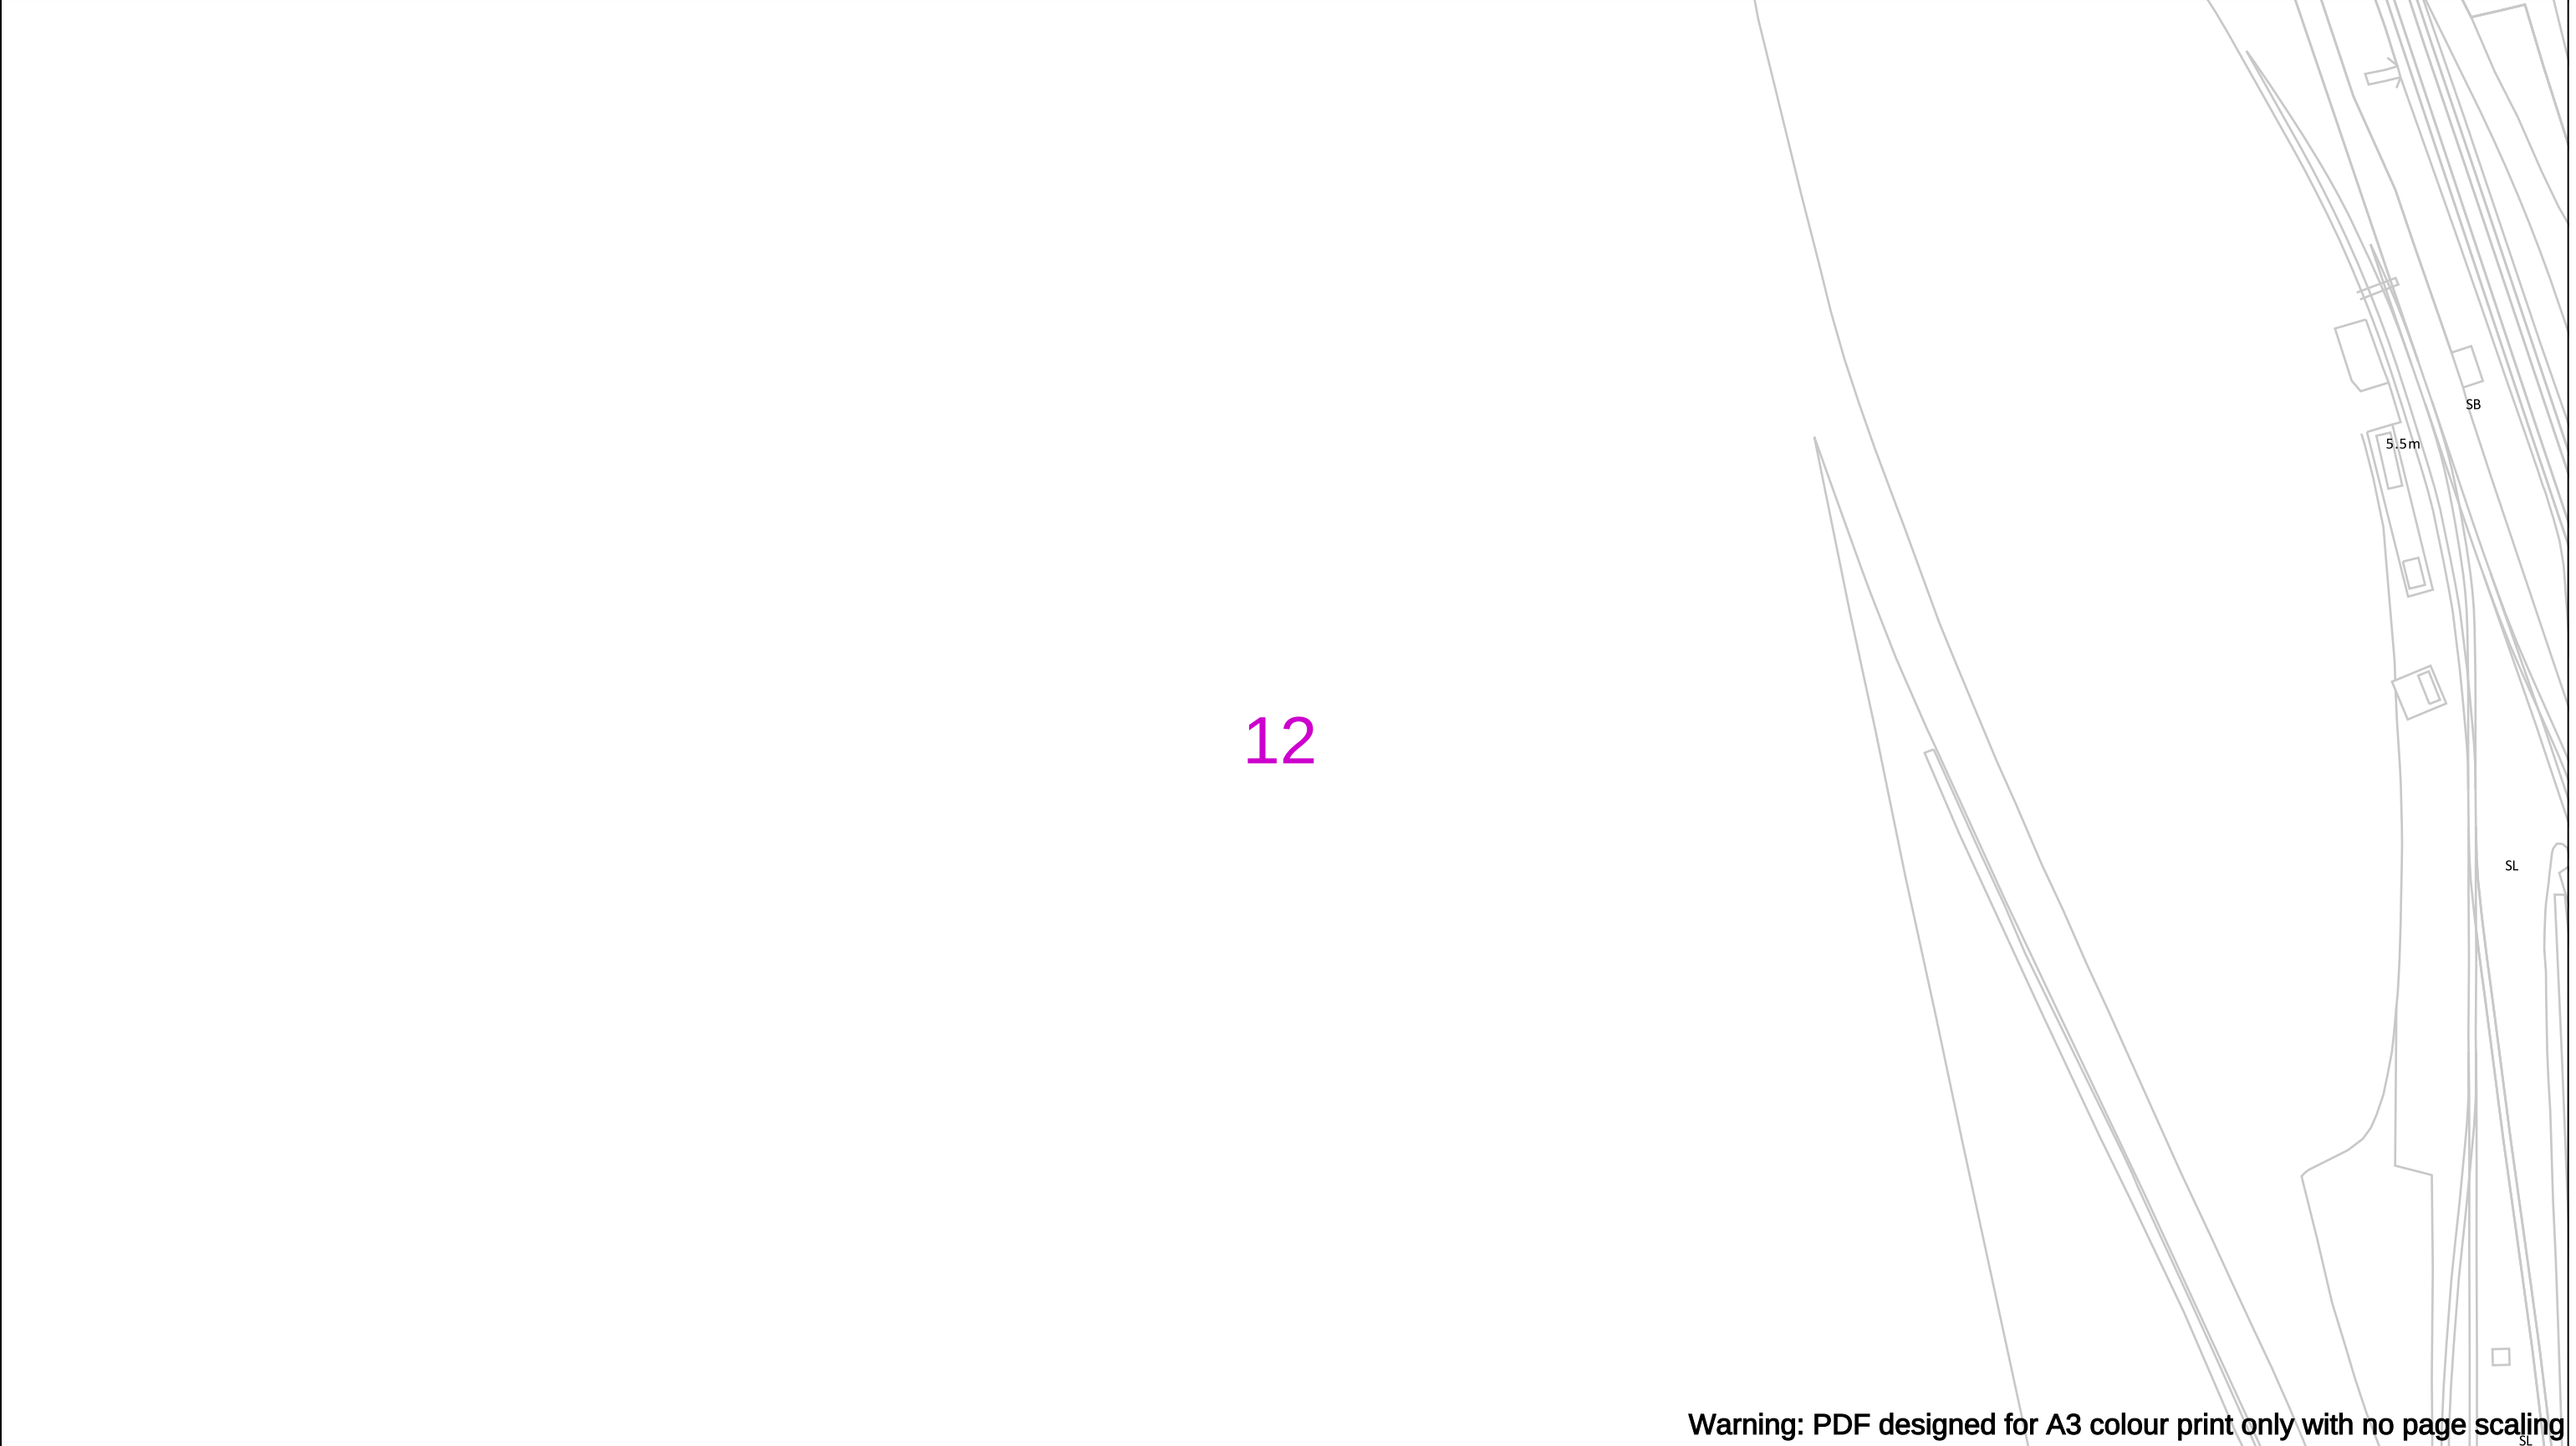

Warning: PDF designed for A3 colour print only with no page scaling

Contact Us Mapping Enquiries: 02920 278 912 General Enquiries: 0800 912 2999 Date Requested: 24/11/2023 Job Reference: 31655152 Site Location: 278263 185096 Requested by: Mr Farhan Aslam Your Scheme/Reference: National Grid Steel Margam FEED Scale: 1:1250 (When plotted at A3)	IMPORTANT NOTICES • This information is given as a guide only and its accuracy cannot be guaranteed • The plan only shows those pipes owned by Wales & West Utilities (WWU) as its role as a licensed Gas Transporter • Service pipes, valves, syphons, stub connections etc. may not be shown but their presence should be anticipated • You must use safe digging practices in accordance with HS(G)47 to establish the actual position of mains, services and other apparatus before any mechanical excavation is used • It is your responsibility to ensure this information is provided to all persons working near our plant • If in doubt call the WWU dig team on 02920 278912	In case of an emergency call 0800 111 999 Dig Sites Area: Line: Low Pressure (LP) 21mbar – 75mbar Medium Pressure (MP) 350mbar – 2bar Intermediate Pressure (IP) 2bar – 7bar High Pressure (HP) >7bar Line/Fire Valve Governor Station Change of Diameter End Cap Depth of cover	
---	---	--	-------------------------------------

Crown Copyright © - Reproduced by permission of Ordnance Survey on behalf of HMSO. And database right 2023. All rights reserved. Ordnance Survey Licence number 0100044308.

Our Ref: 31654782 NG TATA Steel Margam FEED

Friday, 24 November 2023

Farhan Aslam
Flat1, 162-164, Yardley Road, Acocks green.

West Midlands
B27 6LR

National Grid House
Warwick Technology Park
Gallows Hill, Warwick
CV34 6DA

Electricity Emergency Number:
0800 40 40 90*
*Available 24 hours, 7 days/week.
Calls may be recorded and monitored.
www.nationalgrid.com

Asset Protection
Electricity Transmission
National Grid
Warwick
Email: assetprotection@nationalgrid.com

National Grid Electricity – Small Scale Works - Initial Enquiry

Dear Sir/ Madam,

An assessment has been carried out with respect to National Grid Electricity Transmission plc's apparatus and the proposed work location. Based on the location entered into the system for assessment the area has been found to be within the High Risk zone from National Grid Electricity Transmission plc's apparatus and **Must Not Proceed** without further assessment by Asset Protection.

As you have entered an **Initial enquiry** please could you ensure that you submit a **Planned works enquiry** in Line Search (LSBUD) with a works description (including how deep you are excavating) at least **4 weeks** ahead of your scheduled start date. Once you receive the LSBUD Planned works response please submit plans to following email address assetprotection@nationalgrid.com including the LSBUD reference number.

If you require any additional information at this stage such as Overhead Line profile drawings please contact assetprotection@nationalgrid.com including the LSBUD reference number.

Failure to submit a Planned enquiry and requested information will result in a delay to your works being assessed.

Please do not commence with any works until you have been contacted by National Grid.

Please note this response and any attached map(s) are valid for 28 days from the date of this letter.

Yours sincerely,

Asset Protection



Your Responsibilities and Obligations

The "Assessment" Section below outlines the detailed requirements that must be followed when planning or undertaking your activities at this location.

It is your responsibility to ensure that the information you have submitted is accurate and that all relevant documents including links are provided to all persons (either direct labour or contractors) working for you near National Grid Electricity Transmission plc's apparatus, e.g. as contained within the Construction (Design and Management) Regulations.

This assessment solely relates to National Grid Electricity Transmission plc (NGET)

This assessment does **NOT** include:

- National Grid's legal interest (easements or wayleaves) in the land which restricts activity in proximity to National Grid's assets in private land. You must obtain details of any such restrictions from the landowner in the first instance and if in doubt contact Asset Protection.
- Recently installed apparatus
- National Grid Gas plc.
- Apparatus owned by other organisations, e.g. Cadent, other gas distribution operators, local electricity companies, other utilities, etc.

It is **YOUR** responsibility to take into account whether the items listed above may be present and if they could be affected by your proposed activities.

This communication does not constitute any formal agreement or consent for any proposed development work; either generally or with regard to National Grid Electricity Transmission plc easements or wayleaves nor any planning or building regulations applications.

National Grid Electricity Transmission plc or their agents, servants or contractors do not accept any liability for any losses arising under or in connection with this information. This limit on liability applies to all and any claims in contract, tort (including negligence), misrepresentation (excluding fraudulent misrepresentation), breach of statutory duty or otherwise. This limit on liability does not exclude or restrict liability where prohibited by the law nor does it supersede the express terms of any related agreements.

If you require further assistance please contact the Asset Protection team via e-mail (assetprotection@nationalgrid.com) or via the contact details at the top of this response.



Assessment

Affected Apparatus

The apparatus that has been identified as being in the vicinity of your proposed works is:

- Electricity Transmission Overhead Line apparatus.
- Electricity Transmission Underground Cables and associated apparatus.
- Substation above ground electricity sites.

Requirements

Over Head Lines

BEFORE carrying out any work you must:

(N.B. Works only to be undertaken when contact has been made and response received from Asset Protection)

- Carefully read these requirements including the attached guidance documents and maps showing the location of apparatus.
- Contact the landowner and ensure any proposed works in private land do not infringe National Grid Electricity Transmission plc's legal rights (i.e. easements or wayleaves). If the works are in the road or footpath the relevant local authority should be contacted.
- Ensure that all persons, including direct labour and contractors, working for you on or near National Grid Electricity Transmission plc's apparatus follow the requirements of the HSE Guidance Notes HSG47 - 'Avoiding Danger from Underground Services' and GS6 – 'Avoidance of danger from overhead electric power lines'. This guidance can be downloaded free of charge at www.hse.gov.uk
- In line with the above guidance, verify and establish the actual position of mains, pipes, cables, services and other apparatus on site before any activities are undertaken.

DURING any work you must:

- Comply with all guidance for working within the vicinity of overhead lines as detailed within the guidance documents listed below.
- Comply with all guidance relating to general activities and any specific guidance for each asset type as specified in the Guidance Section below.
- Ensure that access to National Grid Electricity Transmission plc's apparatus is maintained at all times.
- Prevent the placing of heavy construction plant, equipment, materials or the passage of heavy vehicles over National Grid Electricity Transmission plc's apparatus unless specifically agreed with National Grid Electricity Transmission plc's apparatus in advance.
- Exercise extreme caution if slab (mass) concrete is encountered during excavation works as this maybe protecting or supporting National Grid Electricity Transmission plc's apparatus.

Underground Cables

BEFORE carrying out any work you must:

(N.B. Works only to be undertaken when contact has been made and response received from Asset Protection)

- Refer to the attached cable profile drawings which provide details about the location of National Grid's high voltage underground cables.
- Carefully read these requirements including the attached guidance documents and maps showing the location of apparatus.
- Contact the landowner and ensure any proposed works in private land do not infringe National Grid Electricity Transmission plc's legal rights (i.e. easements or wayleaves). If the works are in the road or footpath the relevant local authority should be contacted.
- Ensure that all persons, including direct labour and contractors, working for you on or near infringe National Grid Electricity Transmission plc's follow the requirements of the HSE Guidance Notes HS(G)47 "Avoiding Danger From Underground Services". This guidance can be downloaded free of charge at www.hse.gov.uk
- In line with the above guidance, verify and establish the actual position of mains, pipes, cables,

National Grid is a trading name for:

National Grid Electricity Transmission plc

Registered Office: 1-3 Strand, London WC2N 5EH

Registered in England and Wales, No 2366977



services and other apparatus on site before any activities are undertaken.

DURING any work you must:

- Comply with all guidance for working within the vicinity of Electricity Underground Cables as detailed within the guidance documents listed below.
- Comply with all guidance relating to general activities and any specific guidance for each asset type as specified in the Guidance Section below.
- Ensure that access to National Grid Electricity Transmission plc's apparatus is maintained at all times.
- Prevent the placing of heavy construction plant, equipment, materials or the passage of heavy vehicles over National Grid Electricity Transmission plc's apparatus unless specifically agreed with National Grid Electricity Transmission plc's in advance.
- Exercise extreme caution if slab (mass) concrete is encountered during excavation works as this maybe protecting or supporting National Grid Electricity Transmission plc's apparatus.

GUIDANCE

National Grid is a trading name for:
National Grid Electricity Transmission plc
Registered Office: 1-3 Strand, London WC2N 5EH
Registered in England and Wales, No 2366977

National Grid Electricity Transmission Network data

- The Network map for National Grid Electricity Transmission assets can be downloaded at the following link in GIS format.

<https://www.nationalgrid.com/uk/electricity-transmission/network-and-infrastructure/network-route-maps>

Buried Cables

- National Grid's underground cables are protected by a Deed of grant; Easement; Wayleave Agreement or the provisions of the New Roads and Street Works Act. Which provide full right of access to retain, maintain, repair and inspect our asset. Hence we require that no permanent structures are to be built over our cables or within the easement strip.
- Ground levels above our cables must not be altered in any way. Any alterations to the depth of our cables will subsequently alter the rating of the circuit and can compromise the reliability, efficiency and safety of our electricity network.
- The supplied detailed route records should not be taken as positive indication of the cable location. This can only be determined by digging trial holes. Where trial holes are dug the concrete and / or polymeric cable protection tiles must not be disturbed.
- The normal recommendation is to keep 2 metres clear either side of the 1 metre wide trench containing the AC cable.
- National Grid should be made aware of the works starting and may put in place a representative to monitor the works. The works should be carried out in accordance with the recommendations in document HS (G) 47 available from the HSE web site.
- The relocation of existing underground cables is not normally feasible on grounds of cost, operation and maintenance and environmental impact and we believe that successful development can take place in their vicinity.
- The information supplied is given in good faith and only as a guide to the location of our underground cables. The accuracy of this information cannot be guaranteed. The physical presence of such cables may also be evident from physical protection measures such as ducts or concrete protection tiles. The person(s) responsible for planning, supervising and carrying out work in proximity to our cable(s) shall be liable to us, as cable(s) owner, as well as to any third party who may be affected in any way by any loss or damage resulting from their failure to locate and avoid any damage to such a cable(s).
- The relevant guidance in relation to working safely near to existing underground cables is contained within the Health and Safety Executive's (www.hse.gov.uk) Guidance HS(G)47 "Avoiding Danger From Underground Services" and all relevant site staff should make sure that they are both aware of and understand this guidance.
- Our cables are normally buried to a depth of 0.9 metres to the protective covers but this depth can vary depending on location (bridges may have cables 100mm below surface level)..The specific cable route record drawings show further details along the route of the particular cable. The cable route drawings are attached to this letter for your information.
- Cables installed in cable tunnels, whilst less likely to be affected by surface or shallow works may be affected by activities such as piling.
- National Grid assets can be adversely affected by vibration and can provide guidance on the acceptable levels of vibration due to piling and other construction related operations in the vicinity of national grid assets
- Ground cover above our cables should not be reduced or increased without consultation with National Grid.

- If a landscaping scheme is proposed as part of the works, we request that no trees and shrubs are planted either directly above or within 3 metres of the existing underground cable, as ultimately the roots may grow to cause damage to the cable.

Cables Tunnels

- National Grid's underground cable tunnels are protected by the provisions of a Wayleave/Easement or the New Roads and Street Works Act. This provides full right of access to retain, maintain, repair and inspect our asset.
- Further information and guidance regarding National Grid Cable Tunnels is available on our website at <https://www.nationalgrid.com/uk/electricity-transmission/document/121061/download>
- National Grid requires that the clearances indicated in the guidance document linked above are maintained at all times. Should it be necessary to enter the exclusion zone discussion/ agreement with National Grid is required to ensure the integrity of their tunnel asset and the high voltage cables is not compromised.
- Ground levels above our cable tunnels must not be altered in any way without prior agreement with National Grid; any alterations to the depth of our tunnels can compromise its integrity which could have an adverse impact on the reliability, efficiency and safety of our electricity network.
- Any works which would create high levels of vibration such as piling would need to be assessed by National Grid to ensure it has limited impact on our cable tunnels. National Grid can advise on acceptable vibration limits.

Overhead Lines

- National Grid's Overhead Line/s is protected by a Deed of Easement/Wayleave Agreement which provides full right of access to retain, maintain, repair and inspect our asset.
- The submitted proposed design does not change after the date of this letter. Any design change that moves the proposal closer to National Grid Overhead Line Assets shall be submitted for assessment.
- Statutory electrical safety clearances shall be maintained at all times. National Grid recommends that no permanent structures are built directly beneath our overhead lines. These distances are set out in EN 43 – 8 Technical Specification for "Overhead Line Clearances Issue 5 (2019)". To purchase & download EN 43 – 8 Technical Specification for "Overhead Line Clearances Issue 5 (2019)" go to <https://www.ena-eng.org/ENA-Docs/>
- Any changes in ground levels which are proposed either beneath or in close proximity to our existing overhead lines would serve to reduce safety clearances. Safety clearances to existing overhead lines must be maintained in all circumstances.
- To view the Development Near Overhead Lines Document.
<https://www.nationalgridet.com/document/130626/download>
- To view the National Grid Third Party Guidance for working near National Grid Electricity Transmission equipment.
<https://www.nationalgridet.com/sites/et/files/documents/Working%20near%20electricity%20equipment.pdf>
- The relevant guidance in relation to working safely near to existing overhead lines is contained within the Health and Safety Executive's (www.hse.gov.uk) Guidance Note GS 6 "Avoidance of Danger from Overhead Electric Lines."



- If a landscaping scheme is proposed as part of the proposal, only slow and low growing species of trees and shrubs shall be planted beneath and adjacent to the existing overhead line to reduce the risk of growth to a height which compromises statutory safety clearances.
- Drilling or excavation works shall not be undertaken if they have the potential to disturb or adversely affect the foundations or “pillars of support” of our towers. These foundations extend beyond the base of the tower. Pillar of Support drawings shall be obtained using the contact details above.
- Due to the scale, bulk and cost of the transmission equipment required to operate at 275kV or 400kV we only support proposals for the relocation of existing high voltage overhead lines where such proposals directly facilitate a major development or infrastructure project of national importance which has been identified as such by government.
- To promote the successful development of sites crossed by existing overhead lines, and the creation of well-designed places, National Grid has produced ‘Design guidelines for development near pylons and high voltage overhead power lines’, which look at how to create high quality development near overhead lines and offer practical solutions which can assist in avoiding the unnecessary sterilisation of land in the vicinity of high voltage overhead lines.
- Further information regarding our undergrounding policy and development near transmission overhead lines is available on our website at: <https://www.nationalgridet.com/network-and-assets/planning-and-development>

[illegible]

Warning: PDF designed for colour print only with no page scaling


National Grid Electricity Emergency Number: 0800 40 40 90
Available 24 hours, 7 days/week. Calls may be recorded and monitored

This plan shows those pipes owned by National Grid Electricity Transmission plc in its role as a Licensed Electricity Transporter (ET). Electricity cables owned by other ETs, or otherwise privately owned, may be present in this area. Information with regards to such cables should be obtained from the relevant owners. The information shown on this plan is given without warranty, the accuracy thereof cannot be guaranteed. Ancillary equipment such as cooling systems and communication cables are not shown but their presence should be anticipated. No liability of any kind whatsoever is accepted by National Grid Electricity Transmission plc or their agents, servants or contractors for any error or omission. Safe digging practices, in accordance with HS(G)47, must be used to verify and establish the actual position of cables and other apparatus on site before any mechanical plan is used. It is your responsibility to ensure that this information is provided to all persons (either direct labour or contractors) working for you on or near electricity apparatus. The information included on this plan should not be referred to beyond a period of 28 days from the date of issue.

Fibre Cables


Scale: 1:10250 (When plotted at A3)

AssetProtection@NationalGrid.com

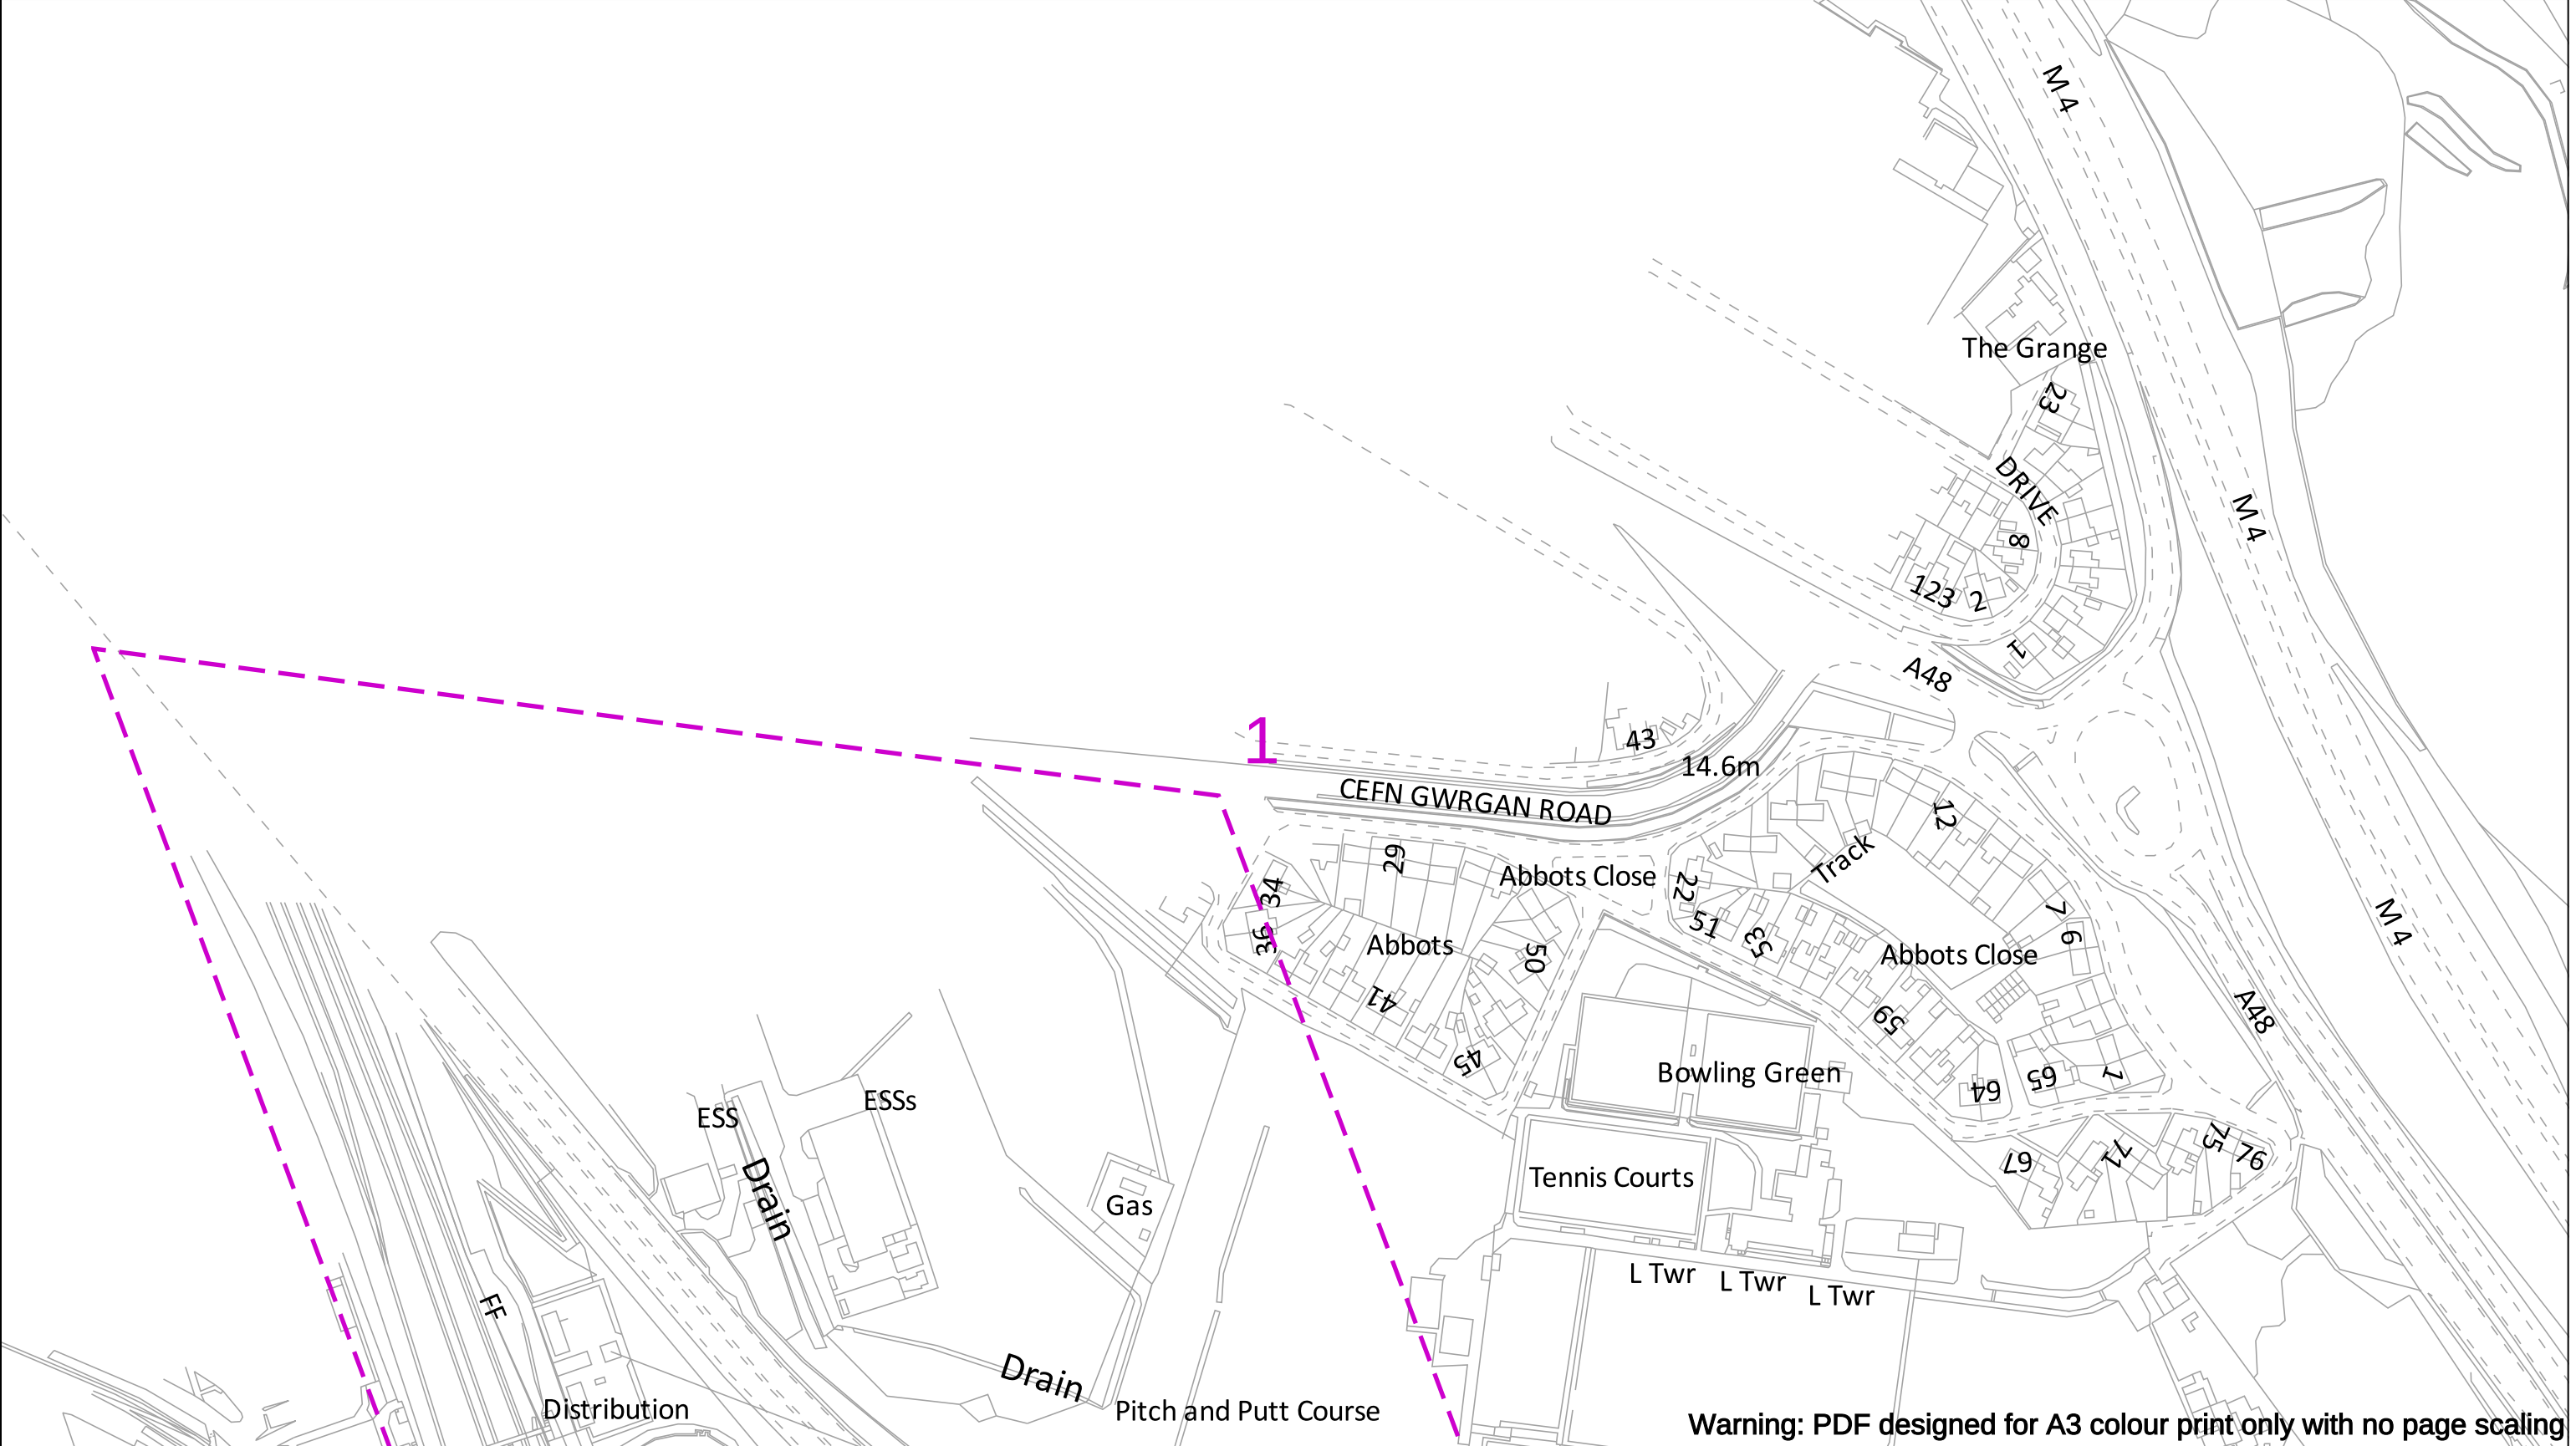


Warning: PDF designed for A3 colour print only with no page scaling

Date Requested: 24/11/2023 Job Reference: 31654782 Site Location: 278649 186231 Requested by: Mr Farhan Aslam Your Scheme/Reference: NG TATA Steel Margam FEED Scale: 1:2500 (When plotted at A3)	EXTREME CAUTION - HIGH VOLTAGE **RISK OF DEATH OR SERIOUS INJURY** IMPORTANT NOTICES This plan shows those pipes owned by National Grid Electricity Transmission plc in its role as a Licensed Electricity Transporter (ET). Electricity cables owned by other ETs, or otherwise privately owned, may be present in this area. Information with regards to such cables should be obtained from the relevant owners. The information shown on this plan is given without warranty, the accuracy thereof cannot be guaranteed. Ancillary equipment such as cooling systems and communication cables are not shown but their presence should be anticipated. No liability of any kind whatsoever is accepted by National Grid Electricity Transmission plc or their agents, servants or contractors for any error or omission. Safe digging practices, in accordance with HS(G)47, must be used to verify and establish the actual position of cables and other apparatus on site before any mechanical plant is used. It is your responsibility to ensure that this information is provided to all persons (either direct labour or contractors) working for you on or near electricity apparatus. The information included on this plan should not be referred to beyond a period of 28 days from the date of issue.	National Grid Electricity Emergency Number: 0800 40 40 90 Available 24 hours, 7 days/week. Calls may be recorded and monitored Warning: PDF designed for colour print only with no page scaling 0200 m Dig Sites Area: Line: Underground Cables Overhead Lines Fibre Cables	NationalGrid House Warwick Technology Park Gallows Hill Warwick CV34 6DA AssetProtection@NationalGrid.com
Crown Copyright © - Reproduced by permission of Ordnance Survey on behalf of HMSO. And database right 2023. All rights reserved. Ordnance Survey Licence number 0100059731			

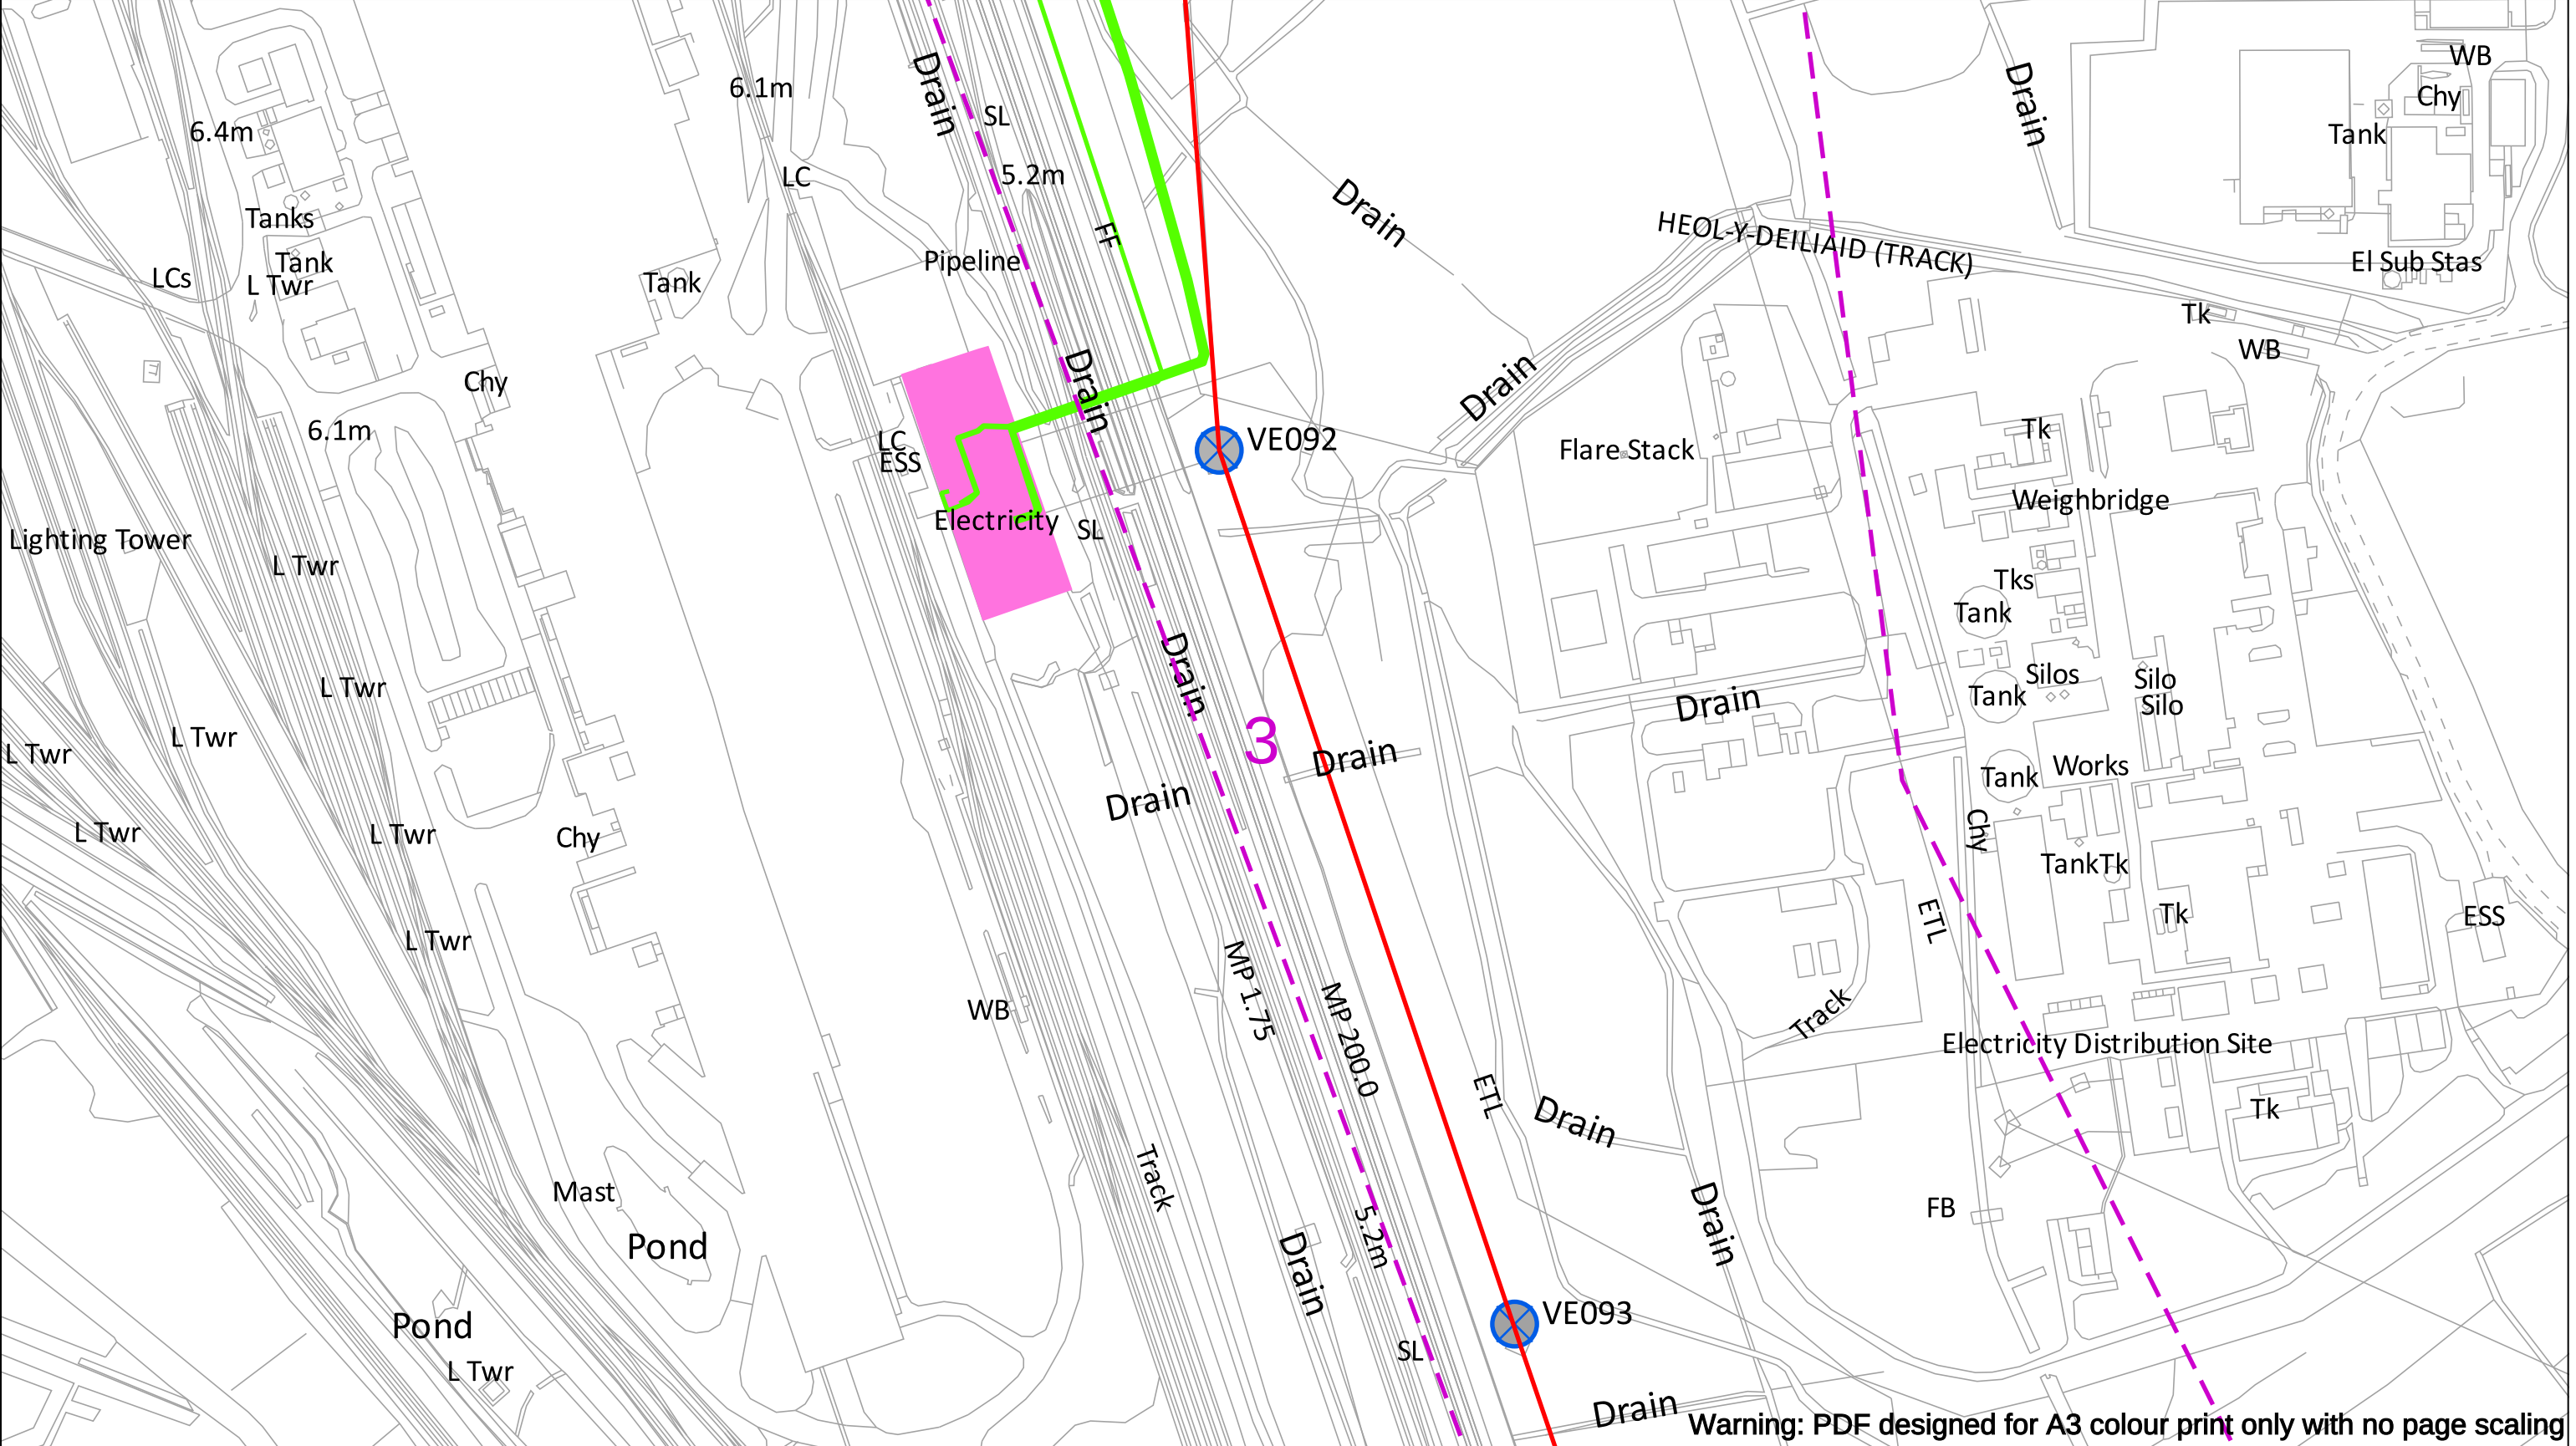

Warning: PDF designed for A3 colour print only with no page scaling

Date Requested: 24/11/2023 Job Reference: 31654782 Site Location: 278649 186231 Requested by: Mr Farhan Aslam Your Scheme/Reference: NG TATA Steel Margam FEED Scale: 1:2500 (When plotted at A3)	EXTREME CAUTION - HIGH VOLTAGE **RISK OF DEATH OR SERIOUS INJURY** IMPORTANT NOTICES This plan shows those pipes owned by National Grid Electricity Transmission plc in its role as a Licensed Electricity Transporter (ET). Electricity cables owned by other ETs, or otherwise privately owned, may be present in this area. Information with regards to such cables should be obtained from the relevant owners. The information shown on this plan is given without warranty, the accuracy thereof cannot be guaranteed. Ancillary equipment such as cooling systems and communication cables are not shown but their presence should be anticipated. No liability of any kind whatsoever is accepted by National Grid Electricity Transmission plc or their agents, servants or contractors for any error or omission. Safe digging practices, in accordance with HS(G)47, must be used to verify and establish the actual position of cables and other apparatus on site before any mechanical plant is used. It is your responsibility to ensure that this information is provided to all persons (either direct labour or contractors) working for you on or near electricity apparatus. The information included on this plan should not be referred to beyond a period of 28 days from the date of issue.	National Grid Electricity Emergency Number: 0800 40 40 90 Available 24 hours, 7 days/week. Calls may be recorded and monitored Warning: PDF designed for colour print only with no page scaling 0200 m Dig Sites Area: Line: Underground Cables Overhead Lines Fibre Cables	NationalGrid House Warwick Technology Park Gallows Hill Warwick CV34 6DA AssetProtection@NationalGrid.com
---	---	---	---

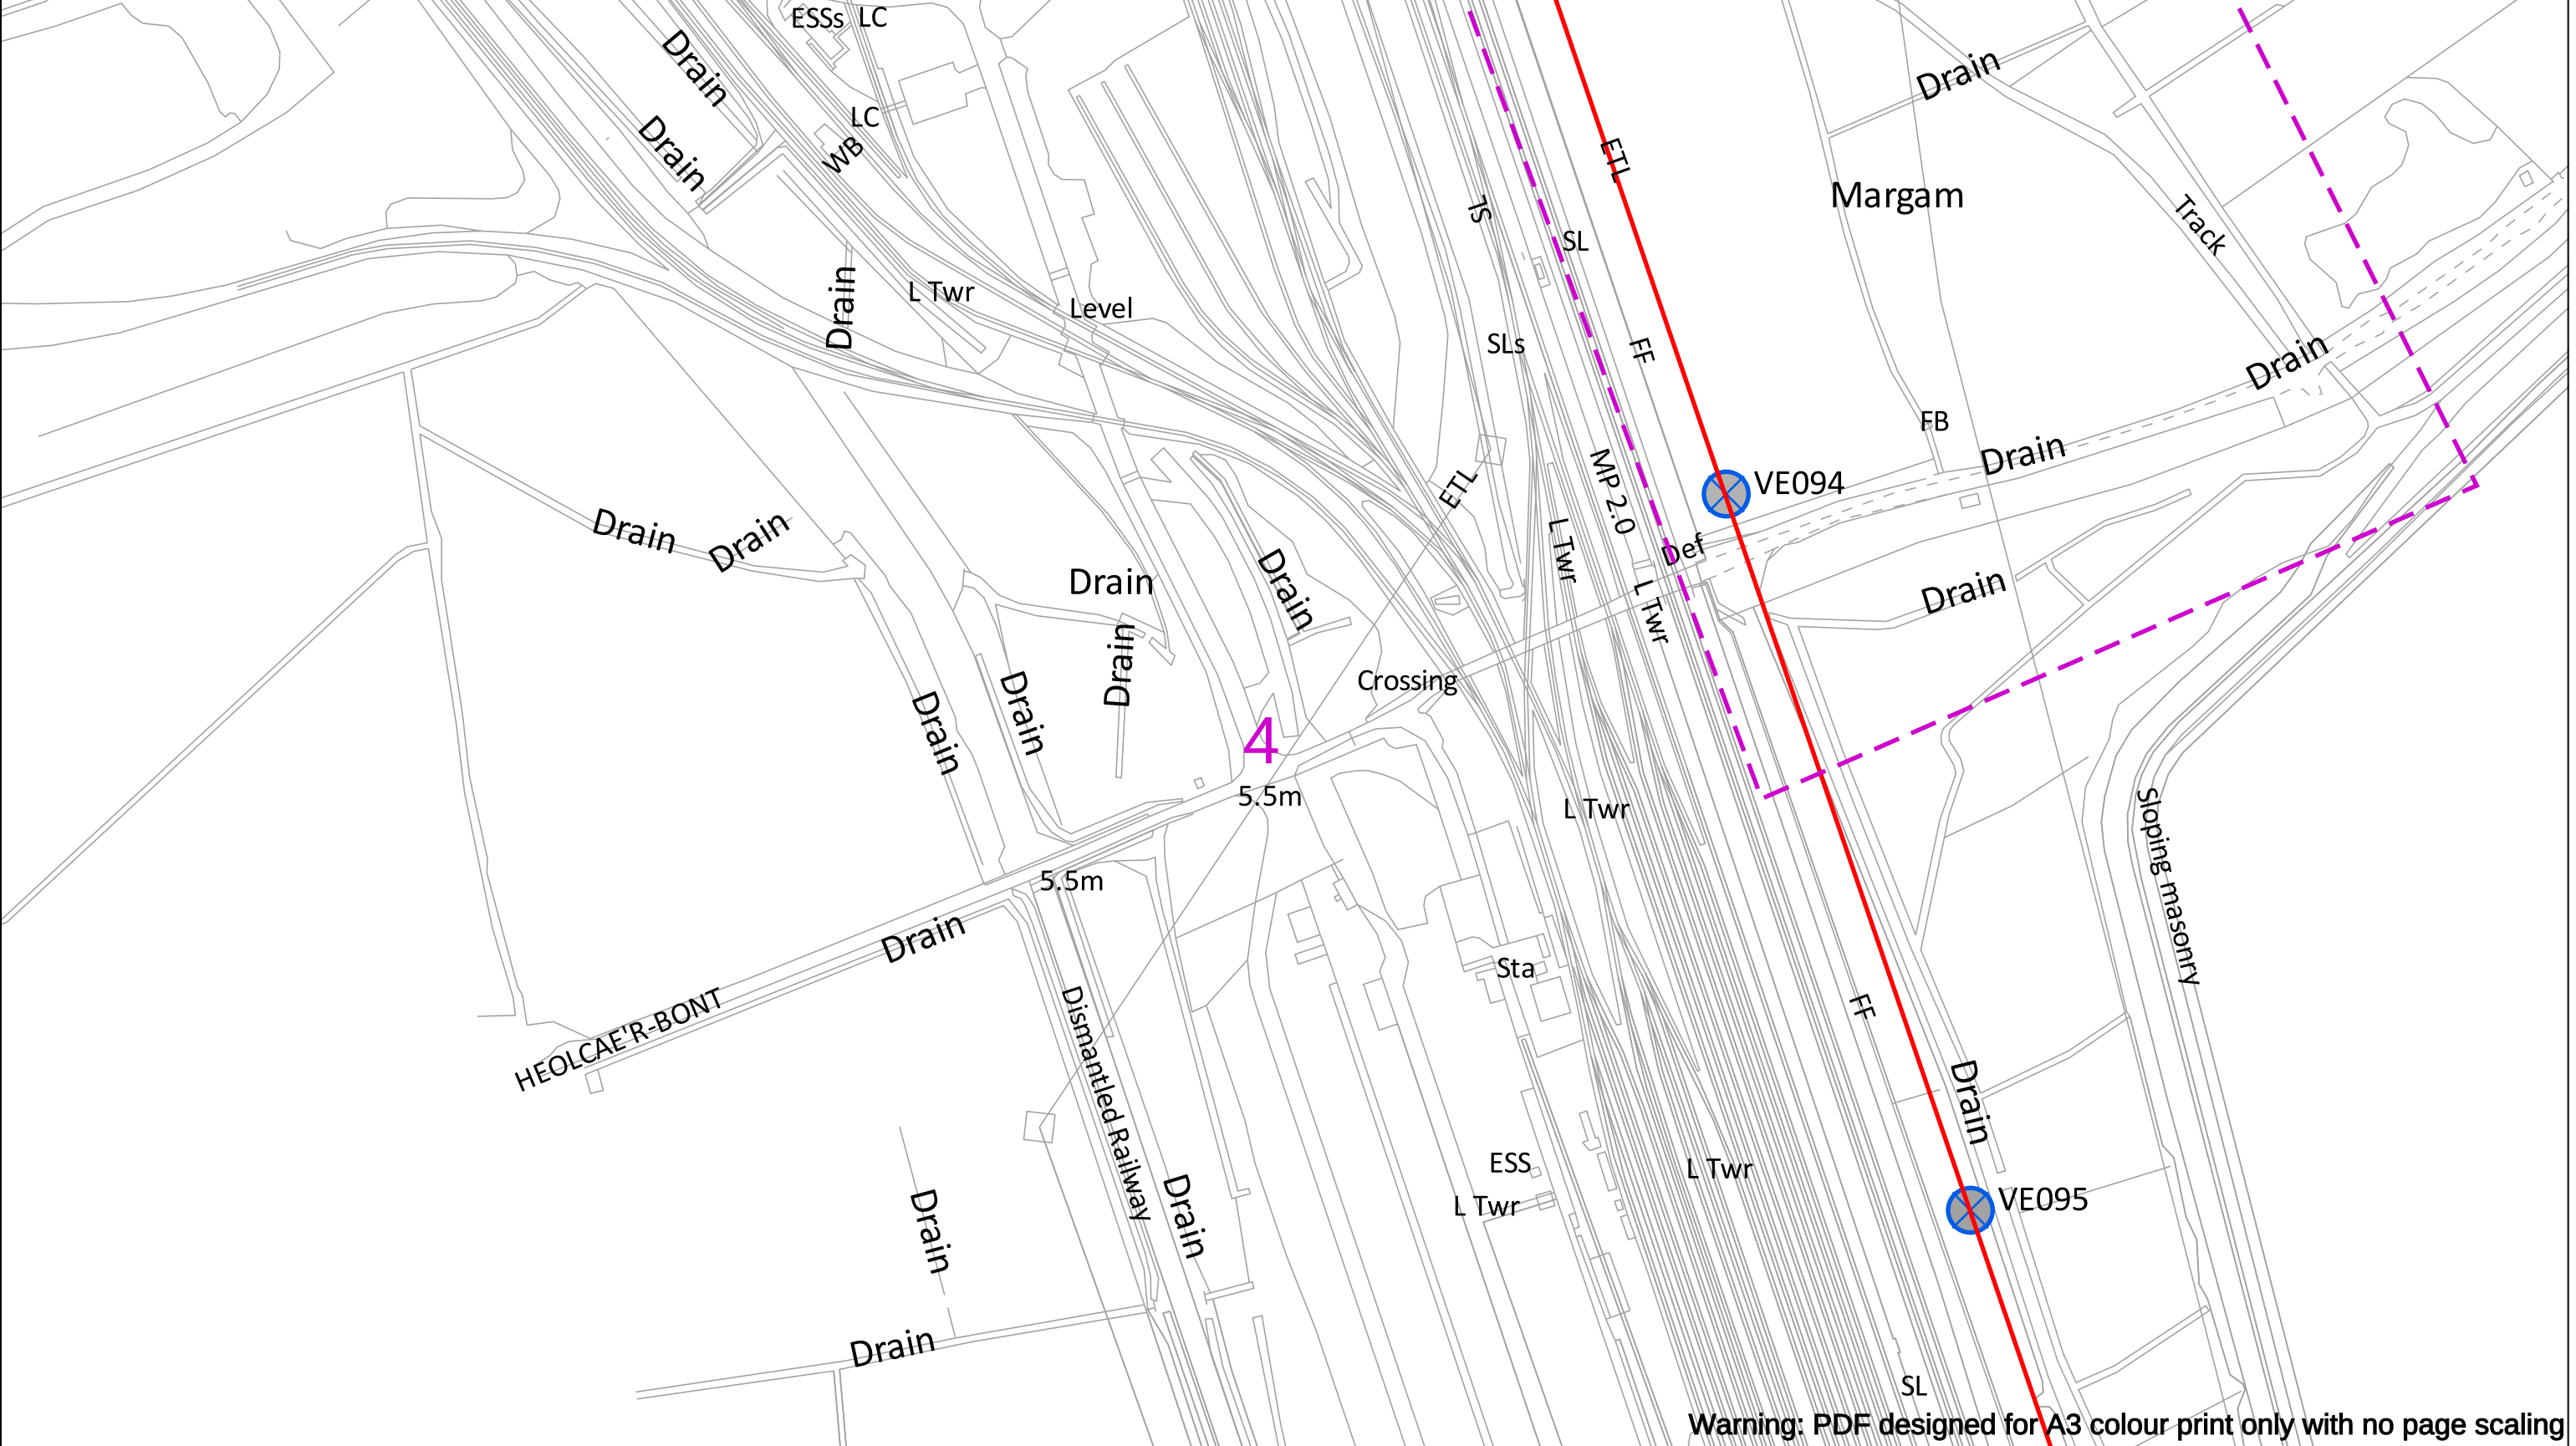

Warning: PDF designed for A3 colour print only with no page scaling

Date Requested: 24/11/2023 Job Reference: 31654782 Site Location: 278649 186231 Requested by: Mr Farhan Aslam Your Scheme/Reference: NG TATA Steel Margam FEED Scale: 1:2500 (When plotted at A3)	EXTREME CAUTION - HIGH VOLTAGE **RISK OF DEATH OR SERIOUS INJURY** IMPORTANT NOTICES This plan shows those pipes owned by National Grid Electricity Transmission plc in its role as a Licensed Electricity Transporter (ET). Electricity cables owned by other ETs, or otherwise privately owned, may be present in this area. Information with regards to such cables should be obtained from the relevant owners. The information shown on this plan is given without warranty, the accuracy thereof cannot be guaranteed. Ancillary equipment such as cooling systems and communication cables are not shown but their presence should be anticipated. No liability of any kind whatsoever is accepted by National Grid Electricity Transmission plc or their agents, servants or contractors for any error or omission. Safe digging practices, in accordance with HS(G)47, must be used to verify and establish the actual position of cables and other apparatus on site before any mechanical plant is used. It is your responsibility to ensure that this information is provided to all persons (either direct labour or contractors) working for you on or near electricity apparatus. The information included on this plan should not be referred to beyond a period of 28 days from the date of issue.	National Grid Electricity Emergency Number: 0800 40 40 90 Available 24 hours, 7 days/week. Calls may be recorded and monitored Warning: PDF designed for colour print only with no page scaling 0 200 m Dig Sites Area: Line: Underground Cables Overhead Lines Fibre Cables	NationalGrid House Warwick Technology Park Gallows Hill Warwick CV34 6DA AssetProtection@NationalGrid.com
---	---	--	--

ENQUIRY SUMMARY

Received Date

24/11/2023 12:10

Work Start Date

25/11/2023

Your Reference

NG TATA Steel Margam FEED

Location

Centre Point: 278649 186231

X Extent:

Y Extent:

Postcode: SA132NS

Map Options

Paper Size: A3

Orientation: LANDSCAPE

Scale: 1:2500

Real World Extents: 942m x 1779m

Enquirer Details

Organisation Name: BakerHicks

Contact Name: Farhan Aslam

Email Address: farhan.aslam@bakerhicks.com

Telephone: 07421234906

Address: Flat1, 162-164, Yardley Road, Acocks green., , West Midlands, B27 6LR

Enquiry Type

Initial Enquiry

Activity Type

Utility Works

Work Types

Horizontal drilling/moling/tunnelling/pipe jacking

Notes/Works Description (if supplied)

Information only for Utility works

Site Contact Name (if supplied)

Jose Antonio Urdaneta

Site Contact Number (if supplied)

07575302017

Our Ref: 31655152 National Grid Steel Margam FEED

Friday, 24 November 2023

Farhan Aslam
Flat1, 162-164, Yardley Road, Acocks green.

West Midlands
B27 6LR

National Grid House
Warwick Technology Park
Gallows Hill, Warwick
CV34 6DA

Electricity Emergency Number:
0800 40 40 90*
*Available 24 hours, 7 days/week.
Calls may be recorded and monitored.
www.nationalgrid.com

Asset Protection
Gas Transmission
National Grid
Warwick
Email: assetprotection@nationalgrid.com

National Grid Electricity – No Assets Affected

Dear Sir/ Madam,

An assessment has been carried out with respect to NGET apparatus and the proposed work location. Based on the search area entered in the LSBUD system for assessment the search area has been found to not affect any NGET apparatus.

Please note this response and any attached map(s) are valid for 28 days

Yours sincerely

Asset Protection Team

Your Responsibilities and Obligations


It is your responsibility to ensure that the information you have submitted is accurate and that all relevant documents including links are provided to all persons (either direct labour or contractors) working for you near National Grid Electricity Transmission plc's apparatus, as legally required including under the Construction (Design and Management) Regulations 2015.

The assessment solely relates to the physical apparatus of National Grid Electricity Transmission plc (NGET)
It does **NOT** cover:

- Apparatus owned by other people or organisations, e.g., Cadent, other gas distribution operators, local electricity companies, other utilities, landowners etc
- Apparatus owned by National Grid Gas plc.
- NGET's legal rights and interests (such as those contained in easements or wayleaves) in or concerning the land, which restrict activity in proximity to NGET's assets in private land. You must obtain details of any such restrictions from the landowner in the first instance and/or from HM Land Registry and/or you should seek legal advice. If in doubt, contact Asset Protection.


It is **YOUR** responsibility to consider whether any of the items or factors listed above may be present or relevant and if they could be affected by your proposed activities.

NGET or its agents, servants or contractors do not accept any liability for any losses arising under or in connection with this information. This limit on liability applies to all and any claims in contract, tort (including negligence), misrepresentation (excluding fraudulent misrepresentation), breach of statutory duty or otherwise. This limit on liability does not exclude or restrict liability, which is prohibited by law, nor does it supersede the express terms of any related agreements.

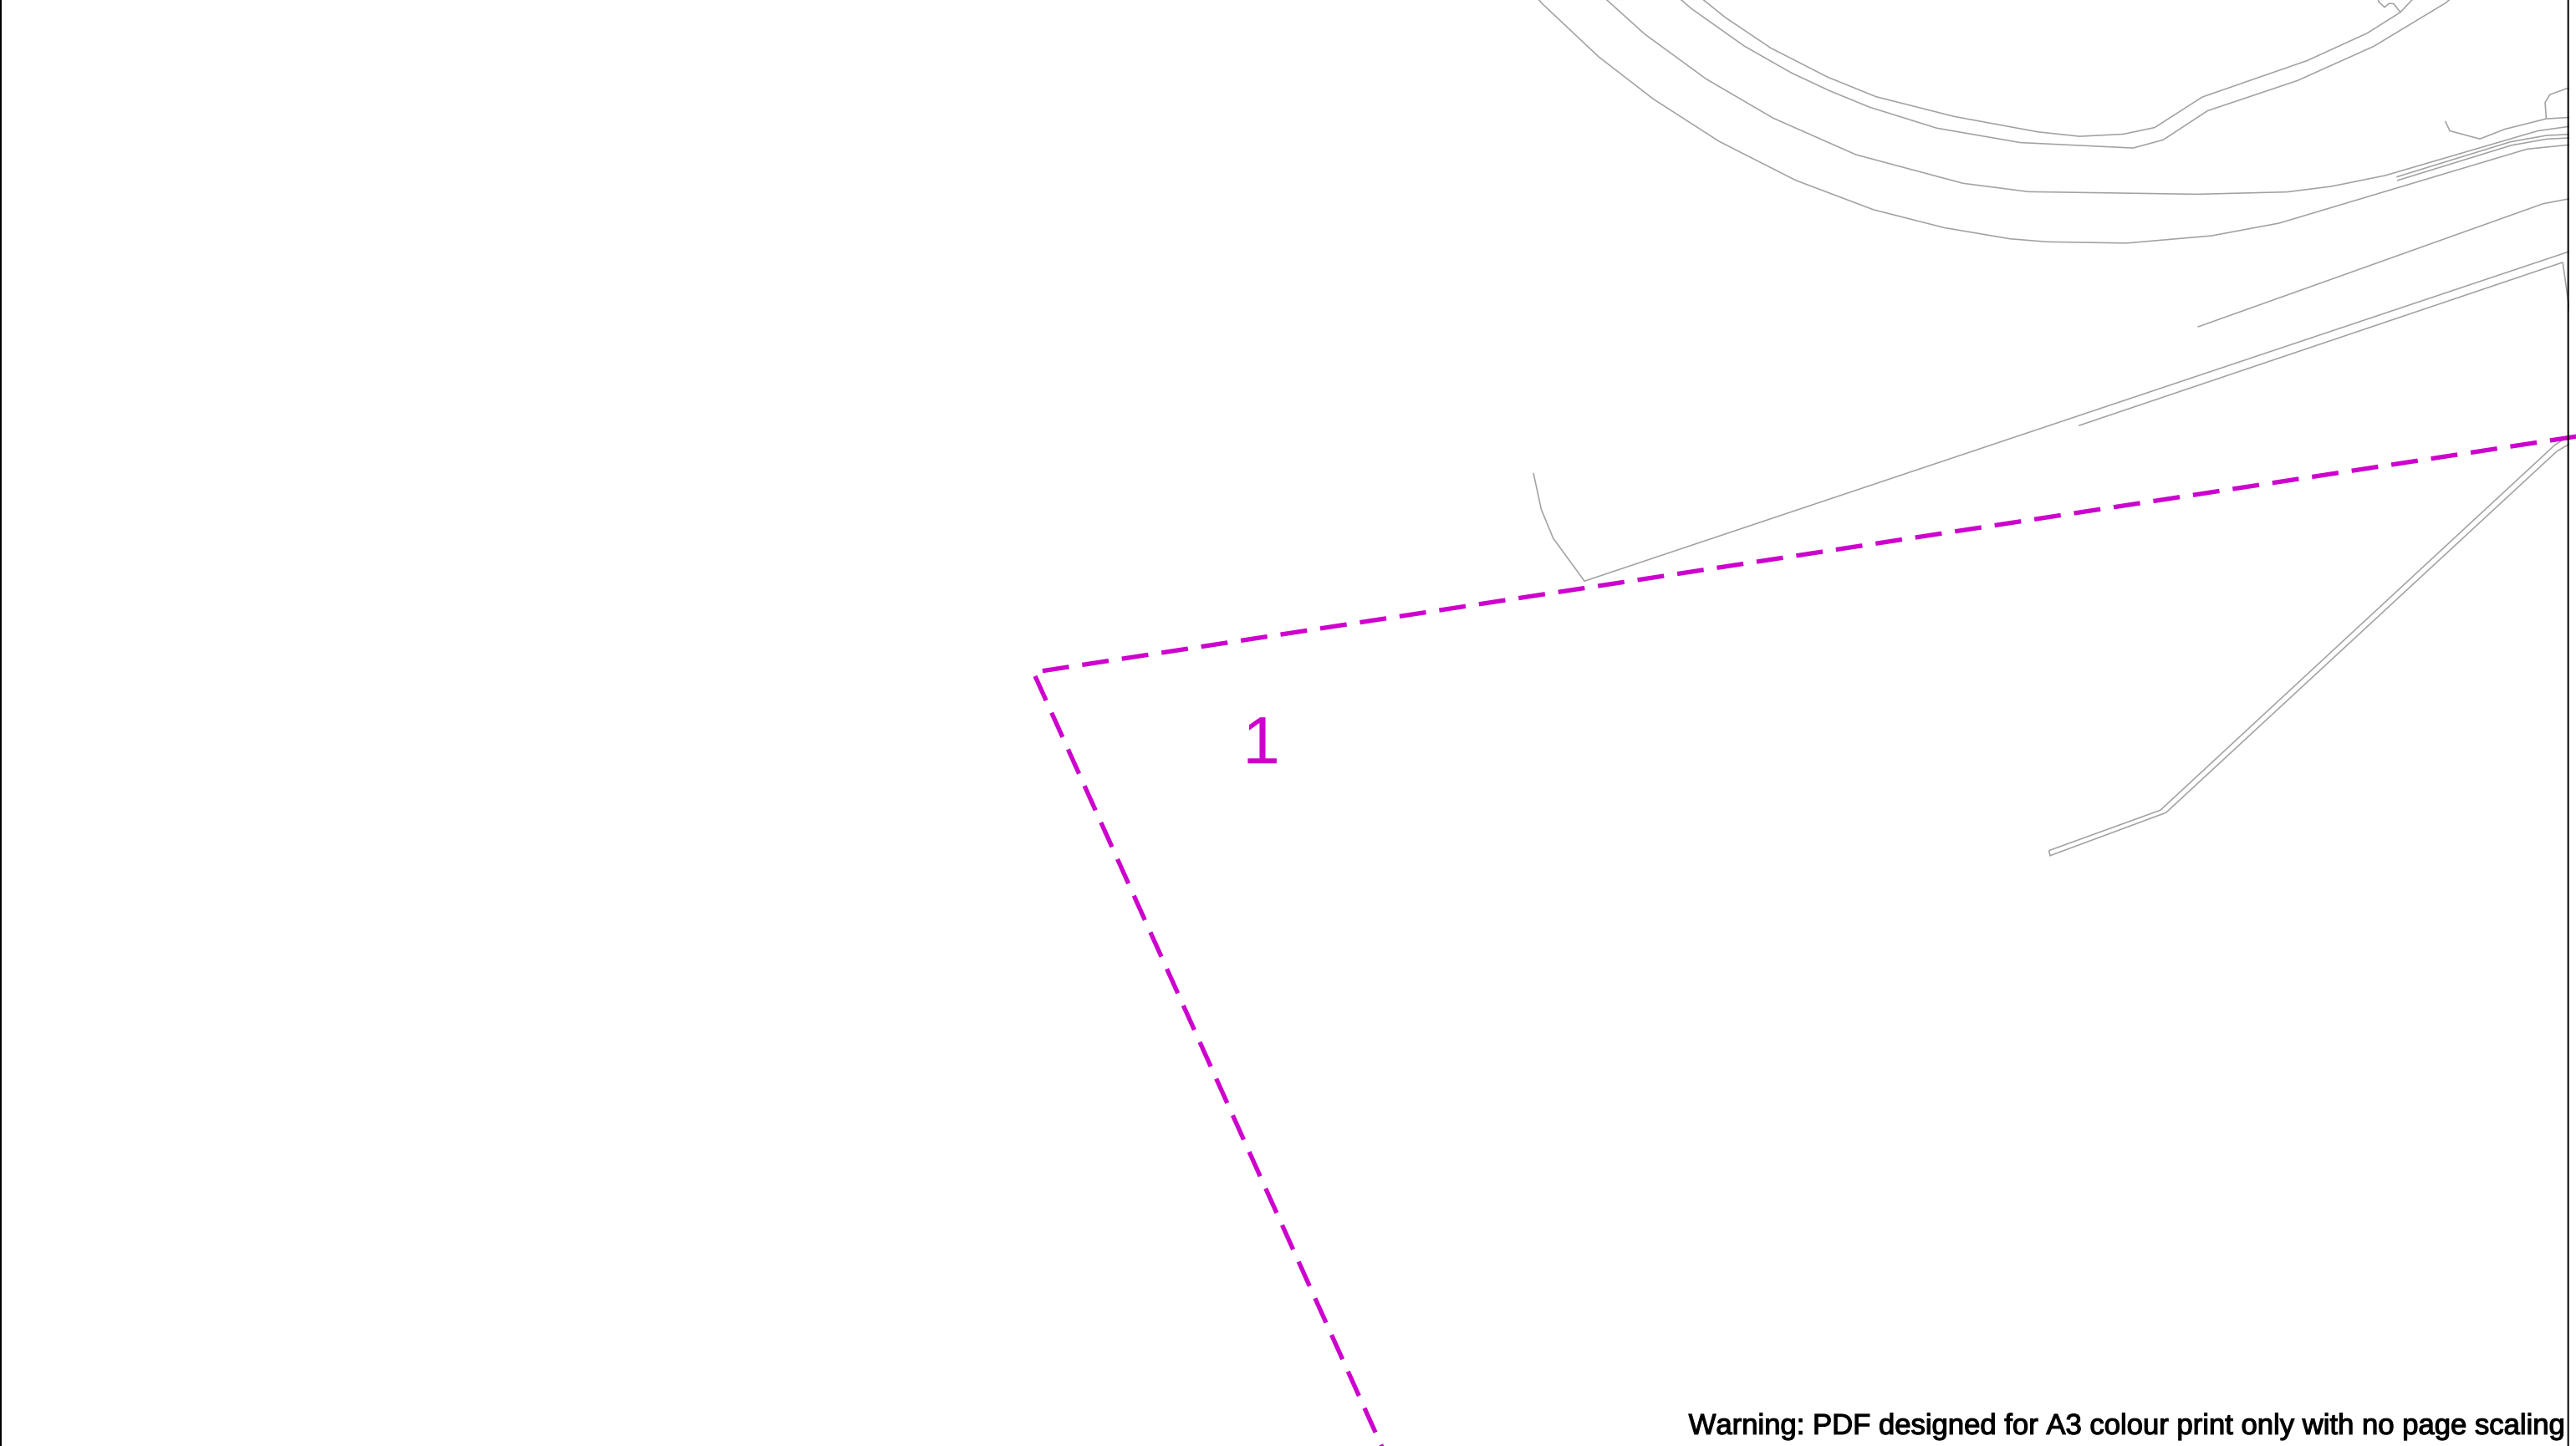


Warning: PDF designed for A3 colour print only with no page scaling

	EXTREME CAUTION - HIGH VOLTAGE **RISK OF DEATH OR SERIOUS INJURY**	National Grid Electricity Emergency Number: 0800 40 40 90 Available 24 hours, 7 days/week. Calls may be recorded and monitored Warning: PDF designed for colour print only with no page scaling	
Date Requested: 24/11/2023 Job Reference: 31655152 Site Location: 278263 185096 Requested by: Mr Farhan Aslam Your Scheme/Reference: National Grid Steel Margam FEED Scale: 1:2500 (When plotted at A3)	IMPORTANT NOTICES This plan shows those pipes owned by National Grid Electricity Transmission plc in its role as a Licensed Electricity Transporter (ET). Electricity cables owned by other ETs, or otherwise privately owned, may be present in this area. Information with regards to such cables should be obtained from the relevant owners. The information shown on this plan is given without warranty, the accuracy thereof cannot be guaranteed. Ancillary equipment such as cooling systems and communication cables are not shown but their presence should be anticipated. No liability of any kind whatsoever is accepted by National Grid Electricity Transmission plc or their agents, servants or contractors for any error or omission. Safe digging practices, in accordance with HS(G)47, must be used to verify and establish the actual position of cables and other apparatus on site before any mechanical plant is used. It is your responsibility to ensure that this information is provided to all persons (either direct labour or contractors) working for you on or near electricity apparatus. The information included on this plan should not be referred to beyond a period of 28 days from the date of issue.	0200 m Dig Sites Area: Line: Underground Cables Overhead Lines Fibre Cables	

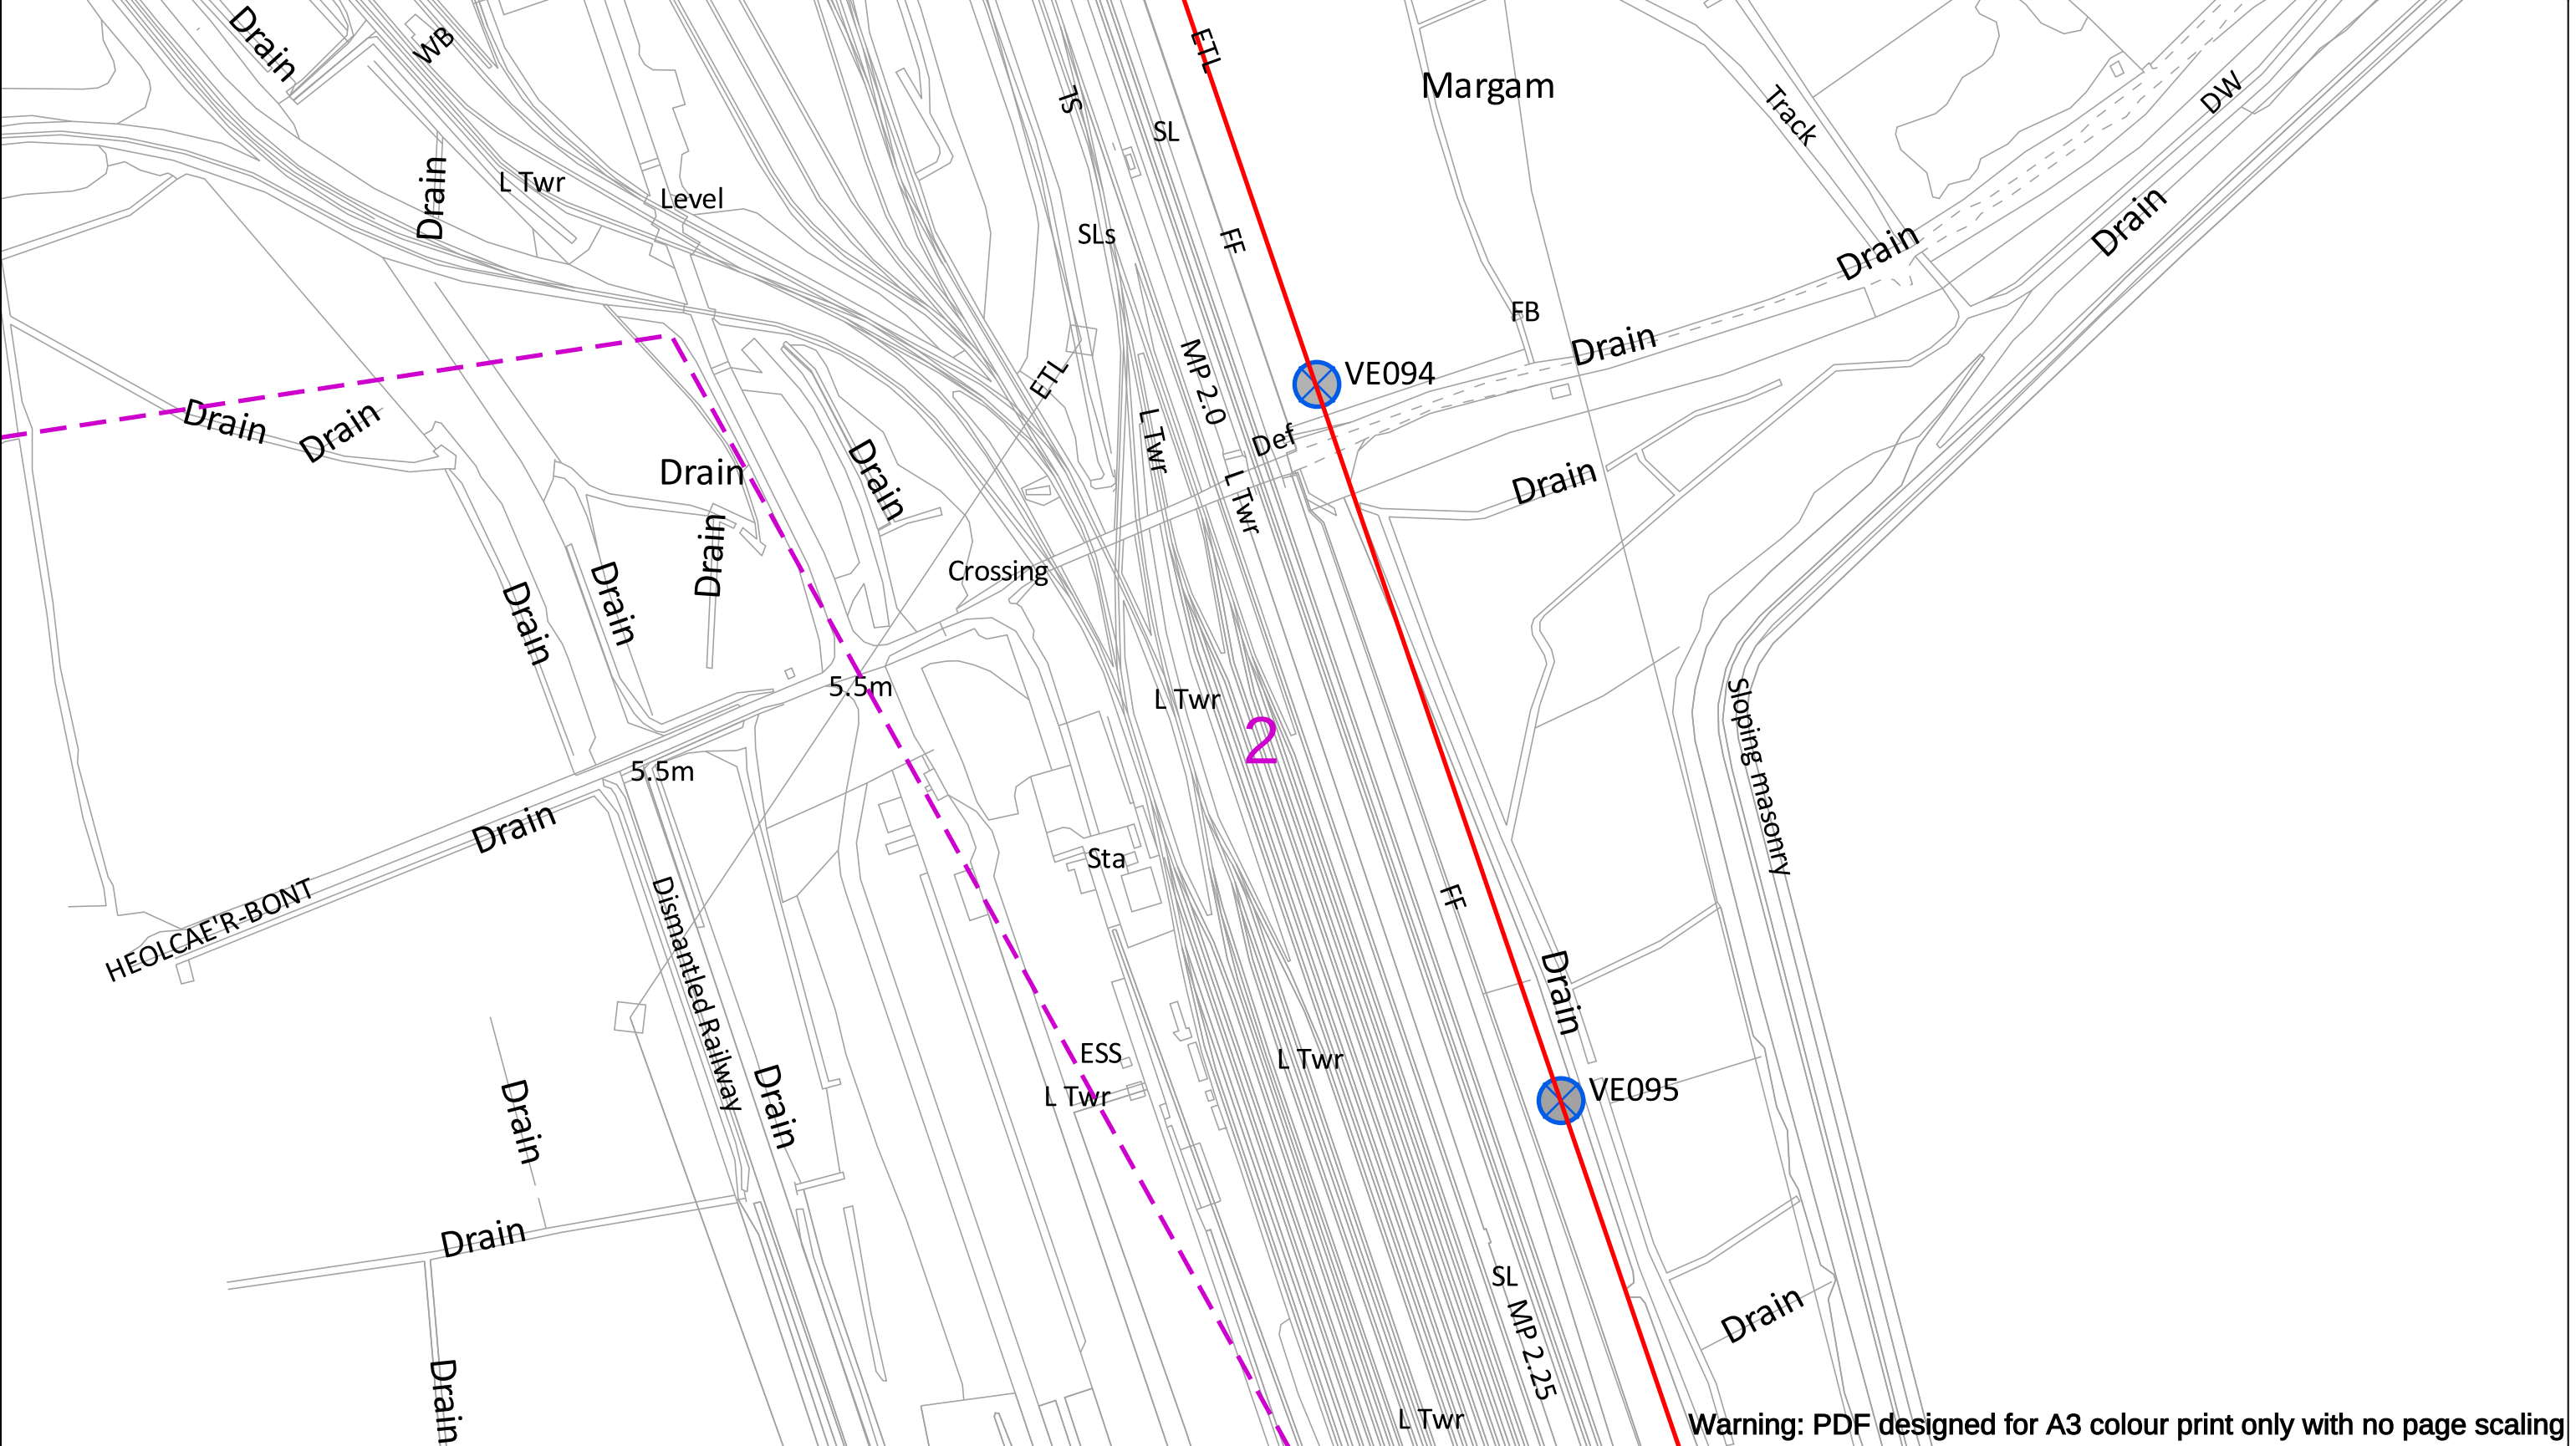


Date Requested: 24/11/2023 Job Reference: 31655152 Site Location: 278263 185096 Requested by: Mr Farhan Aslam Your Scheme/Reference: National Grid Steel Margam FEED Scale: 1:2500 (When plotted at A3)	EXTREME CAUTION - HIGH VOLTAGE **RISK OF DEATH OR SERIOUS INJURY**	National Grid Electricity Emergency Number: 0800 40 40 90 Available 24 hours, 7 days/week. Calls may be recorded and monitored Warning: PDF designed for colour print only with no page scaling	NationalGrid House Warwick Technology Park Gallows Hill Warwick CV34 6DA AssetProtection@NationalGrid.com
	IMPORTANT NOTICES This plan shows those pipes owned by National Grid Electricity Transmission plc in its role as a Licensed Electricity Transporter (ET). Electricity cables owned by other ETs, or otherwise privately owned, may be present in this area. Information with regards to such cables should be obtained from the relevant owners. The information shown on this plan is given without warranty, the accuracy thereof cannot be guaranteed. Ancillary equipment such as cooling systems and communication cables are not shown but their presence should be anticipated. No liability of any kind whatsoever is accepted by National Grid Electricity Transmission plc or their agents, servants or contractors for any error or omission. Safe digging practices, in accordance with HS(G)47, must be used to verify and establish the actual position of cables and other apparatus on site before any mechanical plant is used. It is your responsibility to ensure that this information is provided to all persons (either direct labour or contractors) working for you on or near electricity apparatus. The information included on this plan should not be referred to beyond a period of 28 days from the date of issue.	0200 m Dig Sites Area: Line: Underground Cables Overhead Lines Fibre Cables	
	Crown Copyright © - Reproduced by permission of Ordnance Survey on behalf of HMSO. And database right 2023. All rights reserved. Ordnance Survey Licence number 0100059731		

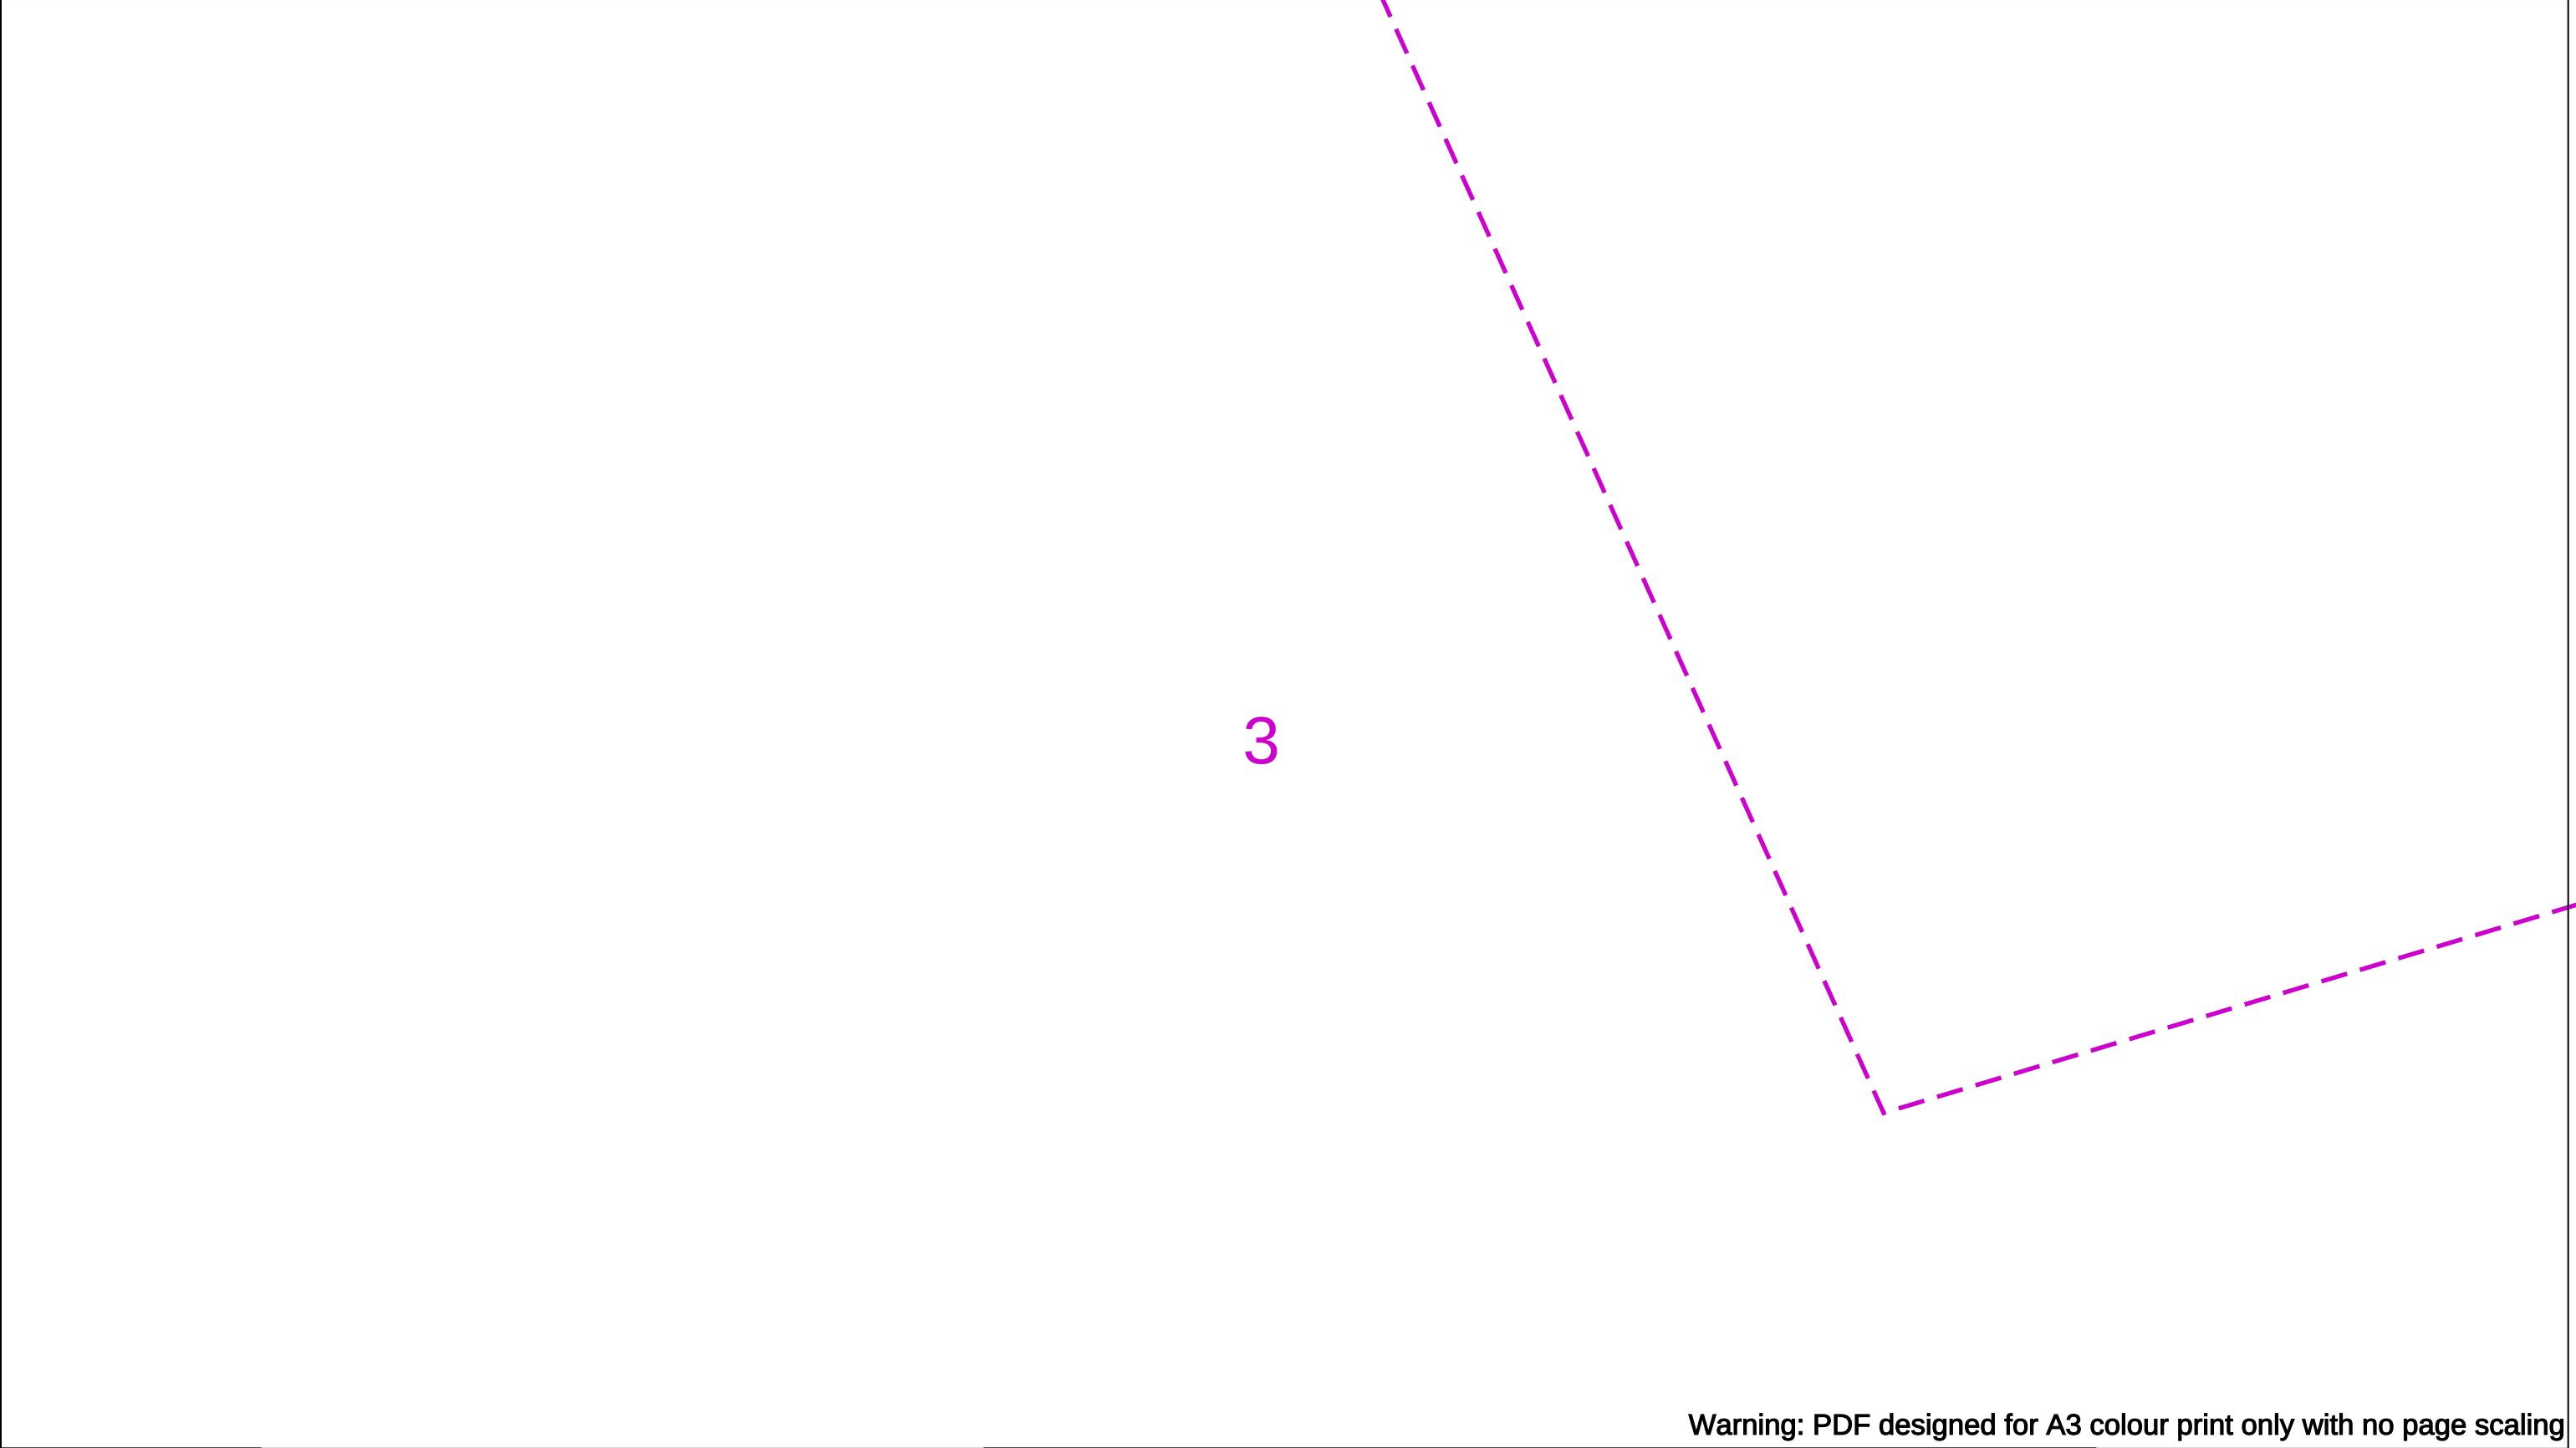

Warning: PDF designed for A3 colour print only with no page scaling

	EXTREME CAUTION - HIGH VOLTAGE **RISK OF DEATH OR SERIOUS INJURY**	National Grid Electricity Emergency Number: 0800 40 40 90 Available 24 hours, 7 days/week. Calls may be recorded and monitored Warning: PDF designed for colour print only with no page scaling	
Date Requested: 24/11/2023 Job Reference: 31655152 Site Location: 278263 185096 Requested by: Mr Farhan Aslam Your Scheme/Reference: National Grid Steel Margam FEED Scale: 1:2500 (When plotted at A3)	IMPORTANT NOTICES This plan shows those pipes owned by National Grid Electricity Transmission plc in its role as a Licensed Electricity Transporter (ET). Electricity cables owned by other ETs, or otherwise privately owned, may be present in this area. Information with regards to such cables should be obtained from the relevant owners. The information shown on this plan is given without warranty, the accuracy thereof cannot be guaranteed. Ancillary equipment such as cooling systems and communication cables are not shown but their presence should be anticipated. No liability of any kind whatsoever is accepted by National Grid Electricity Transmission plc or their agents, servants or contractors for any error or omission. Safe digging practices, in accordance with HS(G)47, must be used to verify and establish the actual position of cables and other apparatus on site before any mechanical plant is used. It is your responsibility to ensure that this information is provided to all persons (either direct labour or contractors) working for you on or near electricity apparatus. The information included on this plan should not be referred to beyond a period of 28 days from the date of issue.	0200 m Dig Sites Area: Line: Underground Cables Overhead Lines Fibre Cables	NationalGrid House Warwick Technology Park Gallows Hill Warwick CV34 6DA AssetProtection@NationalGrid.com
Crown Copyright © - Reproduced by permission of Ordnance Survey on behalf of HMSO. And database right 2023. All rights reserved. Ordnance Survey Licence number 0100059731			

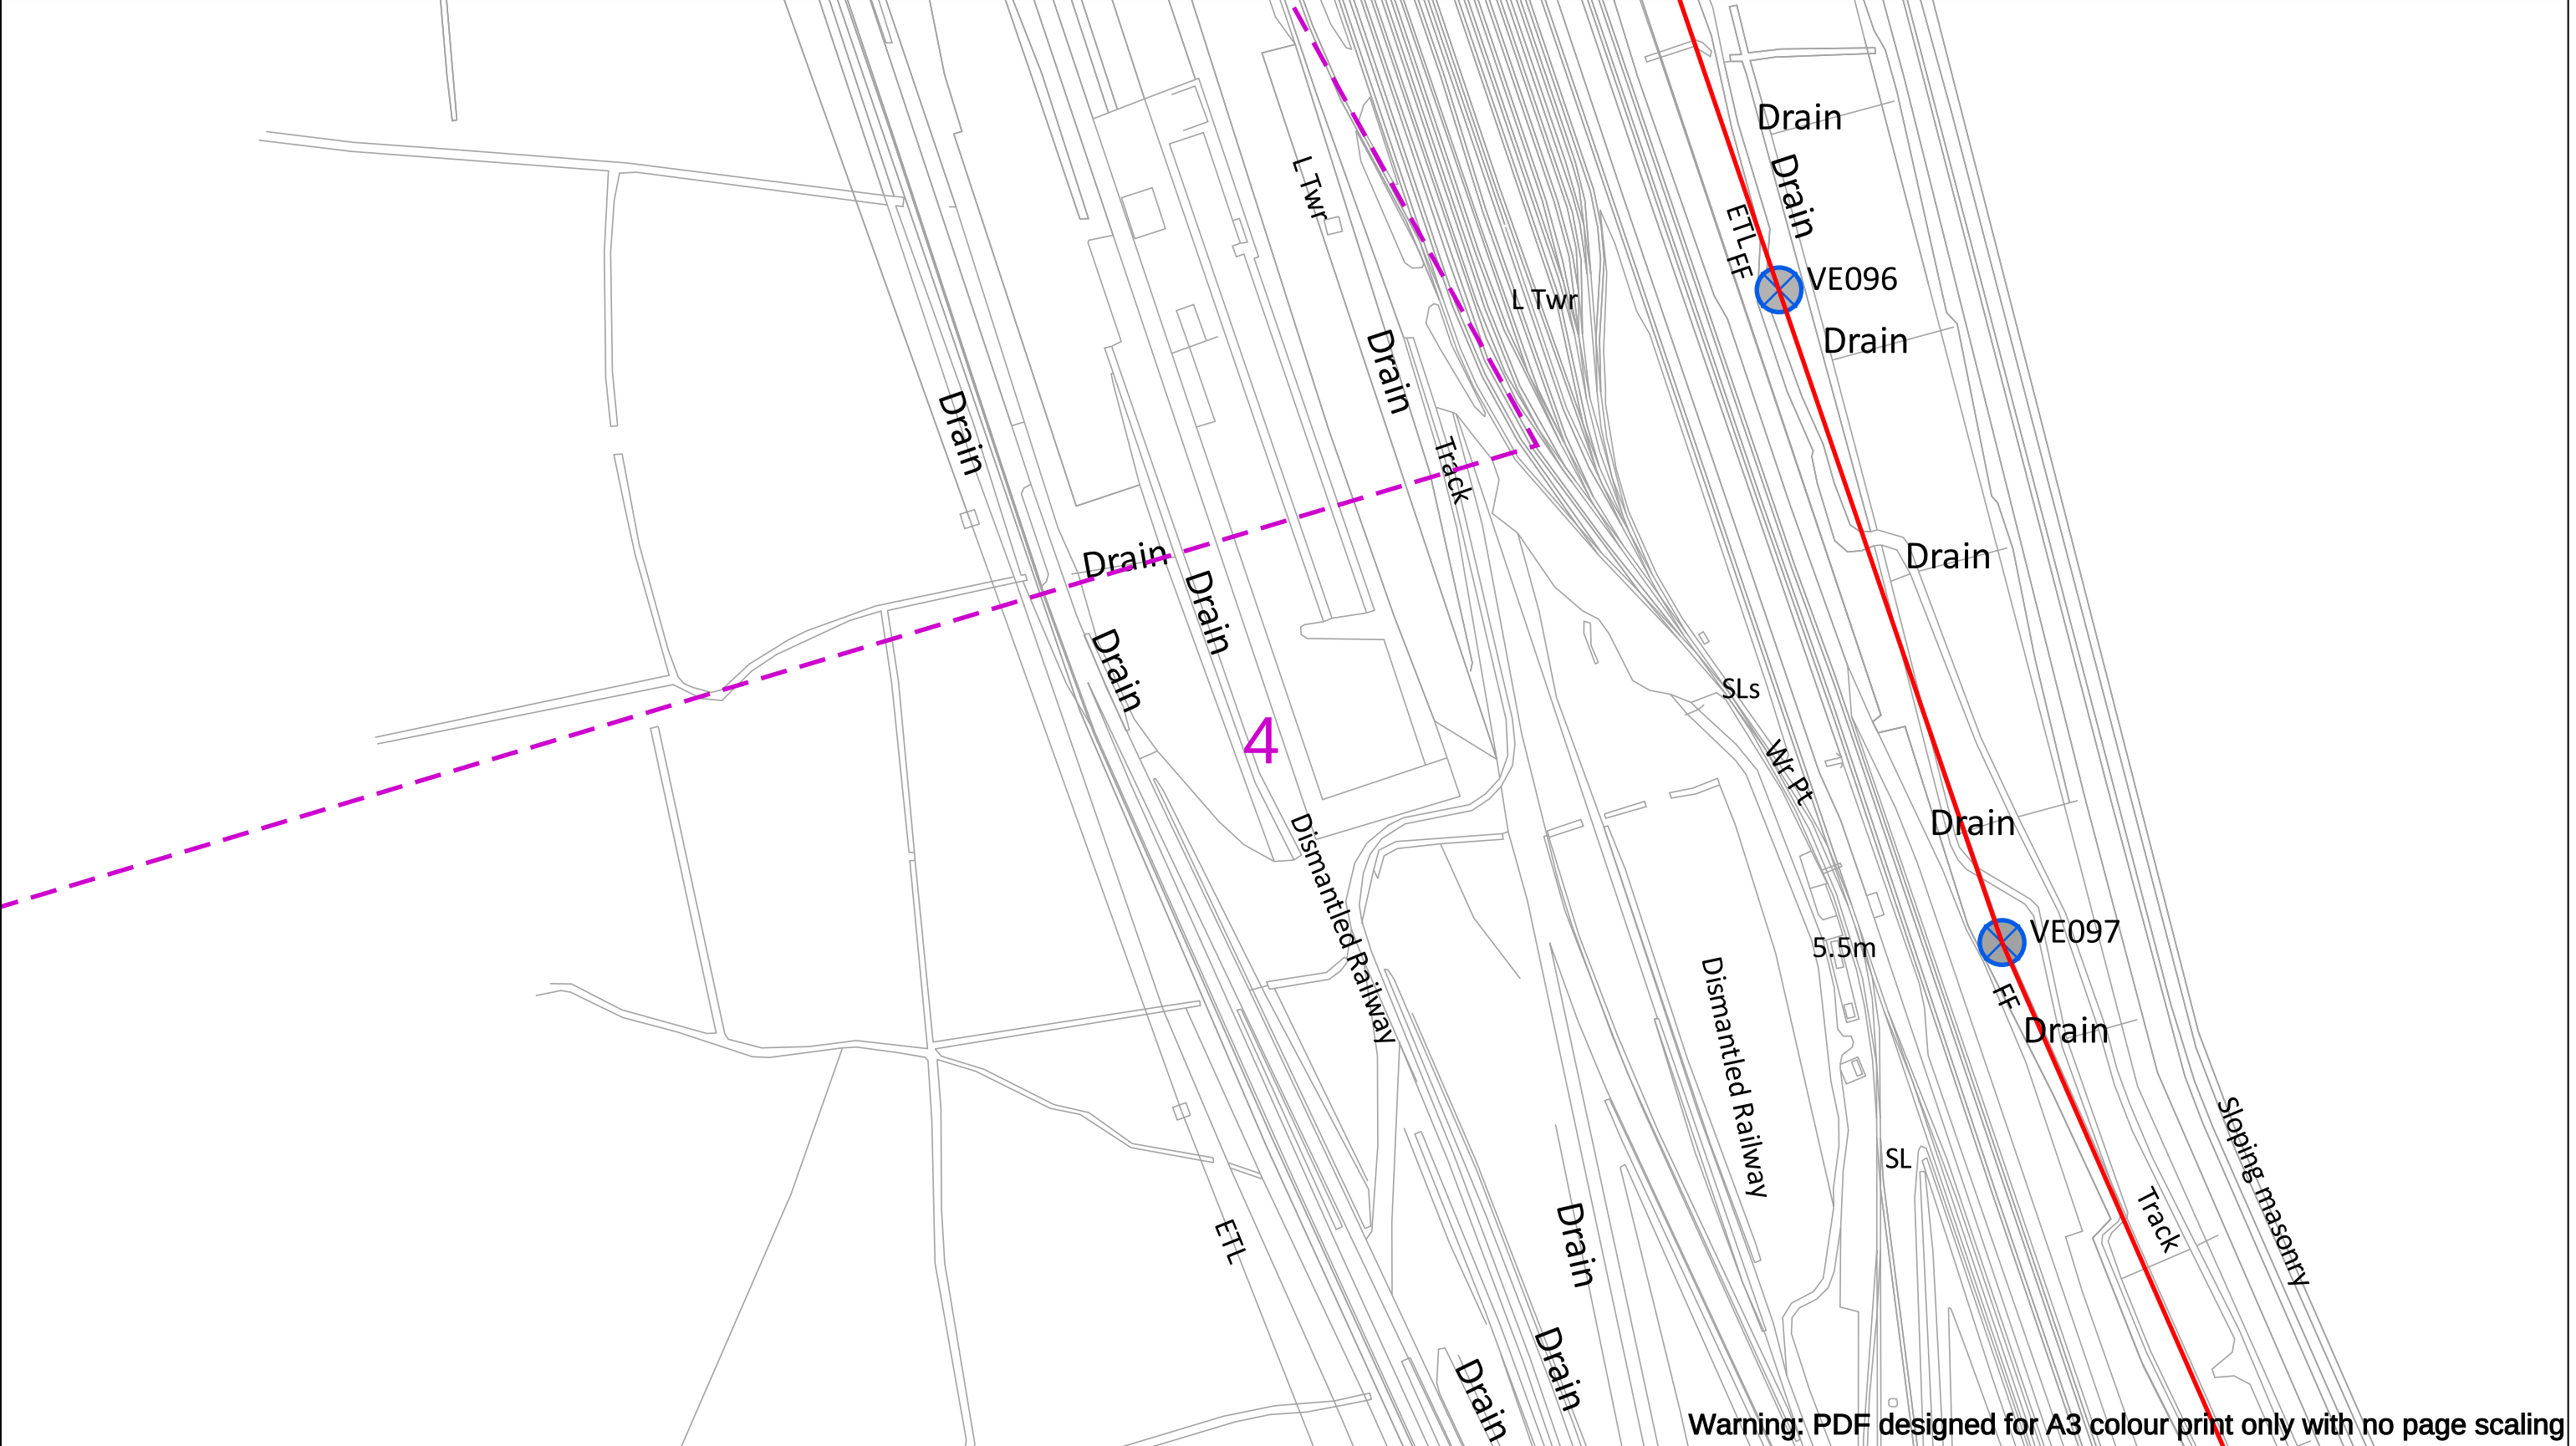

Date Requested: 24/11/2023 Job Reference: 31655152 Site Location: 278263 185096 Requested by: Mr Farhan Aslam Your Scheme/Reference: National Grid Steel Margam FEED Scale: 1:2500 (When plotted at A3)		EXTREME CAUTION - HIGH VOLTAGE **RISK OF DEATH OR SERIOUS INJURY** IMPORTANT NOTICES This plan shows those pipes owned by National Grid Electricity Transmission plc in its role as a Licensed Electricity Transporter (ET). Electricity cables owned by other ETs, or otherwise privately owned, may be present in this area. Information with regards to such cables should be obtained from the relevant owners. The information shown on this plan is given without warranty, the accuracy thereof cannot be guaranteed. Ancillary equipment such as cooling systems and communication cables are not shown but their presence should be anticipated. No liability of any kind whatsoever is accepted by National Grid Electricity Transmission plc or their agents, servants or contractors for any error or omission. Safe digging practices, in accordance with HS(G)47, must be used to verify and establish the actual position of cables and other apparatus on site before any mechanical plant is used. It is your responsibility to ensure that this information is provided to all persons (either direct labour or contractors) working for you on or near electricity apparatus. The information included on this plan should not be referred to beyond a period of 28 days from the date of issue.	National Grid Electricity Emergency Number: 0800 40 40 90 Available 24 hours, 7 days/week. Calls may be recorded and monitored Warning: PDF designed for colour print only with no page scaling 0 200 m Dig Sites Area: Line: Underground Cables Overhead Lines Fibre Cables	NationalGrid House Warwick Technology Park Gallows Hill Warwick CV34 6DA AssetProtection@NationalGrid.com
Crown Copyright © - Reproduced by permission of Ordnance Survey on behalf of HMSO. And database right 2023. All rights reserved. Ordnance Survey Licence number 0100059731				